



STATE PROJECT NUMBER	SHEET NO.
4990-00-17	9.10
CTH 00 OUTAGAMIE COUNTY	

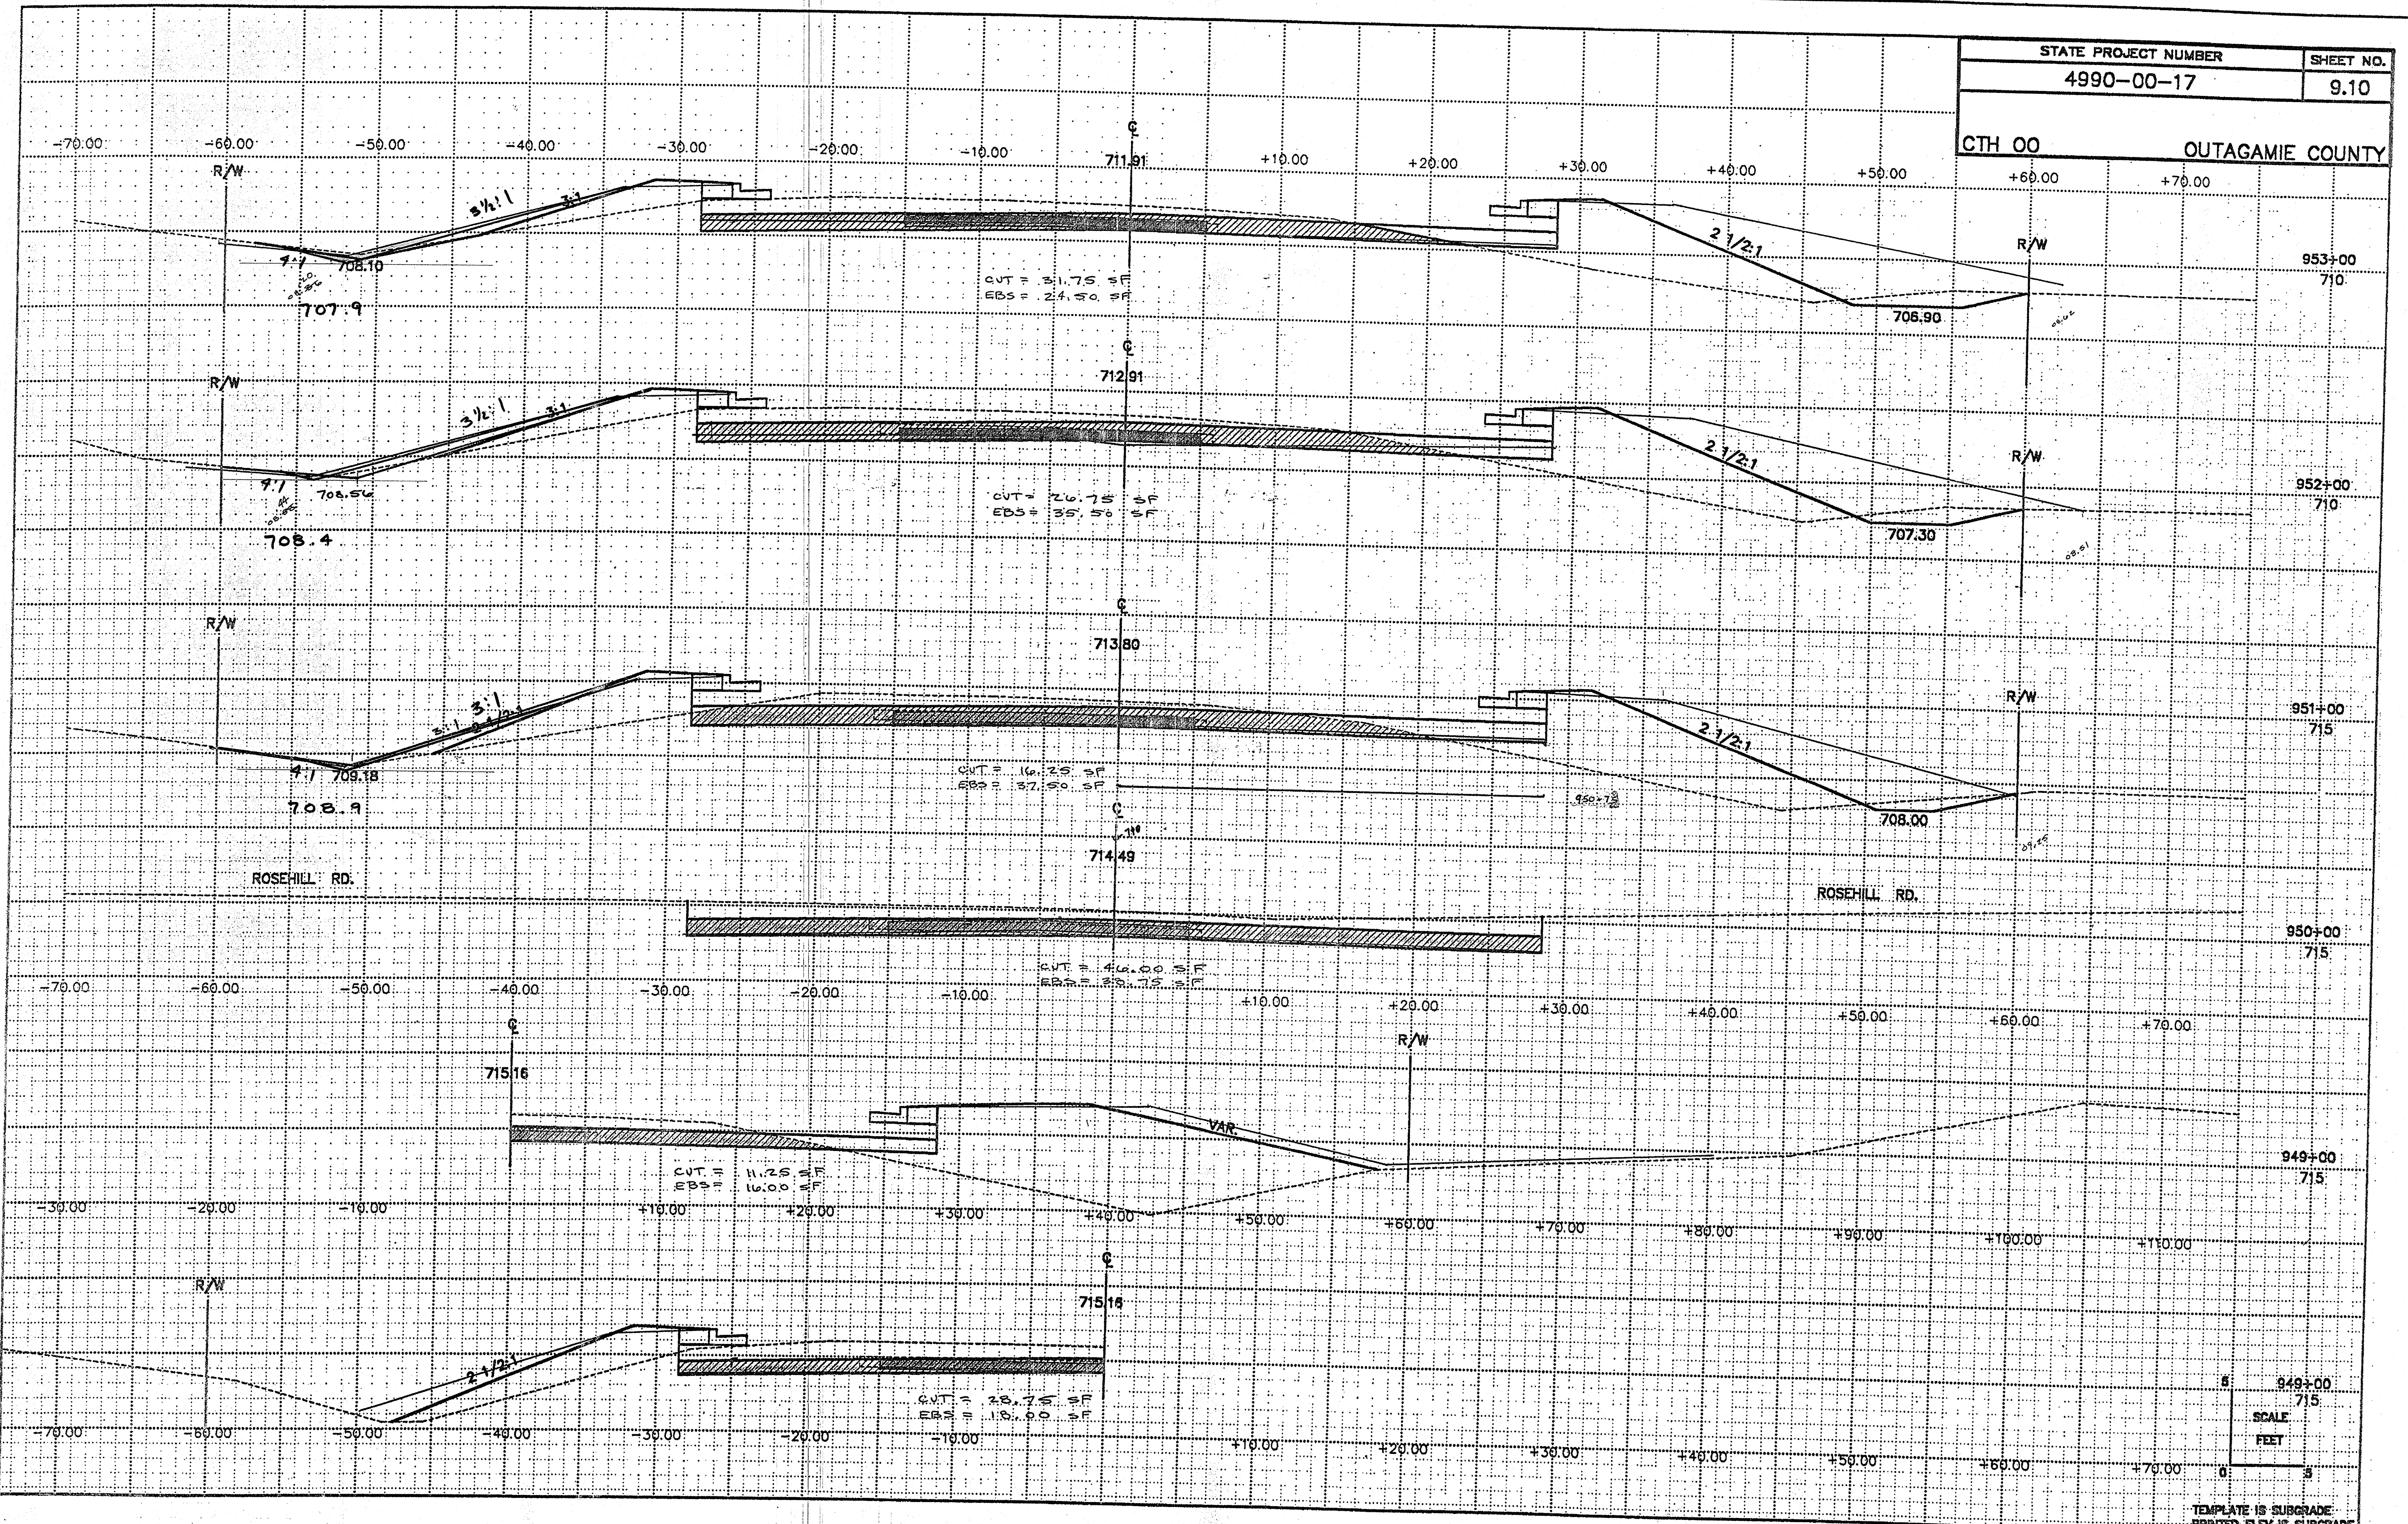

00-21 00-Ditch Regrade as built
East of CC
11/2001

00-21
Buckner to 55


STATE PROJECT NUMBER	SHEET NO.
4990-00-17	9.11
CTH 00 OUTAGAMIE COUNTY	

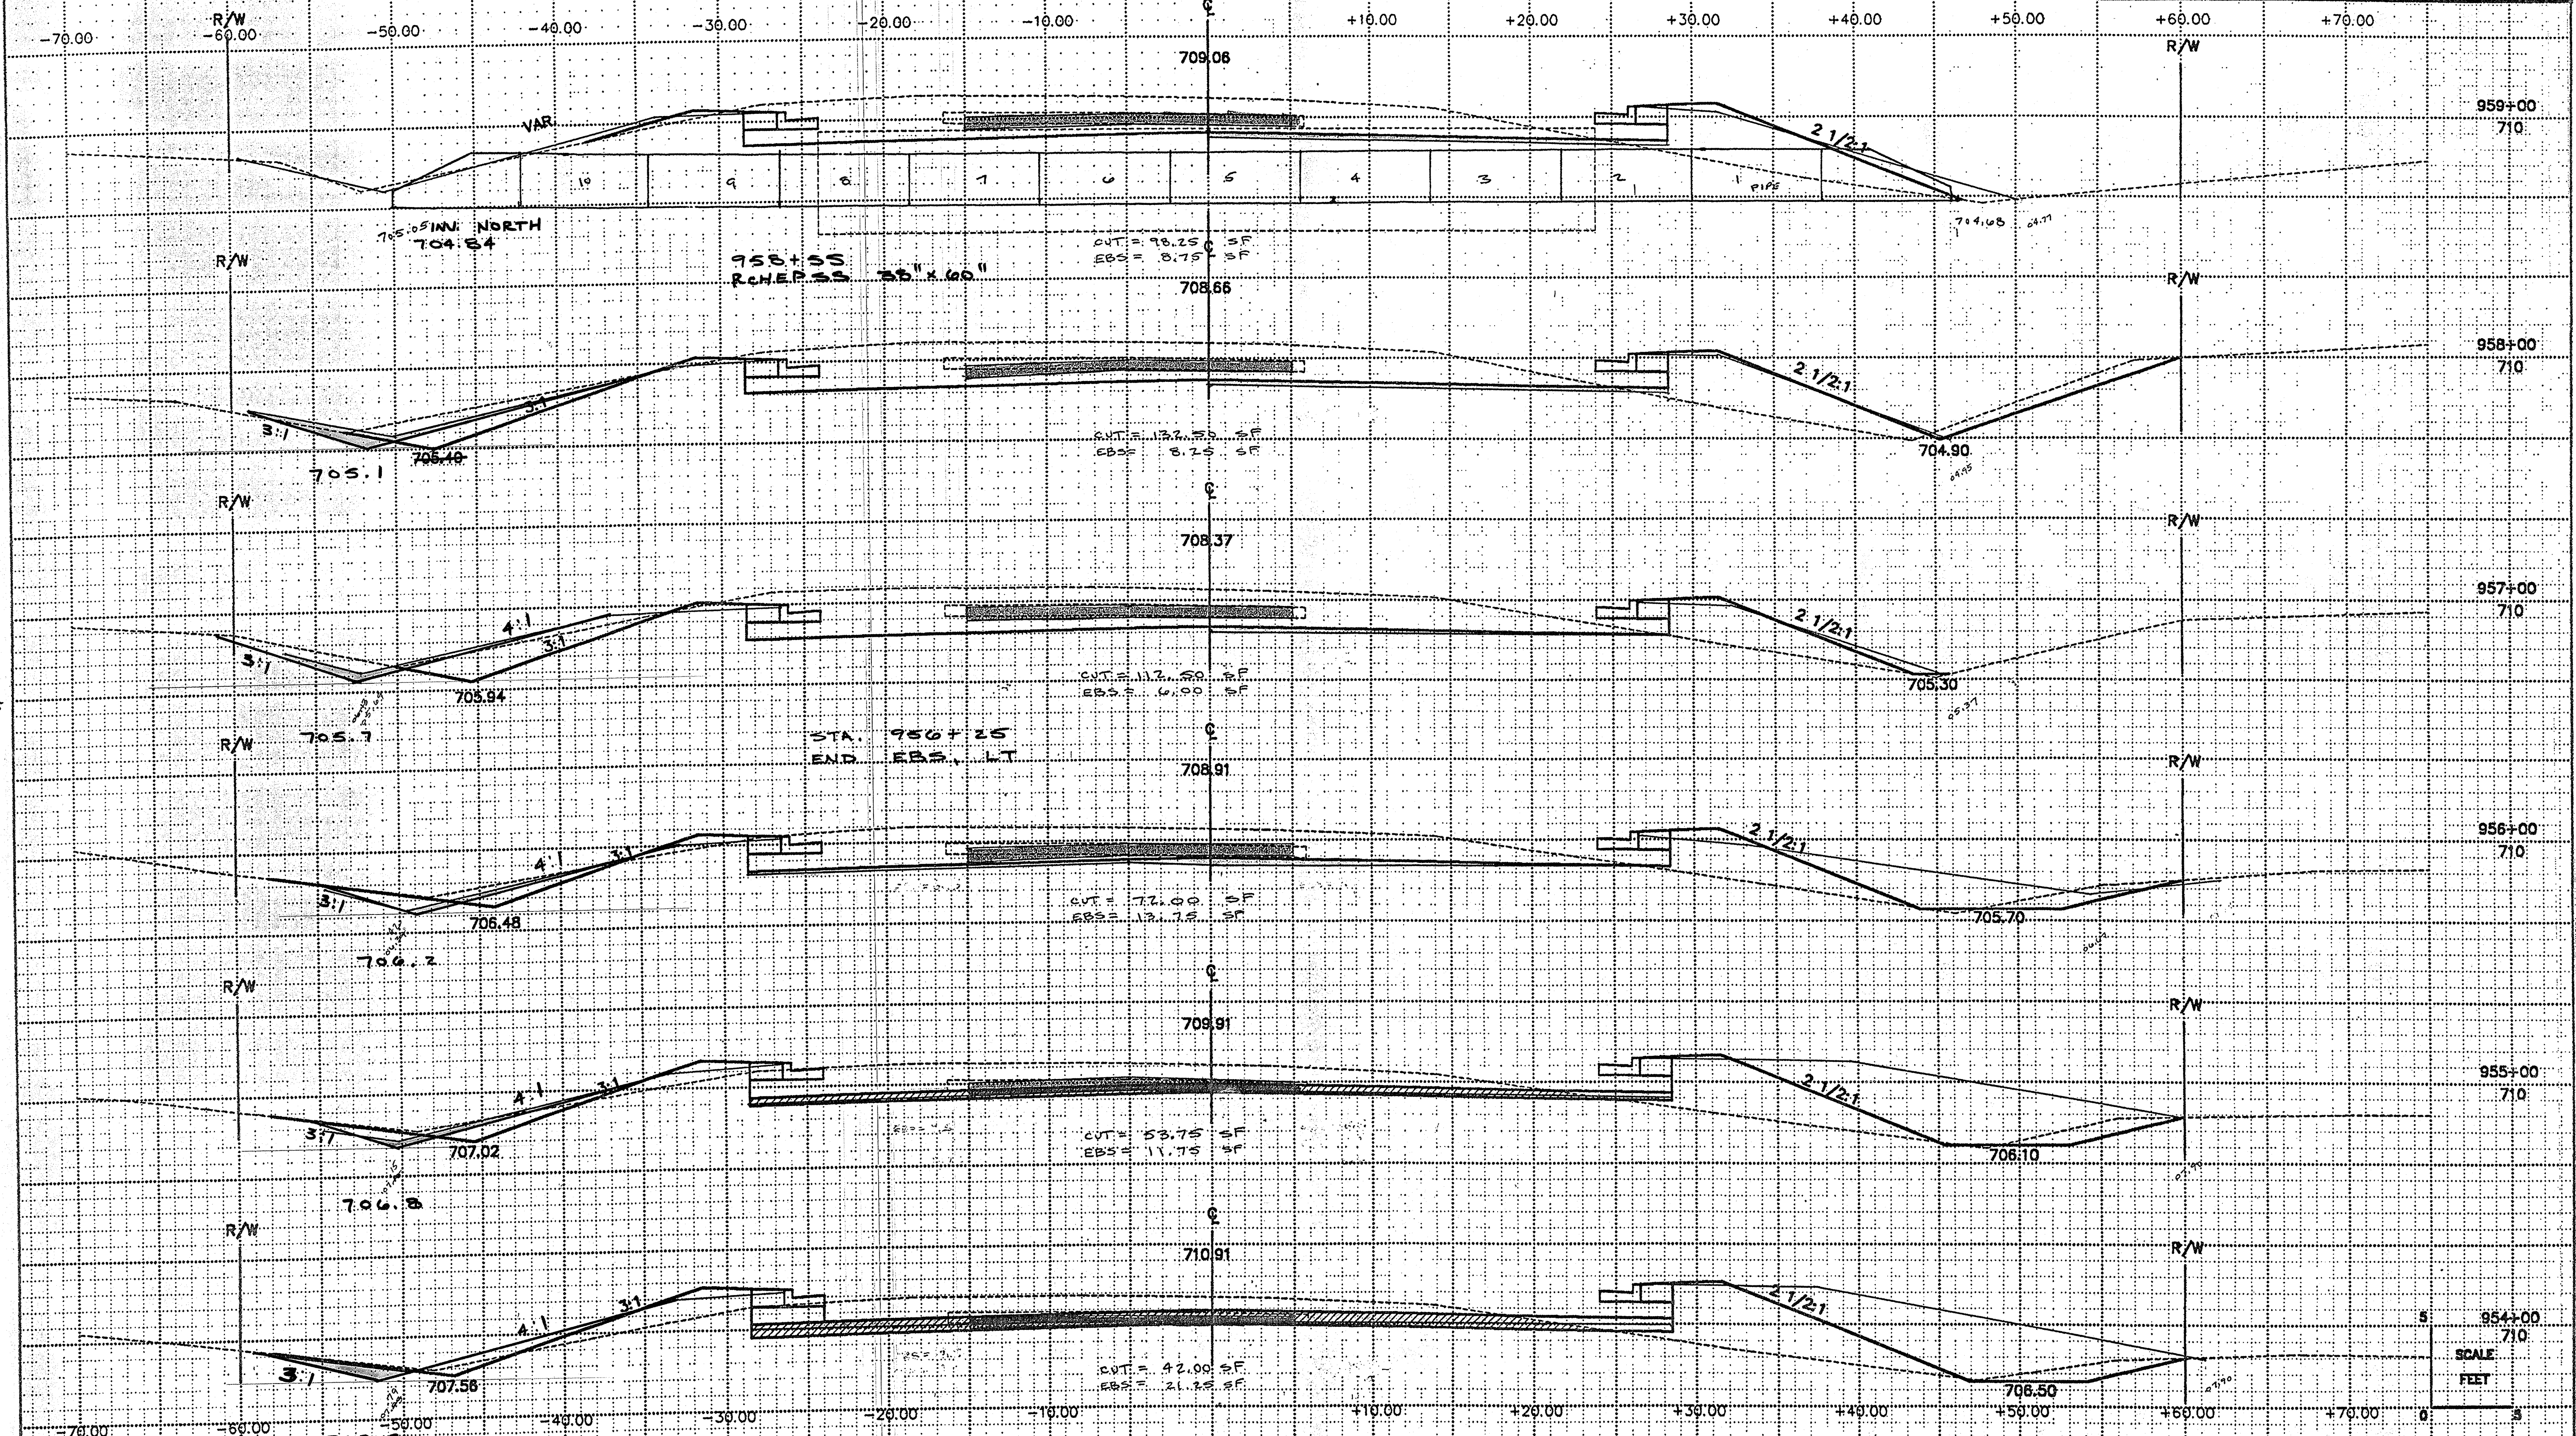

5 954+00
 710
 SCALE
 FEET
 0 5


TEMPLATE IS SUBGRADE
 PRINTED ELEV IS SUBGRADE

STATE PROJECT NUMBER	SHEET NO.
4990-00-17	9.12
CTH 00	OUTAGAMIE COUNTY

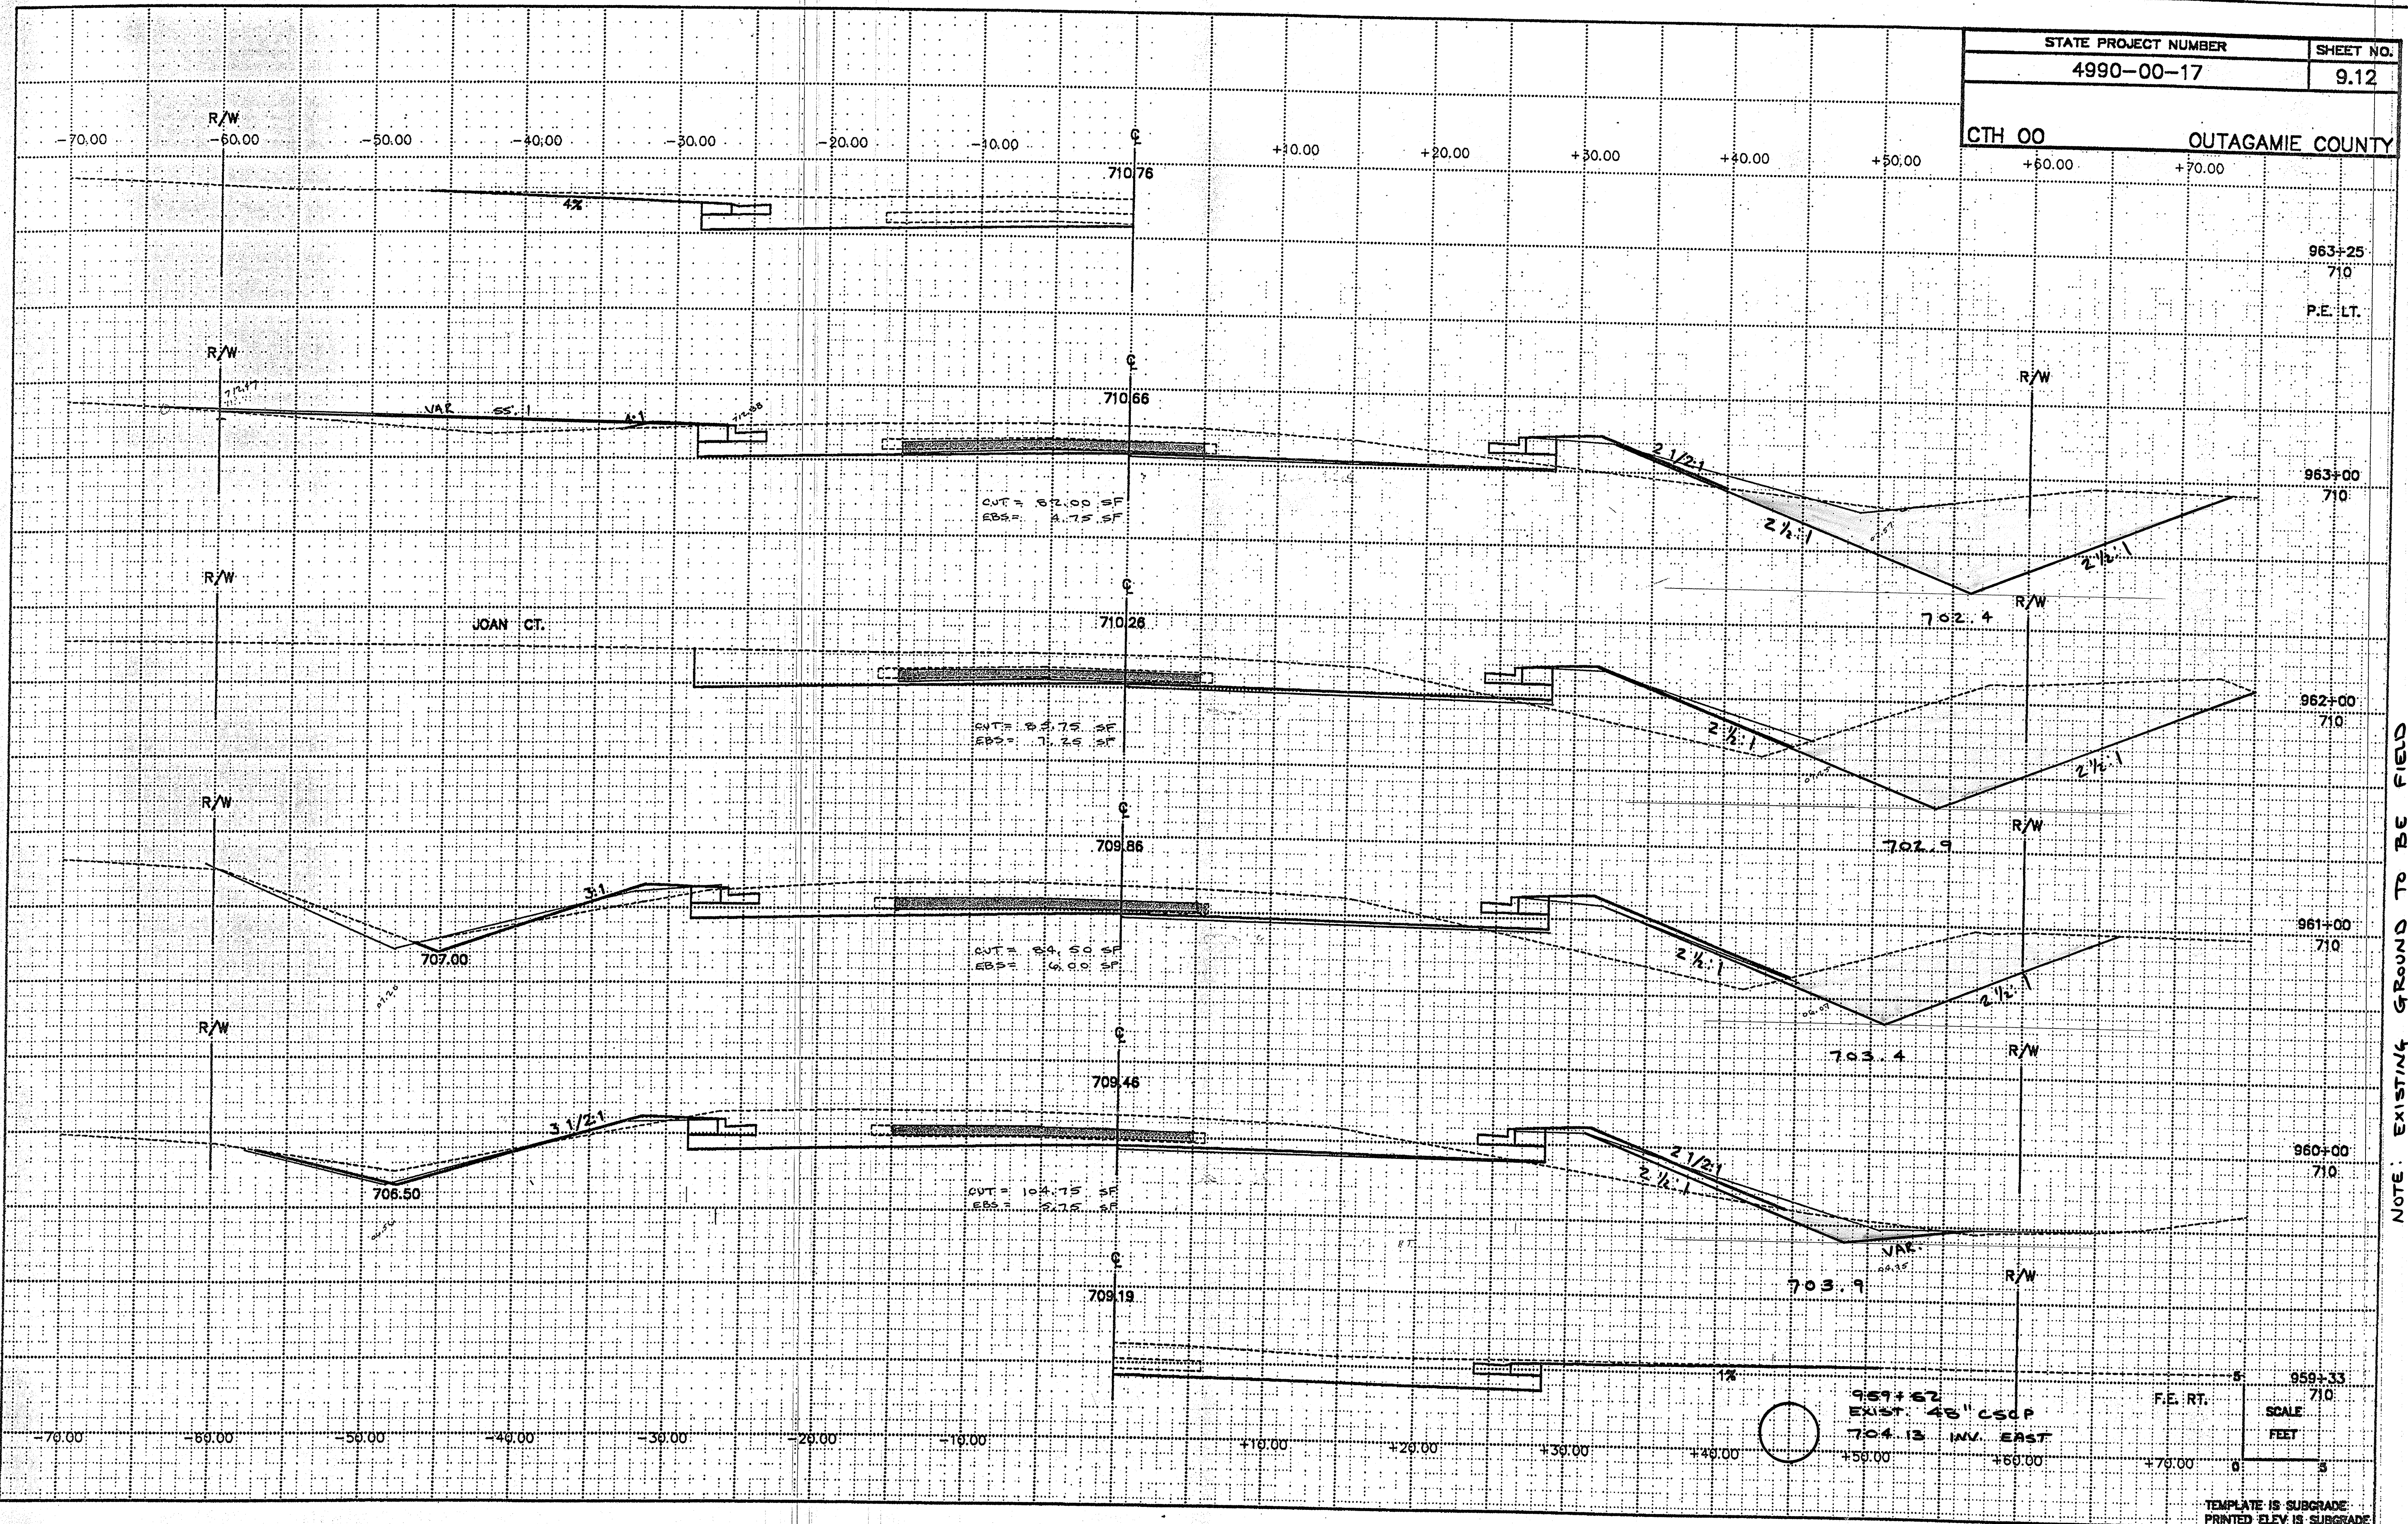

NOTE: EXISTING GROUND TO BE FIELD VERIFIED ON 11-12-01.


STATE PROJECT NUMBER	SHEET NO.
4990-00-17	9.13
CTH 00 OUTAGAMIE COUNTY	

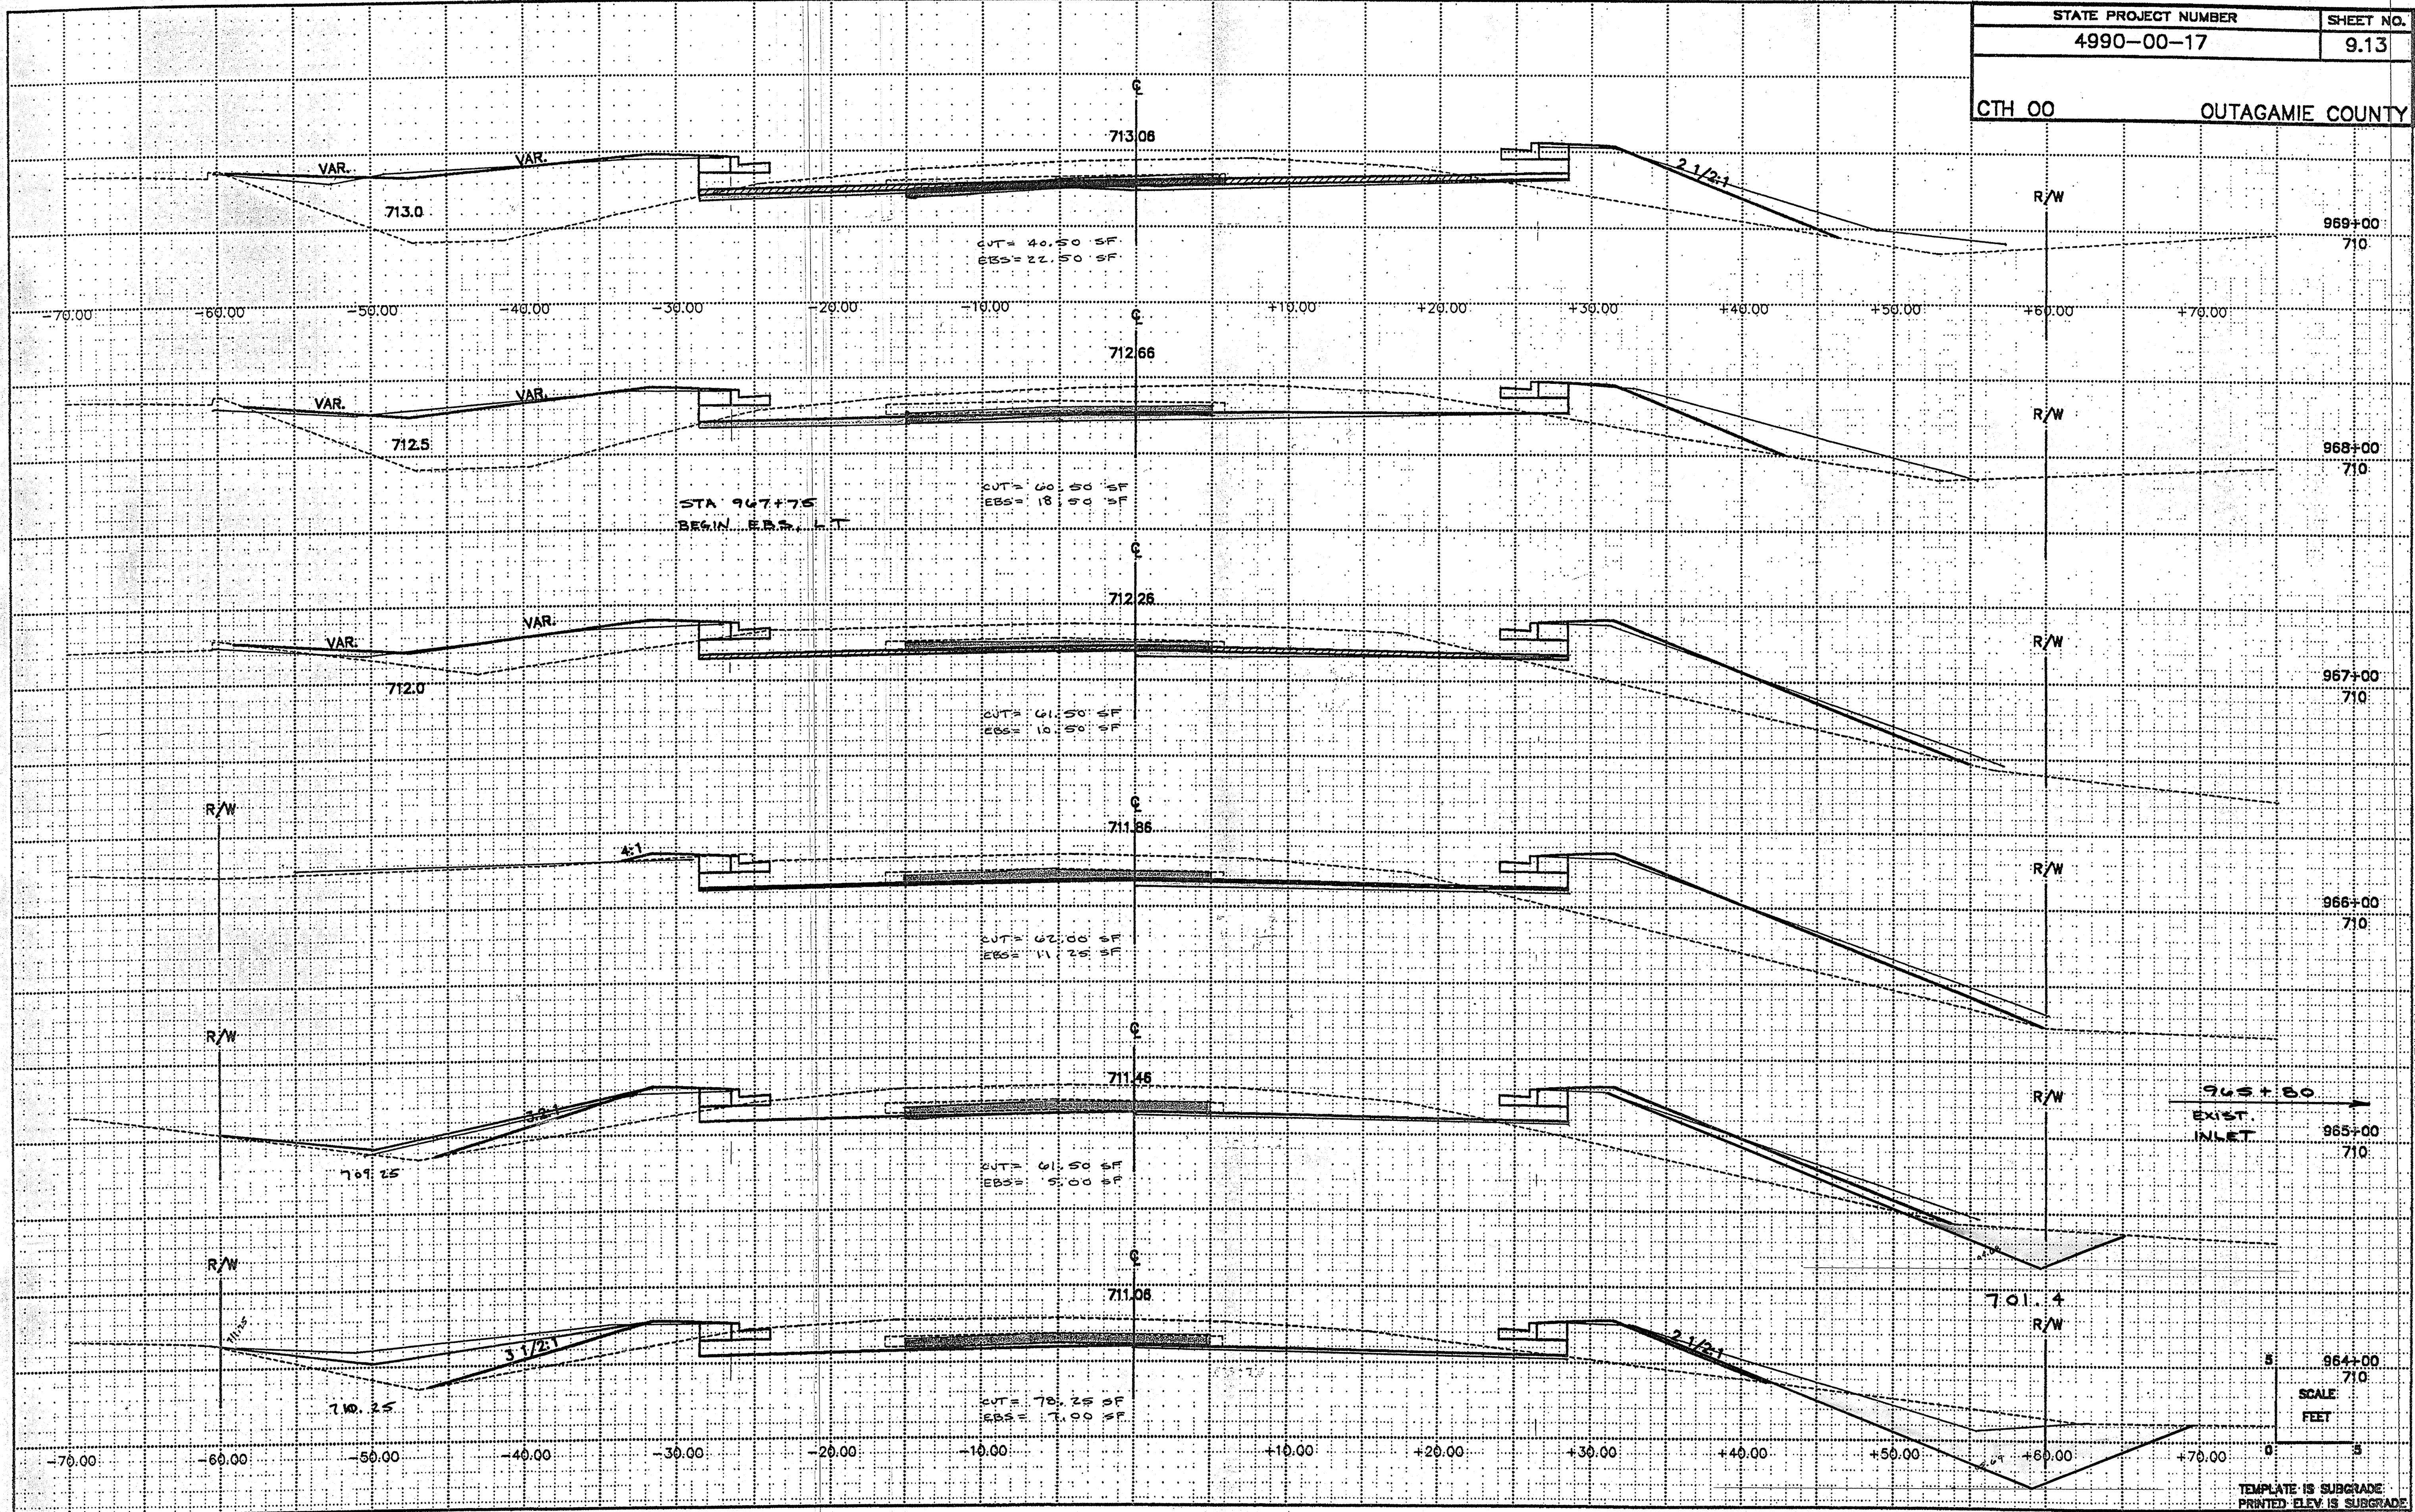

NOTE: EXISTING GROUND TO BE FIELD VERIFIED ON 11-12-01

SCALE: FEET
 0 5
 TEMPLATE IS SUBGRADE
 PRINTED ELEV IS SUBGRADE

STATE PROJECT NUMBER	SHEET NO.
4990-00-17	9.10
CTH 00 OUTAGAMIE COUNTY	

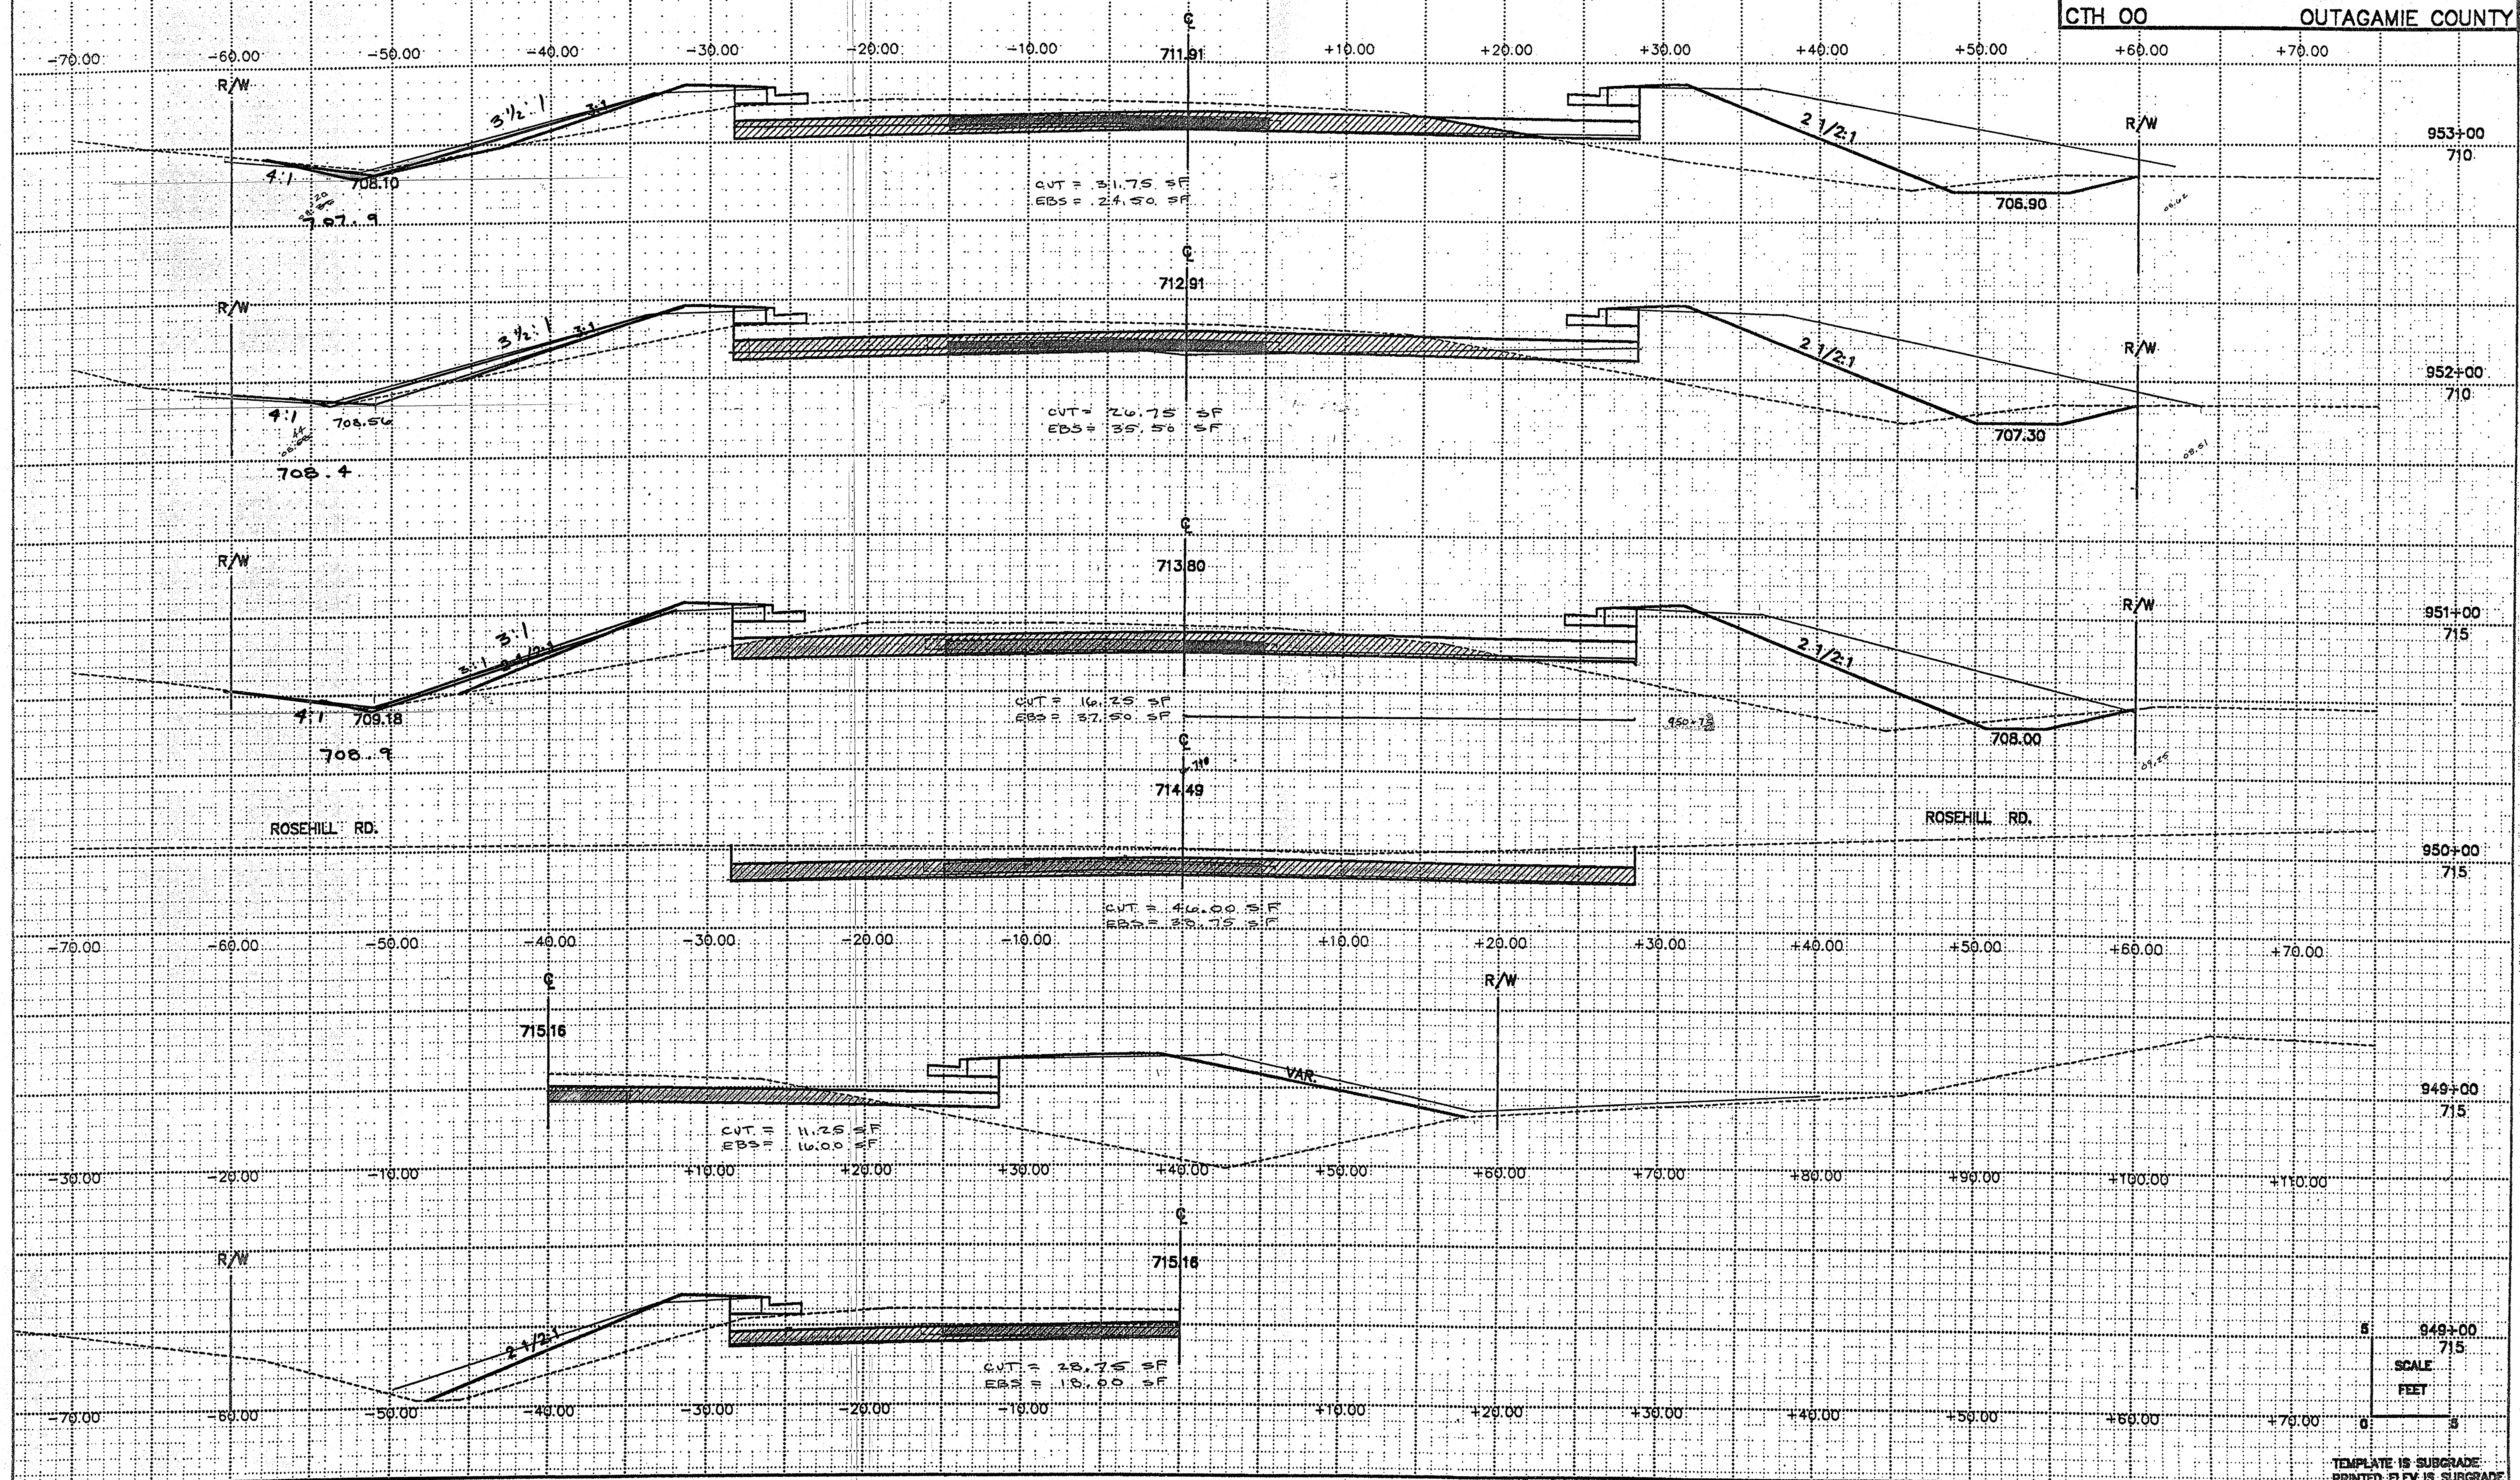

SCALE
FEET


TEMPLATE IS SUBGRADE
PRINTED ELEV IS SUBGRADE

00-21

00-21

STATE PROJECT NUMBER	SHEET NO.
4990-00-17	9.11


CTH 00 OUTAGAMIE COUNTY

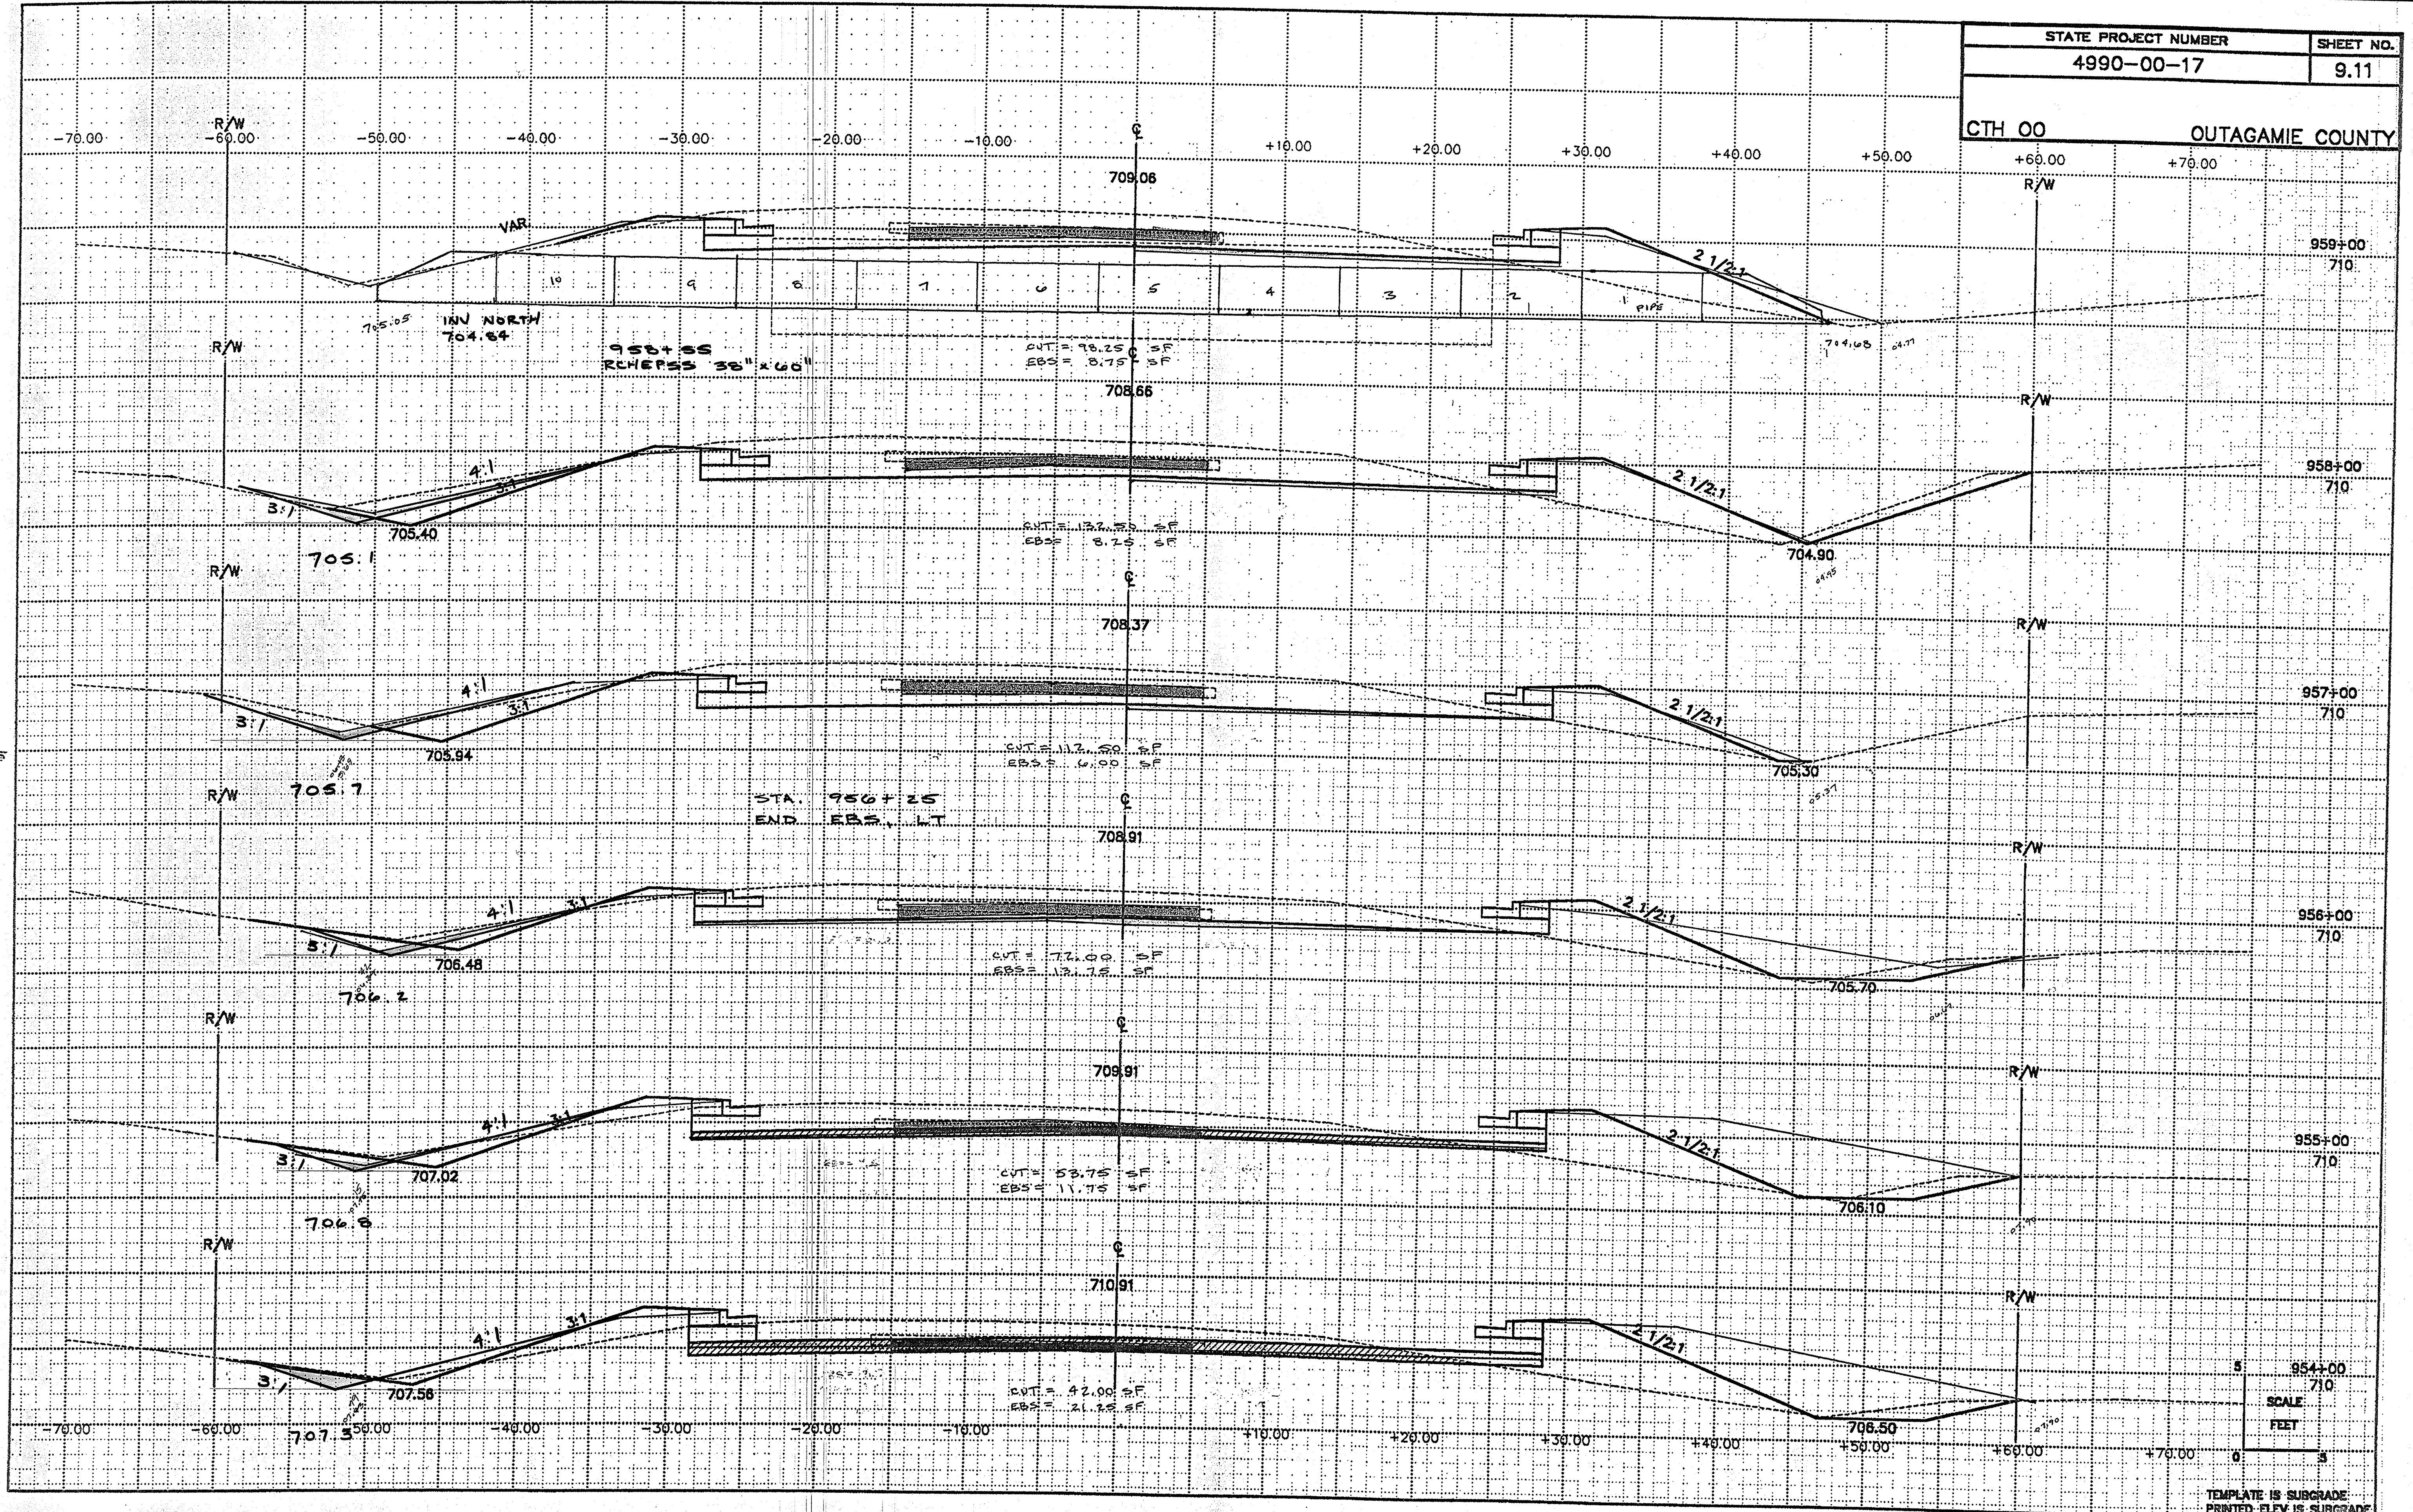

SCALE
FEET

TEMPLATE IS SUBGRADE
PRINTED ELEV IS SUBGRADE

STATE PROJECT NUMBER	SHEET NO.
4990-00-17	9.12
CTH 00 OUTAGAMIE COUNTY	

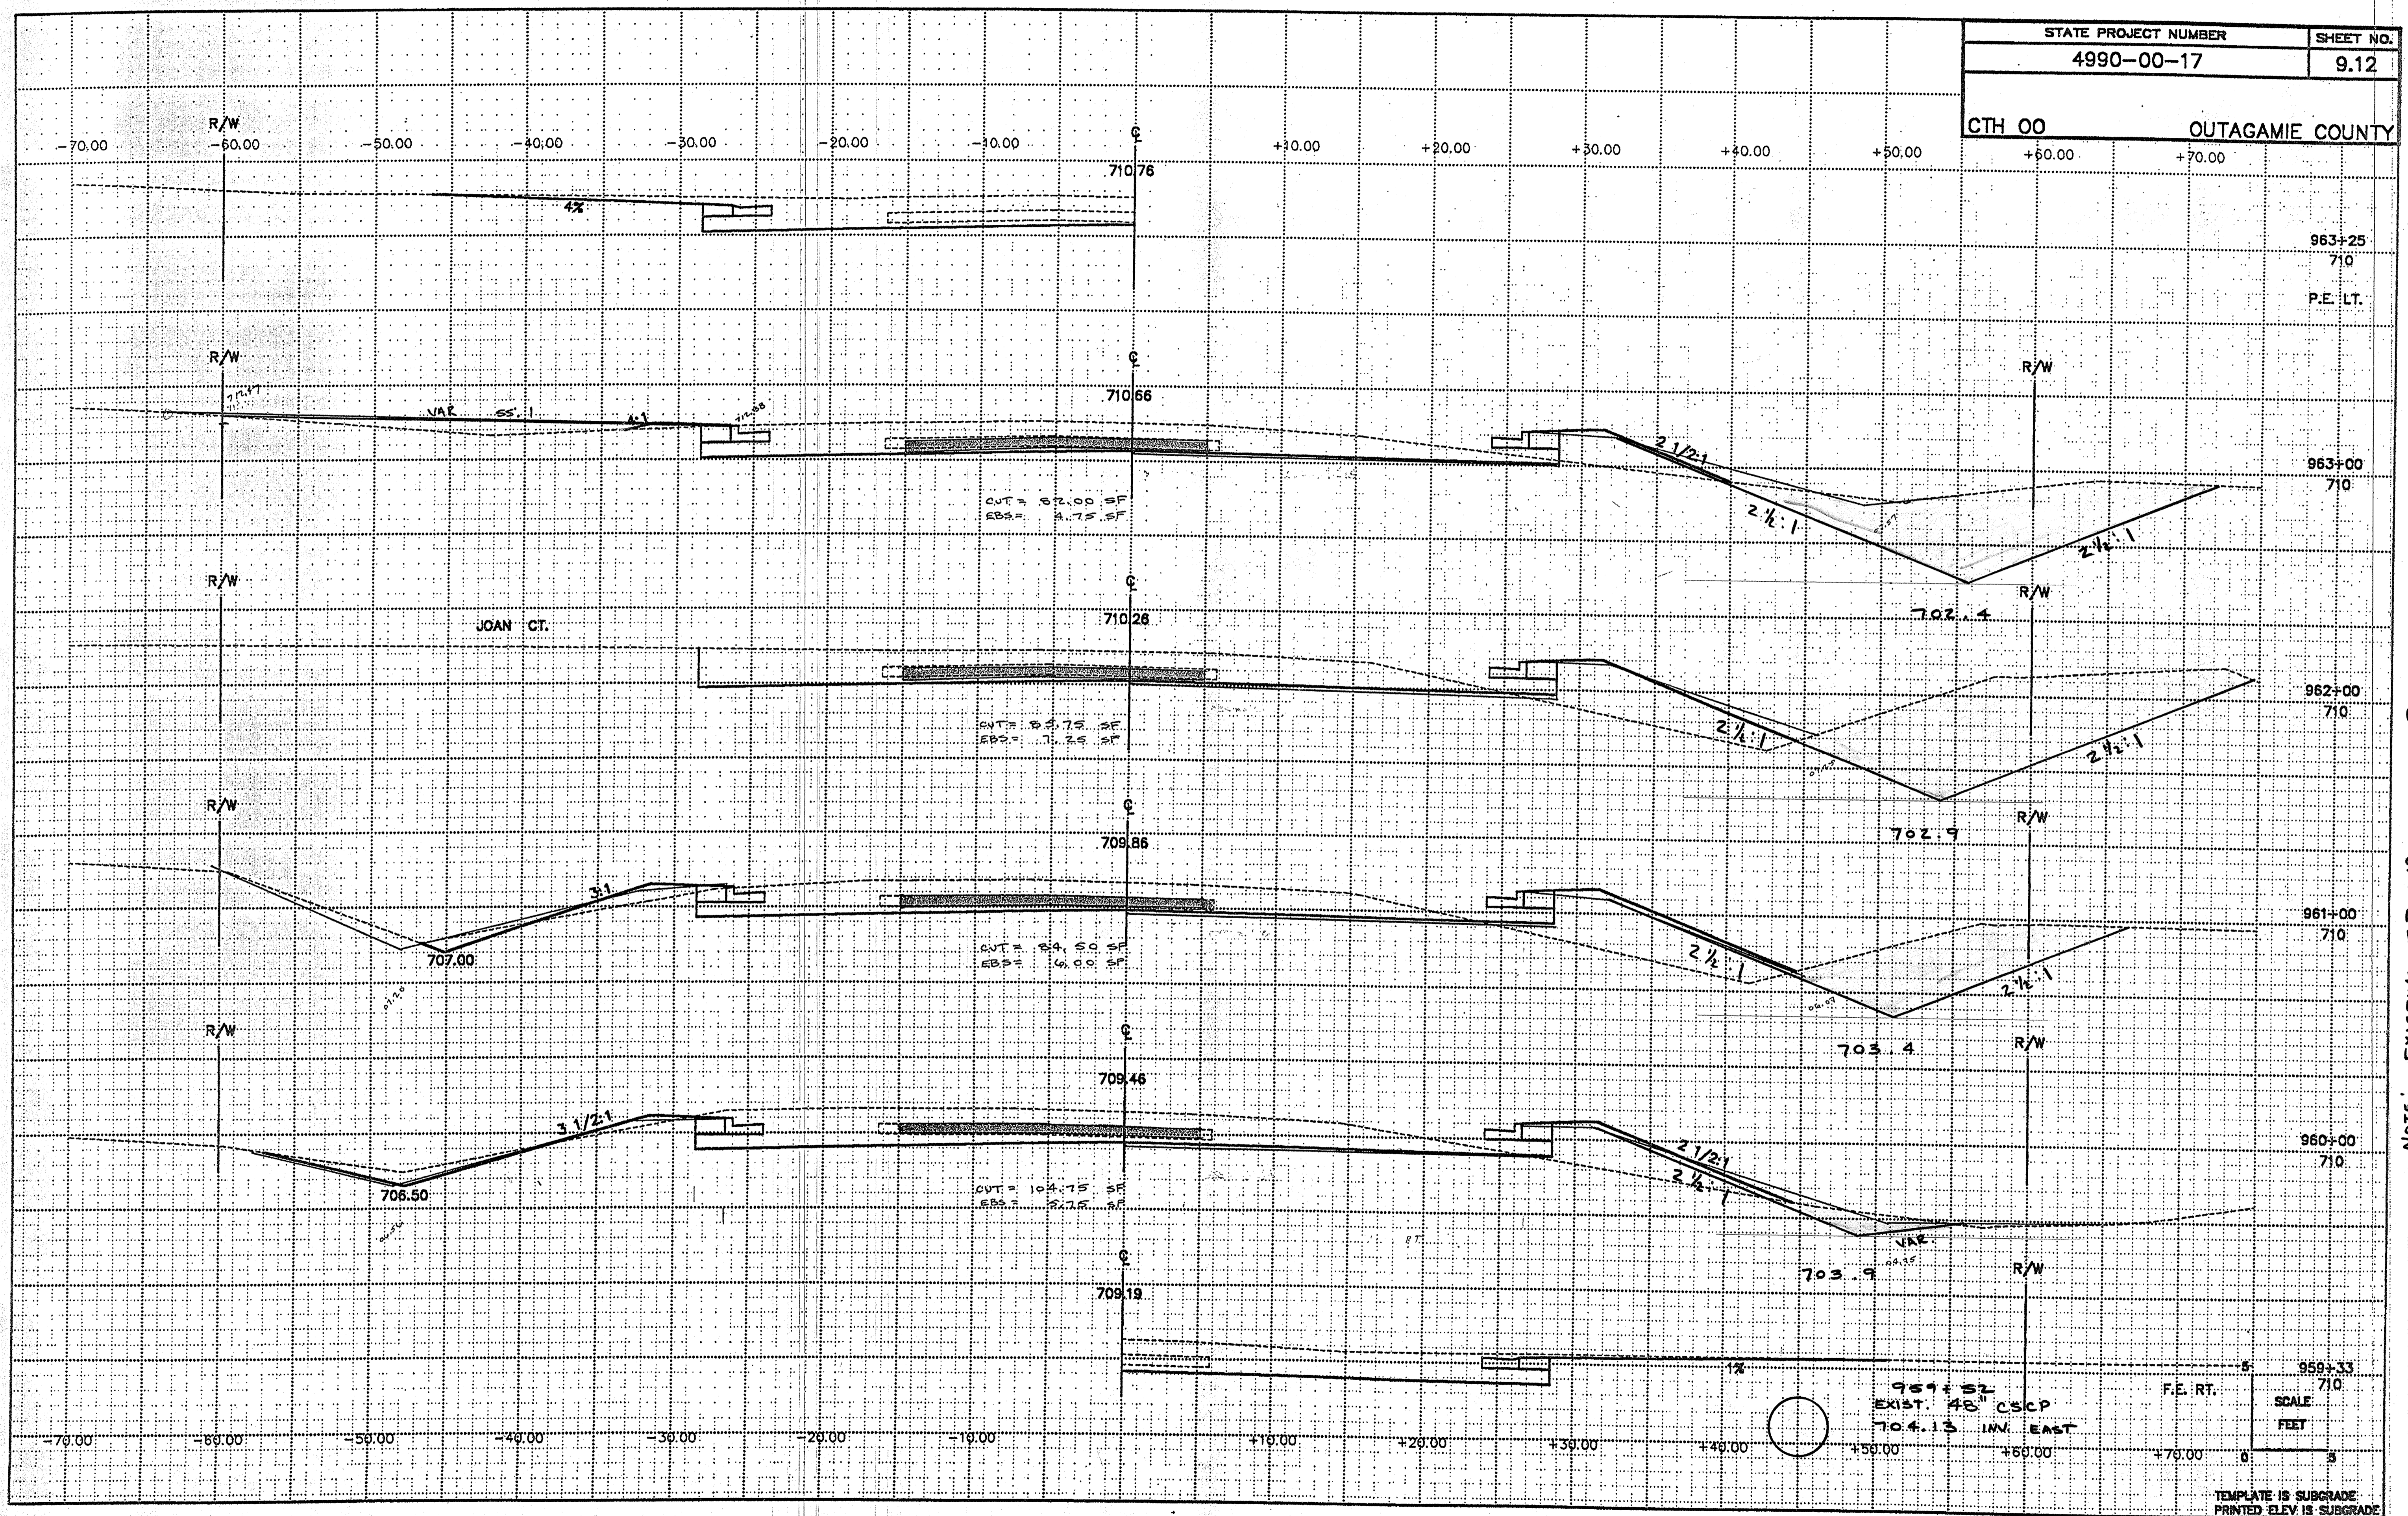


NOTE: EXISTING GROUND TO BE FIELD VERIFIED ON 11-12-01.

959+33
EXIST 48" CSCP
704.13 INV. EAST

F.E. RT. SCALE
FEET

TEMPLATE IS SUBGRADE
PRINTED ELEV IS SUBGRADE

STATE PROJECT NUMBER	SHEET NO.
4990-00-17	9.13
CTH 00 OUTAGAMIE COUNTY	

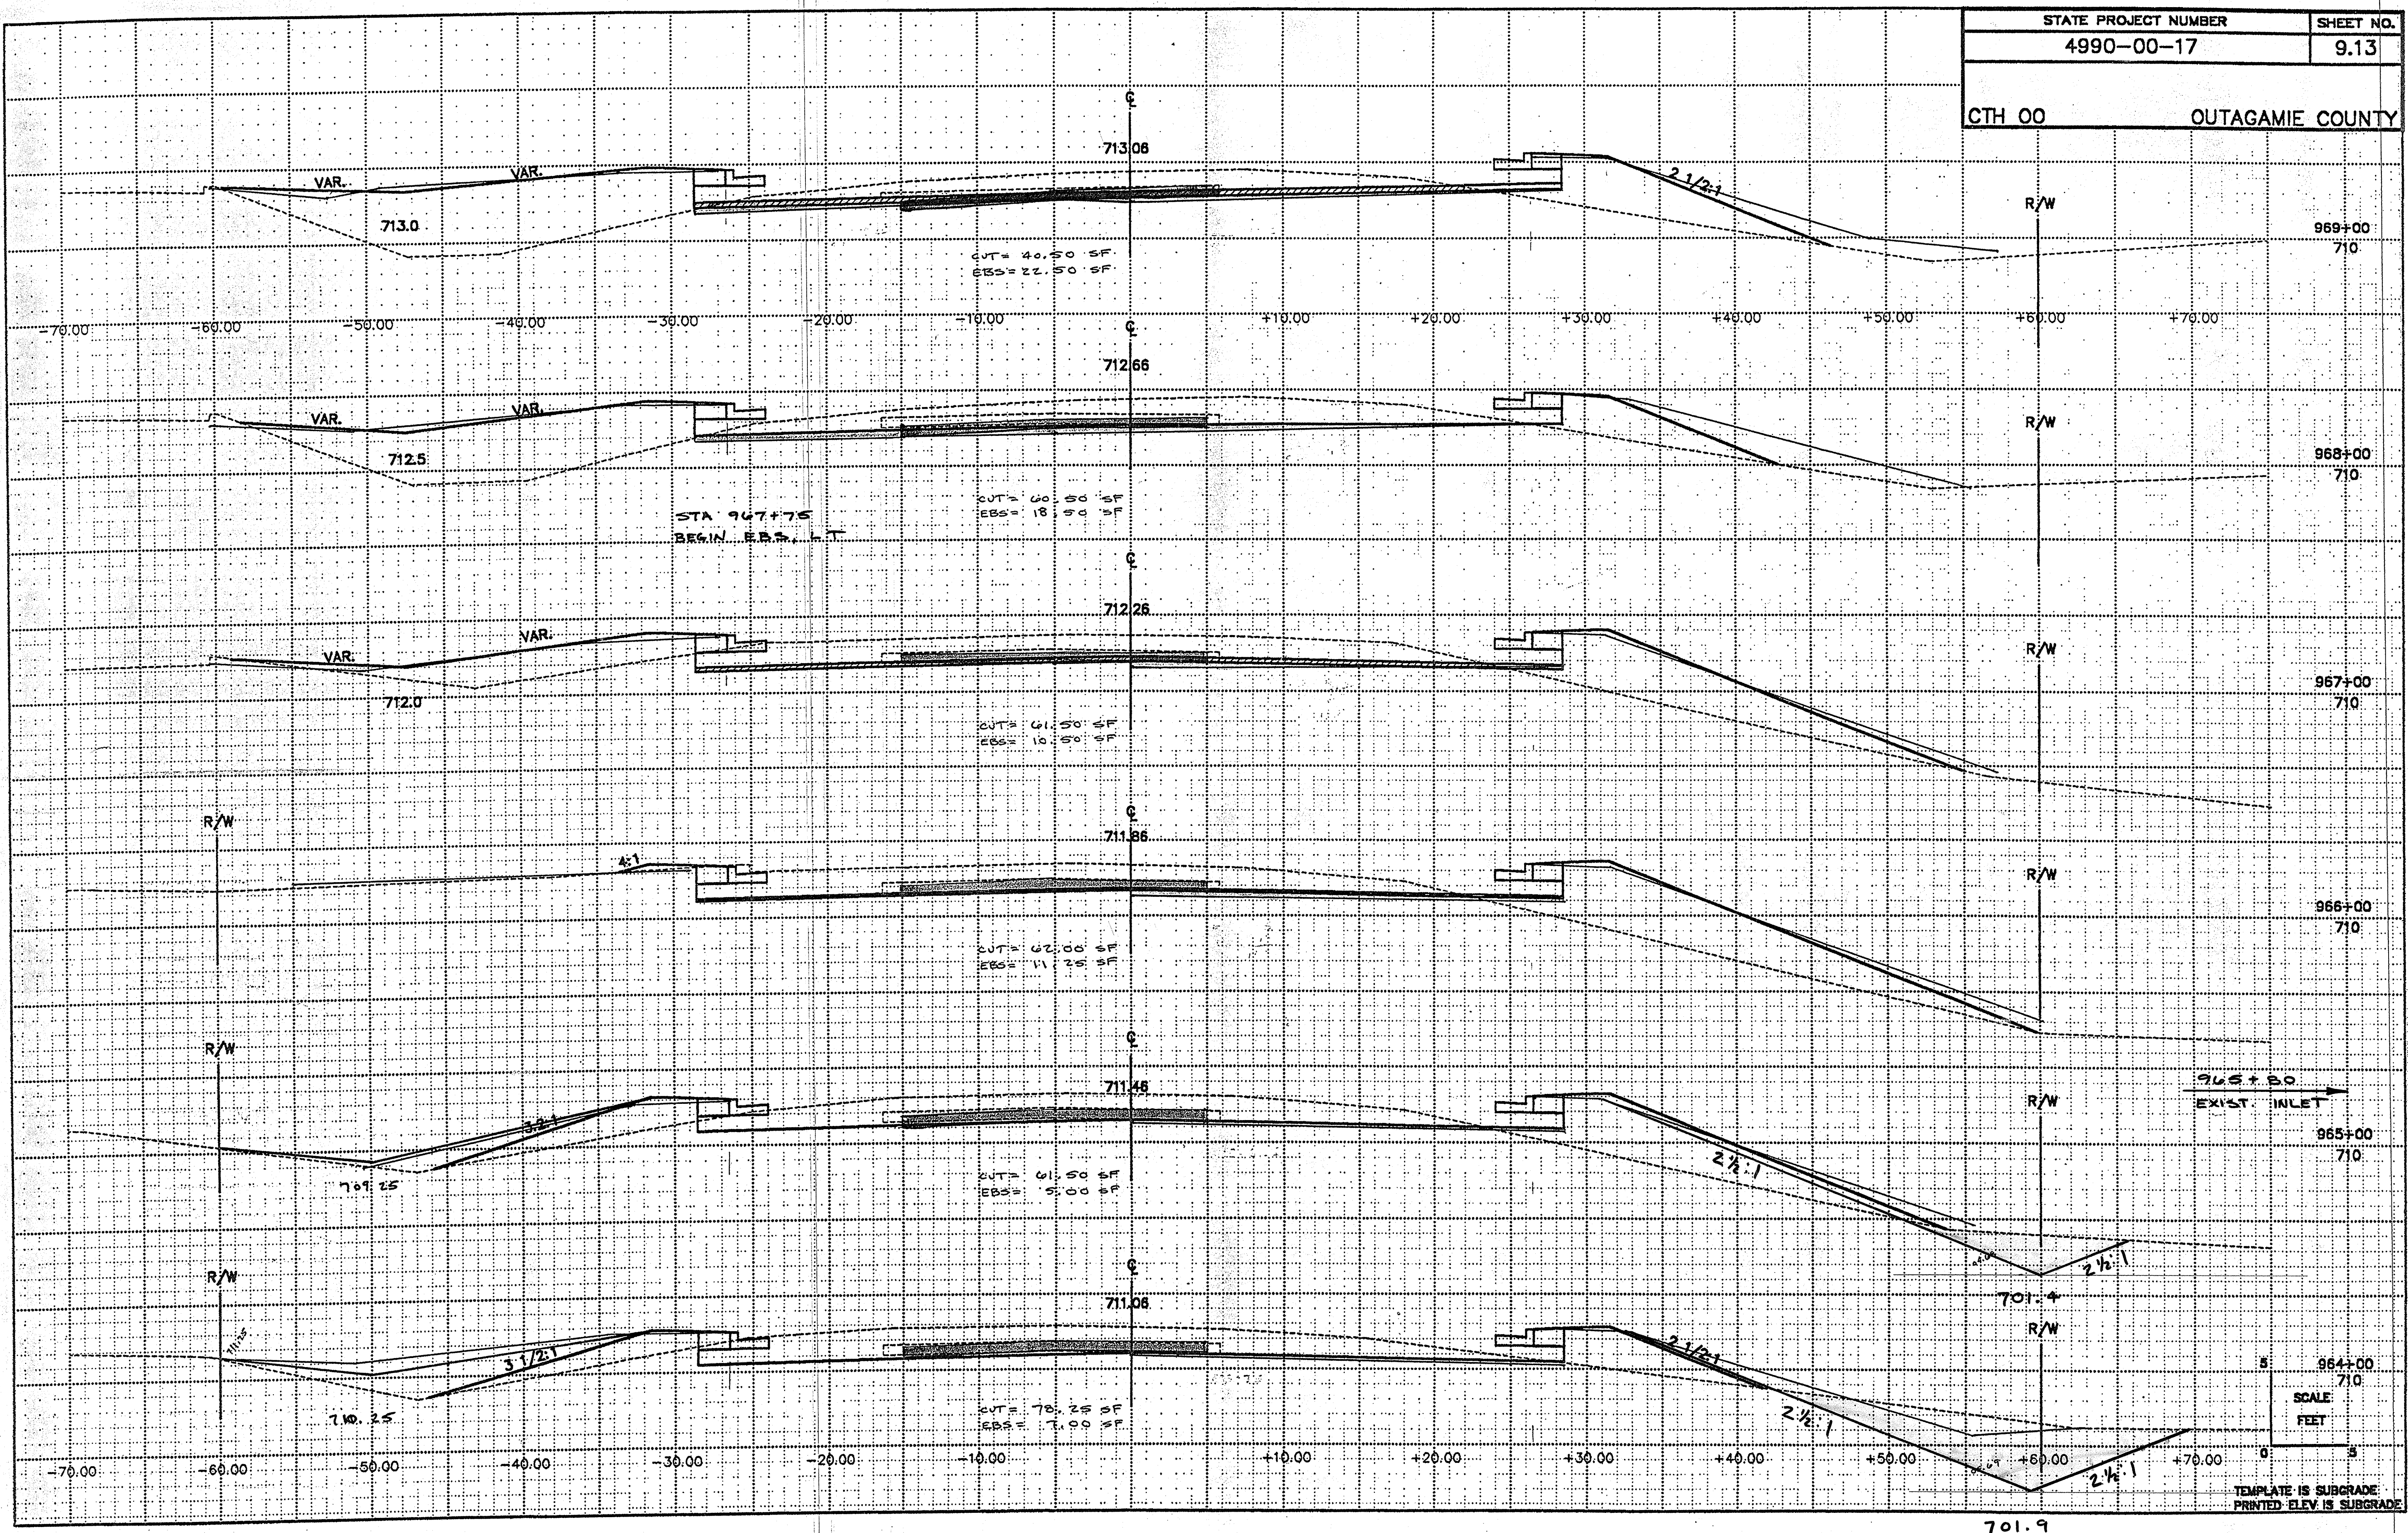

NOTE: EXISTING GROUND TO BE FIELD VERIFIED ON 11-12-01

SCALE: FEET
 TEMPLATE IS SUBGRADE
 PRINTED ELEV IS SUBGRADE