

INDEX OF SHEETS		FEDERAL PROJECT	
Sheet No.	Title	STATE PROJECT	PROJECT
1	Title	4677-06-71	STP 1210 (4)
2-2.5	Typical Sections and Details		1
3-3.1	Estimate of Quantities		
3A-3B	Miscellaneous Quantities		
-	Right of Way Plat		
5	Plan and Profile		
6-6.15	Standard Detail Drawings		
-	Sign Plates		
-	Structure Plans		
-	Computer Earthwork Data		
-	Cross Sections		
TOTAL SHEETS = 29			

**STATE OF WISCONSIN  
DEPARTMENT OF TRANSPORTATION**

**PLAN OF PROPOSED IMPROVEMENT**

**NORTH AVENUE AND BUCHANAN STREET INTERSECTION  
VILLAGE OF LITTLE CHUTE**

**C.T.H. '00'**

**OUTAGAMIE COUNTY**

STATE PROJECT NUMBER  
**4677-06-71**

NORTH

PROJECT LOCATION  
Y = 169,900 ±  
X = 2,444,650

3027  
3024

DESIGNATION

A.D.T. (1991)	= 10,020
A.D.T. (2010)	= 15,700
D.H.V. (2010)	= 1,570
D.	= 50-50
T.	= 4.0%
V.	= 35

CONVENTIONAL SIGNS

COUNTY LINE	—
CORPORATE LIMITS	
PROPERTY LINE	—
LOT LINE	—
LIMITED EASEMENT	—
EXISTING RIGHT OF WAY	—
NEW RIGHT OF WAY	—
REFERENCE LINE	—
SLOPE INTERCEPT	—
ORIGINAL GROUND	—
MARSH OR ROCK PROFILE	—
CULVERT IN PLACE	—
CULVERT REQUIRED	—
CULVERT REQUIRED (PROFILE)	—

COMBUSTIBLE FLUIDS (UNDER PRESSURE)

UNDERGROUND UTILITIES

GAS	—
ELECTRIC	—
TELEPHONE	—
SERVICE PEDESTAL	—
CABLE MARKER	—
POWER POLE	—
TELEPHONE POLE	—
RAILROADS	—
MARSH	—
WOODED AREA	—

LAYOUT  
SCALE 0 1/4 MILE

TOTAL NET LENGTH OF CENTERLINE = 0.000 MI.

AS BUILT PLAN  
NO.  
SUPERVISOR AGRIS ROZITE  
RESIDENT CHARLES H. GEURTS  
CONTRACTOR ELMSTAR ELECTRIC  
COMPLETED 8-9-94

00-13

ACCEPTED FOR  
OUTAGAMIE COUNTY  
11/30/93 Mehal Johnson  
DATE SIGNATURE

ORIGINAL PLANS PREPARED BY  
McMAHON ASSOCIATES INC.

WISCONSIN  
PROFESSIONAL ENGINEER  
MICHAEL ROBERT MCMAHON  
E-25850 MENASHA WIS.  
11/30/93 Mehal Johnson  
DATE SIGNATURE

STATE OF WISCONSIN  
DEPARTMENT OF TRANSPORTATION

PREPARED BY

SURVEYOR	McMAHON ASSOCIATES, INC.
DESIGNER	McMAHON ASSOCIATES, INC.
DISTRICT EXAMINER	D.H. CARLSON
DISTRICT SUPERVISOR	J.C. LAMERS
PROJ. DEV. ENGINEER	
C.O. EXAMINER	Ron Calkins

APPROVED FOR DISTRICT OFFICE  
DATE: 12-20-93 James Lamers  
SIGNATURE

00-13

00-13


00-13

STATE PROJECT NUMBER	SHEET NO.
4677-06-71	2.0
GENERAL NOTES, STANDARD ABBREVIATIONS AND SYMBOLS, SDD NUMBERS, AND UTILITIES	

STANDARD ABBREVIATIONS  
AND SYMBOLS

ANGLE	MAX	MAXIMUM
AGG.	MIN	MINIMUM
AH	N	NORTH
ASPH	NC	NORMAL CROWN
AVE.	NO.	NUMBER
BK	NOR.	NORMAL
B.M.	P.E.	PRIVATE ENTRANCE
BIT.	P.C.	POINT OF CURVATURE
B.O.W.	P.I.	POINT OF INTERSECTION
C.E.	P.O.L.	POINT ON LINE
C.A.B.C.	P.T.	POINT OF TANGENCY
or CL	P.V.I.	POINT OF VERTICAL CURVATURE
CB	P.V.T.	POINT OF VERTICAL INTERSECTION
CONC.	PB	POINT OF VERTICAL TANGENCY
C.M.C.P.	PED.	PEDESTAL
C.T.H.	PVC	PAVEMENT
CL.	P/L	PROPERTY LINE
CT.	PVC	PAVEMENT
CU.YD.	R	RADIUS
D.	R.C.C.	REINFORCED CONCRETE CULVERT PIPE
D.G.	REQ'D	REQUIRED
E.	R/L	REFERENCE LINE
ELEV.	R/W	RIGHT OF WAY
EXIST.	RD.	ROAD
EXP.	RDWY	ROADWAY
F.F.	RT.	RIGHT
FL	S	SLOPE
FOOT PER FOOT	S.	SOUTH
GV	S.D.D.	STANDARD DETAIL DRAWING
H.	SB	SIGNAL BASE
HYD.	SE	SUPERELEVATION RATE
INL.	ST.	STREET
INV.	STA.	STATION
JT.	S.T.H.	STATE TRUNK HIGHWAY
L.	SQ. FT.	SQUARE FEET
L.H.F.	SQ. YD.	SQUARE YARD
L.S.	STA.	STATION
LA.	S.W.	SIDEWALK
LIN. FT.	T	TANGENT LENGTH OF CURVE
L.V.C.	TRANS-PAD	TRANSFORMER PAD
LT.	T/L	TRANSIT LINE
MH	TYP.	TYPICAL
DW	V.C.	VERTICAL CURVE
FDW	W	WALK
R	WV	WATER VALVE/SHUTOFF
Y		
G		
FR		
FY		

Q- HYDRANT W/AUXILIARY VALVE  
●- LIGHT POLE

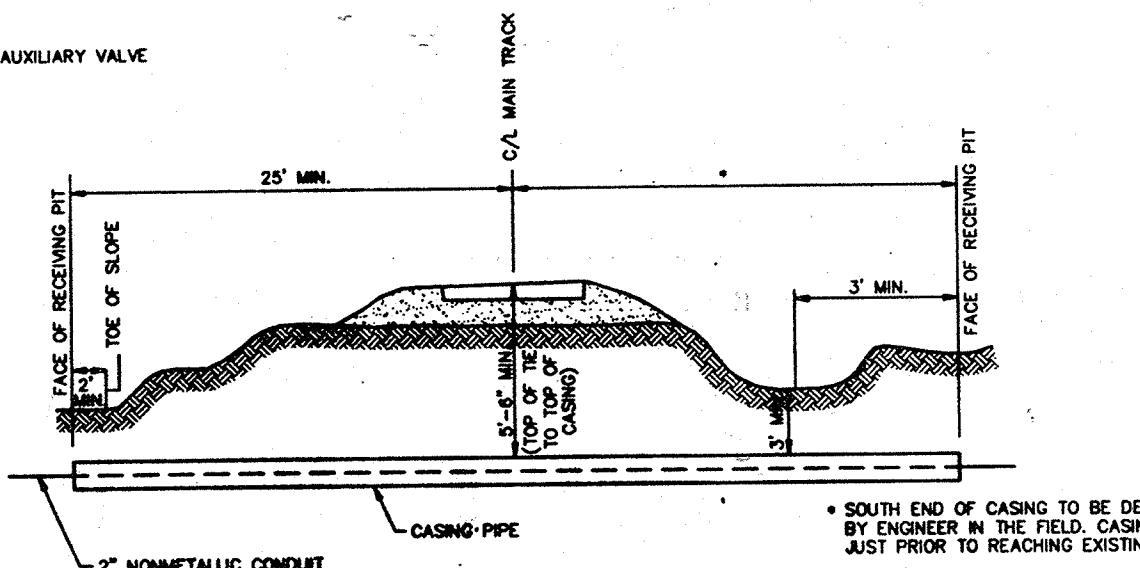

ALL MINIMUM DIMENSIONS MEASURED NORMAL TO C/L OF OUTSIDE TRACK

TYPICAL RAILROAD CROSSING DETAIL

GENERAL NOTES

WHEN THE QUANTITY OF CRUSHED AGGREGATE BASE COURSE, AND ASPHALTIC CONCRETE PAVEMENT, TYPE MV IS MEASURED FOR PAYMENT BY THE TON, THE THICKNESS AS SHOWN ON THE PLAN IS APPROXIMATE AND THE ACTUAL THICKNESS WILL DEPEND UPON THE DISTRIBUTION OF THE MATERIAL AS DIRECTED BY THE ENGINEER IN THE FIELD.

THE LOCATIONS OF EXISTING AND PROPOSED UTILITY FACILITIES AS SHOWN ON THE PLAN ARE APPROXIMATE. THERE MAY BE OTHER UTILITY FACILITIES WITHIN THE PROJECT AREA THAT ARE NOT SHOWN.

CURB AND GUTTER RADII ARE SHOWN TO THE BACK OF CURB.

ALL DISTURBED AREAS WITHIN THE RIGHT OF WAY SHALL BE TOPSOILED, FERTILIZED, SEEDED AND MULCHED.

AN AGREEMENT HAS BEEN OBTAINED FROM THE RAILROAD TO INSTALL THE CABLE CROSSING UNDER THE TRACKS.

UTILITIES / RAILROADS

AMERITECH (414) 735-3246  
MR. RICK VAN BEEK  
4 EAST OSPE  
221 WEST WASHINGTON  
P.O. BOX 2159  
APPLETON, WI 54913  
CABLE LOCATE (TOLL FREE)  
1-800-242-2511

WISCONSIN GAS COMPANY (414) 766-3551  
MR. LYLE NEUHAUSE  
601 W. NORTH STREET  
LITTLE CHUTE, WI 54140

CITY OF KAUKAUNA (414) 734-1411  
ELECTRIC DEPT.  
MR. GARY WOLF  
777 ISLAND ST.  
KAUKAUNA, WI 54915



CABLEVISION OF THE FOX CITIES (414) 749-1320  
MR. RANDY HAUGESTUEN  
1001 KENNEDY AVENUE  
KIMBERLY, WI 54136


VILLAGE OF LITTLE CHUTE (414) 788-7395  
DEPT. OF PUBLIC WORKS  
MR. GENE HOJAN  
1940 BUCHANAN ST.  
LITTLE CHUTE, WI 54140  
(TOLL FREE)  
1-800-242-8511

DIGGERS HOTLINE  
WISCONSIN CENTRAL LTD./ (715) 345-2580  
FOX VALLEY AND WESTERN RAILROAD  
CHIEF ENGINEER & SIGNAL COMMUNICATIONS  
MR. JOHN LAMZ  
1625 DEPOT STREET  
P.O. BOX 348  
STEVENS POINT, WI 54481

STANDARD DETAIL DRAWINGS

SDD No.	TITLE
8D1-11	CONCRETE CURB, CONCRETE CURB AND GUTTER AND PAVEMENT TIES
8D5-8	CURB RAMPS
9B2-5	CONDUIT
9B4-1	PULL BOX
9C2-1	CONCRETE BASES
9C3-1	CAST BASES
9C5-1	CONCRETE CONTROL CABINET BASES
9D1-1	CABINET SERVICE INSTALLATION
9D2-1	SIGNAL OR LIGHTING CONTROL CABINET
9E1-1a	POLE MOUNTINGS FOR TRAFFIC SIGNALS, TYPE 2
9E1-1b	HARDWARE DETAILS FOR POLE MOUNTINGS
9F8-1	LOOP DETECTOR PLACED IN CRUSHED AGGREGATE BASE (NEW ASPHALTIC PAVEMENT)
9F9-1	LOOP DETECTOR PLACED IN CRUSHED AGGREGATE BASE (NEW CONCRETE PAVEMENT)
15C8-5a	PAVEMENT MARKING (MAINLINE AND INTERSECTIONS)
15C9-2	PAVEMENT MARKING DETAILS FOR RAILROAD-HIGHWAY GRADE CROSSINGS
15C9-5c	PAVEMENT MARKING (STOPLINES & CROSS WALKS)

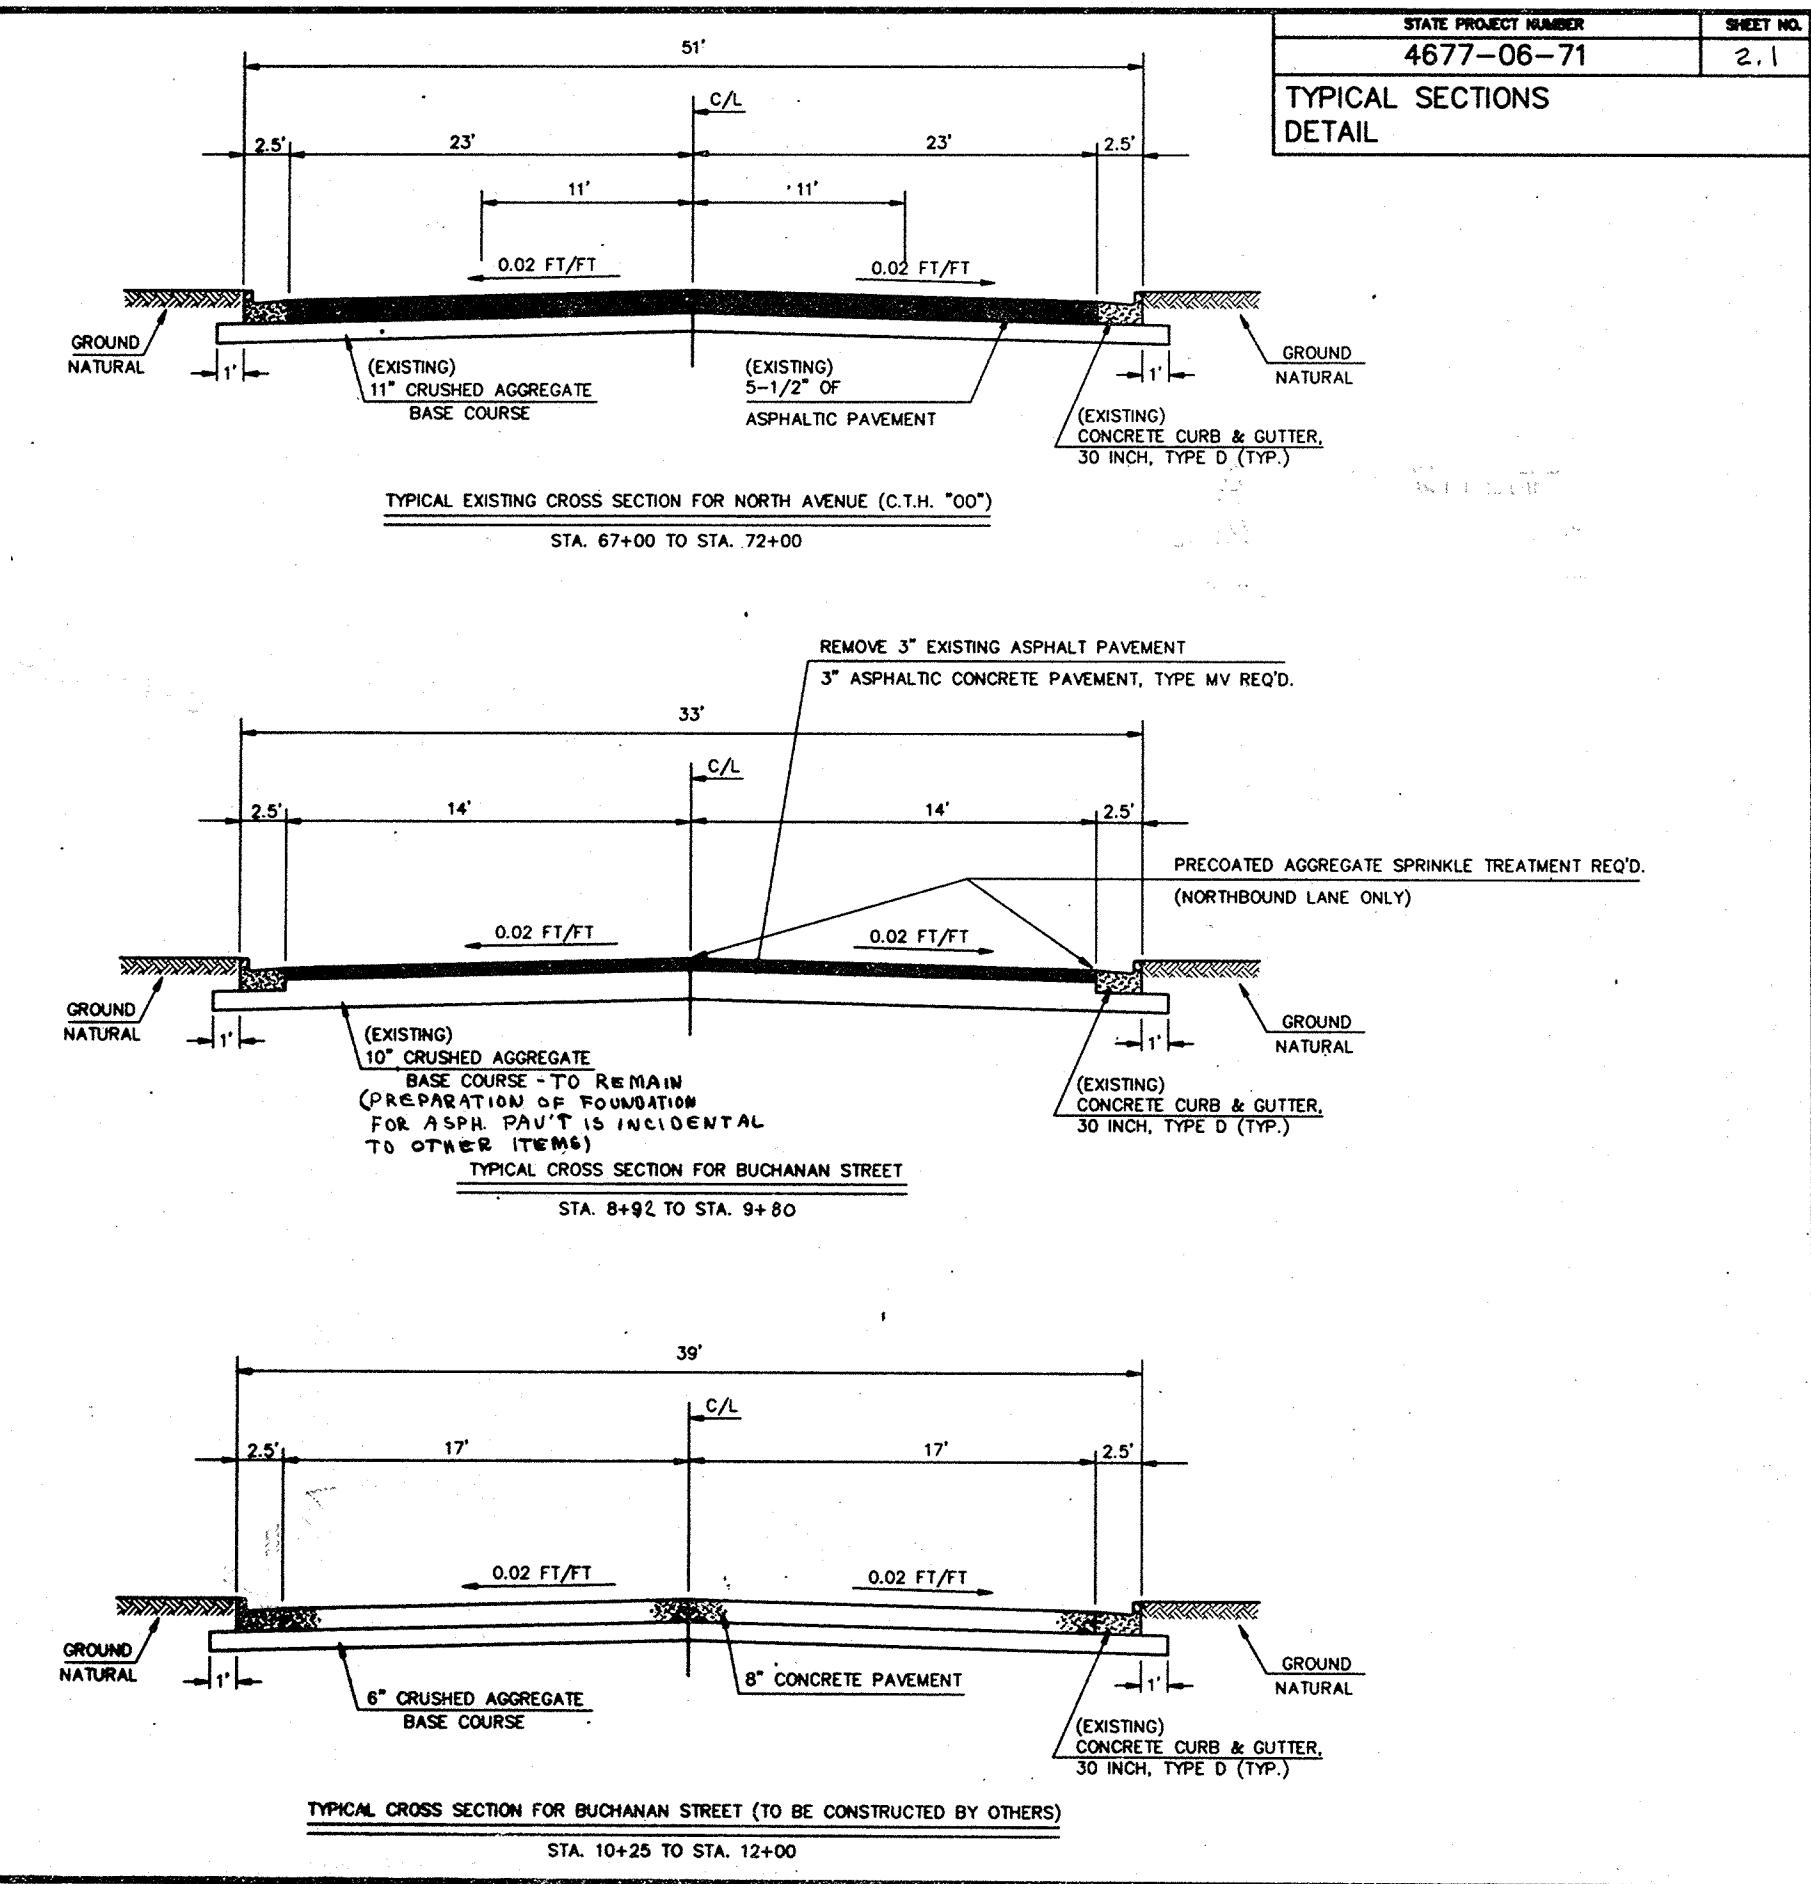
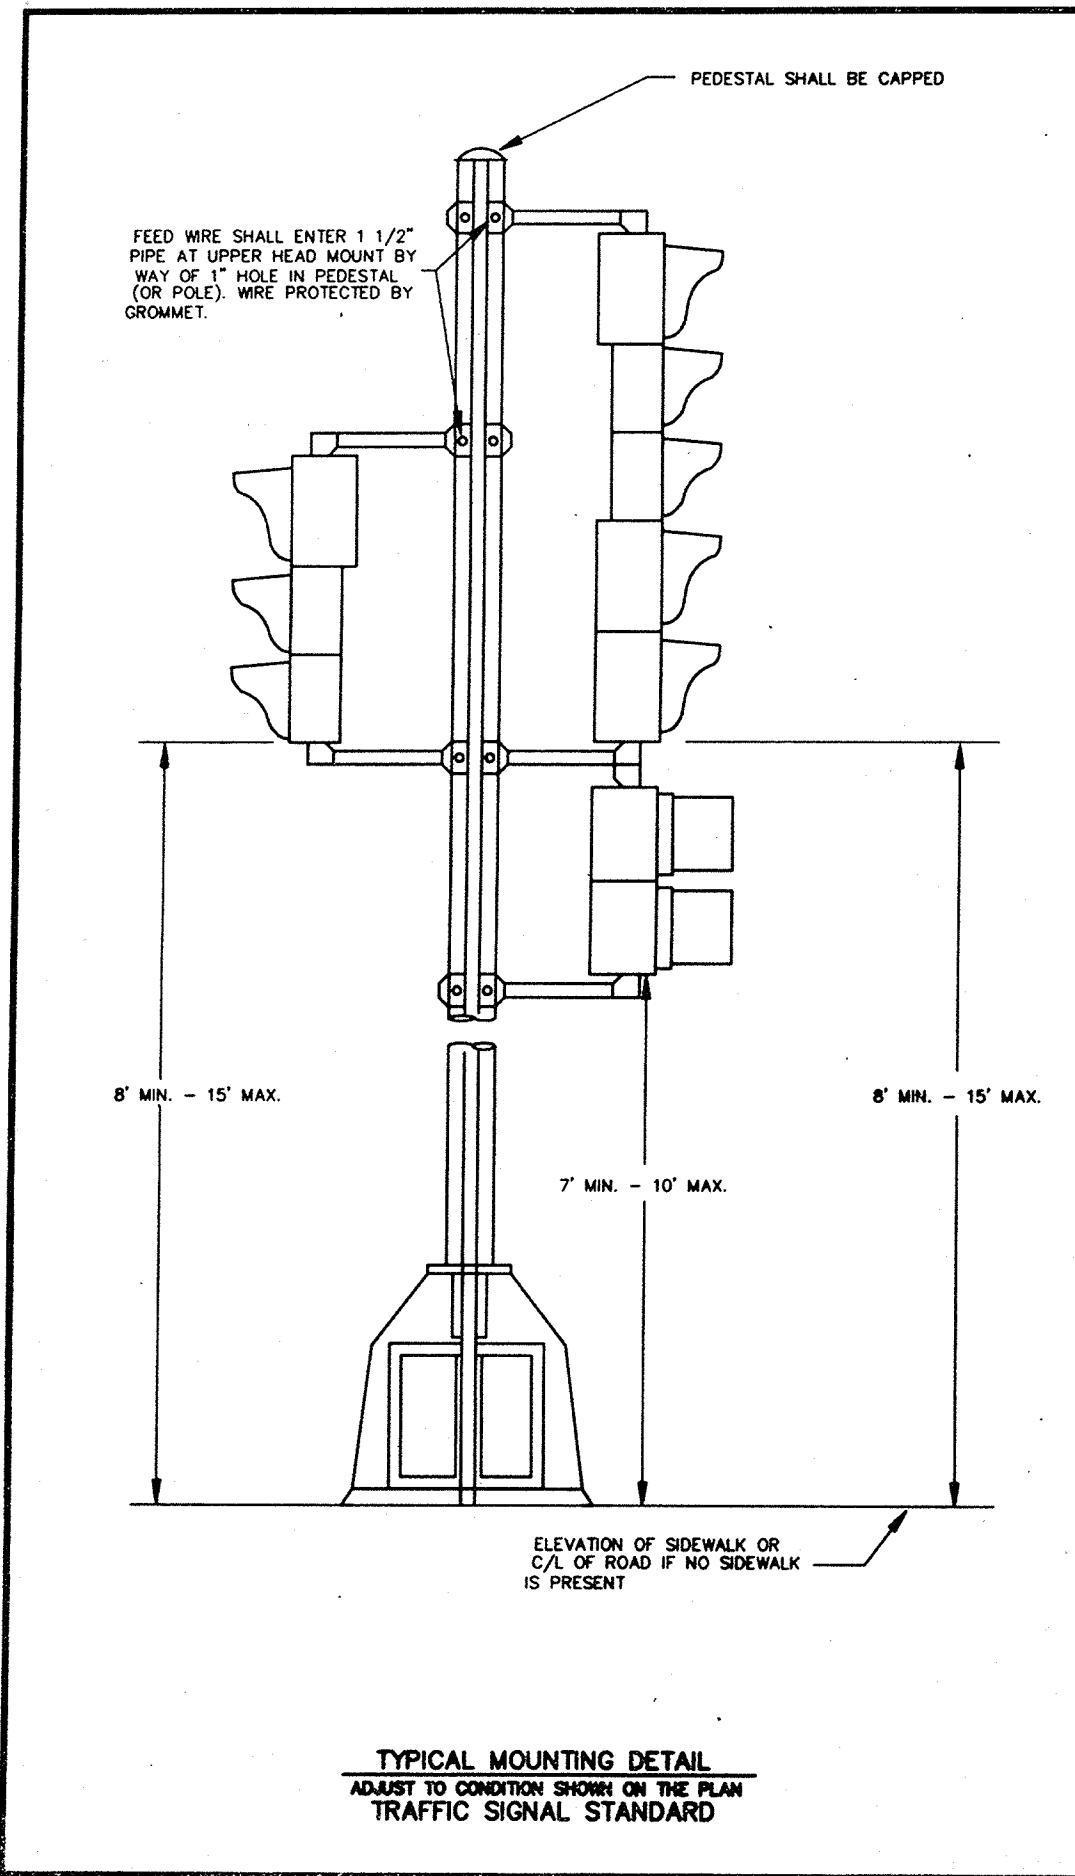


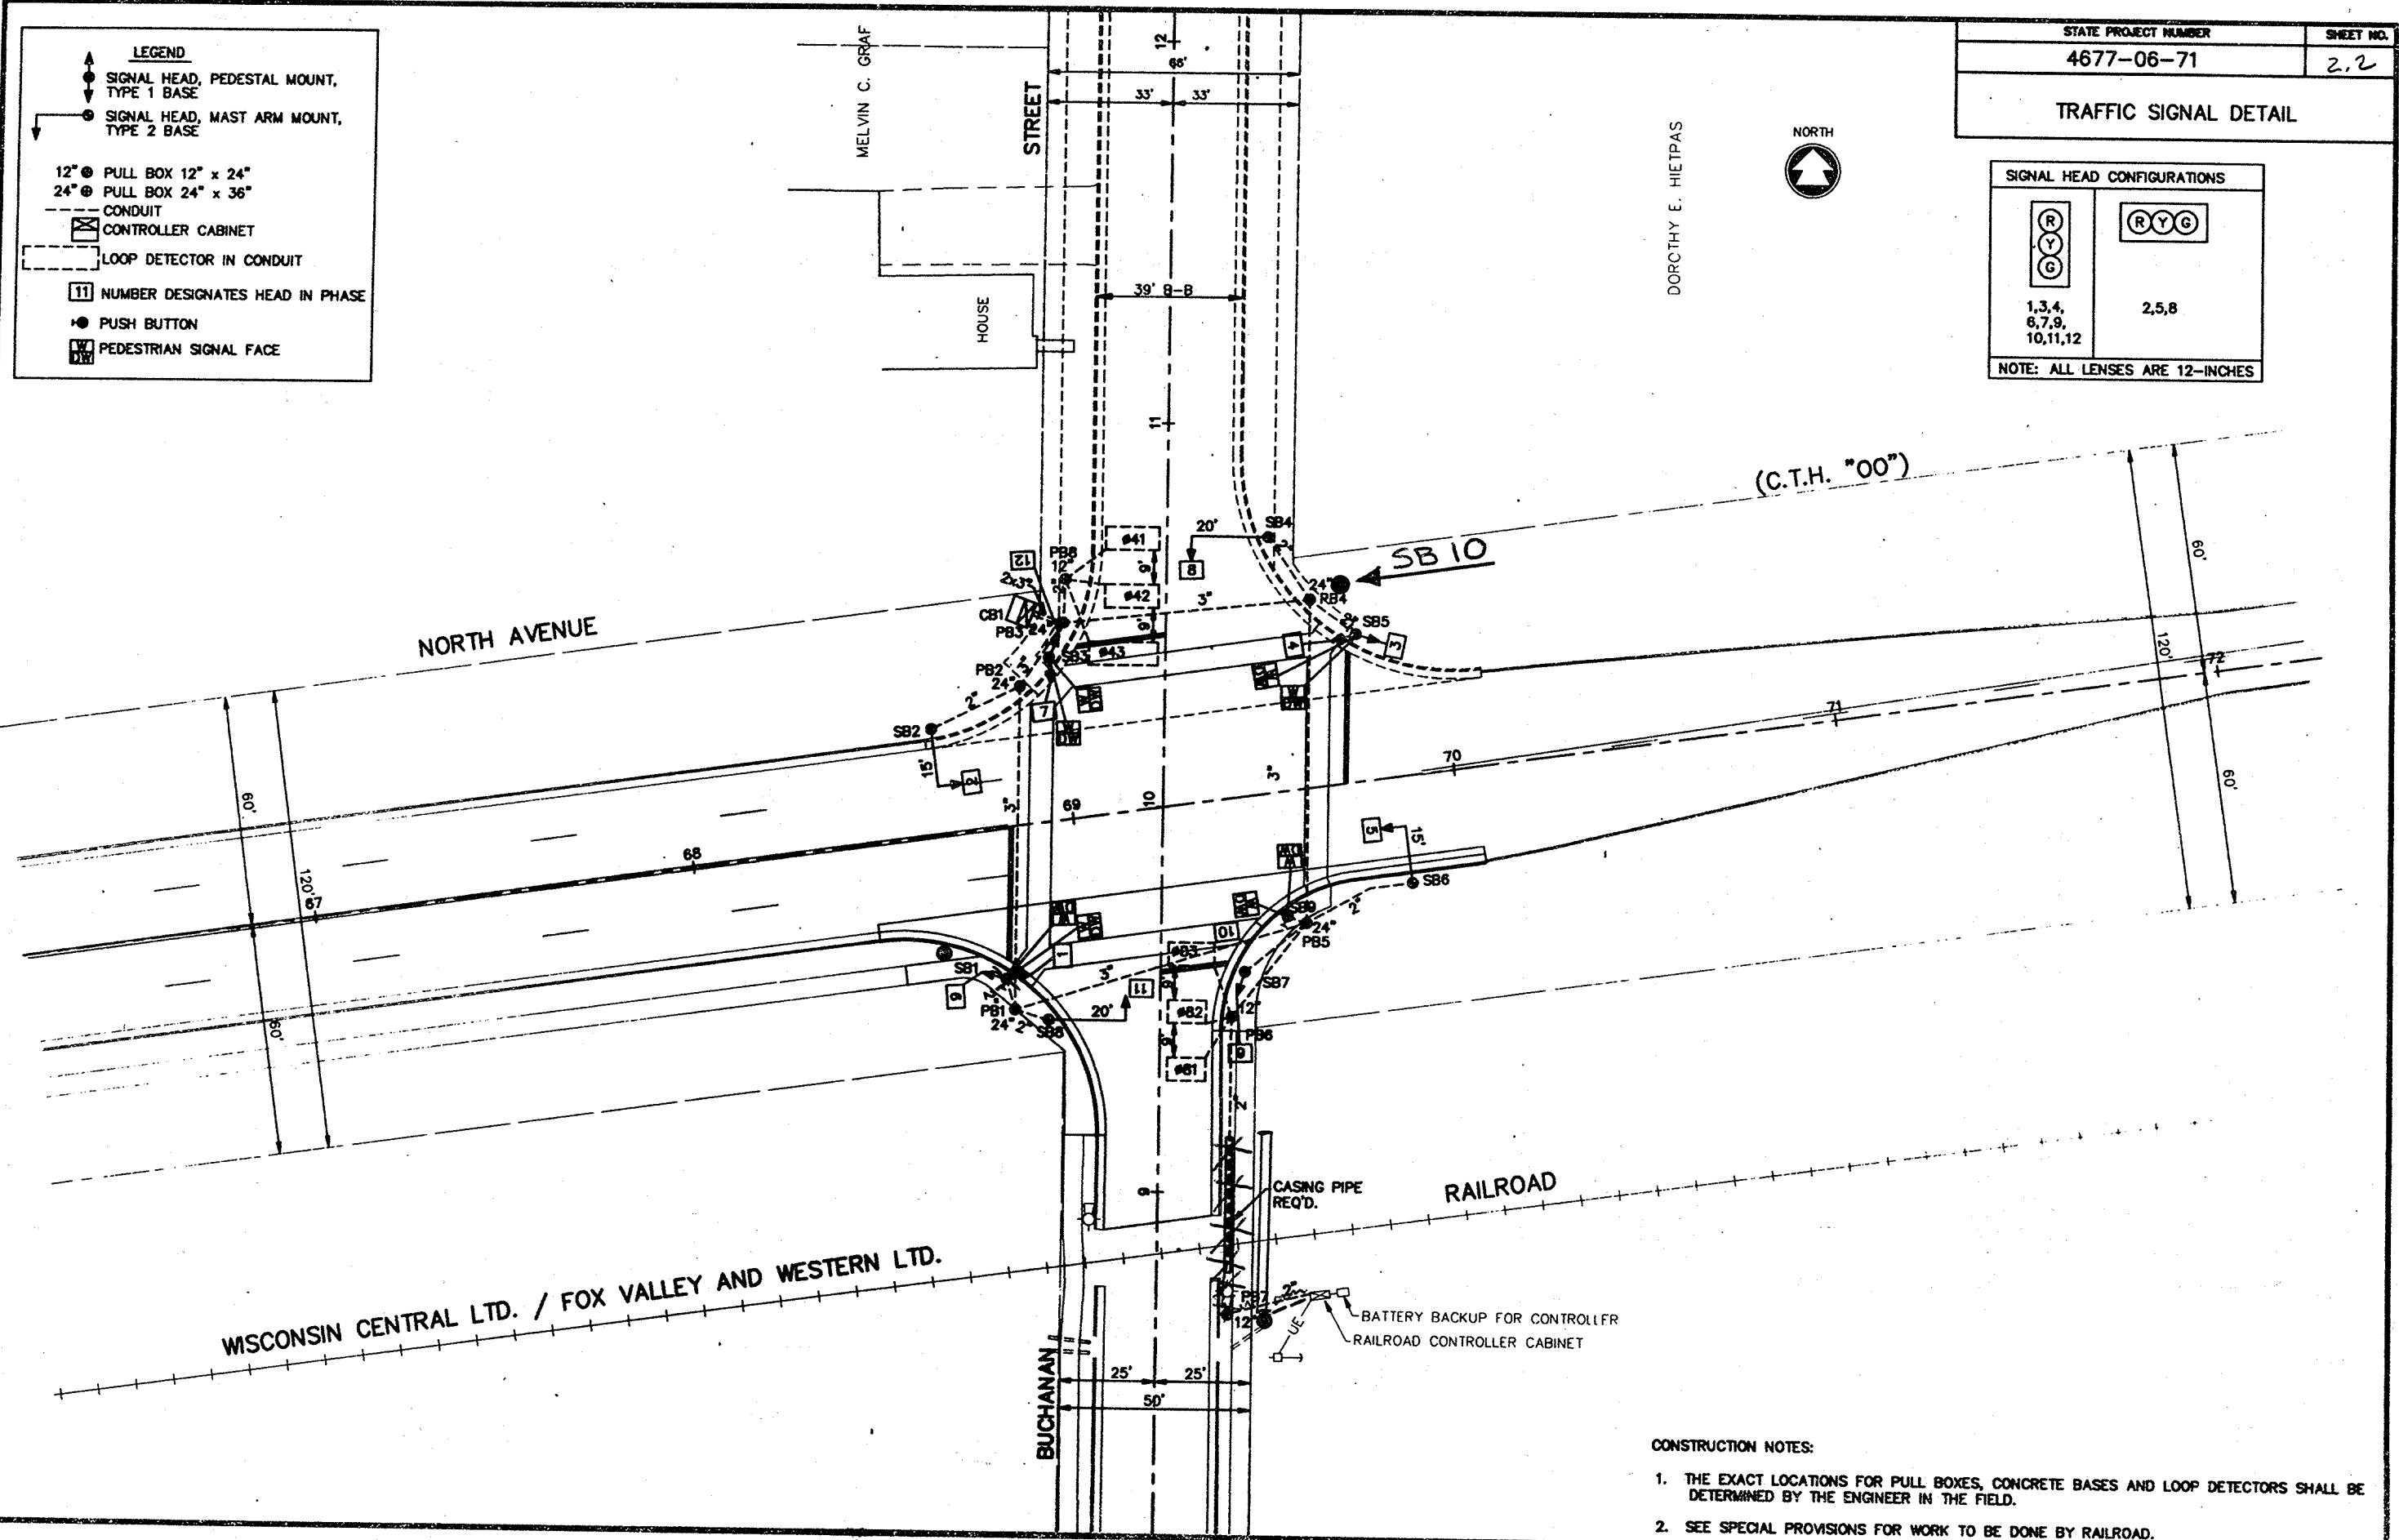

## DETECTOR LOGIC

STATE PROJECT NUMBER	sheet no.
4677-06-71	2.3
SEQUENCE OF OPERATIONS	

## SEQUENCE OF OPERATION

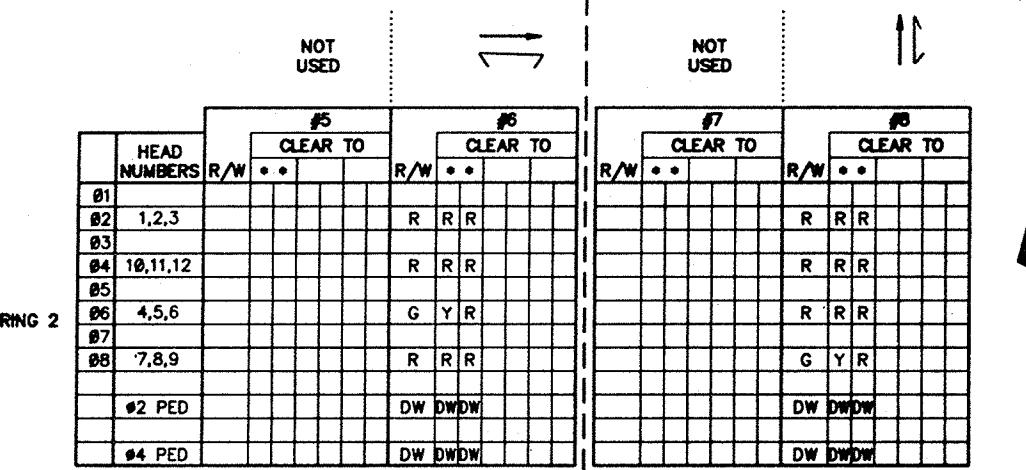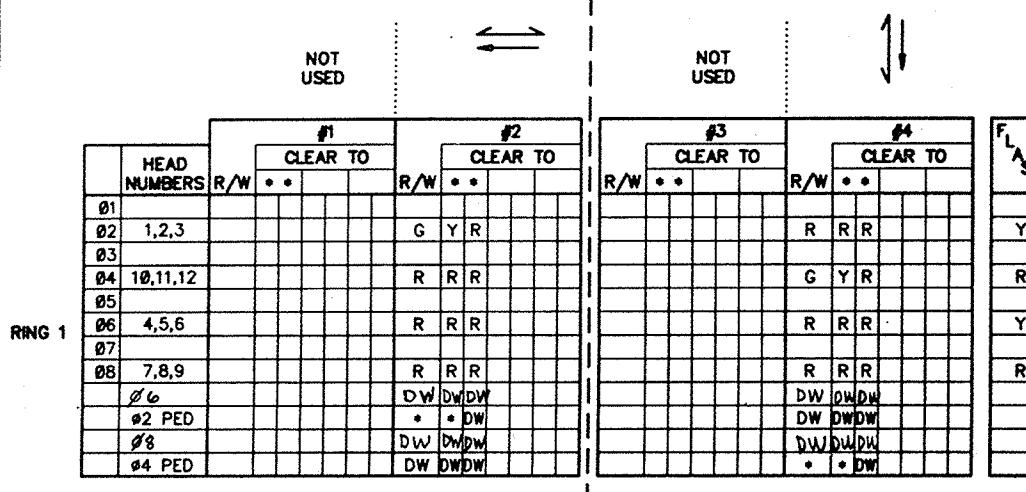

- \* WHEN CALLED TIMED STEADY WALK, FOLLOWED BY FLASHING DON'T WALK, THEN STEADY DON'T WALK
- \*\* CLEARANCE TO A PHASE IN CONFLICT WITH THIS PHASE ON (SEE CHART 1 BELOW)

## CHART 1


PHASE ON	NON-CONFLICTING PHASE ALLOWED TO TIME CONCURRENTLY	PHASES IN CONFLICT WITH PHASE ON
91		
92	6	4,8
93		
94	8	2,6
95		
96	2	4,8
97		
98	4	2,6

## CONTROLLER LOGIC

PHASE NUMBER	PHASE LOCKING	DUAL ENTRY W / Ø	PHASE RECALL
1			
2	X	W / 6	X
3			
4		W / 8	
5			
6	X	W / 2	X
7			
8		W / 4	

## OVERLAPS

**NONE**

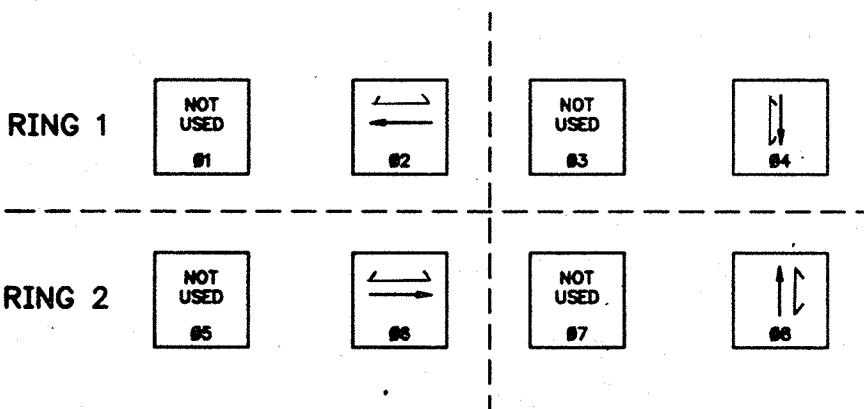

## BARRIER

TYPE OF INTERCONNECT		TYPE OF PRE-EMPT		TYPE OF LIGHTING	
NONE	X	NONE		NONE	
TBC		RAILROAD	X	IN TRAFFIC CONTROL CABINET	
CLOSED LOOP		EMERGENCY VEHICLE		IN SEPARATE CONTROL CABINET	
HARDWIRE					
TONE (FREQ)					


NOTES:

1. ANY ACTUATED PHASE FOR WHICH THERE IS NO CALL SHALL BE SKIPPED.
2. WHEN ONE PHASE IS ON ALONE, ANY NON-CONFLICTING PHASE MAY START TIMING CONCURRENTLY WITHOUT A CLEARANCE INTERVAL (SEE CHART 1 AT LEFT).
3. IF ANY OPPPOSING THRU PHASES ARE TIMING CONCURRENTLY, THEY SHALL TERMINATE TOGETHER DUE TO PERMISSIVE LEFT TURN CONFLICT.
4. WHEN A CALL FOR RAILROAD PREEMPTION IS RECEIVED:
  - A. ANY GREEN INTERVAL IN EFFECT SHALL TIME A MINIMUM 7 SECOND DURATION BEFORE ENTERING THE PREEMPT SEQUENCE. ELAPSED GREEN TIME PRIOR TO THE PREEMPT CALL SHALL BE CONSIDERED IN THE MINIMUM TIME.
  - B. ANY CLEARANCE INTERVAL IN EFFECT SHALL TIME ITS FULL NORMAL DURATION BEFORE ENTERING THE PREEMPT SEQUENCE.
5. UPON R.R. PREEMPTION SIGNAL SHOULD CLEAR TO #8, CLEAR #8, THEN GO TO A FLASH YELLOW ON C.T.H. "00" (#2 & #8) AND A FLASH RED ON BUCHANAN ST. (#4 & #8), AFTER R.R. PREEMPTION SIGNALS SHOULD GO TO A STEADY YELLOW ON C.T.H. "00", (#2 & #8) AND A STEADY RED ON BUCHANAN ST. (#4 & #8). NORMAL PHASING SHALL RESUME IN #4 & #8 SUBSEQUENT TO TERMINATION OF RAILROAD PREEMPTION.
6. TIMINGS TO BE OBTAINED FROM VILLAGE OF LITTLE CHUTE DIRECTOR OF PUBLIC WORKS

NORTH AVENUE (CTH "OO") AT BUCHANAN STREET	
OUTAGAMIE CO.	
SIGNAL NO.	
DATE	SHEET NO. OF

STATE PROJECT NUMBER **4677-06-71** SHEET NO. **2.4**

**PAVEMENT MARKINGS DETAIL**


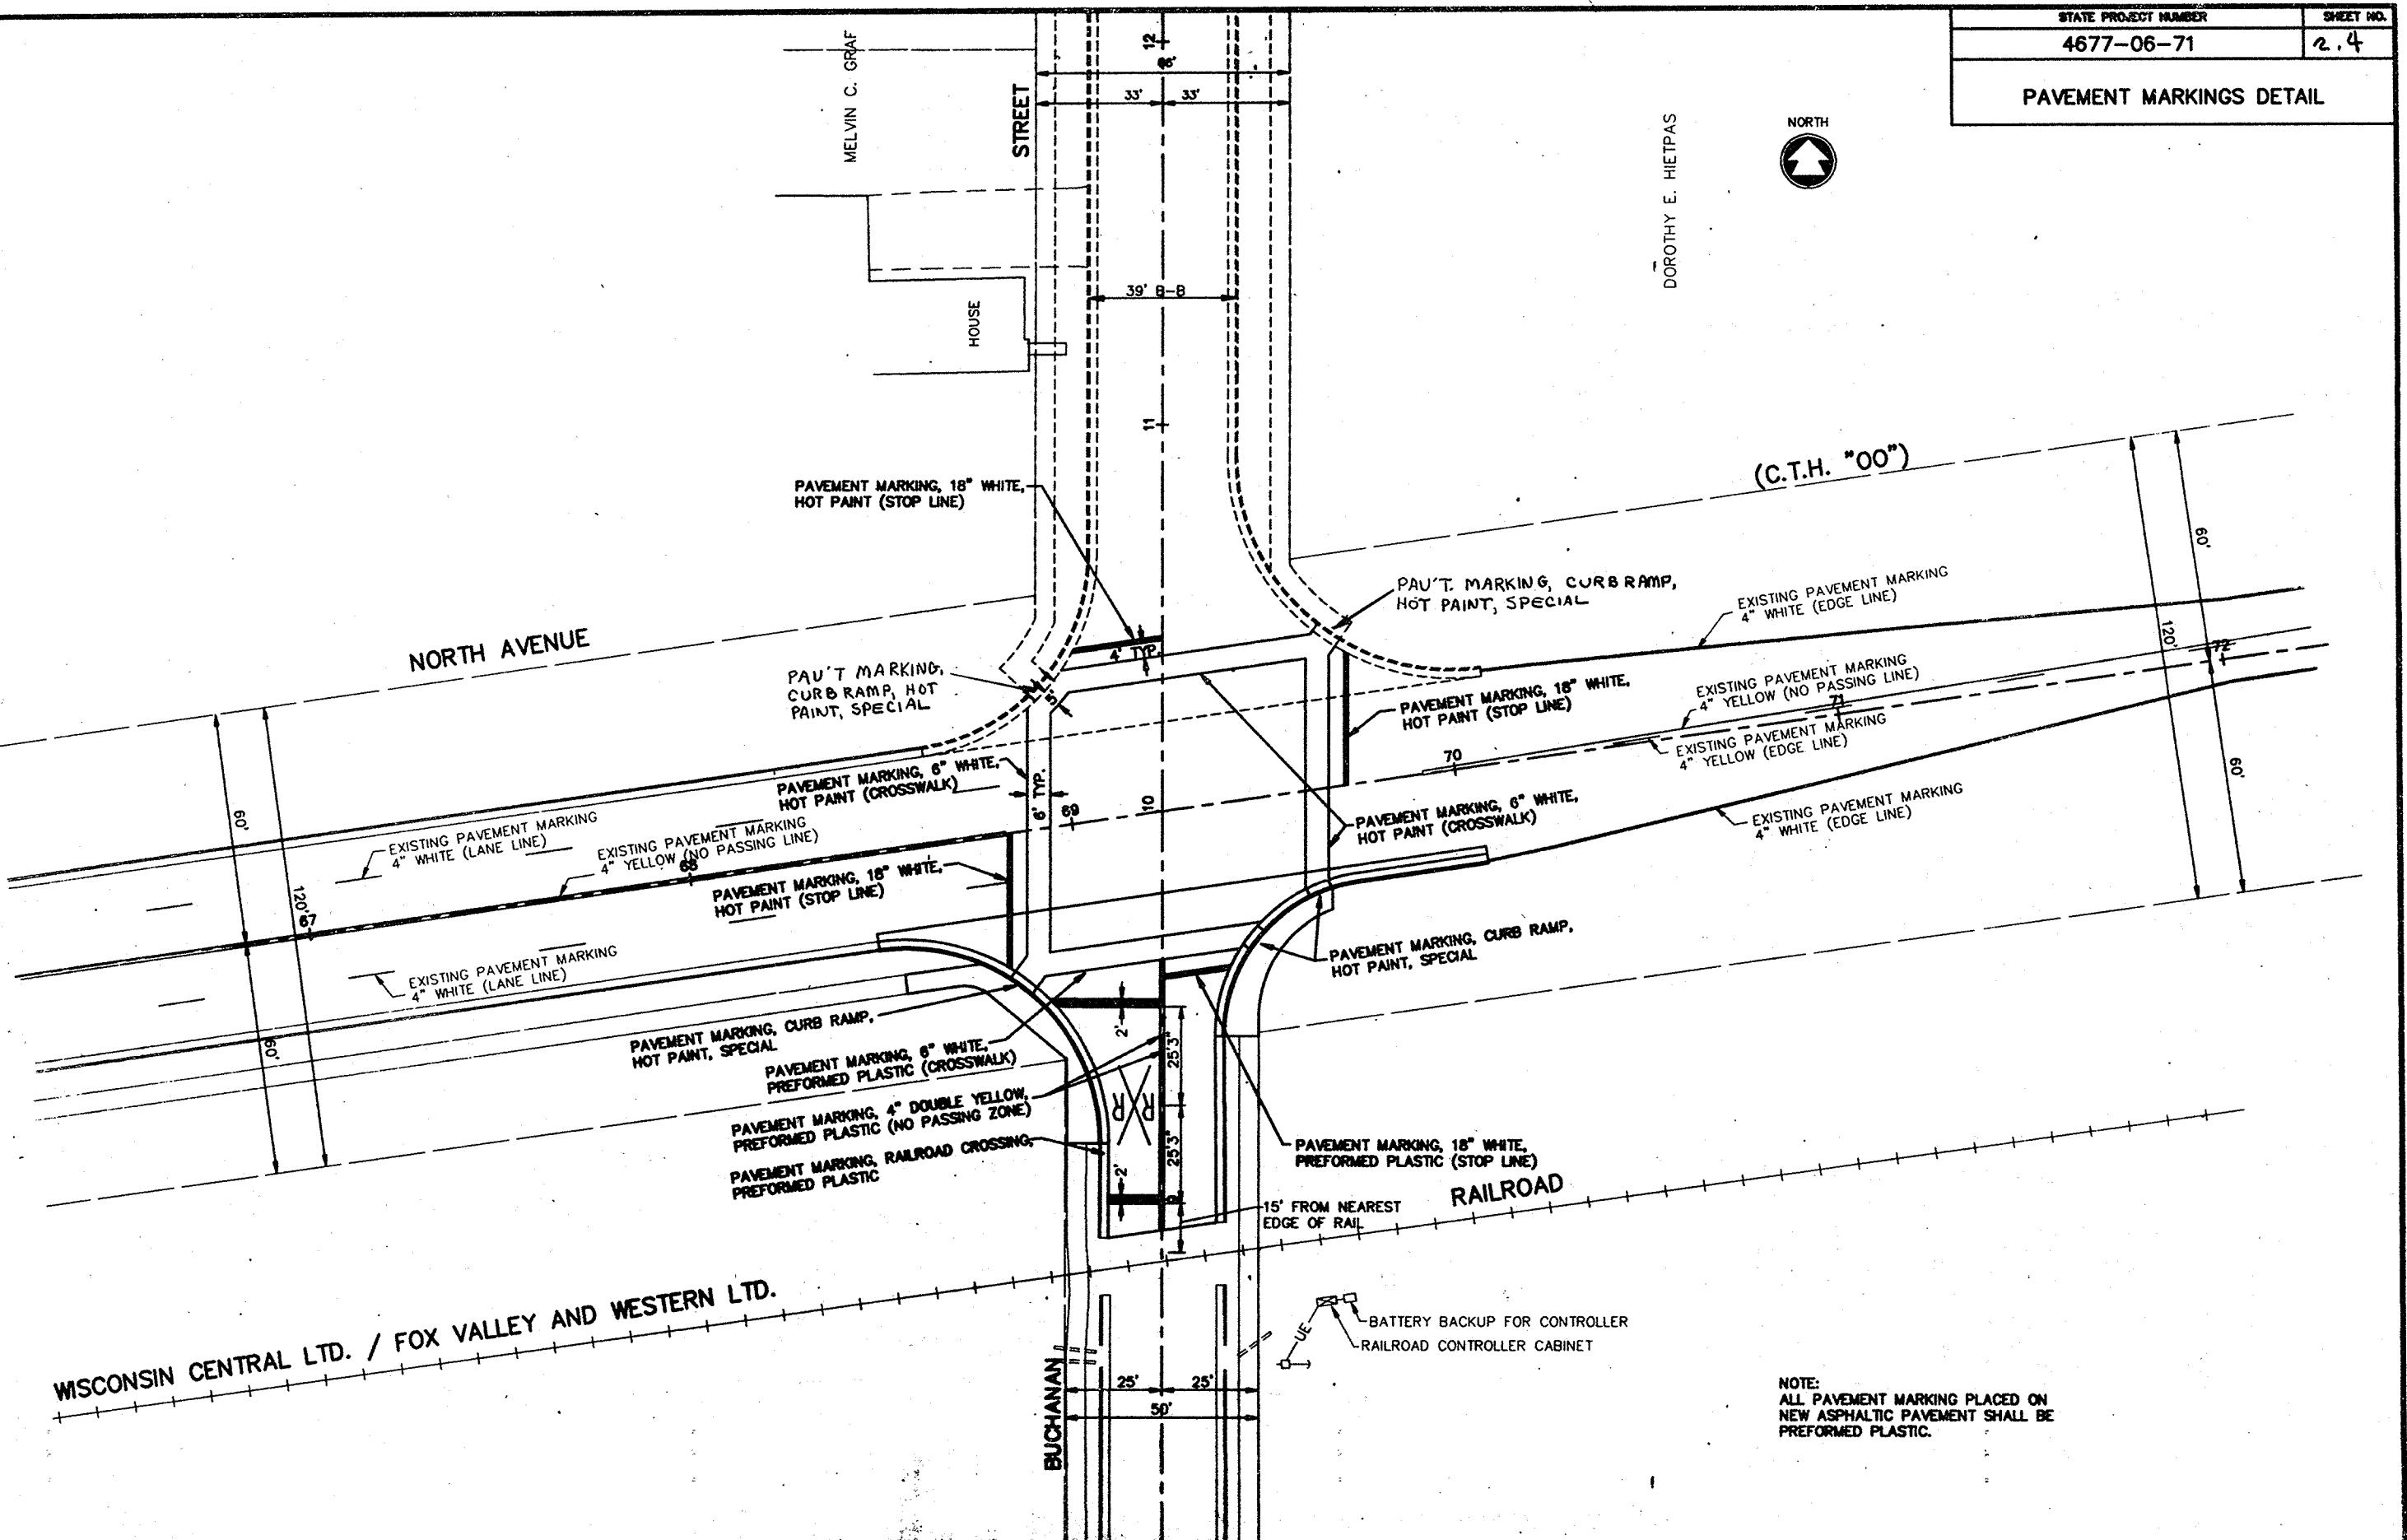


STATE PROJECT NUMBER	SHEET NO.
4677-06-71	2,3

## DETECTOR LOGIC

## SEQUENCE OF OPERATIONS

## SEQUENCE OF OPERATION

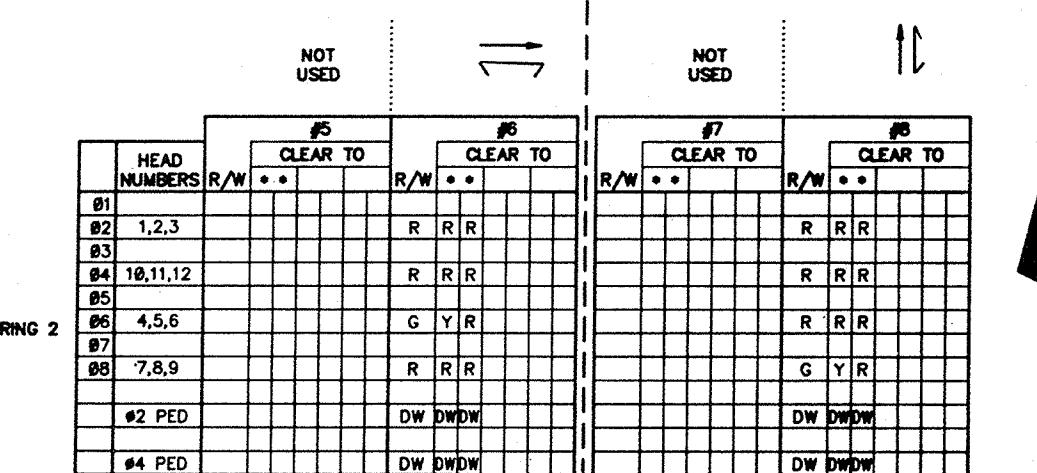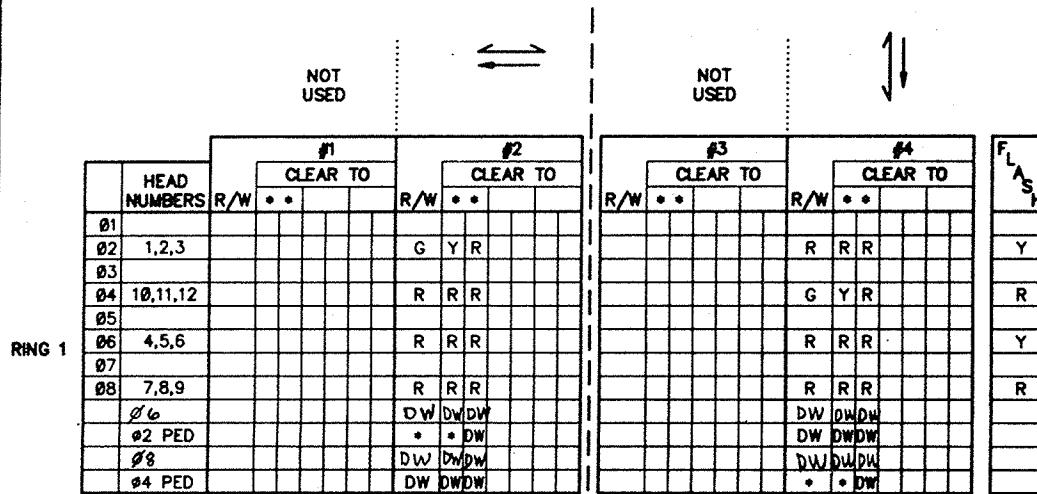

- WHEN CALLED TIMED STEADY WALK, FOLLOWED BY FLASHING DON'T WALK, THEN STEADY DON'T WALK
- CLEARANCE TO A PHASE IN CONFLICT WITH THIS PHASE ON (SEE CHART 1 BELOW)


## CHART 1

PHASE ON	NON-CONFLICTING PHASE ALLOWED TO TIME CONCURRENTLY	PHASES IN CONFLICT WITH PHASE ON
91		
92	6	4,8
93		
94	8	2,6
95		
96	2	4,8
97		
98	4	2,6

## CONTROLLER LOGIC

PHASE NUMBER	PHASE LOCKING	DUAL ENTRY W / Ø	PHASE RECALL
1			
2	X	W / 6	X
3			
4		W / 8	
5			
6	X	W / 2	X
7			
8		W / 4	

## OVERLAPS

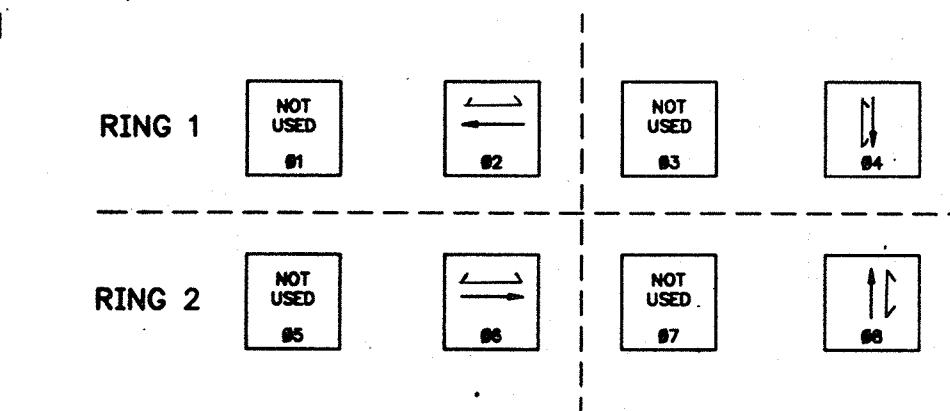

## BARRIER

TYPE OF INTERCONNECT	
NONE	X
TBC	
CLOSED LOOP	
HARDWIRE	
TONE (FREQ)	

TYPE OF PRE-EMPT
NONE
RAILROAD
EMERGENCY VEHICLE

TYPE OF LIGHTING
NONE
IN TRAFFIC CONTROL CABINET
IN SEPARATE CONTROL CABINET

NOTES:

1. ANY ACTUATED PHASE FOR WHICH THERE IS NO CALL SHALL BE SKIPPED.
2. WHEN ONE PHASE IS ON ALONE, ANY NON-CONFLICTING PHASE MAY START TIMING CONCURRENTLY WITHOUT A CLEARANCE INTERVAL (SEE CHART 1 AT LEFT).
3. IF ANY OPPPOSING THRU PHASES ARE TIMING CONCURRENTLY, THEY SHALL TERMINATE TOGETHER DUE TO PERMISSIVE LEFT TURN CONFLICT.
4. WHEN A CALL FOR RAILROAD PREEMPTION IS RECEIVED:
  - A. ANY GREEN INTERVAL IN EFFECT SHALL TIME A MINIMUM 7 SECOND DURATION BEFORE ENTERING THE PREEMPT SEQUENCE. ELAPSED GREEN TIME PRIOR TO THE PREEMPT CALL SHALL BE CONSIDERED IN THE MINIMUM TIME.
  - B. ANY CLEARANCE INTERVAL IN EFFECT SHALL TIME ITS FULL NORMAL DURATION BEFORE ENTERING THE PREEMPT SEQUENCE.
5. UPON R.R. PREEMPTION SIGNAL SHOULD CLEAR TO #8, CLEAR #8, THEN GO TO A FLASH YELLOW ON C.T.H. "00" (#2 & #8) AND A FLASH RED ON BUCHANAN ST. (#4 & #8), AFTER R.R. PREEMPTION SIGNALS SHOULD GO TO A STEADY YELLOW ON C.T.H. "00", (#2 & #8) AND A STEADY RED ON BUCHANAN ST. (#4 & #8). NORMAL PHASING SHALL RESUME IN #4 & #8 SUBSEQUENT TO TERMINATION OF RAILROAD PREEMPTION.
6. TIMINGS TO BE OBTAINED FROM VILLAGE OF LITTLE CHUTE DIRECTOR OF PUBLIC WORKS.

NORTH AVENUE (CTH "OO")  
AT BUCHANAN STREET

OUTAGAMIE CO

SIGNAL NO

SHEET NO. OF

DATE

DATE

MELVIN C. GRAF

STREET

HOUSE


STATE PROJECT NUMBER	SHEET NO.
4677-06-71	2.4

## PAVEMENT MARKINGS DETAIL




DOROTHY E. HIETPAS

(C.T.H. "00")

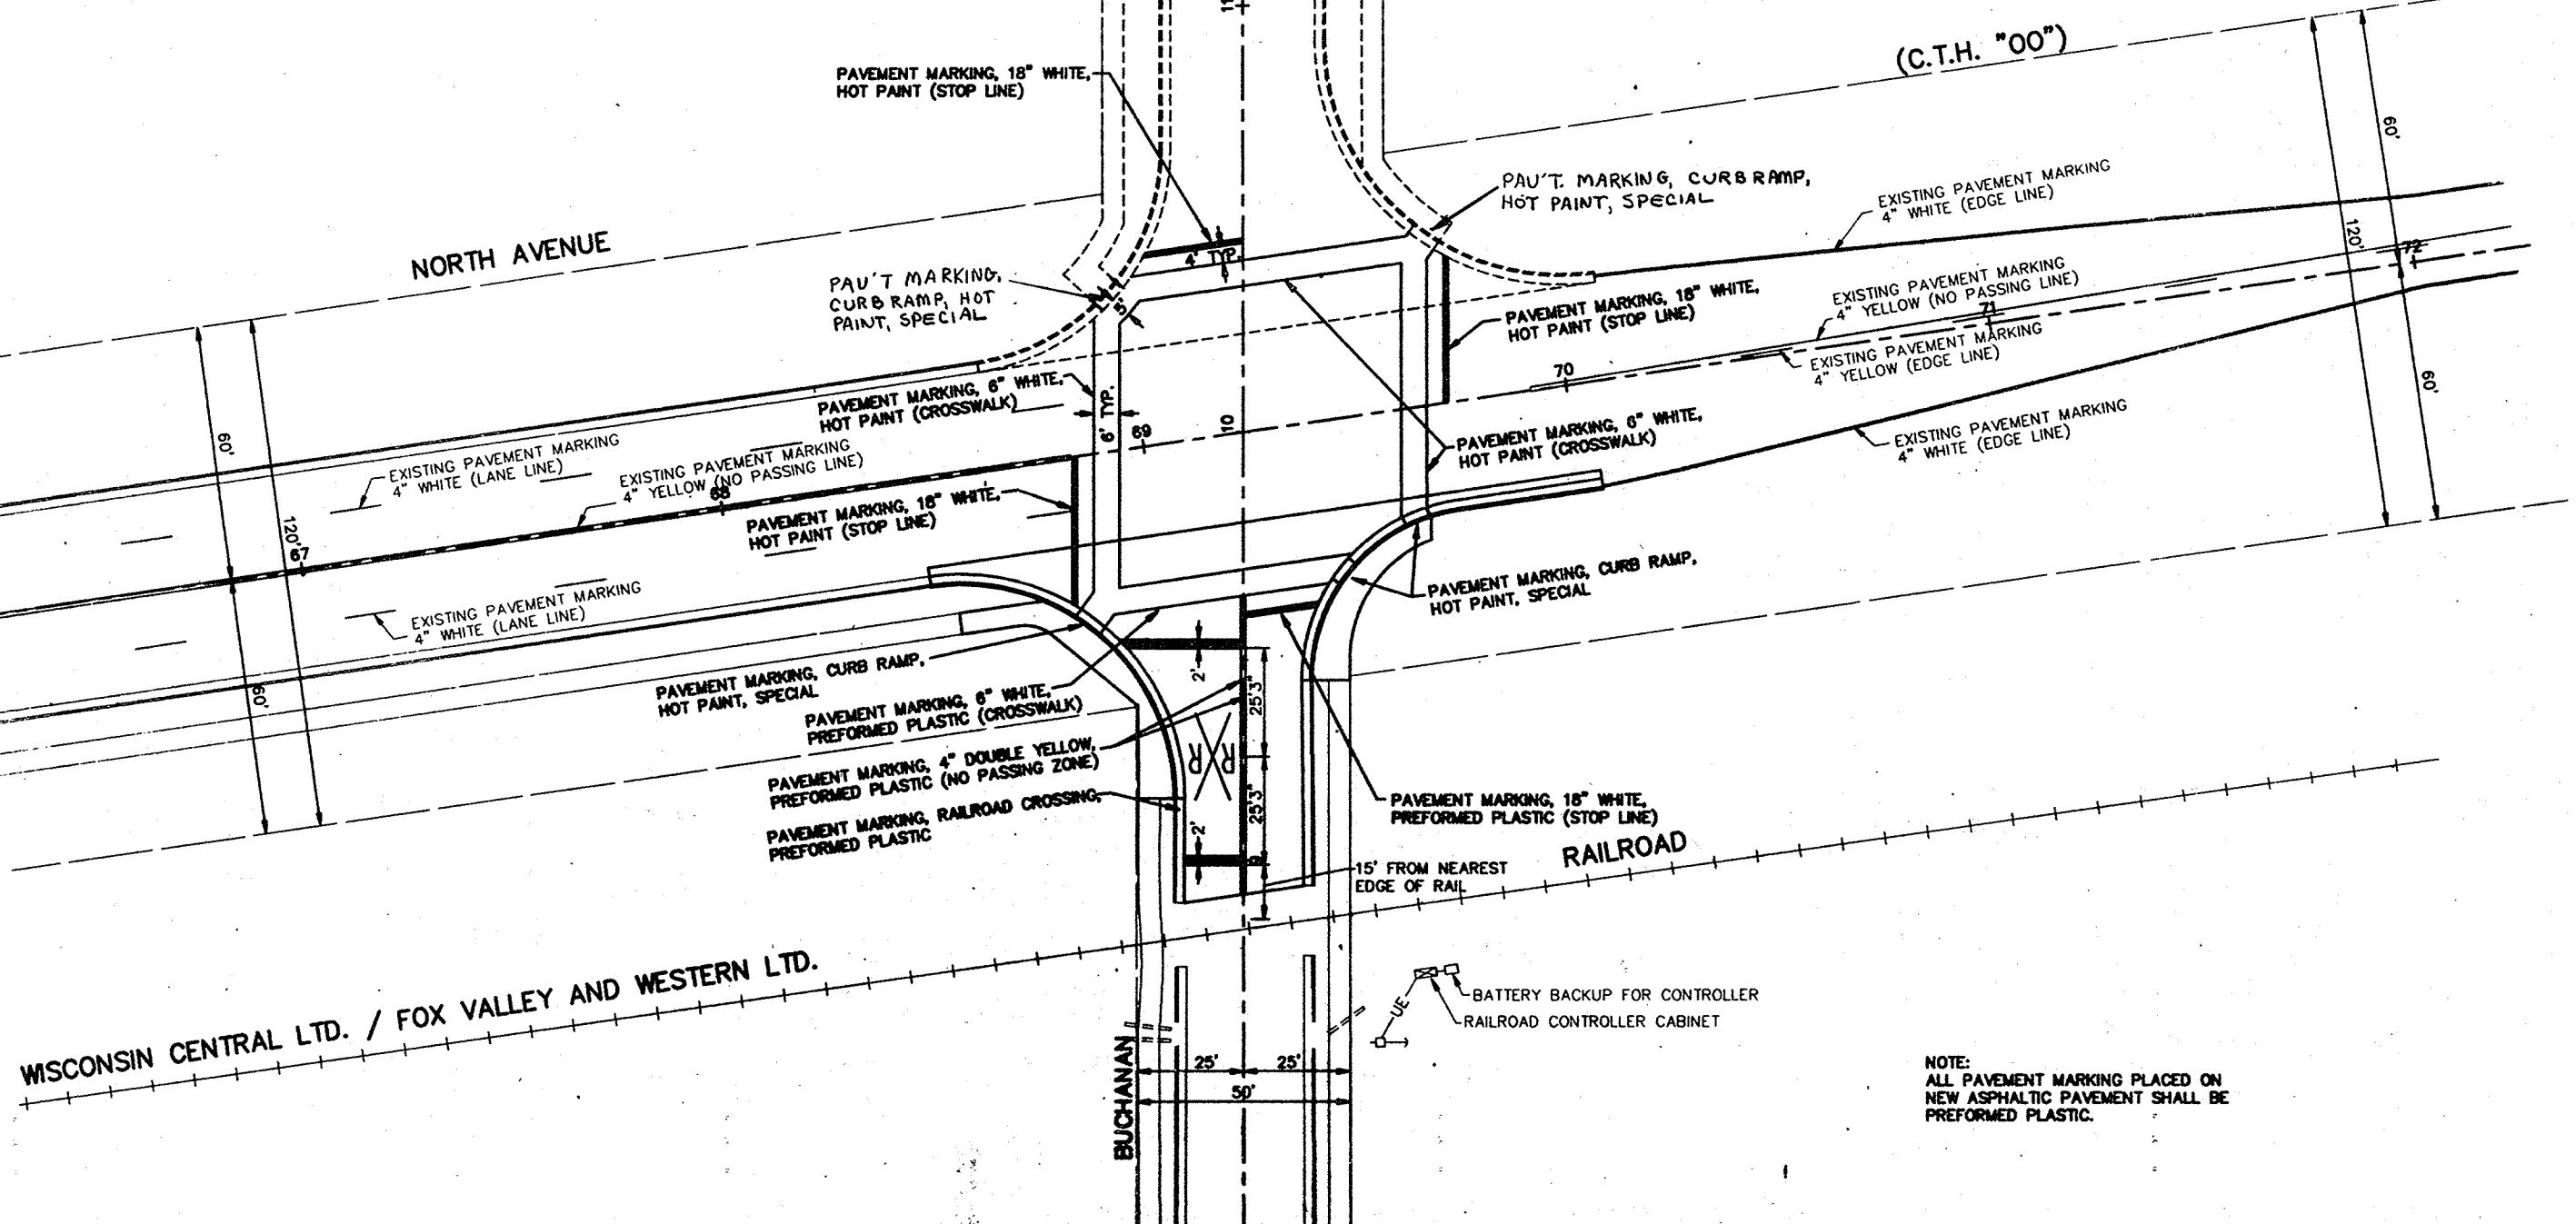

STATE PROJECT NUMBER	SHEET NO.
4677-06-71	2.5
TRAFFIC CONTROL DETAIL	
OUTAGAMIE CO.	

### SYMBOLS

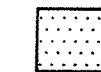


WORK AREA



FLAGGER, EQUIPPED WITH STOP/SLOW  
PADDLE FASTENED ON SUPPORT STAFF



SIGN ON PORTABLE OR  
PERMANENT SUPPORT

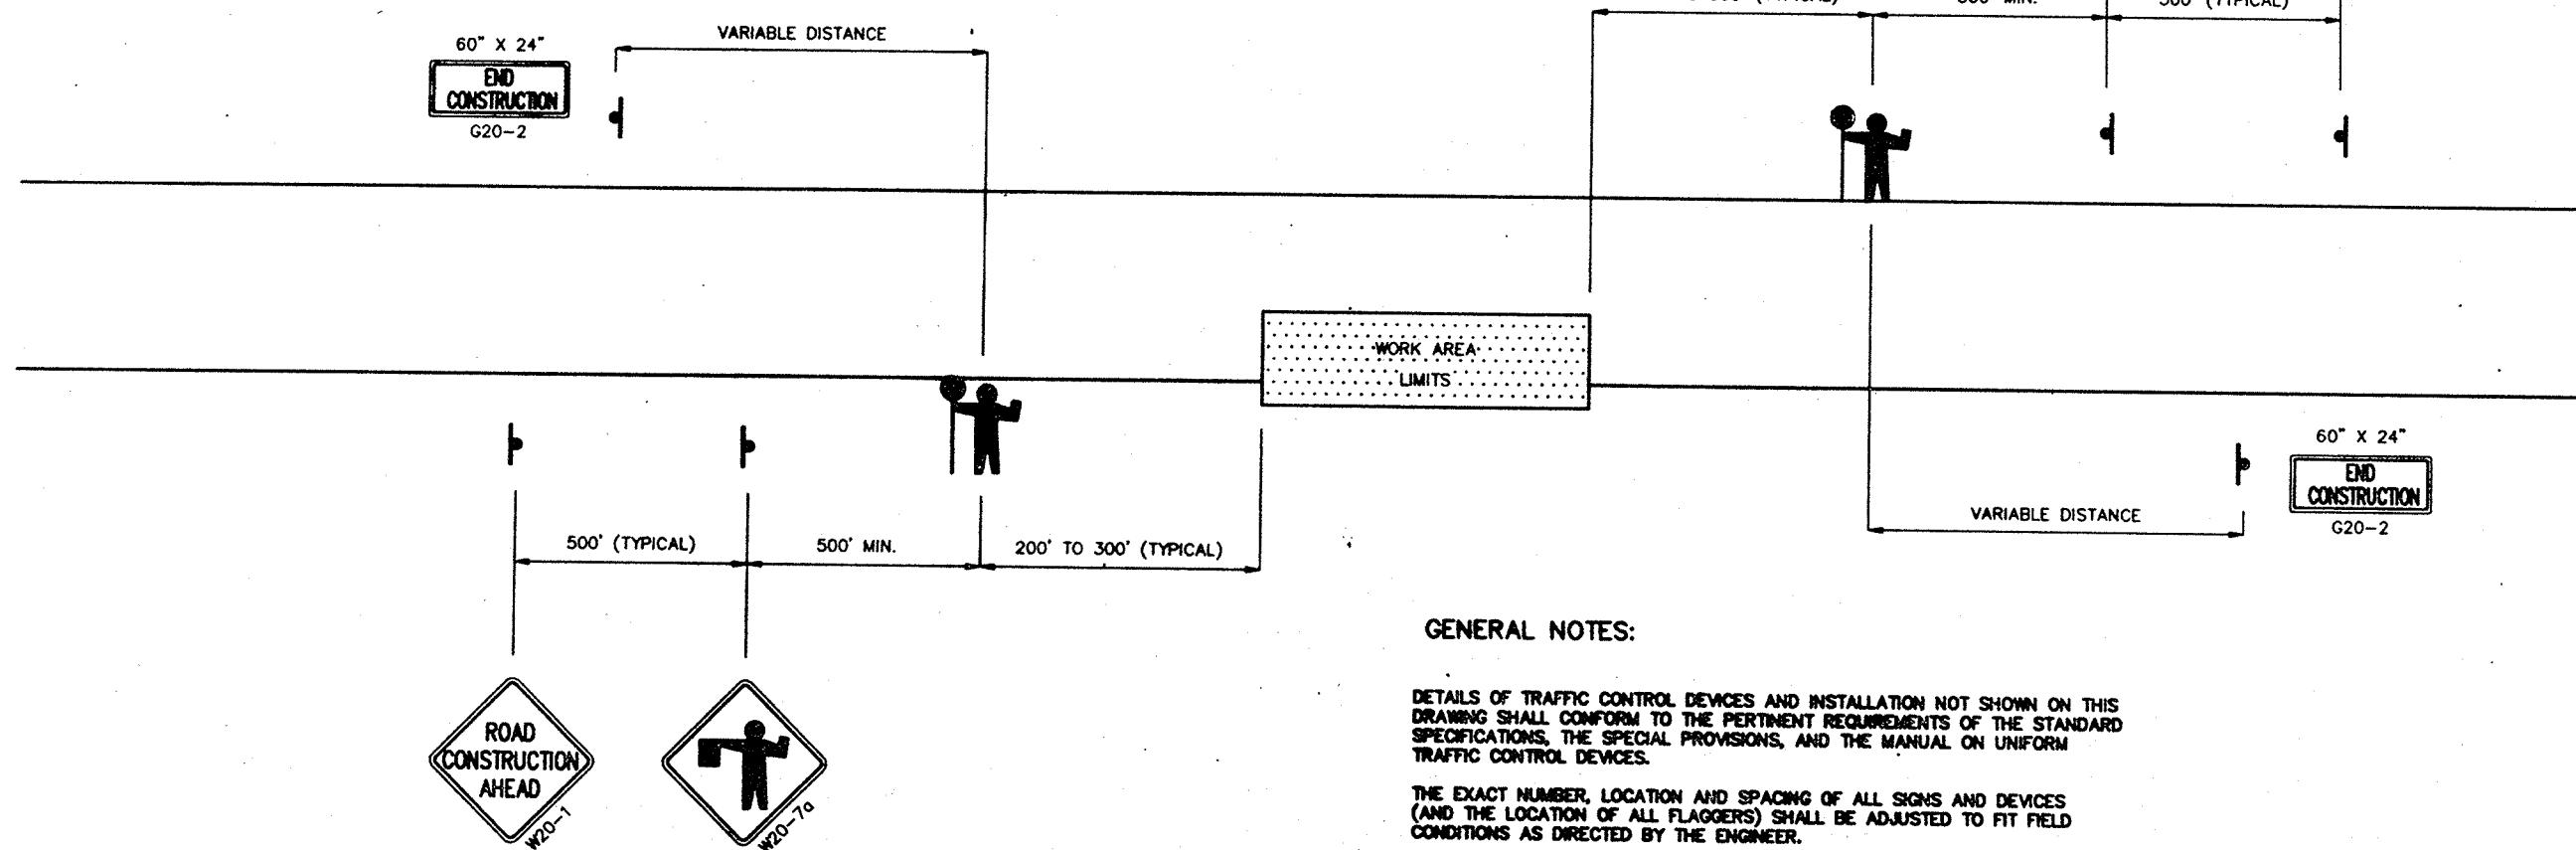

### GENERAL NOTES:


DETAILS OF TRAFFIC CONTROL DEVICES AND INSTALLATION NOT SHOWN ON THIS DRAWING SHALL CONFORM TO THE PERTINENT REQUIREMENTS OF THE STANDARD SPECIFICATIONS, THE SPECIAL PROVISIONS, AND THE MANUAL ON UNIFORM TRAFFIC CONTROL DEVICES.

THE EXACT NUMBER, LOCATION AND SPACING OF ALL SIGNS AND DEVICES (AND THE LOCATION OF ALL FLAGGERS) SHALL BE ADJUSTED TO FIT FIELD CONDITIONS AS DIRECTED BY THE ENGINEER.

THE FIRST ADVANCE WARNING SIGN SHOULD TYPICALLY BE LOCATED IN ADVANCE OF THE ANTICIPATED TRAFFIC BACKUP OR QUEUE.

FLAGGERS SHALL BE IN SIGHT OF EACH OTHER OR IN DIRECT COMMUNICATION AT ALL TIMES. THEY SHALL BE EQUIPPED WITH STOP/SLOW PADDLES FASTENED ON SUPPORT STAFFS. WHEN THE FLAGGING OPERATION IS NOT IN EFFECT, THE FLAGGER AHEAD SIGN SHALL BE COVERED OR REMOVED AND THE HIGHWAY RESTORED TO NORMAL OPERATION.

ALL SIGNS ARE 48" X 48" UNLESS OTHERWISE NOTED.

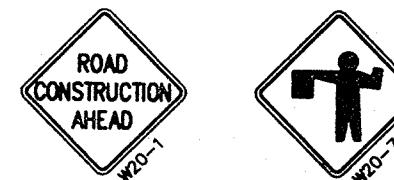

DATE 03/03/94

## ESTIMATE OF QUANTITIES

ITEM	ITEM DESCRIPTION	UNIT	TOTAL	4677-06-71 QUANTITY
20402	REMOVING ASPHALTIC SURFACE	S.Y.	350.00	350.00
20405	REMOVING CURB AND GUTTER	L.F.	180.00	180.00
20406	REMOVING CONCRETE SIDEWALK	S.Y.	70.00	70.00
21301	FINISHING ROADWAY	L.S.	1.00	1.00
30404	CRUSHED AGGREGATE BASE COURSE	TON	50.00	50.00

40713	ASPHALTIC CONCRETE PAVEMENT, TYPE MV	TON	75.00	75.00
60133	CONCRETE CURB AND GUTTER, 30-INCH, TYPE D	L.F.	175.00	175.00
60205	CONCRETE SIDEWALK, 5-INCH	S.F.	870.00	870.00
61334	NONMETALLIC CONDUIT, 2-INCH	L.F.	288.00	288.00
61336	NONMETALLIC CONDUIT, 3-INCH	L.F.	36.00	36.00

61347	CONDUIT, 3-INCH, SPECIAL	L.F.	312.00	312.00
61910	MOBILIZATION	L.S.	1.00	1.00
62501	TOPSOIL	S.Y.	100.00	100.00
62702	MULCHING	S.Y.	100.00	100.00
62902	FERTILIZER, TYPE A	CWT.	6.30	6.30

63002	SEEDING	LB.	1.80	1.80
64002	POLES, TYPE 2	EACH	4.00	4.00
64012	CONCRETE BASES, TYPE 1	EACH	5.00	5.00
64013	CONCRETE BASES, TYPE 2	EACH	4.00	4.00
64301	TRAFFIC CONTROL	L.S.	1.00	1.00

64405	PAVEMENT MARKING, PREFORMED PLASTIC	L.F.	130.00	130.00
64418	PAVEMENT MARKING, RAILROAD CROSSINGS, PREFORMED PLASTIC	EACH	1.00	1.00
64422	PAVEMENT MARKING, STOP LINE, HOT PAINT, 18-INCH	L.F.	92.00	92.00
64434	PAVEMENT MARKING, STOP LINE, HOT PAINT, 18-INCH	L.F.	17.00	17.00
64442	PAVEMENT MARKING, CROSSWALK, HOT PAINT, 6-INCH	L.F.	360.00	360.00

64454	PAVEMENT MARKING, CROSSWALK, PREFORMED PLASTIC, 6-INCH	L.F.	135.00	135.00
-------	--	------	--------	--------

Sheet 3

ITEM	ITEM DESCRIPTION	UNIT	TOTAL	QUANTITY
64601	SAWING EXISTING PAVEMENT	L.F.	215.00	215.00
90001	TRAFFIC SIGNAL CONTROLLER, FULLY ACTUATED, 8-PHASE, SPECIAL	EACH	1.00	1.00
90002	TRAFFIC SIGNAL STANDARDS, ALUMINUM, 13-FEET	EACH	5.00	5.00
90003	TRAFFIC SIGNAL CABLE, 16 CONDUCTOR, No.14	L.F.	472.00	472.00
90004	CASING PIPE FOR RAILROAD CROSSING	L.F.	35.00	35.00
90005	SPRINKLE TREATMENT	S.Y.	140.00	140.00
90006	ASPHALTIC MATERIAL FOR SPRINKLE TREATMENT	TON	.02	.02
90007	PAVEMENT MARKING, CURB RAMP, HOT PAINT, SPECIAL	L.F.	60.00	60.00
90008	ELECTRICAL SERVICE, TRAFFIC SIGNALS, METER BREAKER, NORTH AVE. & BUCHANAN ST.	L.S.	1.00	1.00
90402	QUALITY MANAGEMENT PROGRAM, ASPHALTIC MIXTURE	TON	75.00	75.00
90660	ELECTRICAL WIRE, TRAFFIC SIGNALS, NO. 10	L.F.	1,482.00	1,482.00
90785	CONCRETE CONTROL CABINET BASES, TYPE 9	EACH	1.00	1.00
90792	PULL BOXES, 12X24-1INCH	EACH	3.00	3.00
90797	PULL BOXES, 24X36-1INCH	EACH	5.00	5.00
90800	PEDESTAL BASES	EACH	5.00	5.00
90801	TRANSFORMER BASES	EACH	4.00	4.00
90815	MAST ARMS, TRAFFIC SIGNAL TROMBONE, 15-FT.	EACH	2.00	2.00
90814	MAST ARMS, TRAFFIC SIGNAL TROMBONE, 20-FT.	EACH	2.00	2.00
90817	TRAFFIC SIGNAL FACES, 3-12 VERTICAL	EACH	8.00	8.00
90823	TRAFFIC SIGNAL FACES, 3-12 HORIZONTAL	EACH	4.00	4.00
90830	PEDESTRIAN SIGNAL FACES, 12-1INCH	EACH	8.00	8.00
90833	PEDESTRIAN PUSH BUTTONS	EACH	8.00	8.00
90834	TRAFFIC SIGNAL MOUNTING HARDWARE, NORTH AVE. & BUCHANAN ST.	L.S.	1.00	1.00

Sheet 31


Sheet 3.2


ITEM	ITEM DESCRIPTION	UNIT	TOTAL	4677-06-71 QUANTITY
90838	BACKPLATES	EACH	12.00	12.00
90842	TRAFFIC SIGNAL CABLE, 7 CONDUCTOR, NO. 14	L.F.	1,117.00	1,117.00
90870	LOOP DETECTOR AMPLIFIER, NORTH AVE. & BUCHANAN ST.	L.S.	1.00	1.00
90871	LOOP DETECTOR CONDUIT, 1-INCH	L.F.	302.00	302.00
90872	LOOP DETECTOR WIRE	L.F.	940.00	940.00
90873	LOOP DETECTOR LEAD IN CABLE	L.F.	684.00	684.00

				STATE PROJECT NUMBER	SHEET NO.
				4677-06-71	3A
				MISCELLANEOUS QUANTITIES C.T.H. "OO" AND BUCHANAN ST. OUTAGAMIE COUNTY	
<u>SAWING EXISTING PAVEMENT</u>					
LOCATION	QUANTITY (L.F.)				
8+92, BUCHANAN STREET	28				
9+80, BUCHANAN STREET	162				
CURB & GUTTER SIDEWALK REMOVALS	25				
	215				
<u>TOPSOIL, SEED, FERTILIZER &amp; MULCH</u>					
LOCATION	FERTILIZER, TYPE A QUANTITY (CWT.)	TOPSOIL QUANTITY (S.Y.)	MULCHING QUANTITY (S.Y.)	SEEDING QUANTITY (LBS.)	
CURB AND GUTTER, CONDUIT, PULLBOX, BASE AND SIDEWALK INSTALLATION AREAS	6.3	100	100	1.8	
<u>REMOVING ASPHALTIC SURFACE</u>				<u>SPRINKLE TREATMENT, ASPHALTIC MATERIAL FOR SPRINKLE TREATMENT</u>	
STATION TO STATION	LOCATION	QUANTITY (S.Y.)		STATION TO STATION	LOCATION
8+92 TO 9+80	BUCHANAN STREET	350		8+92 TO 9+80	BUCHANAN STREET, NORTHBOUND LANE
				SPRINKLE TREATMENT (S.Y.)	ASPH. MATERIAL FOR SURFACE TREATMENT (TON)
				140	.02
<u>CRUSHED AGGREGATE BASE COURSE</u>				<u>REMOVING CURB &amp; GUTTER</u>	
STATION TO STATION	LOCATION	QUANTITY (TON)		LOCATION	QUANTITY (L.F.)
9+20 TO 9+80	BUCHANAN STREET PAVEMENT WIDENING - 10" MIN.	50		BUCHANAN STREET S.E. RADIUS	100
				BUCHANAN STREET S.W. RADIUS	80
					180
<u>CASING PIPE FOR RAILROAD CROSSING</u>				<u>REMOVING CONCRETE SIDEWALK</u>	
STATION	LOCATION	QUANTITY (L.F.)		LOCATION	QUANTITY (S.Y.)
9+00	BUCHANAN STREET, RT.	50		BUCHANAN STREET, RT.	25
				BUCHANAN STREET, LT.	45
					70
<u>ASPHALTIC CONCRETE PAVEMENT, TYPE MV</u>				<u>CONCRETE SIDEWALK, 5-INCH</u>	
STATION TO STATION	LOCATION	QUANTITY (TON)		LOCATION	QUANTITY (L.F.)
8+92 TO 9+80	BUCHANAN STREET	75		BUCHANAN STREET, RT.	375
<u>CONCRETE CURB &amp; GUTTER</u>					
LOCATION	30-INCH, TYPE D QUANTITY (L.F.)				
BUCHANAN STREET, RT.	75				
BUCHANAN STREET, LT.	100				
	175				





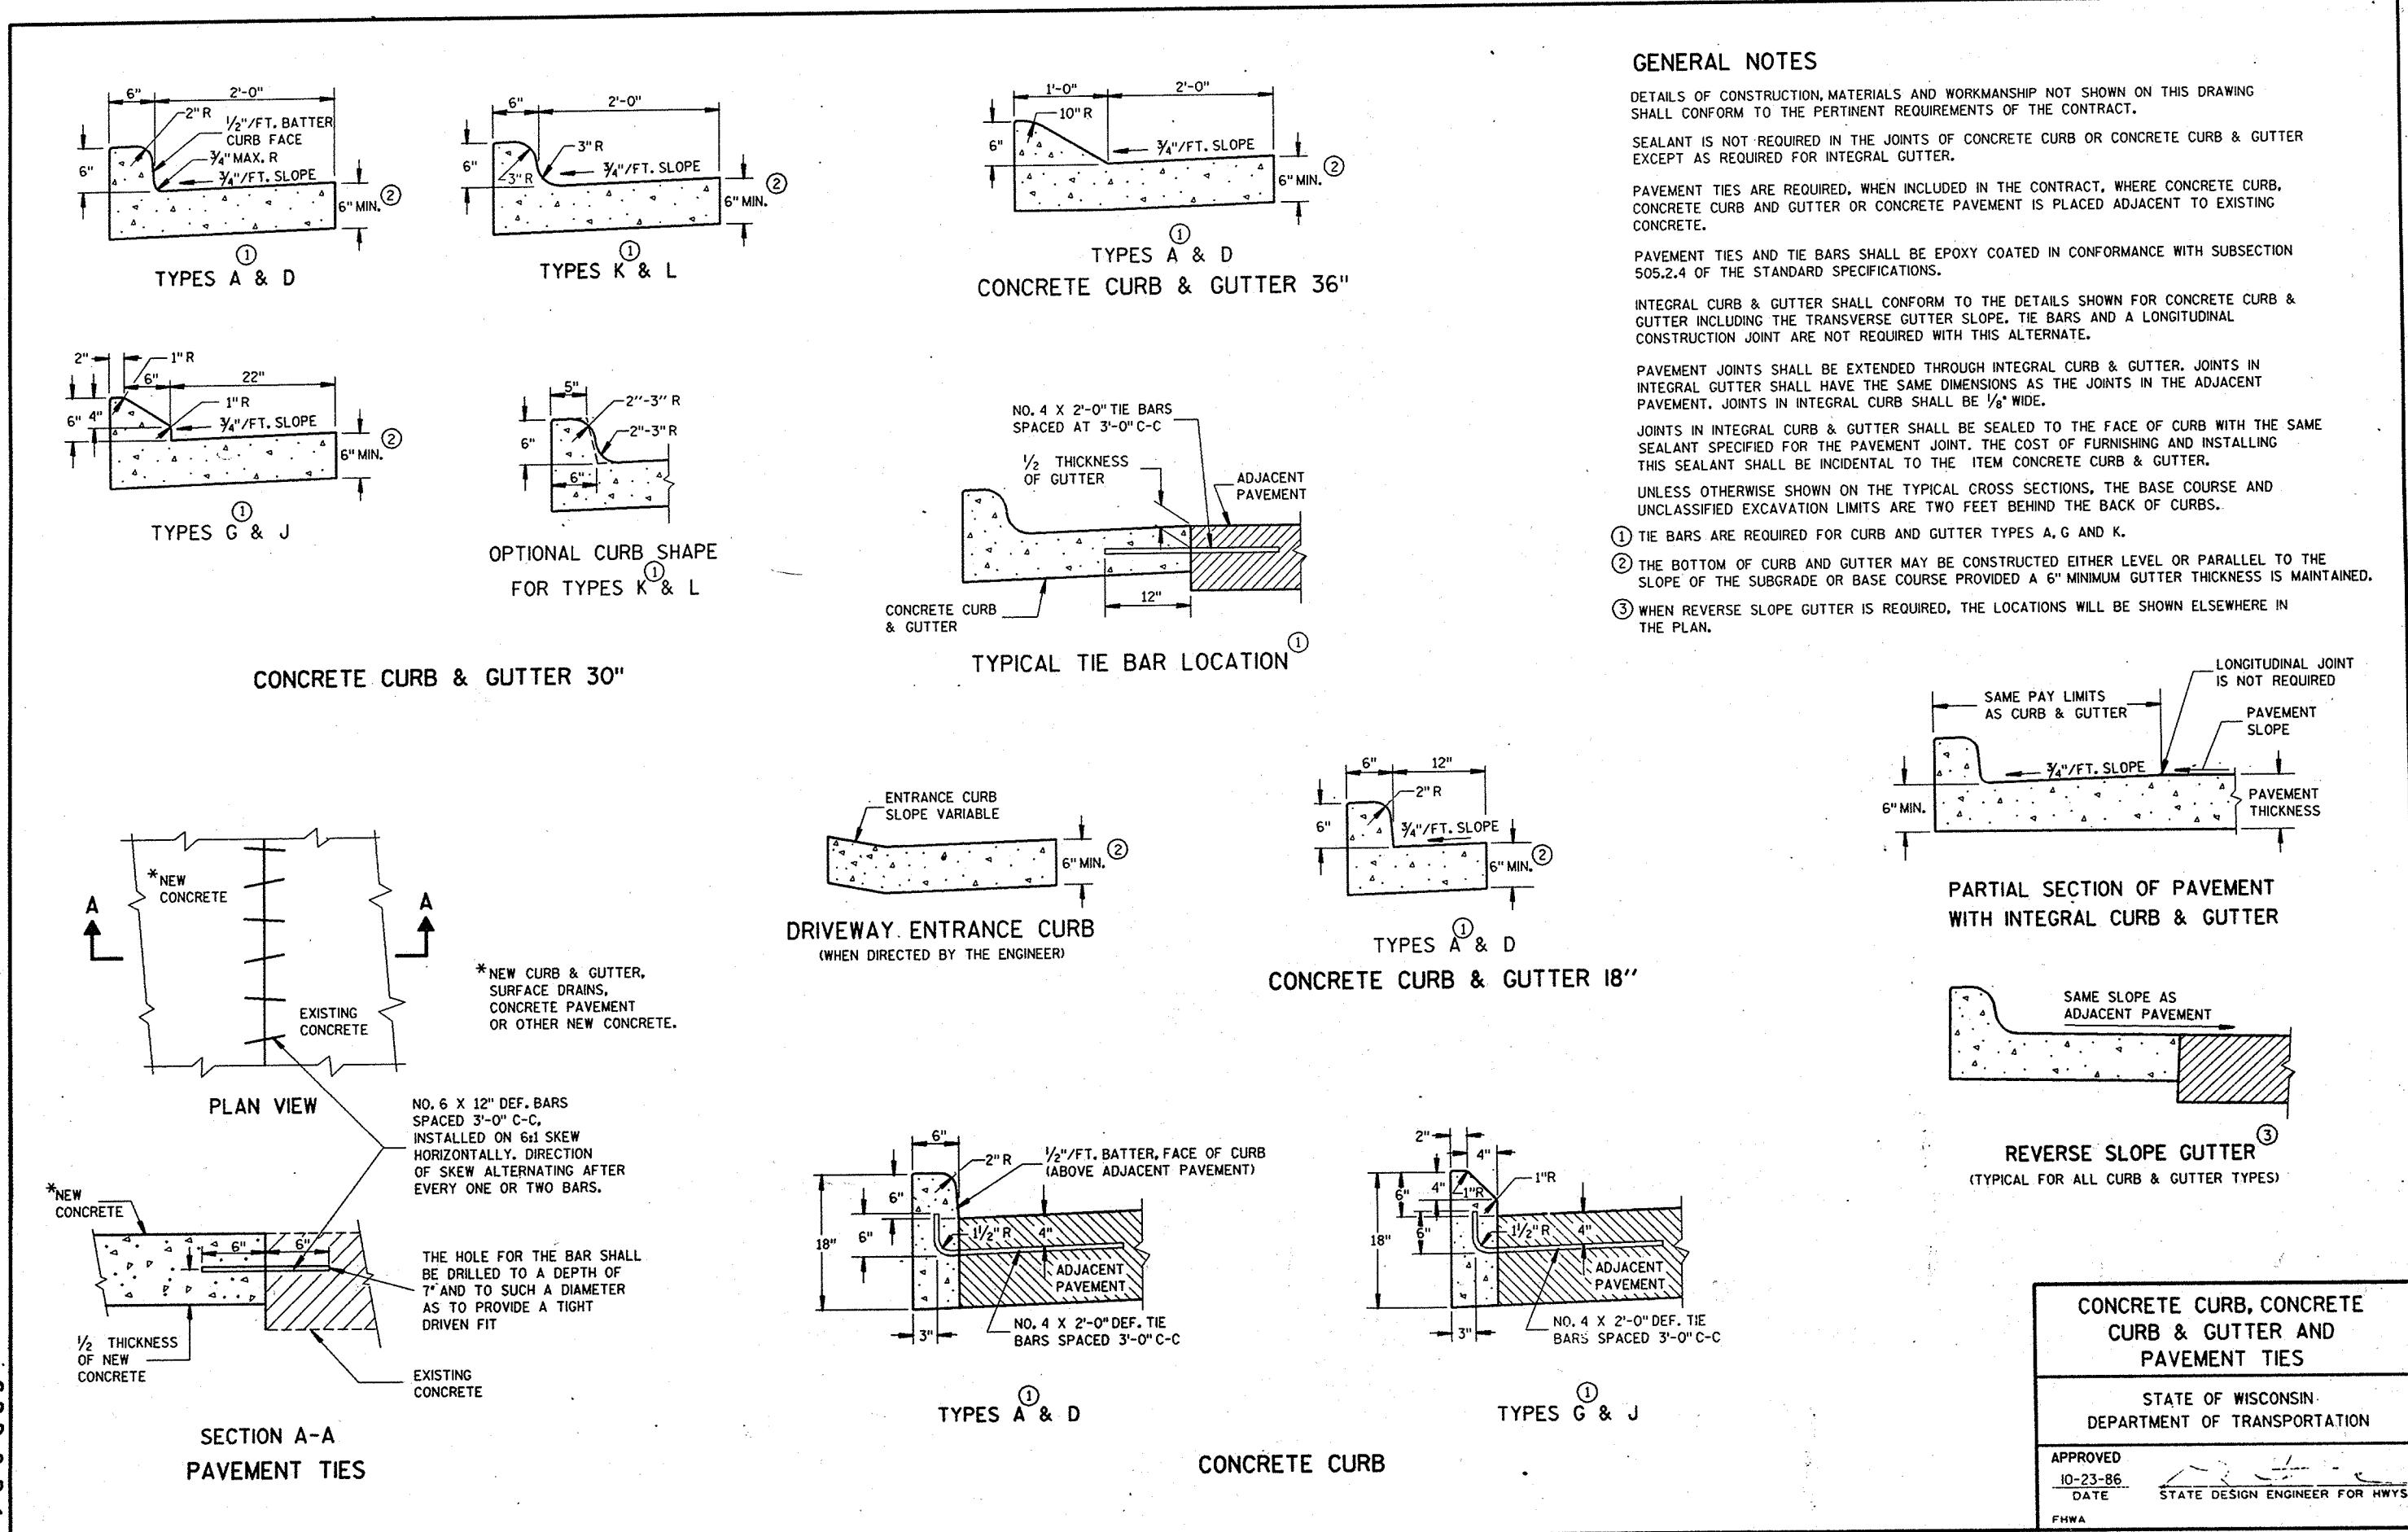


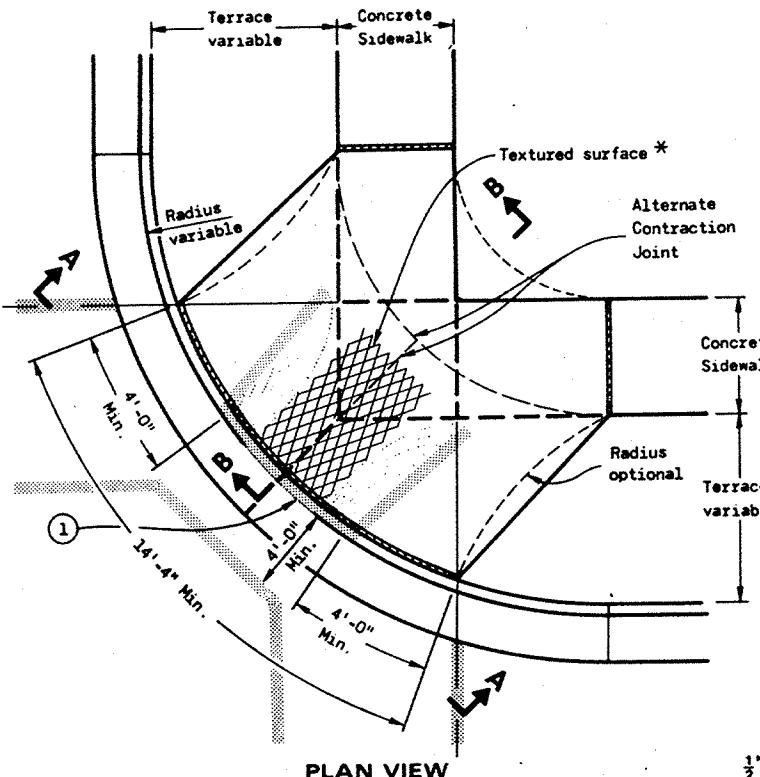


PLAN VIEW  
TYPE 1-A RAMP  
(NO TERRACE)

1" — EXPANSION JOINTS - SIDEWALK  
— CONTRACTION JOINTS


Location of joints may be varied from those shown to better fit site conditions and/or local government preference.

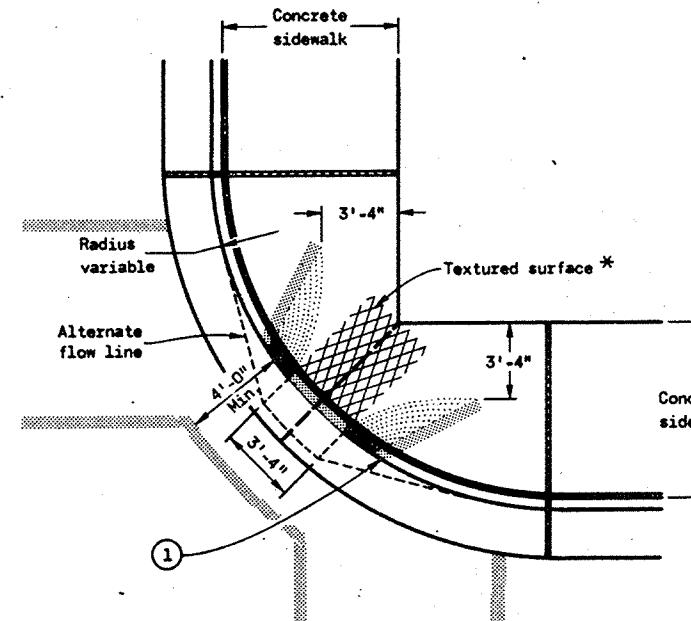

PLAN VIEW  
TYPE 1-A RAMP  
(NO TERRACE)

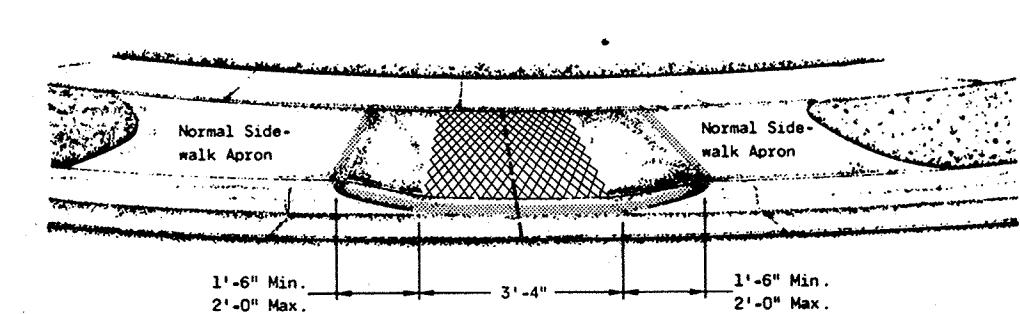


VIEW A-A

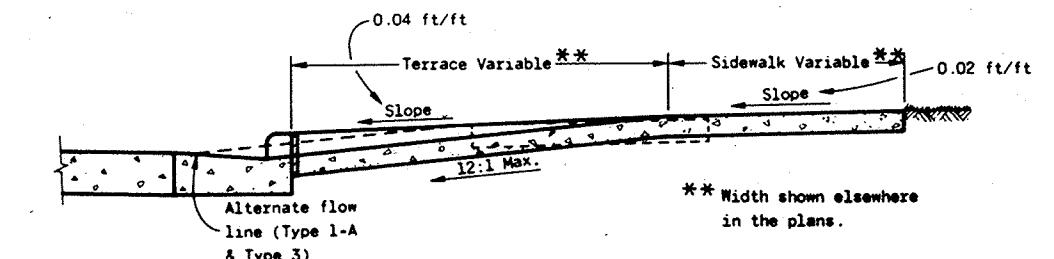


SECTION B-B


\*\* Width shown elsewhere in the plans.

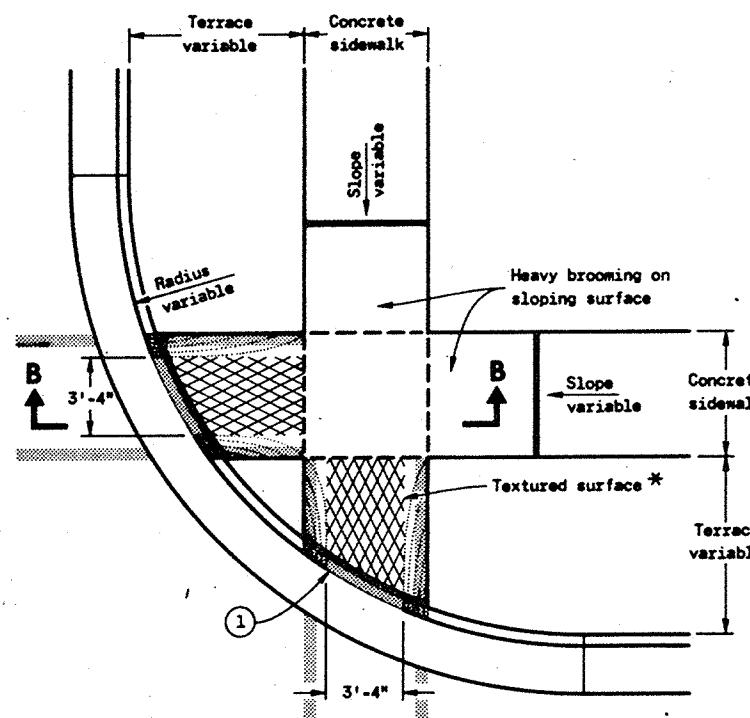

PLAN VIEW  
TYPE 2 RAMP  
(ON LINE WITH SIDEWALK)

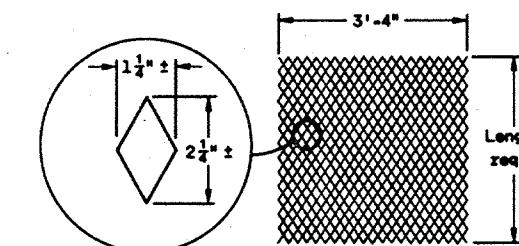

DETAIL OF DIAMOND PATTERN \*

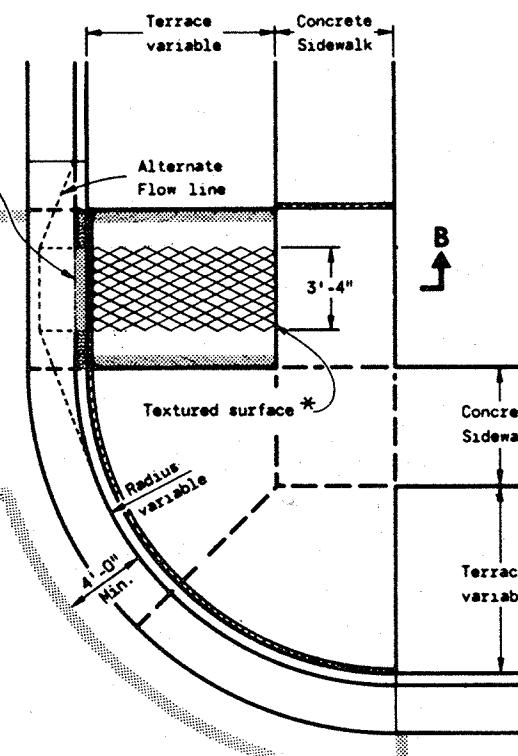

PLAN VIEW  
TYPE 3 RAMP  
(OUTSIDE OF CROSSWALK AREA)

## GENERAL NOTES

Details of construction, materials and workmanship not shown on this drawing shall conform to the pertinent requirements of the Standard Specifications and the applicable Special Provisions.

Ramps shall be built at 12:1 or flatter. When necessary, the sidewalk elevation may be lowered to meet the high point on the ramp.

Type 1, or Type 1-A Ramps shall have a normal sidewalk apron and curb on both sides of ramp.

Curb ramps shall be measured and paid for as Concrete Sidewalk and Concrete Curb and Gutter.

Surface texturing shall consist of linear impressions approximately  $\frac{1}{8}$  inch to  $\frac{1}{4}$  inch in depth and width, oriented to provide a uniform pattern of diamond shapes measuring approximately  $1\frac{1}{2}$  inches in width by  $2\frac{1}{2}$  inches in length, with the length being parallel to the direction of pedestrian movement. This surface texture may be achieved by impressing and removing a piece of expanded metal regular industrial mesh into the surface of the ramp while the concrete is in a plastic state.

The ramp shall be bordered on both sides and on the curb line with a 4 inch wide yellow stripe or with brick of a contrasting color. Normally the paint stripe alternate will be used. The municipality or the department will apply this striping unless otherwise specified in the contract.


If a municipality requires the brick alternate, special details and provisions are shown elsewhere in the plans.

## CURB RAMPS


State of Wisconsin  
Department of Transportation

APPROVED  
10-23-84  
DATE  
CHIEF DESIGN ENGINEER  
FHWA

*[Signature]*

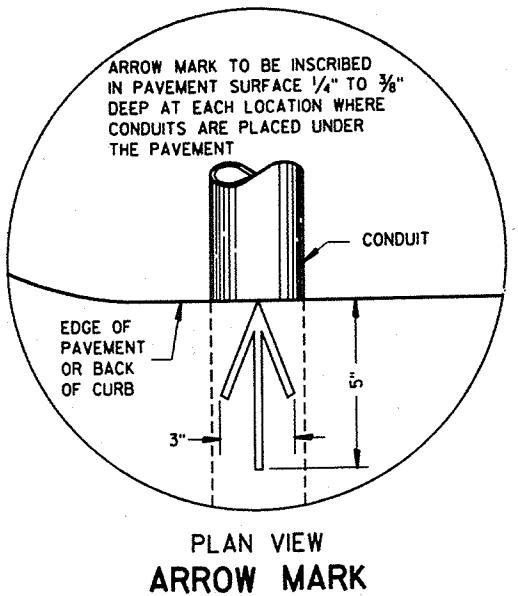


PLAN VIEW  
ARROW MARK

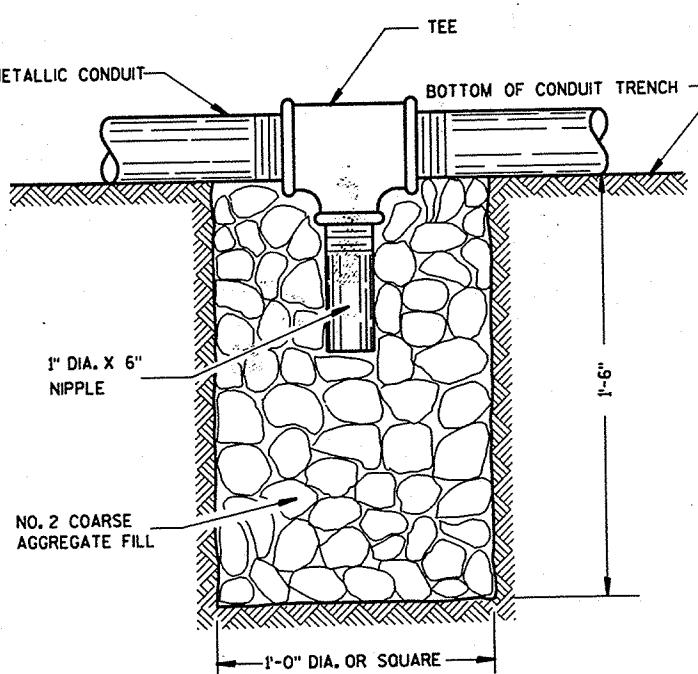

NOTE: INSTALL AT LOCATIONS WHERE METALLIC CONDUITS CANNOT BE PITCHED TO DRAIN INTO A PULL BOX.

### DRAIN SUMP FOR CONDUIT

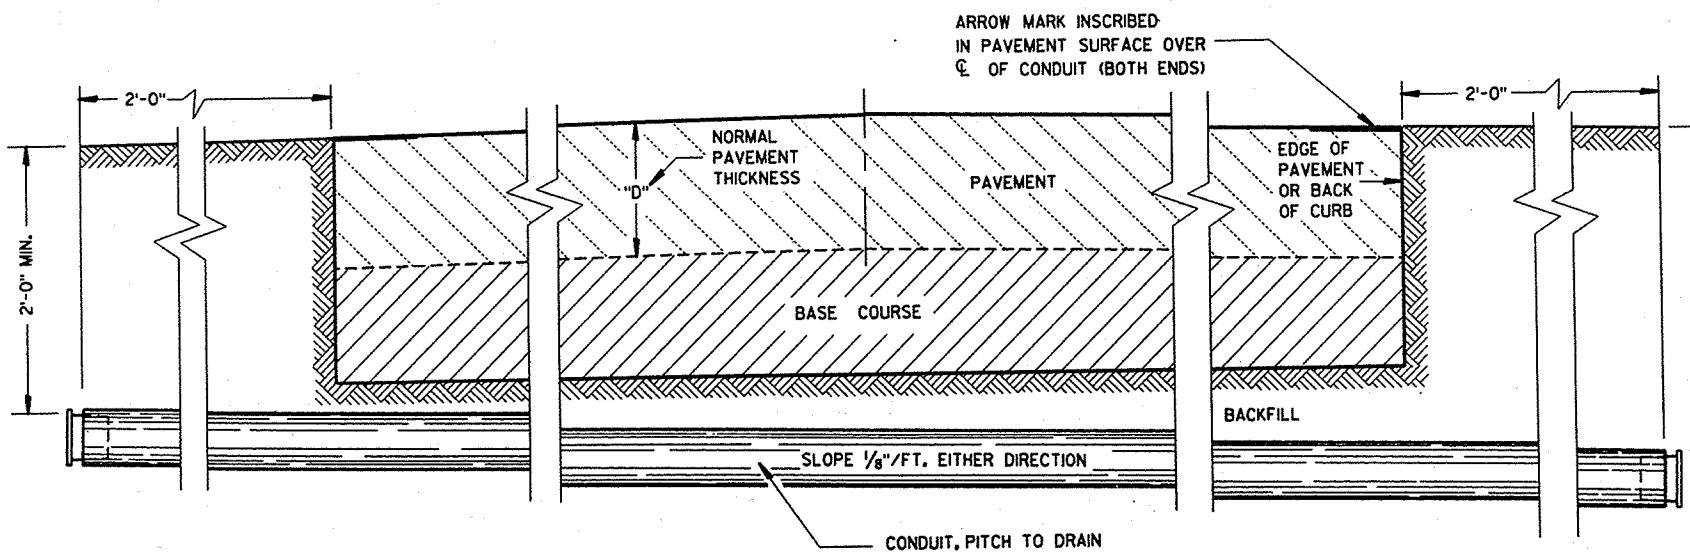

SIDE ELEVATION  
DETAIL FOR CONDUIT UNDER PAVED HIGHWAYS

### GENERAL NOTES

DETAILS OF CONSTRUCTION, MATERIALS AND WORKMANSHIP NOT SHOWN ON THIS DRAWING SHALL CONFORM TO THE PERTINENT REQUIREMENTS OF THE CONTRACT.

METALLIC (STANDARD SPECIFICATION 613.2.2) OR NONMETALLIC (STANDARD SPECIFICATION 613.2.3) CONDUIT SHALL BE FURNISHED AND PLACED AS SHOWN.

DEPTH OF CONDUIT INSTALLED BELOW THE TRAVELED WAY SHALL BE 24 INCHES MINIMUM AND 36 INCHES MAXIMUM.

DEPTH OF CONDUIT INSTALLED THAT IS NOT BELOW THE TRAVELED WAY SHALL BE 18 INCHES MINIMUM AND 36 INCHES MAXIMUM.

ANY EXCEPTION TO THE MAXIMUM DEPTH SHALL BE ONLY WITH THE WRITTEN APPROVAL OF THE ENGINEER.

THE TRENCH SHALL NOT BE BACKFILLED PRIOR TO INSPECTION OF THE CONDUIT.

ALL METALLIC CONDUIT RACEWAY ENDS SHALL BE REAMED AND THREADED.

ALL METALLIC CONDUIT IN WHICH WIRE OR CABLE IS TO BE INSTALLED SHALL BE BUSHED WITH APPROVED THREADED BUSHINGS BEFORE INSTALLATION OF THE WIRE OR CABLE.

ALL METALLIC CONDUITS IN WHICH WIRE OR CABLE IS NOT TO BE INSTALLED SHALL BE CAPPED WITH THREADED PROTECTIVE CAPS, AS APPROVED BY THE ENGINEER.

ALL NONMETALLIC CONDUIT SHALL BE CAPPED OR PLUGGED IMMEDIATELY AFTER INSTALLATION.

NONMETALLIC CONDUITS IN WHICH WIRE OR CABLE IS NOT BEING INSTALLED SHALL REMAIN CAPPED OR PLUGGED.

WHEN REQUIRED TO CONNECT NONMETALLIC CONDUIT TO METALLIC CONDUIT, ONLY U.L. LISTED ADAPTER FITTINGS SHALL BE USED.

PRIOR TO CONDUIT ACCEPTANCE, CONDUIT CAPS OR PLUGS SHALL BE REMOVED, AND THE CAPS, PLUGS AND CONDUIT ENDS SHALL BE THOROUGHLY CLEANED AND THEN THE CAPS OR PLUGS REINSTALLED TO ENSURE THAT THE CAPS OR PLUGS CAN BE EASILY REMOVED IN THE FUTURE.

ALL CONDUIT BEING FURNISHED AND INSTALLED SHALL HAVE THE U.L. LABEL FIRMLY ATTACHED.

CONDUIT RUNS SHALL BE THE SAME SIZE PIPE FROM ONE END TO THE OTHER (FROM PULL BOX TO PULL BOX-OR-JUNCTION BOX TO JUNCTION BOX).

A #12 GAUGE, GALVANIZED PULL WIRE SHALL BE INSTALLED IN EACH RUN OF CONDUIT THAT DOES NOT RECEIVE CABLE OR WIRE UNDER THIS CONTRACT. THE PULL WIRE SHALL BE DOUBLED BACK 2 FEET AT EACH END CAP OF THE CONDUIT RUN.

BENDING OF PVC SHALL BE ACCOMPLISHED BY USING A BLANKET OR EMERSION TYPE TANK DESIGNED FOR THE PURPOSE OF BENDING PVC ELECTRICAL CONDUIT.

ALL CONDUIT RUNS SHALL BE STRAIGHT (WITHOUT BENDS) FROM PULL BOX TO PULL BOX, PULL BOX TO BASE AND BASE TO BASE AS SHOWN ON THE PLANS UNLESS OTHERWISE APPROVED BY THE PROJECT ENGINEER.

ALL CUT ENDS SHALL BE TRIMMED INSIDE AND OUTSIDE TO REMOVE ALL ROUGH EDGES ON NONMETALLIC CONDUIT. (SEE NEC 347.5)

### CONDUIT

STATE OF WISCONSIN  
DEPARTMENT OF TRANSPORTATION

APPROVED	11/14/82	STATE ELECTRICAL ENGR FOR HWYS
	9/15/82	Robert Busch
		STATE TRAFFIC ENGINEER FOR HWYS




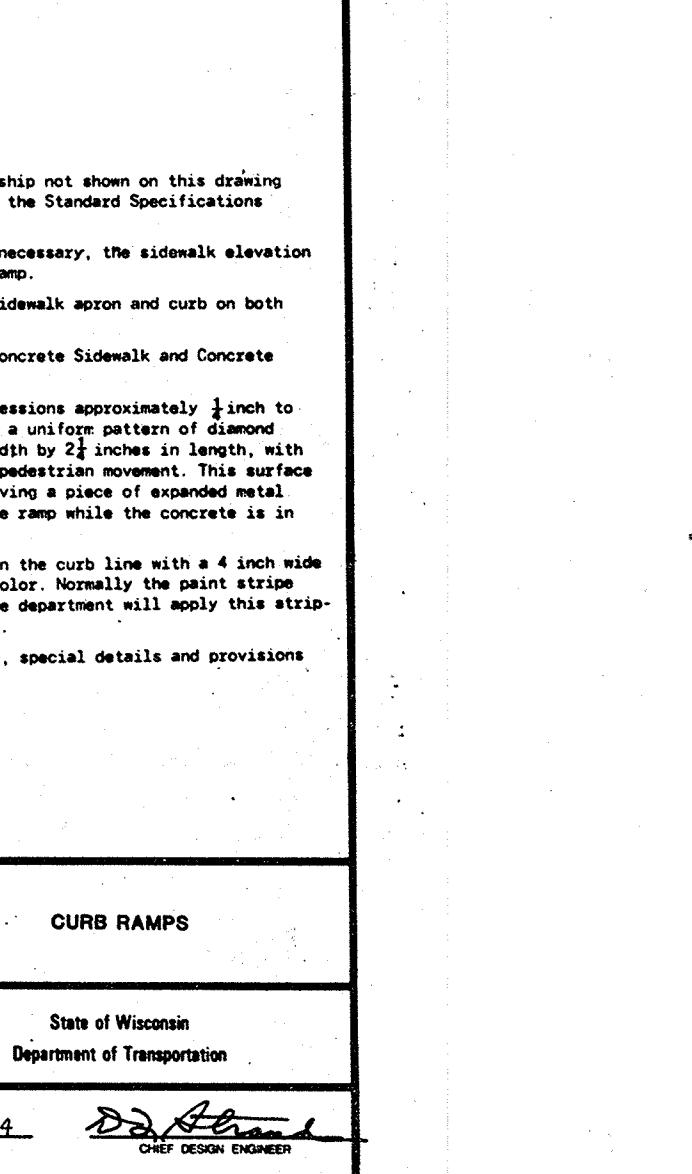


TABLE OF NOMINAL DIMENSIONS AND WEIGHTS

DIMENSION IN INCHES		TYPE OF PIPE					
		CORRUGATED STEEL			POLYETHYLENE SDR 32.5		
PIPE DIAMETER (INSIDE)	A	12	12	18	18	24	24
PIPE LENGTH **	B	24	36	24	36	24	36
WALL THICKNESS	C	0.064	0.064	0.064	0.064	0.064	0.064
COVER	D	10 1/4	10 1/4	16 1/4	16 1/4	22 1/4	22 1/4
FRAME	E	14 1/2	14 1/2	20 1/2	20 1/2	26 1/2	26 1/2
FRAME	F	8 1/2	8 1/2	14 1/2	14 1/2	20 1/2	20 1/2
FRAME	G	11 1/2	11 1/2	17 1/2	17 1/2	23 1/2	23 1/2
WEIGHT IN POUNDS *							
FRAME AND COVER		60	60	110	110	155	155
							60

\* THE ACTUAL WEIGHT OF THE MANHOLE FRAME AND COVER MAY VARY WITHIN 5 PERCENT PLUS OR MINUS OF THE WEIGHTS SHOWN.

\*\* NORMALLY USED LENGTHS. THE PROJECT ENGINEER SHALL DETERMINE IF PIPE LENGTHS, OTHER THAN THOSE SPECIFIED, SHALL BE USED, TO A MAXIMUM OF 48" (CONTINUOUS LENGTH, NON-SPliced)

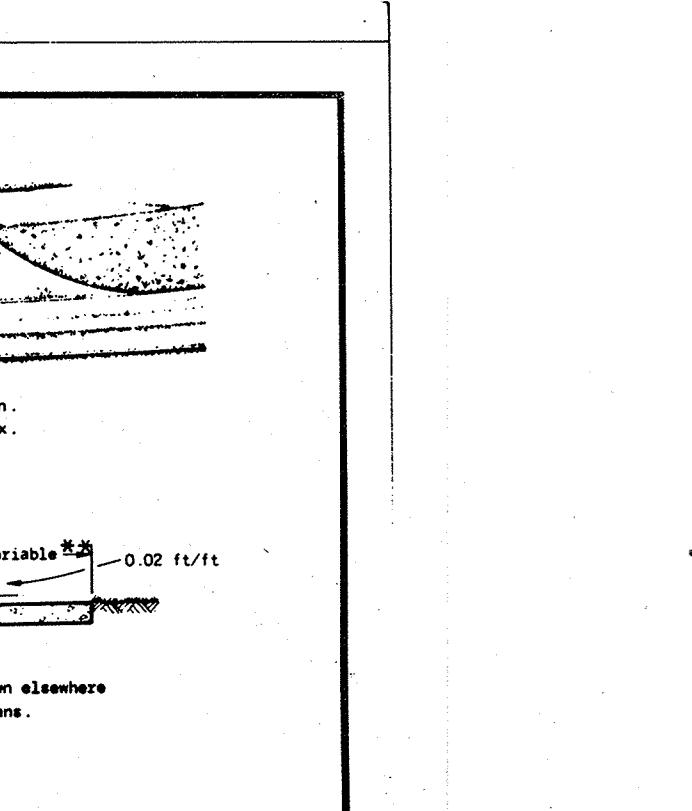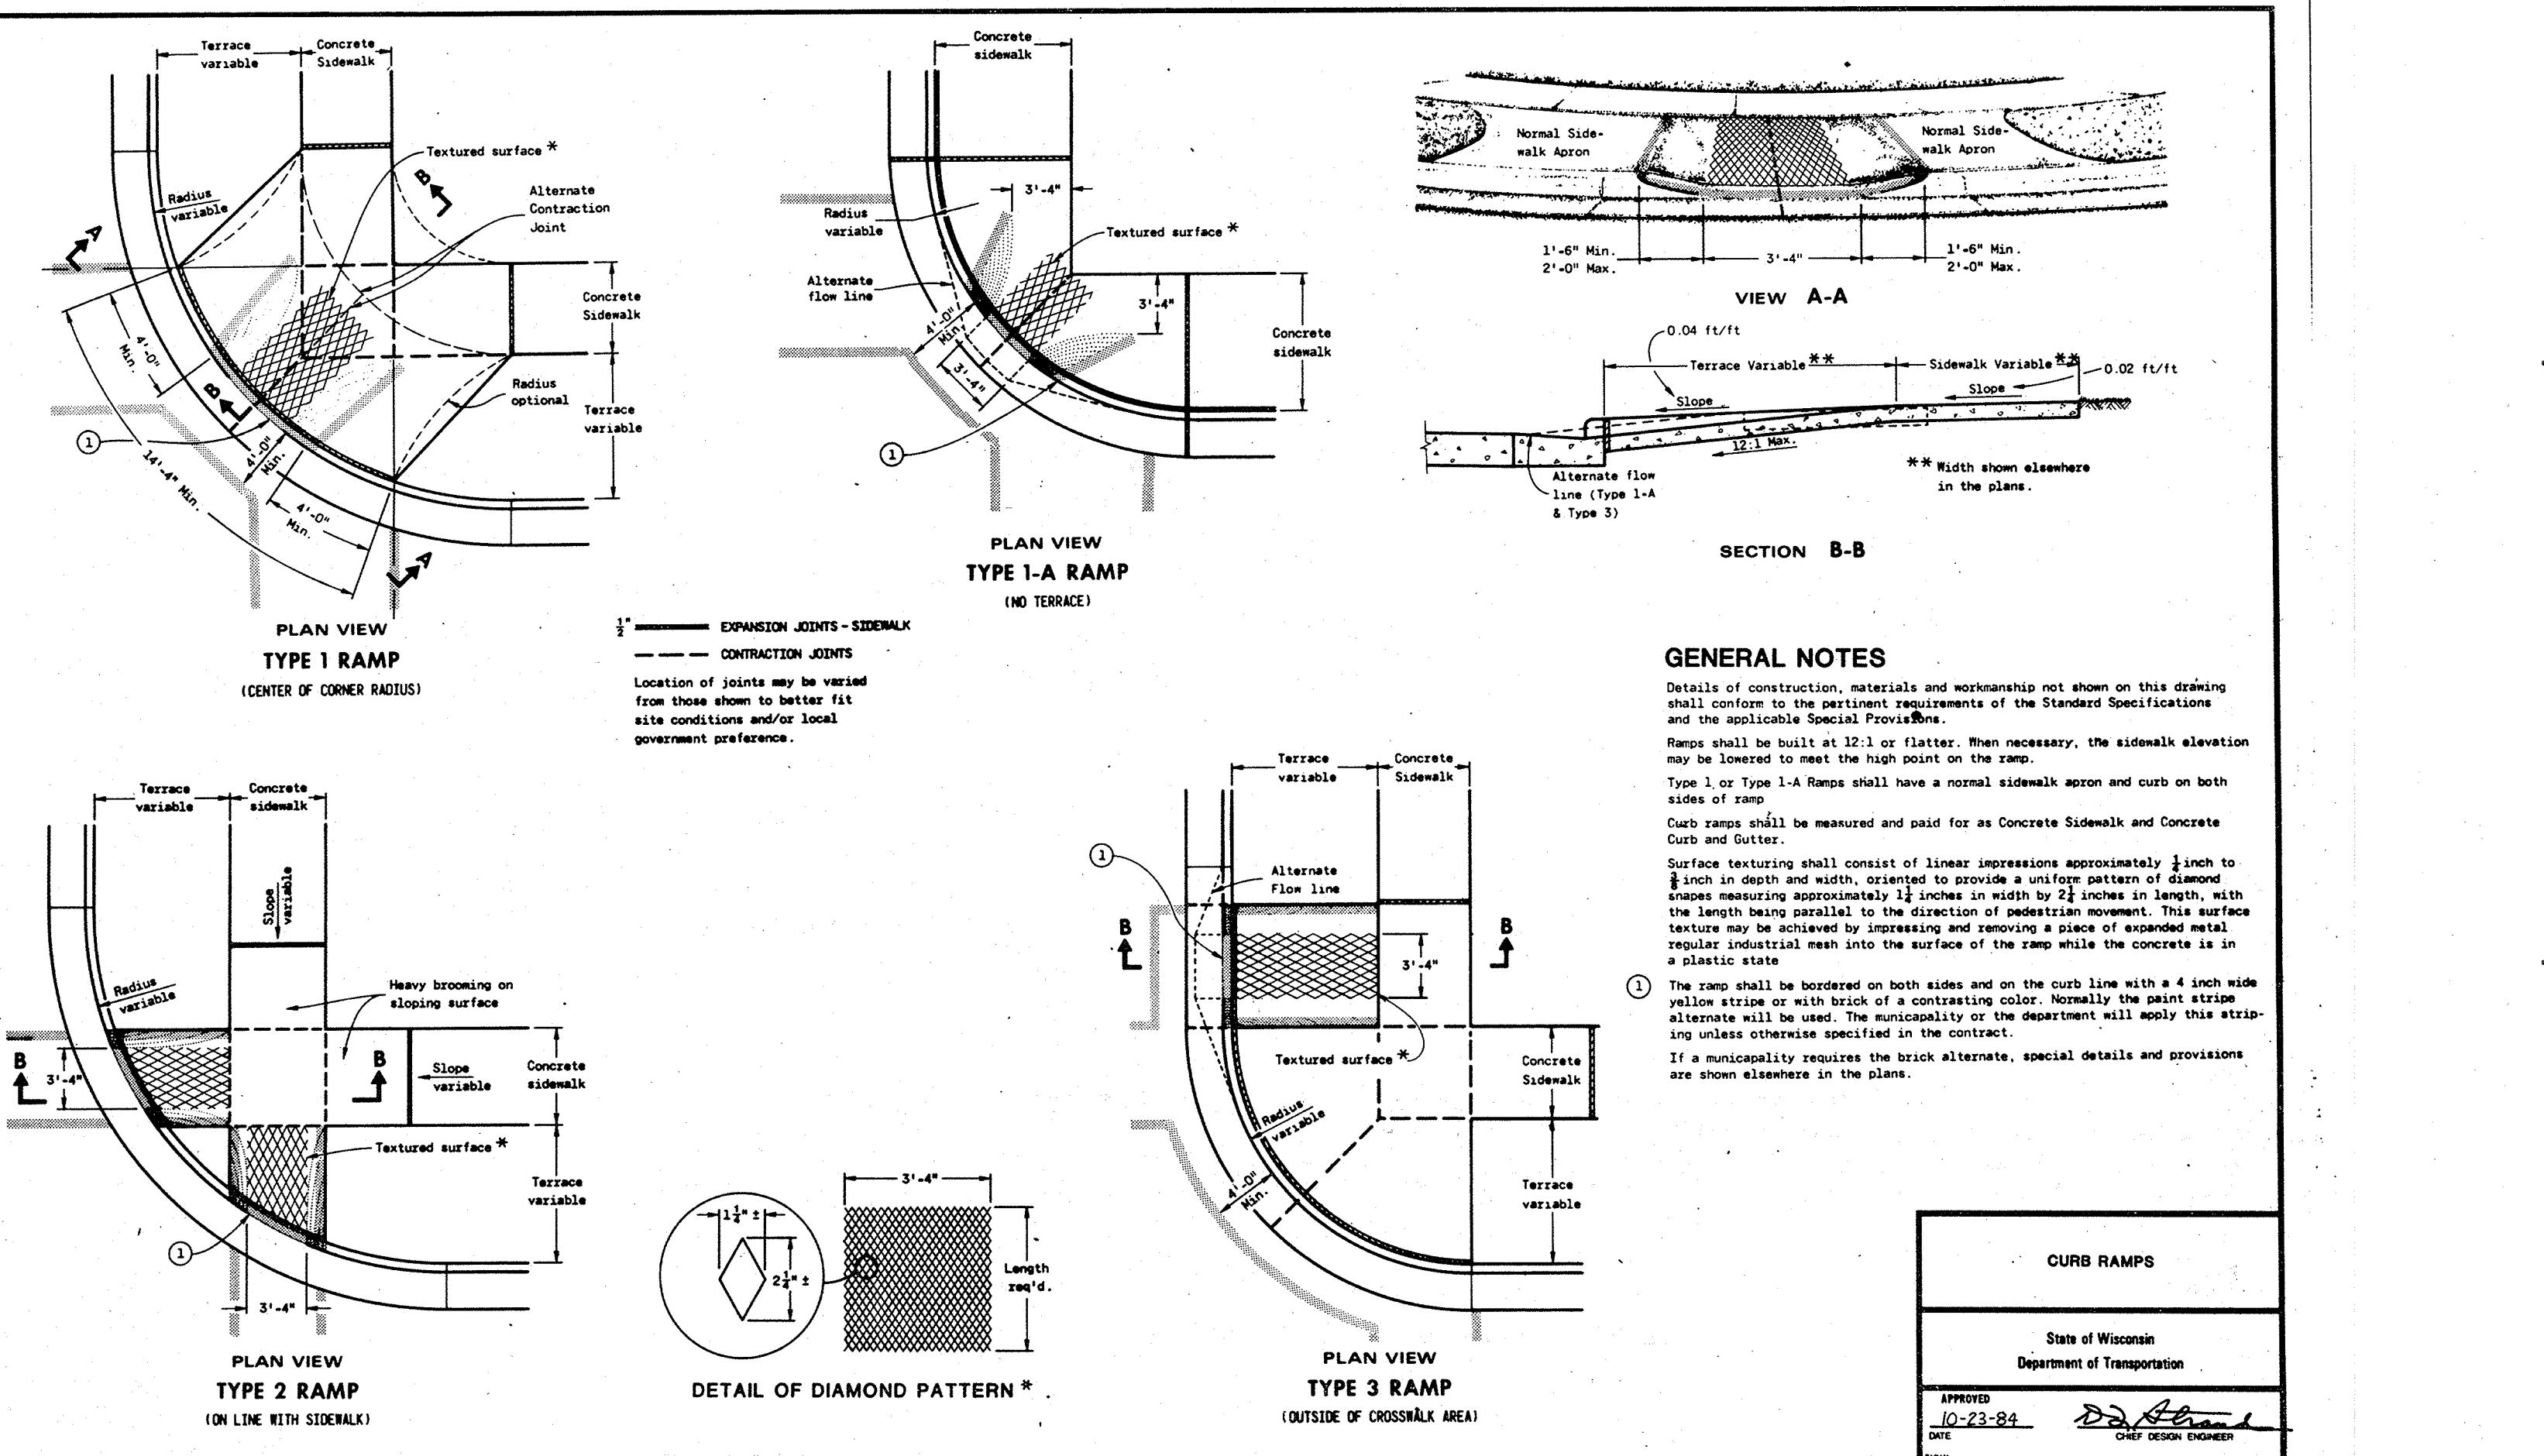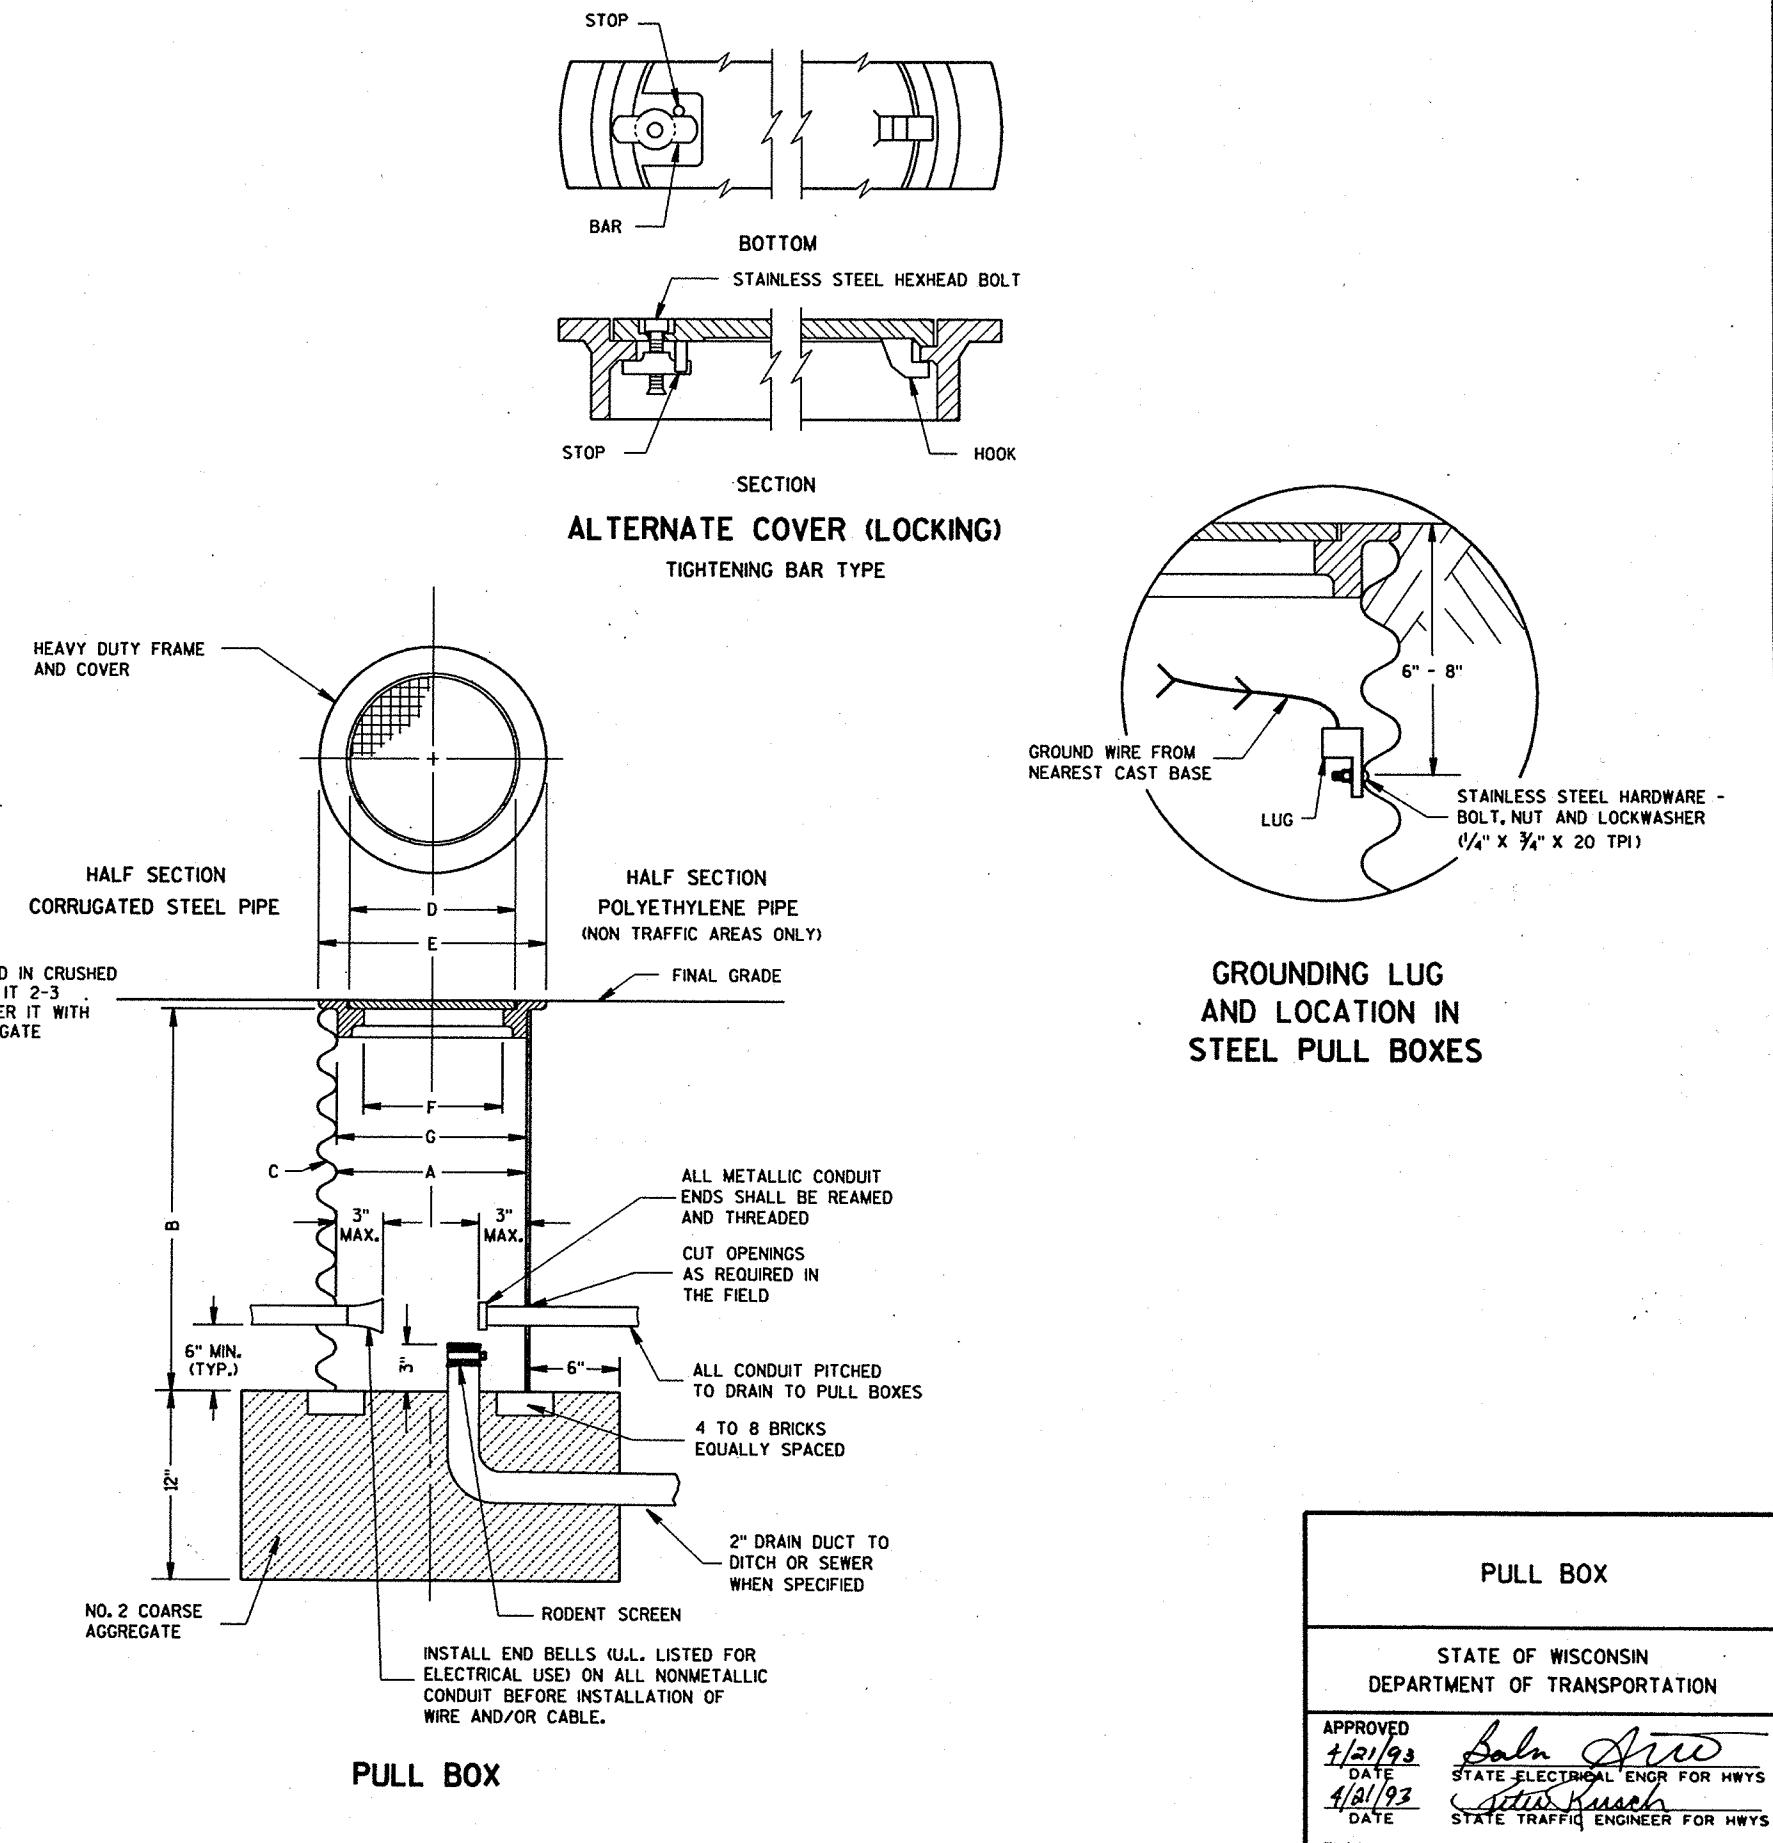

GENERAL NOTES

DETAILS OF CONSTRUCTION, MATERIALS AND WORKMANSHIP NOT SHOWN ON THIS DRAWING SHALL CONFORM TO THE PERTINENT REQUIREMENTS OF THE CONTRACT.

ALL FRAMES AND COVERS SHALL BE HEAVY DUTY TYPE, SUITABLE FOR VEHICULAR TRAFFIC LOADS.

POLYETHYLENE PULL BOXES SHALL NOT BE INSTALLED IN CONCRETE OR ASPHALTIC PAVEMENT. PULL BOXES LOCATED IN THE ROADWAY SHALL HAVE LOCKING COVERS.

ENTRANCE HOLES INTO PULL BOXES SHALL BE CUT WITH A CIRCULAR HOLE SAW OR HYDRAULIC CONDUIT PUNCH. HOLE SIZE SHALL BE THE OUTSIDE DIAMETER OF THE CONDUIT THAT IS TO FIT IN THE OPENING PLUS NO MORE THAN 1/4".

THE CONTRACTOR SHALL NOT INSTALL WIRE IN ANY PULL BOX UNTIL ITS INSTALLATION HAS BEEN INSPECTED AND ACCEPTED BY THE ENGINEER.

GROUNDING LUGS (MECHANICAL CONNECTORS) SHALL BE U.L. LISTED AND APPROVED FOR USE WITH COPPER WIRE. THE MECHANICAL CONNECTION (INSIDE AND OUTSIDE) TO THE PULL BOX, SHALL BE TOTALLY AND PERMANENTLY SEALED WITH A SILICONE OR RUBBERIZED CAULKING COMPOUND AS APPROVED BY THE ENGINEER.

GROUNDING LUGS ARE NOT REQUIRED IN PULL BOXES WHEN VOLTAGES OF LESS THAN 50 VOLTS AC ARE THE ONLY VOLTAGES ENCOUNTERED IN THE BOXES.

DRAIN DUCT SHALL BE MEASURED AND PAID FOR SEPARATELY.

RODENT SCREEN SHALL BE 1/8" GALVANIZED STEEL MESH AND BE INSTALLED WITH A STAINLESS STEEL HOSE CLAMP OF SUFFICIENT SIZE.

ALL METALLIC CONDUIT IN WHICH WIRE AND/OR CABLE IS TO BE INSTALLED, SHALL BE BUSHED BEFORE INSTALLATION OF THE WIRE AND/OR CABLE.

## GENERAL NOTES

DETAILS OF CONSTRUCTION, MATERIALS AND WORKMANSHIP NOT SHOWN ON THIS DRAWING SHALL CONFORM TO THE PERTINENT REQUIREMENTS OF THE CONTRACT.

BASES SHALL BE EXCAVATED BY USE OF A CIRCULAR AUGER.

TOP SURFACES OF CONCRETE BASES SHALL BE TROWEL FINISHED AND LEVEL.

CONDUIT SIZES AND LOCATIONS SHALL BE AS SHOWN ON THE PLANS.

MINIMUM BENDING RADIUS OF CONDUIT = 6 X THE DIAMETER.

CONDUIT HEIGHT ABOVE CONCRETE BASES SHALL BE 1 INCH. ALL METALLIC CONDUIT ENDS SHALL BE REAMED AND THREADED.

ALL METALLIC CONDUITS IN WHICH WIRE OR CABLE IS NOT TO BE INSTALLED SHALL BE CAPPED WITH THREADED PROTECTIVE CAPS, AS APPROVED BY THE ENGINEER.

ALL NONMETALLIC CONDUITS IN WHICH WIRE OR CABLE IS NOT INSTALLED SHALL BE PLUGGED.

ALL CONDUIT ENDS AT THE TOP OF CONCRETE BASES SHALL BE CAPPED IF METALLIC OR PLUGGED IF NONMETALLIC IMMEDIATELY AFTER PLACEMENT AND BEFORE CONCRETE IS POURED. CONDUITS IN WHICH WIRE OR CABLE IS NOT INSTALLED SHALL REMAIN CAPPED OR PLUGGED.

BELL ENDS SHALL BE INSTALLED ON ALL PVC CONDUIT EXPOSED AT THE TOP OF CONCRETE BASES BEFORE INSTALLATION OF CABLE OR WIRE.

ENDS OF CONDUIT INSTALLED BELOW GRADE FOR FUTURE USE SHALL BE CAPPED IF METALLIC OR PLUGGED IF NONMETALLIC.

WHEN REQUIRED TO CONNECT NONMETALLIC CONDUIT TO METALLIC CONDUIT, ONLY ADAPTER FITTINGS, U.L. LISTED FOR ELECTRICAL USE, SHALL BE USED.

IF A BASE REQUIRES A DEEP FORM BECAUSE OF LOOSE DIRT OR FILL, THE FORM SHALL BE REMOVED BEFORE BACKFILLING AROUND THE BASE. BACKFILL SHALL BE TAMPED TIGHT AGAINST THE BARE CONCRETE BASE IN LAYERS OF 1 FOOT OR LESS.

A NO. 6 AWG, STRANDED COPPER GROUNDING WIRE SHALL BE CADWELDED TO THE GROUND ROD FOR TYPE 2 AND TYPE 5 BASES.

THE GROUNDING WIRE SHALL BE FURNISHED AND INSTALLED TO ENTER THE BASE OF THE TYPE 2 AND TYPE 5 BASES THROUGH A 1 INCH CONDUIT INSTALLED FOR GROUNDING PURPOSES, LEAVING A 4 FOOT COIL OF WIRE ABOVE THE CONCRETE BASE. THE GROUNDING WIRE SHALL BE NEATLY COILED AND THE COILS TIED TOGETHER.

ANCHOR BOLTS SHALL BE THREADED 8" IN LENGTH ON EACH END OF THE BOLT, AND BE MANUFACTURED IN ACCORDANCE WITH SECTION 640.2.9 OF THE STANDARD SPECIFICATIONS, ASTM A-449, OR ASTM A-687 (GRADE 105).

WHEN ANCHOR BOLTS USING THE ALTERNATE "L" BEND ARE FURNISHED, THE 4" "L" BEND SHALL BE IN ADDITION TO THE SPECIFIED ANCHOR BOLT BAR LENGTH. THE "L" BEND END SHALL NOT BE THREADED.

① THE MINIMUM DEPTH OF CONDUIT EXITING THE CONCRETE BASE AND INSTALLED BELOW THE TRAVELED WAY SHALL BE 24 INCHES. THE MINIMUM DEPTH OF CONDUIT EXITING THE CONCRETE BASE THAT IS NOT INSTALLED BELOW THE TRAVELED WAY SHALL BE 18 INCHES. THE MAXIMUM DEPTH OF ALL CONDUIT SHALL BE 36 INCHES EXCEPT WITH WRITTEN APPROVAL BY THE ENGINEER.

② (4) 1" DIA. X 3'-6" ANCHOR BOLTS.

③ (4) 1" DIA. X 5'-0" ANCHOR BOLTS.

④ (6) NO. 6 X 6'-8" BAR STEEL REINFORCEMENT.

⑤ (7) NO. 4 X 5'-1" BAR STEEL REINFORCEMENT @ 1'-0" C-C.

⑥ (4) 1" DIA. X 3'-6" ANCHOR BOLTS.

⑦ (6) NO. 4 X 4'-8" BAR STEEL REINFORCEMENT

⑧ (5) NO. 4 X 5'-1" BAR STEEL REINFORCEMENT @ 1'-0" C-C.


## CONCRETE BASES

STATE OF WISCONSIN  
DEPARTMENT OF TRANSPORTATION

APPROVED  
4/2/93  
DATE  
STATE ELECTRICAL ENGR FOR HWYS  
4/8/93  
DATE  
STATE TRAFFIC ENGINEER FOR HWYS  
FHWA

S.D.D. 9 C 2-1


FORM DEPTH SHALL BE  
NO MORE THAN 6" BELOW  
GRADE ON THE LOWER  
SIDE OF BASE

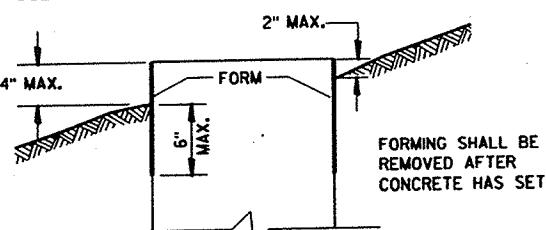

QUANTITY REQUIREMENTS	CONCRETE BASE TYPE		
	1	2	5
APPROX. CUBIC YARDS OF CONCRETE	.32	.57	.40
LBS. OF HOOP BAR STEEL	NONE	23	16
LBS. OF VERTICAL BAR STEEL	NONE	60	18

WELDING ANCHOR BOLTS TO THE CAGE  
IS UNACCEPTABLE. TIE WIRES SHALL BE USED.


## FORMING DETAIL

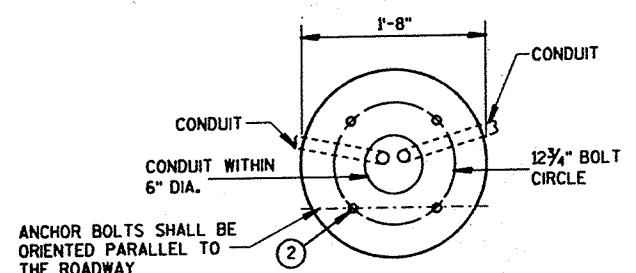


FORM ALL EXPOSED CONCRETE. PROVIDE 1" CHAMFER ALL AROUND

HALF SECTION IN UNPAVED AREA  
(TYPICAL FOR TYPES 1, 2 & 5)

TOPSOIL AND SEED OR CRUSHED AGGREGATE

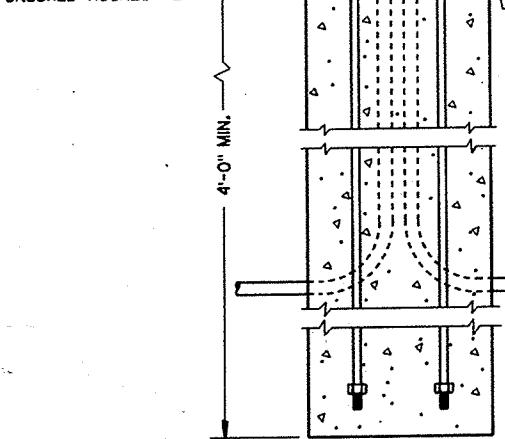

TYPE 1

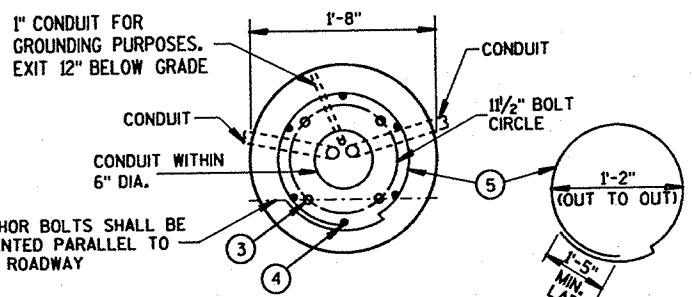

HALF SECTION IN PAVEMENT  
(TYPICAL FOR TYPES 1, 2 & 5)

FORM ALL EXPOSED CONCRETE. PROVIDE 1" CHAMFER ALL AROUND

LOCK WASHER (TYPICAL)



3/4" PREFORMED FILLER AS APPROVED BY THE ENGINEER

CADWELDED CONNECTION FOR GROUNDING WIRE

5/8" DIA. X 8'-0" COPPERCLAD GROUND ROD REQUIRED

OPTIONAL 4" L BEND OR HEX NUT (TYPICAL FOR TYPES 1, 2 & 5)

TYPE 2

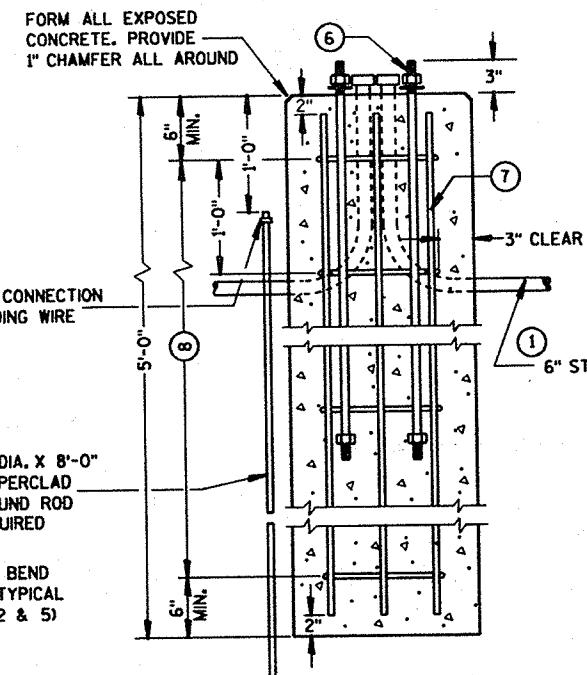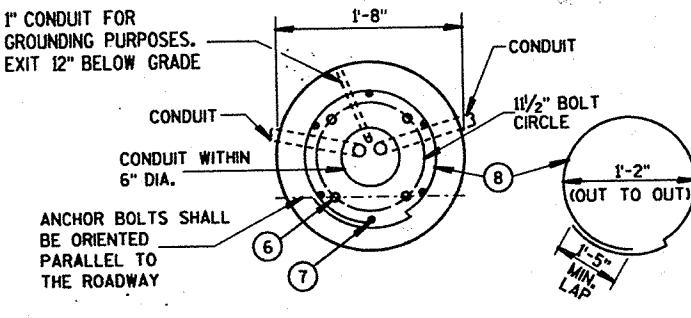

TYPE 5

## CONCRETE BASES

## GENERAL NOTES

DETAILS OF CONSTRUCTION, MATERIALS AND WORKMANSHIP NOT SHOWN ON THIS DRAWING SHALL CONFORM TO THE PERTINENT REQUIREMENTS OF THE CONTRACT.

FOUR (4) BOLTS TO BE FURNISHED WITH EACH TRANSFORMER BASE. BOLTS SHALL BE 1" DIAMETER, 4" IN LENGTH, WITH WASHERS, LOCK WASHERS AND NUTS. BOLTS, NUTS AND WASHERS SHALL BE MANUFACTURED IN ACCORDANCE WITH ASTM A-449, AND BE GALVANIZED IN ACCORDANCE WITH ASTM A-153, CLASS C.

4" BOLTS SHALL BE IN ACCORDANCE WITH SECTION 640.2.9 OF THE STANDARD SPECIFICATIONS, ASTM A-449 OR ASTM A-687 (GRADE 105).

LEVELING SHIMS, IF NEEDED, SHALL BE DESIGNED FOR THE PURPOSE AND USED UNDER CAST BASES WHEN PLUMBING POLES OR STANDARDS DURING INSTALLATION. THE USE OF WASHERS IN LIEU OF PROPER LEVELING SHIMS IS NOT ACCEPTABLE.

SHIM LENGTH SHALL BE LONG ENOUGH TO COMPLETELY COVER THE AREA UNDER THE LENGTH AND WIDTH OF THE BASE MOUNTING FLANGE.




DOUBLE NUTTING IS NOT ACCEPTABLE FOR LEVELING OR MOUNTING PURPOSES.

A NEMA APPROVED AND U.L. LISTED MECHANICAL CONNECTOR (LUG) AL/CU RATED AND SIZED TO ACCEPT #10 AWG STRANDED WIRE, SHALL BE FURNISHED AND INSTALLED IN THE PEDESTAL AND TRANSFORMER BASES.

THE MECHANICAL CONNECTOR SHALL BE INSTALLED USING A  $\frac{1}{4}$ " - 20 (TPI) STAINLESS STEEL HEX HEAD BOLT OF SUFFICIENT LENGTH TO FIRMLY ATTACH THE LUG TO THE BASE.


SHOULD THE MANNER OF ATTACHMENT OF THE LUG REQUIRE WASHERS, HEX NUTS, LOCK WASHER - THEY SHALL BE STAINLESS STEEL AS IS THE BOLT. THE MANNER OF ATTACHMENT SHALL NOT BLOCK ACCESSIBILITY TO WIRE PLACEMENT IN THE CONNECTOR.

TEST REPORTS FROM AN FHWA APPROVED INDEPENDENT LABORATORY SHALL BE PROVIDED CERTIFYING THAT THE BASE HAS BEEN TESTED AND MEETS OR EXCEEDS ALL OF THE APPLICABLE 1985 AASHTO BREAKAWAY REQUIREMENTS. A STATEMENT OF CERTIFICATION FROM FHWA ATTESTING THAT SUCH TESTS HAVE BEEN ACCEPTED AND APPROVED SHALL BE SUPPLIED ALONG WITH THE BID.

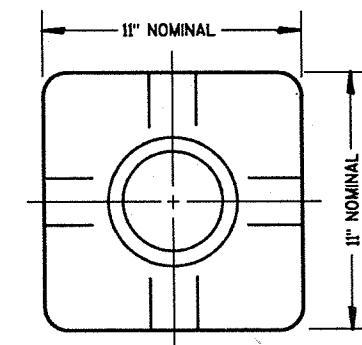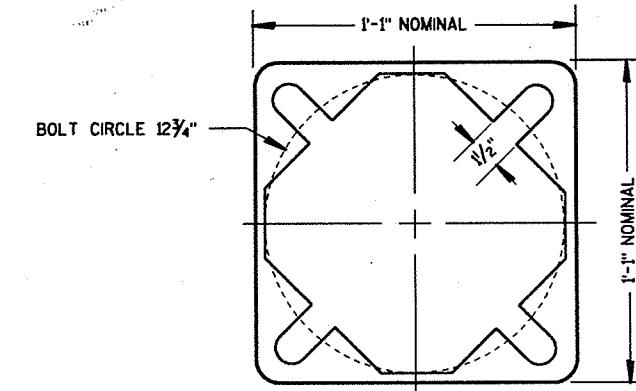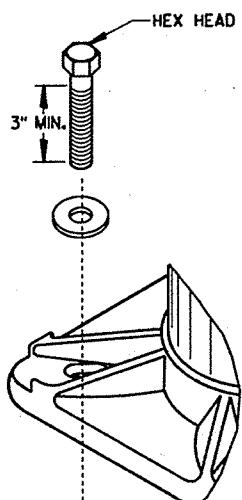

BOTTOM VIEW  
(PEDESTAL BASE)


TOP VIEW  
(PEDESTAL BASE)

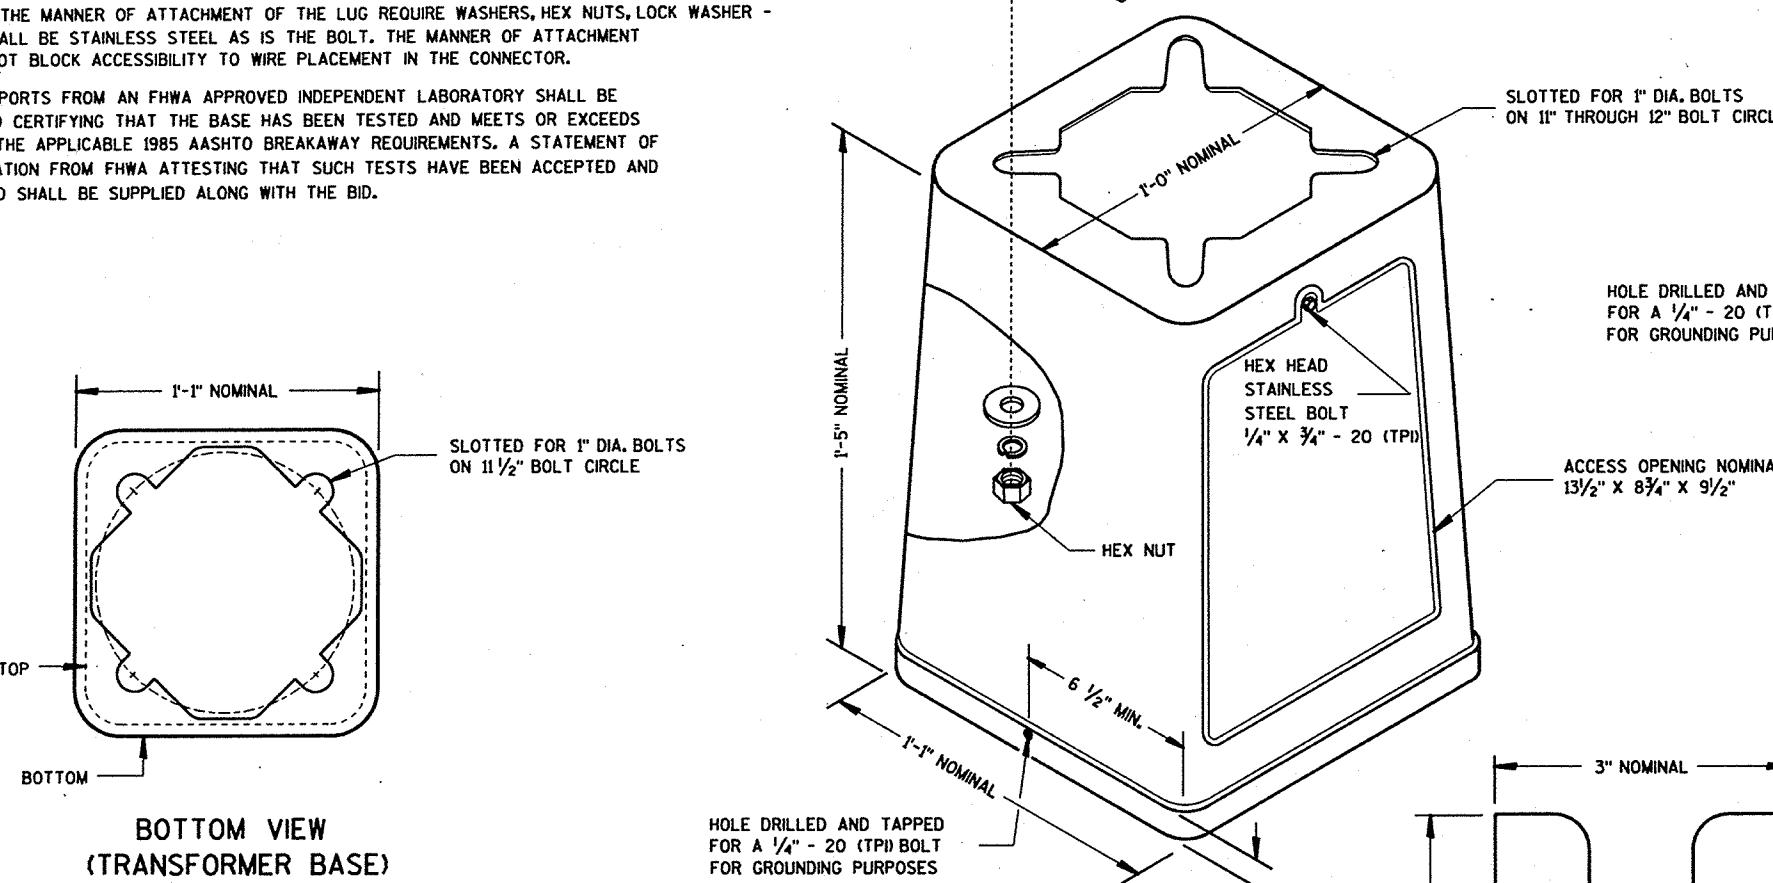


BOTTOM VIEW  
(TRANSFORMER BASE)

## TRANSFORMER BASE

INTENDED FOR USE WITH TYPE 2, 3, 4 & 5 POLES

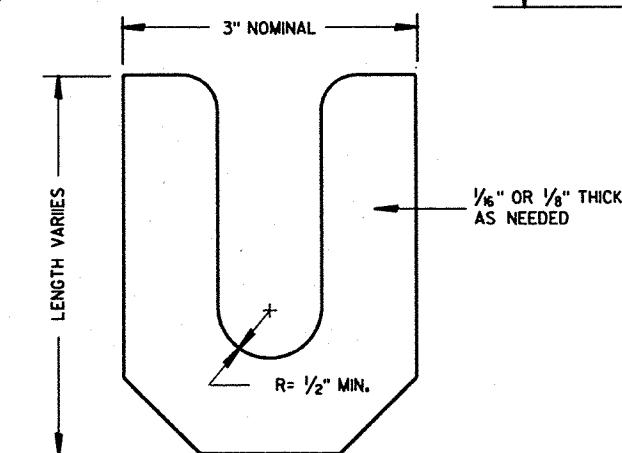

LEVELING SHIM

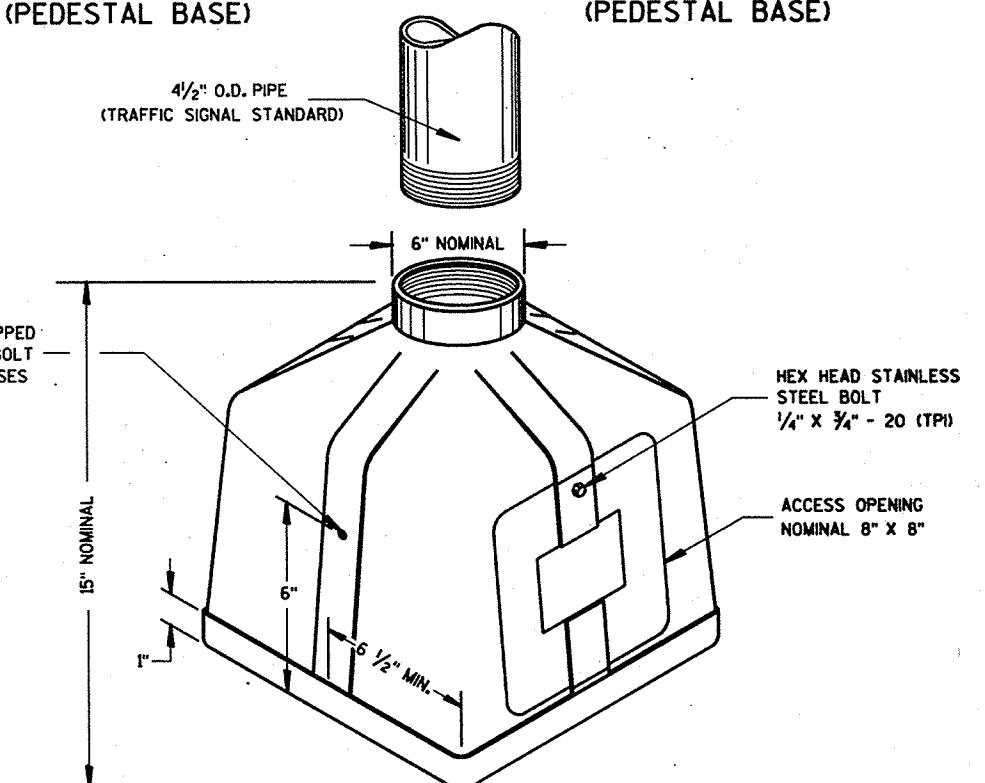


ISOMETRIC VIEW  
PEDESTAL BASE

CAST BASES	
STATE OF WISCONSIN DEPARTMENT OF TRANSPORTATION	
APPROVED 4/21/93 DATE	STATE ELECTRICAL ENGR FOR HWYS John Smith Signature
4/21/93 DATE	STATE TRAFFIC ENGINEER FOR HWYS Steve Kuech Signature
FHWA	

CONTROL CABINET BASE TYPE	DIMENSIONS				C.Y. CONCRETE (APPROX.)
	H	I	J	K	
TYPE 6 - 30" CABINET	34"	60"	10"	17"	.64
TYPE 7 - 38" CABINET	42"	60"	10"	21"	.93
TYPE 8 - 38" CABINET	42"	72"	12"	21"	1.29
TYPE 9 - VARIABLE	54"	72"	14"	27"	1.56
TYPE 10 - POST MOUNT	AS SHOWN				.32

TYPICAL 3'-0" X 3'-0"  
MAINTENANCE PLATFORM,  
LOCATION TO BE DETERMINED  
IN THE FIELD.

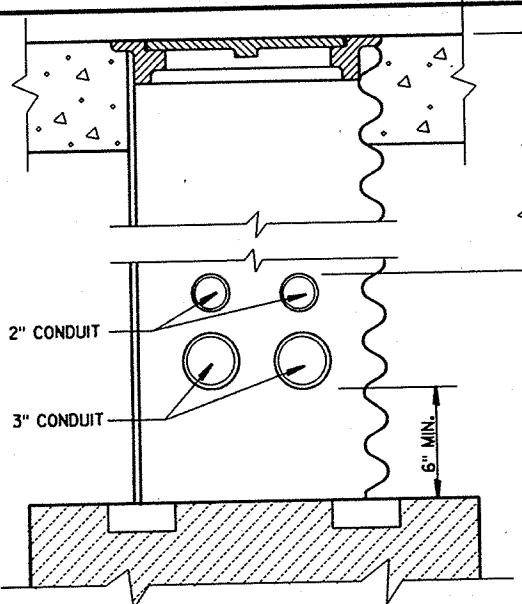

## GENERAL NOTES

DETAILS OF CONSTRUCTION, MATERIALS AND WORKMANSHIP NOT SHOWN ON THIS DRAWING SHALL CONFORM TO THE PERTINENT REQUIREMENTS OF THE CONTRACT.

INSTALL FOUR 1/2 INCH MINIMUM DIAMETER X 4 INCH MINIMUM LENGTH APPROVED CONCRETE MASONRY ANCHORS TO ANCHOR THE CABINET TO TYPE 6, 7, 8, AND 9 BASES. THE ANCHOR BOLTS SHALL BE LOCATED AS DIRECTED BY THE ENGINEER TO PROPERLY ANCHOR THE CONTROL CABINET TO THE BASE.

WHEN REQUIRED TO CONNECT NONMETALLIC CONDUIT TO METALLIC CONDUIT, ONLY ADAPTER FITTINGS, U.L. LISTED FOR ELECTRICAL USE, SHALL BE USED.

CONDUIT HEIGHT ABOVE THE CONCRETE BASE SHALL BE 1 INCH.

DEPTH OF CONDUIT INSTALLED BELOW THE TRAVELED WAY SHALL BE 24 INCHES MINIMUM AND 36 INCHES MAXIMUM.

DEPTH OF CONDUIT INSTALLED THAT IS NOT BELOW THE TRAVELED WAY SHALL BE 18 INCHES MINIMUM AND 36 INCHES MAXIMUM.

ANY EXCEPTION TO THE MAXIMUM DEPTH SHALL BE ONLY WITH THE WRITTEN APPROVAL OF THE ENGINEER.

CONTROL CABINET BASE TOP SURFACES SHALL BE TROWEL FINISHED AND LEVEL.

WHEN A TYPE 10 CONTROL CABINET BASE IS USED TO POST MOUNT A CONTROL CABINET, A 36" SQUARE 4" THICK CONCRETE MAINTENANCE PLATFORM SHALL BE REQUIRED ON THE DOOR SIDE OF THE CABINET. THE TOP 1INCH SHALL BE ABOVE FINISHED GRADE AND BE BROOM FINISHED AND LEVEL.

MAINTENANCE PLATFORMS ARE NOT REQUIRED WHEN THE SURROUNDING AREA IS PAVED.

MINIMUM BENDING RADIUS OF CONDUIT = 6 X THE DIAMETER.

ALL METALLIC CONDUIT ENDS SHALL BE REAMED AND THREADED.

ALL CONDUIT ENDS AT THE TOP OF CONCRETE BASES SHALL BE CAPPED IF METALLIC OR PLUGGED IF NONMETALLIC IMMEDIATELY AFTER PLACEMENT AND BEFORE CONCRETE IS POURED. CONDUITS IN WHICH WIRE OR CABLE IS NOT BEING INSTALLED SHALL REMAIN CAPPED OR PLUGGED.

ALL FOUR (TWO INCH AND THREE INCH) CONDUIT SHALL BE INSTALLED FROM THE CABINET BASE TO THE FIRST (NEAREST) PULL BOX LOCATED AS SHOWN ON THE PLANS.

BELL ENDS SHALL BE INSTALLED ON ALL PVC CONDUIT EXPOSED AT THE TOP OF THE CONCRETE BASE BEFORE INSTALLATION OF CABLE OR WIRE.


CONCRETE FORM DEPTH BELOW FINISHED GRADE SHALL BE 6" MAXIMUM. CONCRETE FORMS SHALL BE REMOVED AFTER CONCRETE HAS SET.

WHEN ANCHOR BOLTS USING THE ALTERNATE L BEND ARE FURNISHED FOR THE TYPE 10 BASE, THE 4" L BEND SHALL BE IN ADDITION TO THE SPECIFIED ANCHOR BOLT BAR LENGTH.



THE "L" BEND SHALL NOT BE THREADED.

STRAIGHT ANCHOR BOLTS SHALL BE THREADED 8" IN LENGTH ON EACH END OF THE BOLT.

① FOUR (4) ANCHOR BOLTS, 1" DIA. X 3'-6" ANCHOR BOLTS SHALL BE MANUFACTURED IN ACCORDANCE WITH SECTION 640.2.9 AND 6412.2 OF THE STANDARD SPECIFICATIONS AND IN ACCORDANCE WITH A-449.

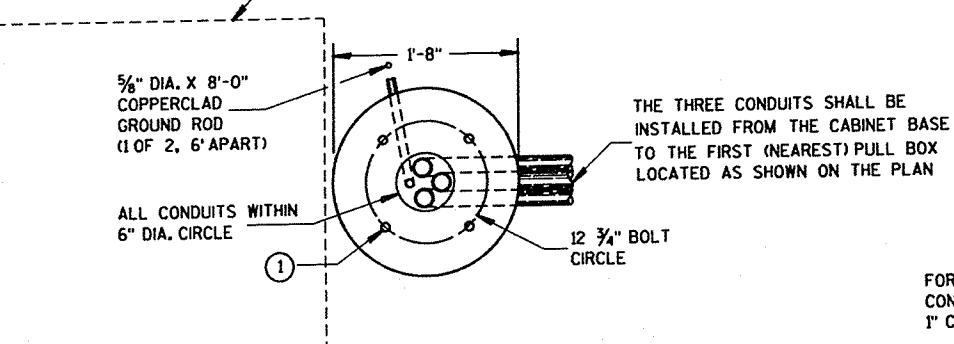

CONDUIT LOCATIONS IN 24" X 36" PULL BOX  
(LEADING TO CONTROLLER CABINET BASE TYPE 6, 7, 8 AND 9)

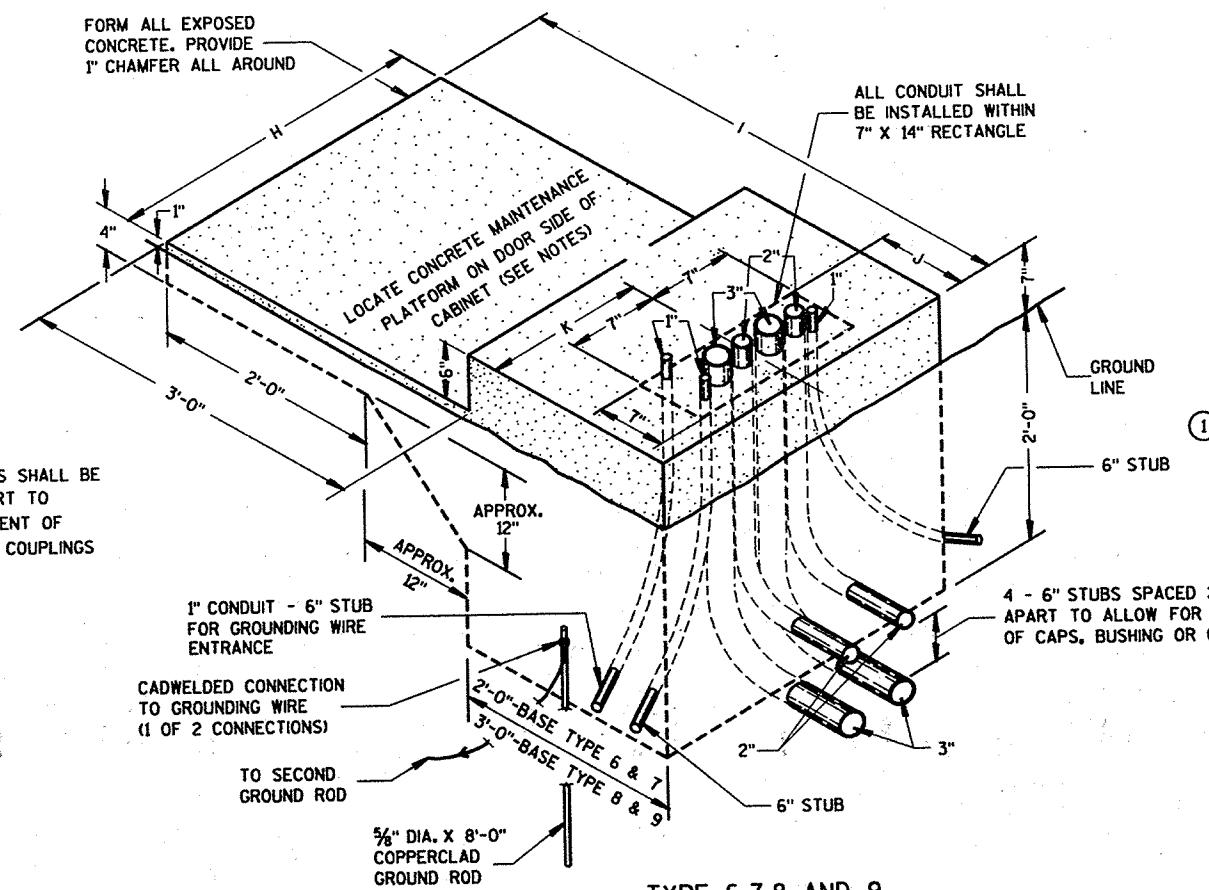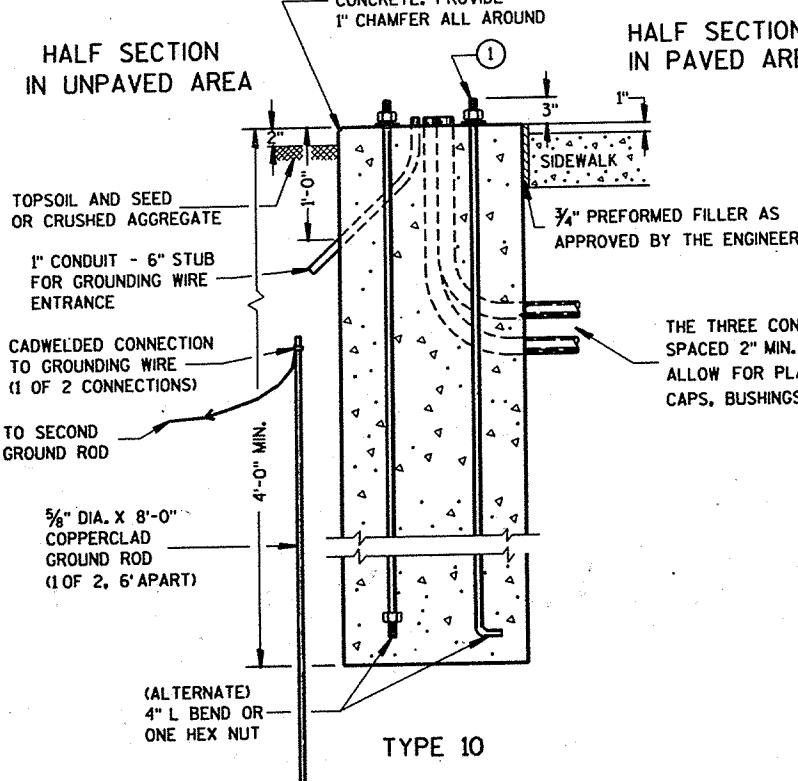


TYPE 6,7,8 AND 9  
(ISOMETRIC VIEW)

CONCRETE CONTROL CABINET BASES

## CONCRETE CONTROL CABINET BASES

STATE OF WISCONSIN  
DEPARTMENT OF TRANSPORTATION

APPROVED	<i>Paul Busch</i>
4/21/93	DATE
4/21/93	DATE
FHWA	STATE ELECTRICAL ENGR FOR HWYS
	STATE TRAFFIC ENGINEER FOR HWYS

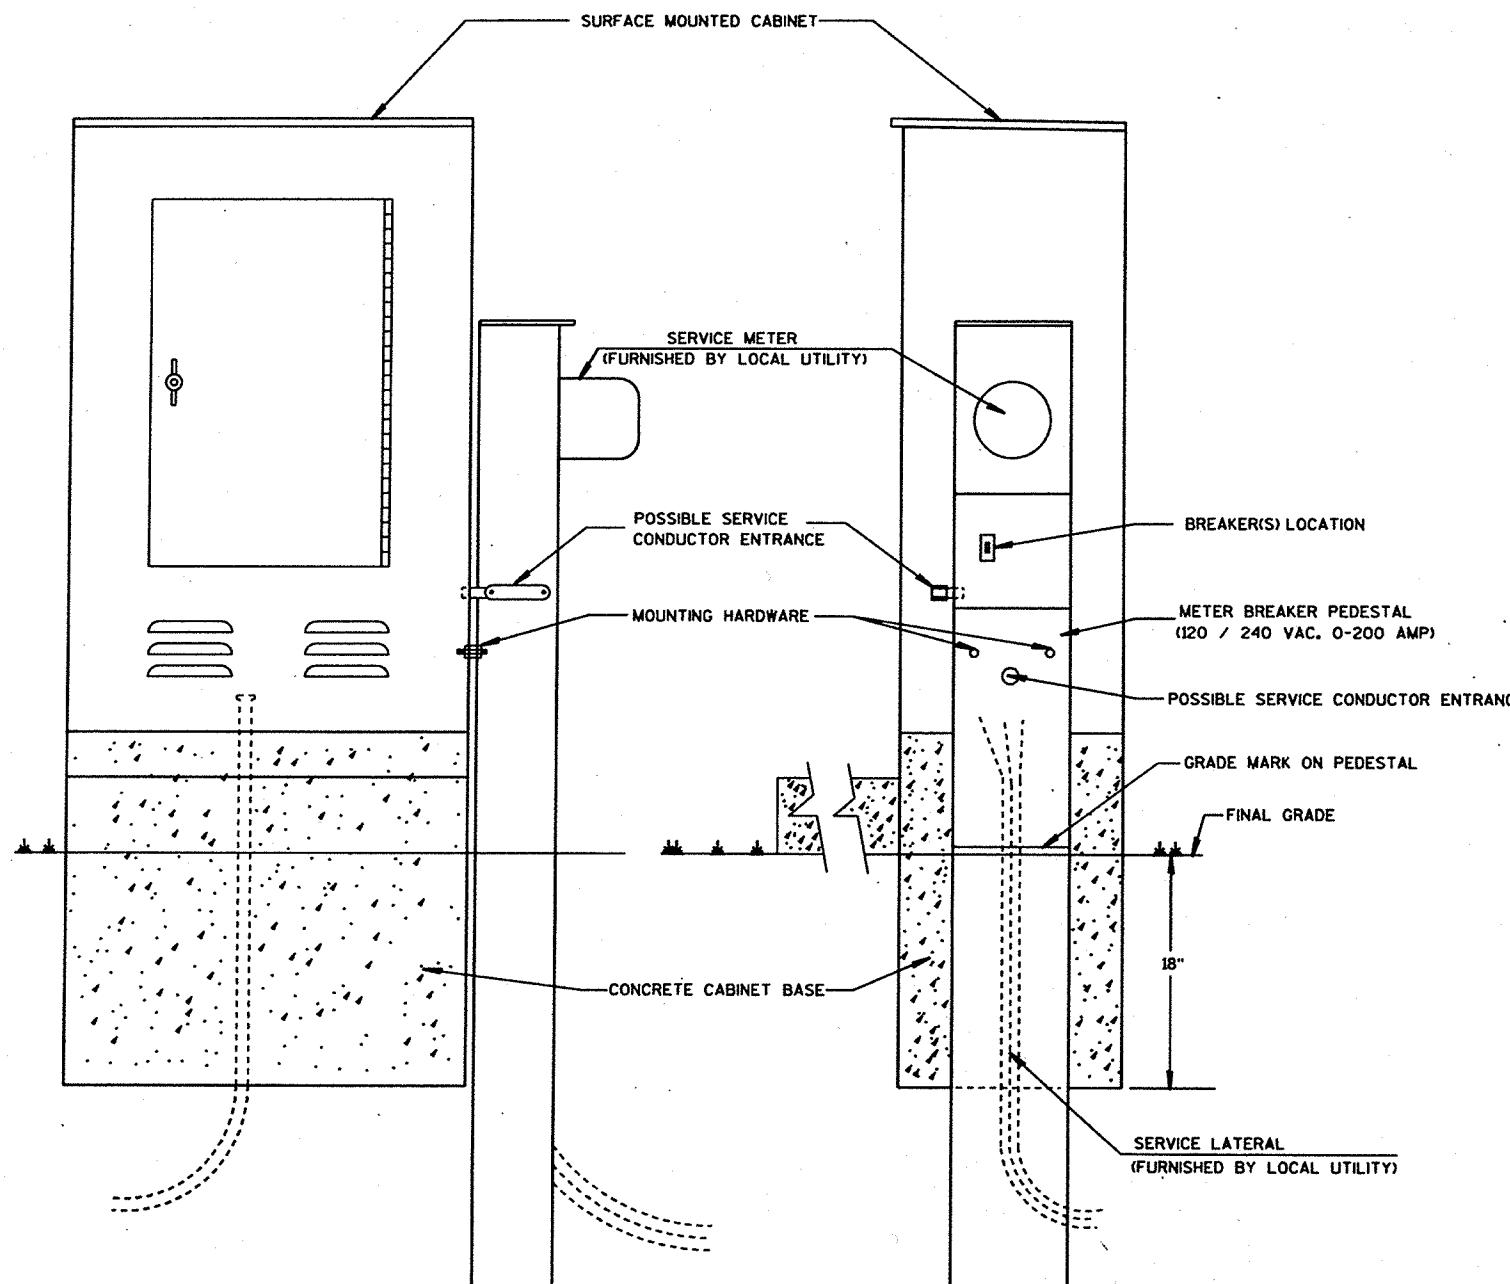

TYPICAL CABINET SERVICE INSTALLATION

GENERAL NOTES

DETAILS OF CONSTRUCTION, MATERIALS AND WORKMANSHIP NOT SHOWN ON THIS DRAWING SHALL CONFORM TO THE PERTINENT REQUIREMENTS OF THE CONTRACT.







THE EXACT LOCATION OF THE METER BREAKER PEDESTAL SHALL BE DETERMINED BY THE ENGINEER IN THE FIELD.

THE TYPE OF CONCRETE CABINET BASE TO BE INSTALLED SHALL BE AS CALLED FOR IN THE PLANS.

SERVICE CONDUCTOR ENTRANCES SHALL BE RIGID CONDUIT, NIPPLES AND/OR CONDULETS AS REQUIRED.

SERVICE CONDUCTOR ENTRANCES SHALL BE SIZED AS REQUIRED AND IN ACCORDANCE WITH APPROPRIATE ARTICLES OF THE LATEST ACCEPTED NATIONAL ELECTRICAL CODE.

CABINET SERVICE INSTALLATION	
STATE OF WISCONSIN DEPARTMENT OF TRANSPORTATION	
APPROVED 4/21/93 DATE 4/21/93 DATE	STATE ELECTRICAL ENGR FOR HWYS STATE TRAFFIC ENGINEER FOR HWYS FHWA

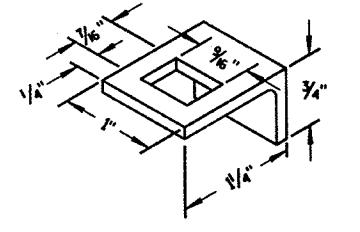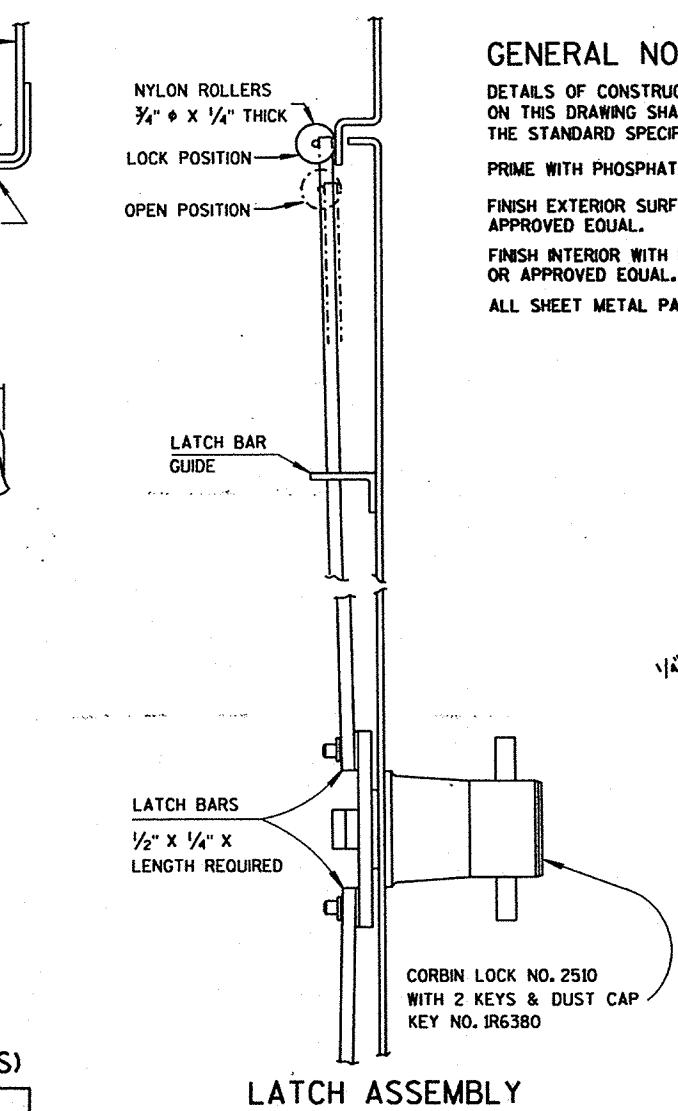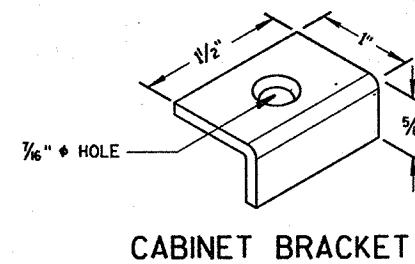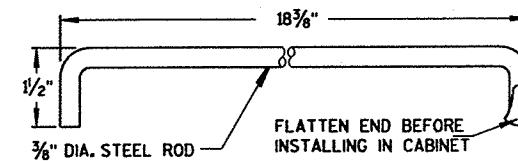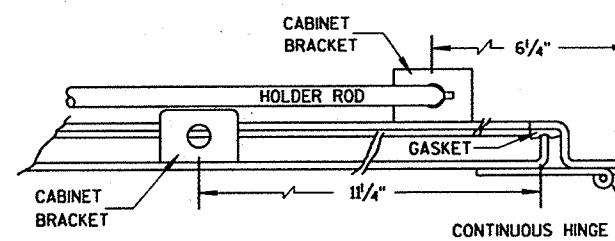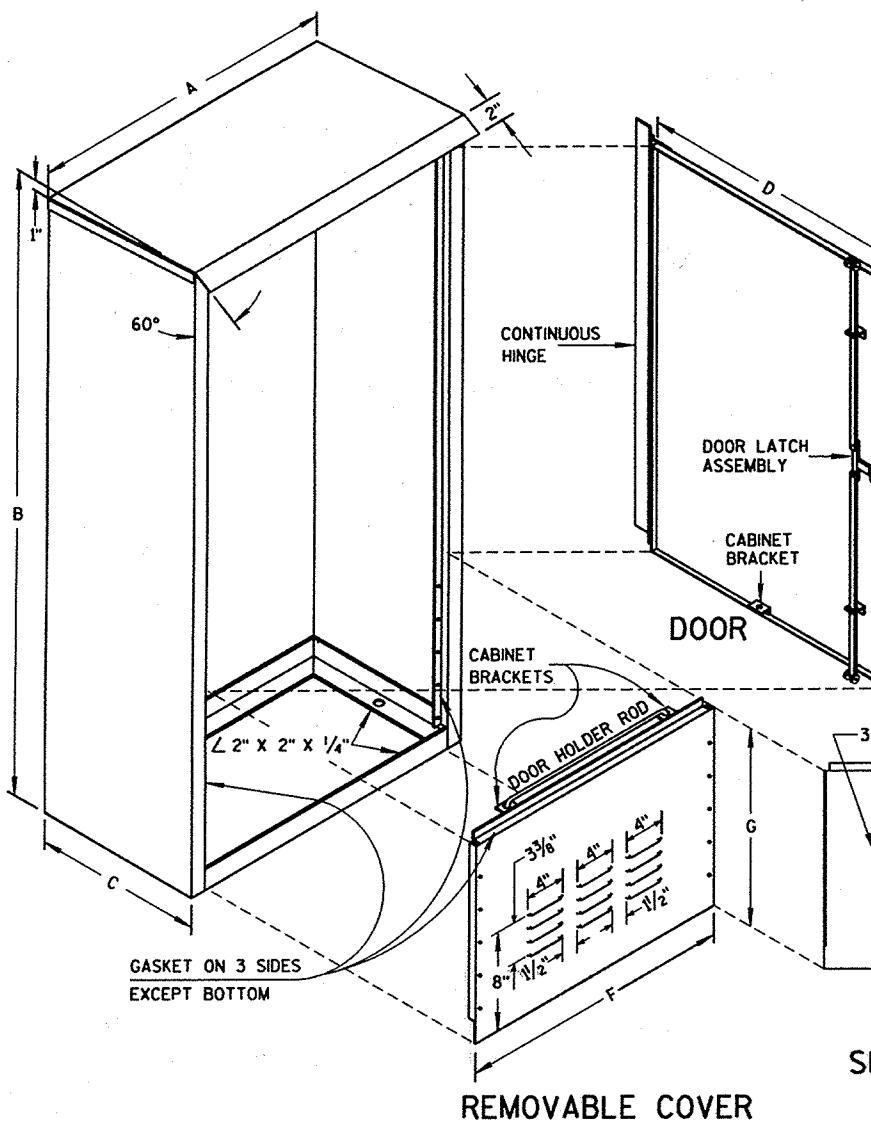

### GENERAL NOTES

DETAILS OF CONSTRUCTION, MATERIALS AND WORKMANSHIP NOT SHOWN ON THIS DRAWING SHALL CONFORM TO THE PERTINENT REQUIREMENTS OF THE STANDARD SPECIFICATIONS AND APPLICABLE SPECIAL PROVISIONS.

PRIME WITH PHOSPHATE TREATMENT AND PRIMER.

FINISH EXTERIOR SURFACES WITH RUSTOLEUM #906 SILVER GRAY OR APPROVED EQUAL.

FINISH INTERIOR WITH RUSTOLEUM #2766 HIGH GLOSS WHITE ENAMEL OR APPROVED EQUAL.

ALL SHEET METAL PARTS SHALL BE 12 GA. H.R.P&O.

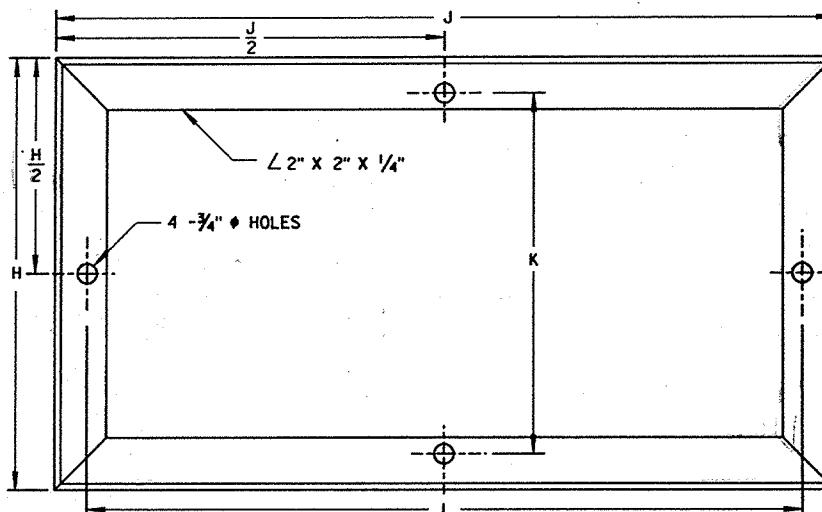



TABLE OF DIMENSIONS (INCHES)

MARK	CABINET TYPE		
	3060	3860	3866
A	30	38	38
B	60	60	66
C	16 1/2	16 1/2	24
D	26 1/2	34 3/4	33 3/4
E	38 3/4	38 3/4	38 3/4
F	26 1/2	34 3/4	33 3/4
G	19	19	25
H	16 1/2	16 1/2	24
J/2	8 1/4	8 1/4	12
J	30	38	38
K	13 3/4	13 3/4	21 1/4
L	27 1/2	35 1/2	35 1/2


SIGNAL OR LIGHTING  
CONTROL CABINET

STATE OF WISCONSIN  
DEPARTMENT OF TRANSPORTATION


APPROVED  
4/1/93  
DATE  
4/22/93  
DATE  
STATE ELECTRICAL ENGR. FOR HWYS  
STATE TRAFFIC ENGINEER FOR HWYS  
FHWA

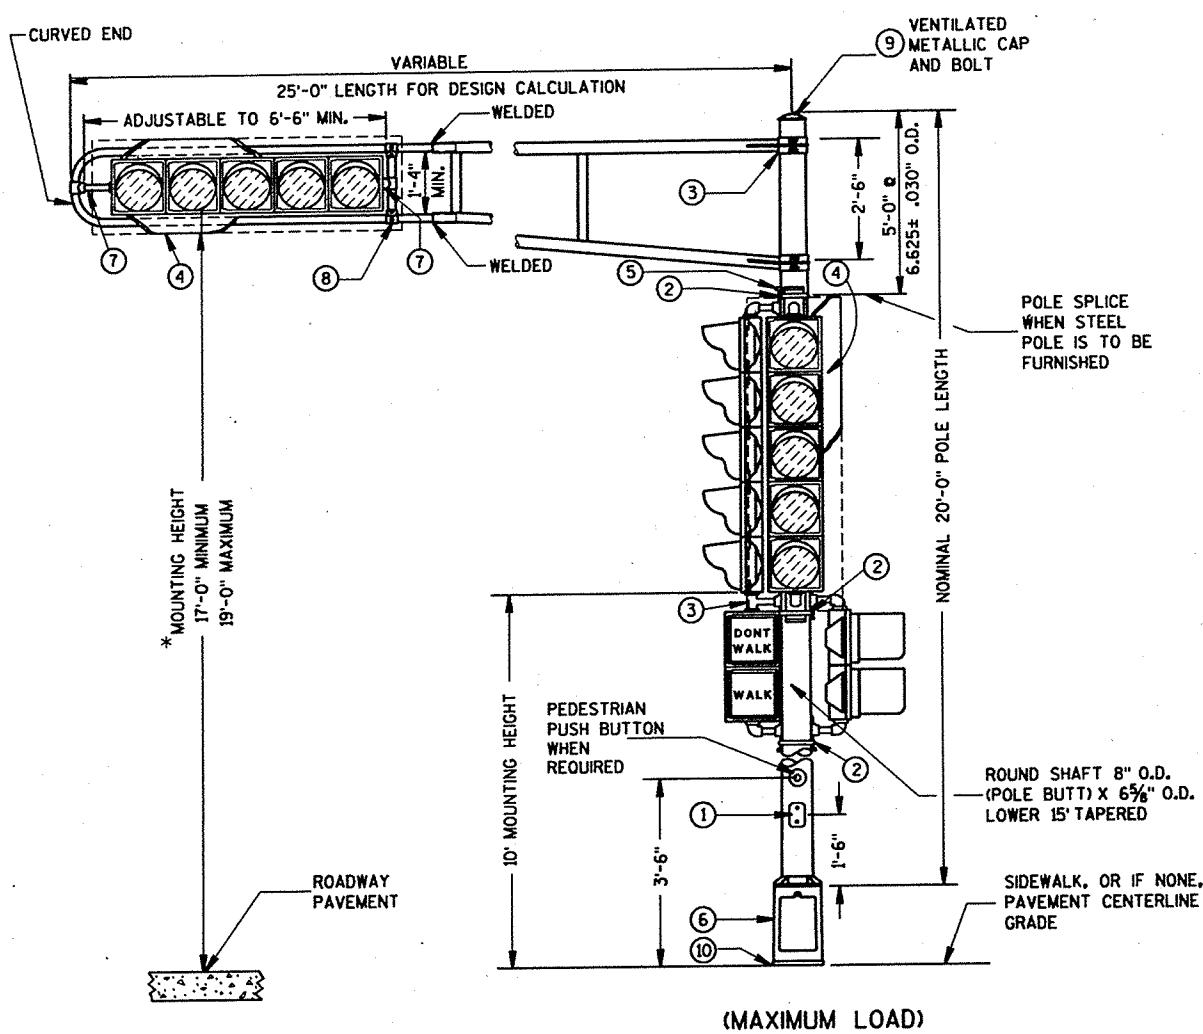

TYPICAL MOUNTING OF BACK TO BACK  
3 AND 5 SECTION SIGNAL FACES  
TYPE 2 POLE MOUNTING CONFIGURATION

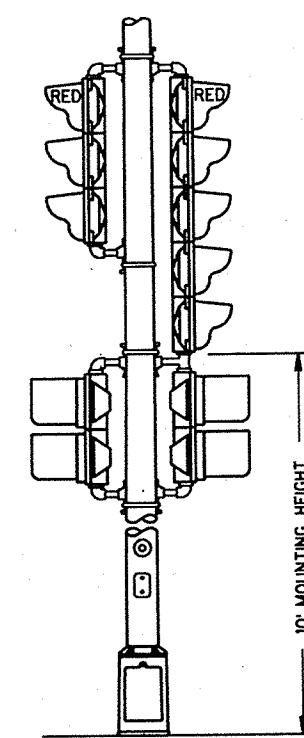

TYPICAL MOUNTING OF 3 SECTION  
SIGNAL FACE

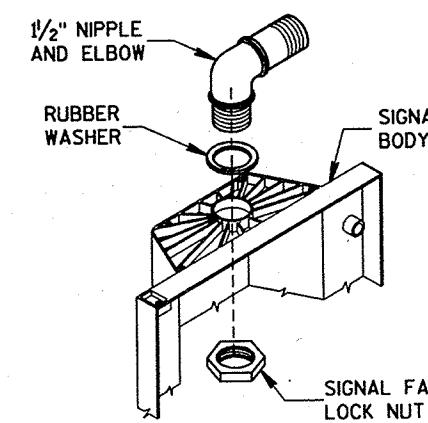



SIGNAL FACE MOUNTING DETAIL

#### GENERAL NOTES

- ① 4" X 6" REINFORCED HANHOLE & COVER ASSEMBLY WITH 2 (TWO) 1/4" X 3/4" - 20 TPI HEX HEAD STAINLESS STEEL BOLTS.
- ② SIGNAL FACE MOUNTING BRACKETS. MOUNT WITH CAP SCREWS AND BANDING. (SEE SPECIAL PROVISIONS).
- ③ GROMMETS, 1" CHASE NIPPLES OR 1" CLOSE CONDUIT NIPPLES WITH BUSHINGS SHALL BE PROVIDED FOR 1 1/8" HOLE IN POLE SHAFT FOR WIRING.
- ④ BACKBOARDS ARE REQUIRED AT ALL TIMES ON TROMBONE MAST ARM MOUNTED SIGNAL FACES. VERTICAL MOUNTED SIGNAL FACES WITH BACKBOARDS REQUIRED ARE LOCATED AS SHOWN ON THE PLANS. BACKBOARDS ARE REQUIRED TO SURROUND SIGNAL FACES. BACKBOARDS SHALL EXTEND 5' BEYOND EXTREMITIES OF THE SIGNAL FACE.
- ⑤ POLE MOUNTED SIGNAL FACES SHALL REQUIRE 1 OR MORE MOUNTING SPACERS UNDER THE TOP MOUNTING BRACKET(S) AS REQUIRED, TO PLUMB THE SIGNAL FACES.
- ⑥ CAST ALUMINUM TRANSFORMER BASE, WHEN REQUIRED.
- ⑦ 1 1/2" PIPE THREAD ON THE MOUNTING BRACKET NIPPLES FOR THE SIGNAL FACE. NIPPLE SHALL BE 1 1/2" X 2".
- ⑧ VERTICAL STRUT (ADJUSTABLE). ONE (1) SET SCREW (1/4" X 3/4" LONG-20 TPI, STAINLESS STEEL, HEX HEAD) INTO EACH ARM MEMBER IF STRUT IS THE SLIDING TYPE.
- ⑨ FURNISH AND INSTALL VENTILATED, CAST, METALLIC (ALUMINUM ALLOY) CAPS. FASTEN CAPS WITH ONE (1) 1/4" X 3/4" - 20 TPI STAINLESS STEEL, HEX HEAD BOLT.
- ⑩ SHIMMING, IF NEEDED, SHALL BE LOCATED BETWEEN THE CONCRETE FOUNDATION AND THE TRANSFORMER BASE.

\*MOUNTING HEIGHT LIMITATION DIMENSIONS OF THE TROMBONE MAST ARM WILL BE DEPENDENT UPON THE USE/NON-USE OF A TRANSFORMER BASE.

WELD TO BE 100% R.T. OR U.T. TESTED AS PER THE REQUIREMENTS OF AWS D 1.5-88. RECORDS OF CERTIFICATION OF COMPLIANCE OF SUCH TESTING SHALL BE FURNISHED TO THE PROJECT ENGINEER FOR APPROVAL PRIOR TO SHIPMENT OF THE POLES. VERIFICATION AND APPROVAL OF THE TESTING CERTIFICATION FROM THE MANUFACTURER SHALL BE COMPLETED BY THE CENTRAL OFFICE BRIDGE SECTION.

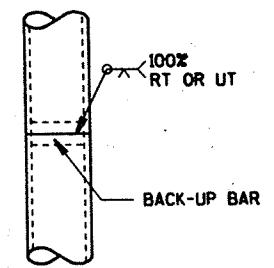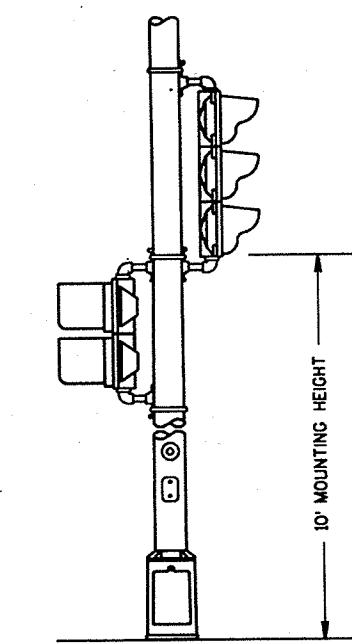


NOTE:  
SHEET SDD 9 E 1-1a IS REQUIRED WHEN THIS DRAWING IS CALLED FOR IN THE PLANS.


DESIGN NOTE: (WILL NOT APPEAR ON CONTRACT PLANS)  
THIS DETAIL IS APPLICABLE WHEN SIGNALS ARE MOUNTED ON A TROMBONE ARM. DO NOT USE FOR LIGHTING.

POLE MOUNTINGS FOR  
TRAFFIC SIGNALS  
TYPE 2



STATE OF WISCONSIN  
DEPARTMENT OF TRANSPORTATION

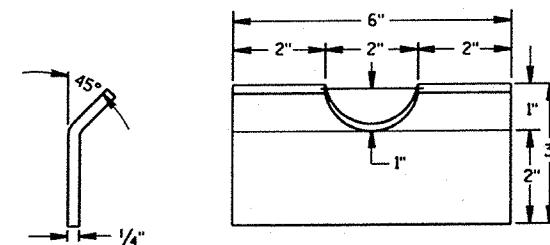


END VIEW  
RECTANGULAR CLAMP SHIM  
(4 TO A SET)

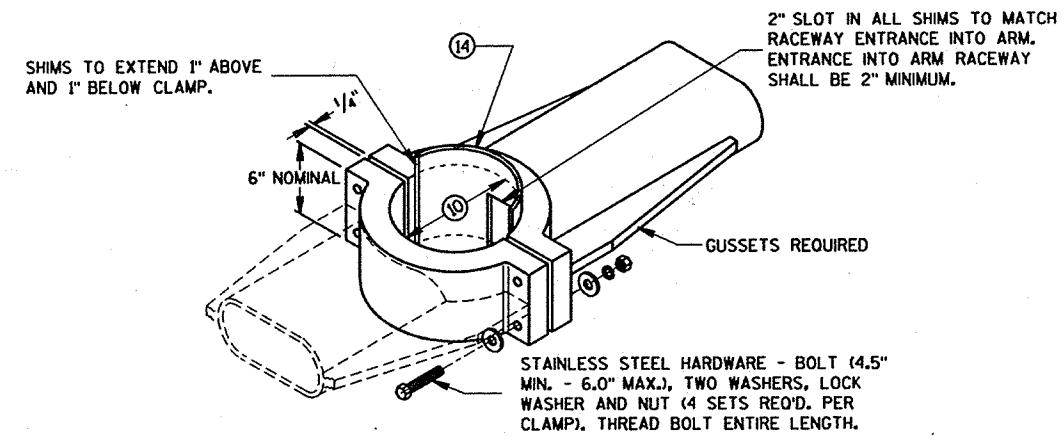


TYPICAL TROMBONE MAST ARM AND  
LUMINAIRE MAST ARM MOUNTING CLAMP

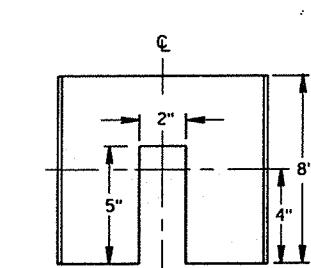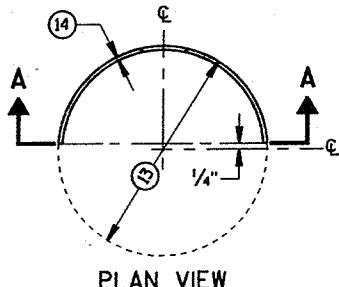



SECTION A-A  
CIRCULAR CLAMP SHIM  
(2 TO A SET)

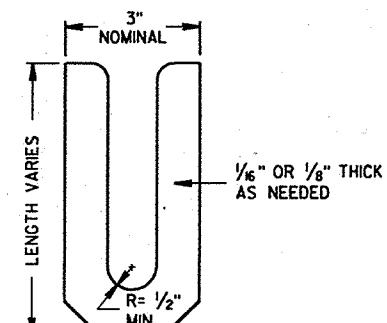


LEVELING SHIM (15)

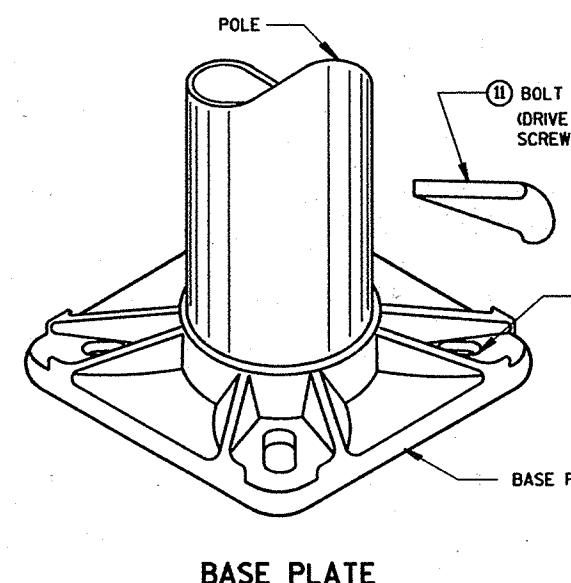

BASE PLATE

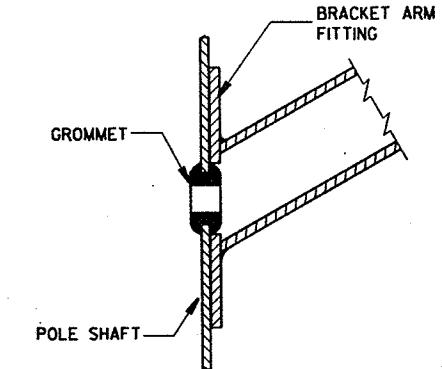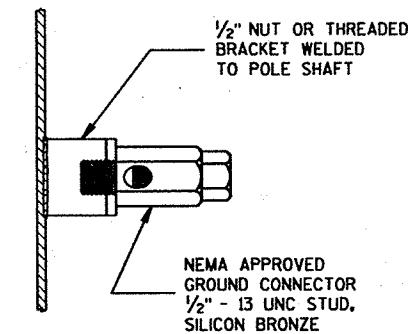


TYPICAL APPLICATION OF  
GROMMET IN POLE SHAFT

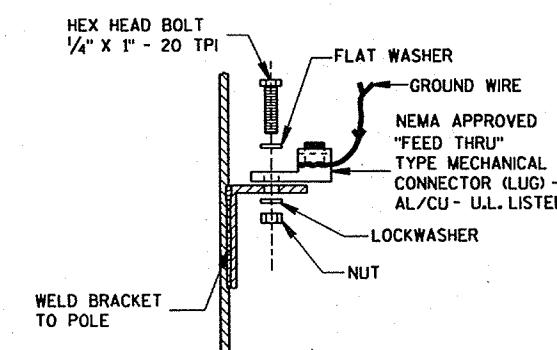


TYPICAL GROUNDING CONNECTIONS

NUT, BOLT AND WASHERS SHALL  
BE STAINLESS STEEL

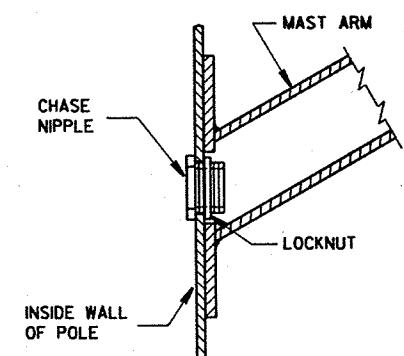

TYPICAL APPLICATION OF  
CHASE NIPPLE IN POLE SHAFT

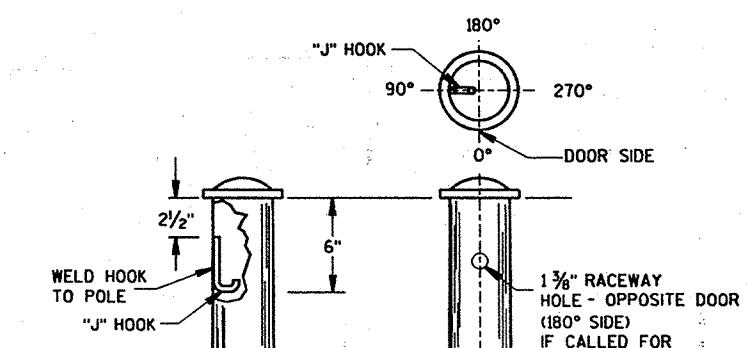

TYPICAL "J" HOOK LOCATION


NOTE:  
THIS DRAWING IS REQUIRED WHEN DRAWINGS  
SDD 9 E 1-a, b, c, OR d IS CALLED FOR IN  
THE PLANS.

HARDWARE DETAILS FOR  
POLE MOUNTINGS

STATE OF WISCONSIN  
DEPARTMENT OF TRANSPORTATION

APPROVED

4/21/93  
DATE  
John Smith  
STATE ELECTRICAL ENGR FOR HWYS  
4/21/93  
DATE  
Paul Kusch  
STATE TRAFFIC ENGINEER FOR HWYS  
FHWA

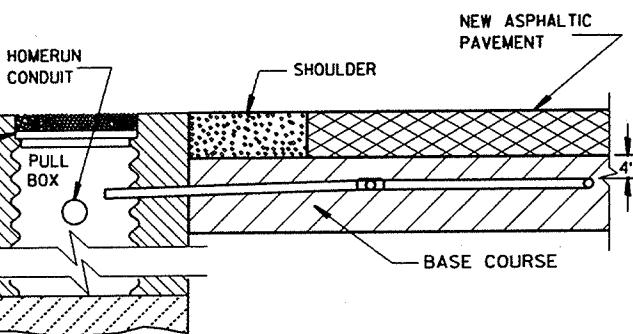

SECTION A-A  
NO CURB & GUTTER  
DETECTOR LOOP INSTALLATION DETAIL

\*RECESS PULL BOX SO THAT THE COVER IS 3" BELOW GRADE IN SHOULDER AREAS OF CRUSHED AGGREGATE. BACKFILL OVER COVER WITH THE CRUSHED AGGREGATE TO BRING THE AREA TO GRADE LEVEL.

#### GENERAL NOTES

DETAILS OF CONSTRUCTION, MATERIALS AND WORKMANSHIP NOT SHOWN ON THIS DRAWING SHALL CONFORM TO THE PERTINENT REQUIREMENTS OF THE CONTRACT.

LOOP SIZE, LOCATION, NUMBER OF TURNS OF WIRE AND ASSOCIATED SIGNAL PHASE SHALL BE AS SHOWN ON THE PLANS.

PITCH LEAD-OUT CONDUIT TO DRAIN TO ROADSIDE PULL BOX.

SPlices shall be installed by using cast in place splice kits such as 3M type 82A1 or approved equal. Non-insulated butt splices to fit #12 AWG stranded wire shall be used. Splices shall be soldered and insulated from each other as per instructions included in the splice kit.

THE GROUND RESISTANCE READING OF THE LOOP SHALL READ "INFINITY" TO GROUND ON AN OHMMETER USING A MULTIPLIER SCALE OF 1 MEGOHM AND AN INPUT RESISTANCE OF 11 MEGOHMS MINIMUM BEFORE SPLICING THE LOOP TO THE LEAD-IN CABLE.

AFTER SPLICING THE LOOP WIRE TO THE LOOP LEAD-IN CABLE, THE CONTRACTOR SHALL MEASURE INDUCTANCE, GROUND RESISTANCE AND WIRE RESISTANCE AT THE CABINET END OF THE LEAD-IN CABLE AND FURNISH A COPY OF THE READINGS TO THE PROJECT ENGINEER FOR EVALUATION.

ANTI-SIEZE LUBRICATING MATERIAL SHALL BE USED ON ALL THREADS OF THREADED ASSEMBLIES BEFORE INSTALLATION.

LOOP DETECTOR LEADS SHALL BE IDENTIFIED WITH THEIR ASSOCIATED LOOP BY USE OF WATERPROOF TAGS AT BOTH ENDS OF THE CABLE. A LISTING OF THE CABLE IDENTIFICATION PER INDIVIDUAL LOOP LEAD-IN SHALL BE PLACED IN THE CABINET.

THE #12 AWG LOOP WIRE FROM THE LOOP TO THE ROADSIDE PULL BOX, SHALL BE HAND TWISTED AT LEAST 3 TURNS PER FOOT BEFORE INSTALLATION.

SPlices of loop wire to lead-in cable shall be made only in pull boxes at the side of the road.


THE #12 AWG LOOP WIRE SHALL BE INSTALLED FROM THE ROADSIDE PULL BOX, THROUGH THE LOOP DUCT, BACK TO THE ROADSIDE PULL BOX, AND BE INSTALLED IN ONE, NON-SPliced, CONTINUOUS LENGTH.

PROTECTION OF THE CONDUIT AND CONDULET SHALL BE REQUIRED AFTER INSTALLATION AND BEFORE THE ASPHALTIC PAVEMENT IS PLACED.


WHEN MULTIPLE LAYERS OF ASPHALTIC PAVEMENT ARE TO BE PLACED, LOOPS MAY BE INSTALLED BY SAWING A TWO INCH WIDE SLOT IN THE FIRST LAYER, DIG OUT THE ASPHALTIC MATERIAL AND BASE COURSE, PLACE THE LOOP, FILL THE SLOT WITH BASE COURSE MATERIAL AND NEW ASPHALTIC MATERIAL AND TAMP THE ASPHALTIC MATERIAL IN PLACE.

SHOULD TRAFFIC BE ALLOWED TO USE THE AREA OF ROADWAY WITH THE NEWLY INSTALLED LOOP BEFORE THE PLACEMENT OF THE NEXT LAYER OF ASPHALTIC PAVEMENT, THE SLOT SHALL BE SEALED AS STATED IN THE SPECIAL PROVISIONS.


DRIVE A 1 1/2" MAX. PK NAIL INTO THE NEW ASPHALTIC PAVEMENT AND DIRECTLY ABOVE THE CONDULET AFTER THE FINAL LAYER OF NEW ASPHALTIC PAVEMENT IS COMPLETELY INSTALLED, IF REQUIRED BY THE DISTRICT TRAFFIC SECTION.

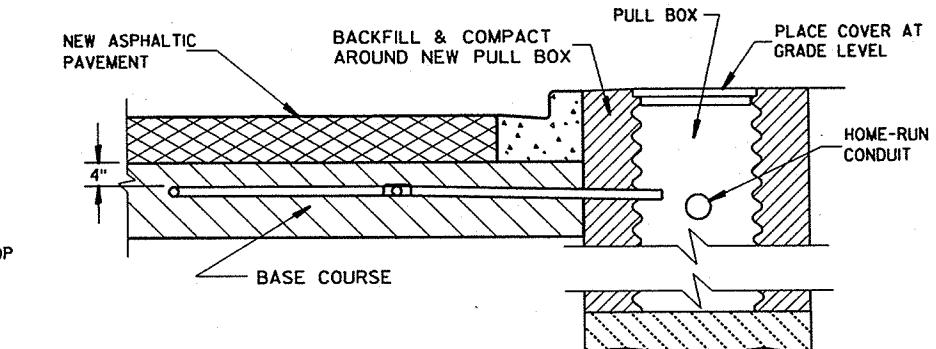

SECTION B-B  
CURB & GUTTER  
LOOP DETECTOR INSTALLATION DETAIL

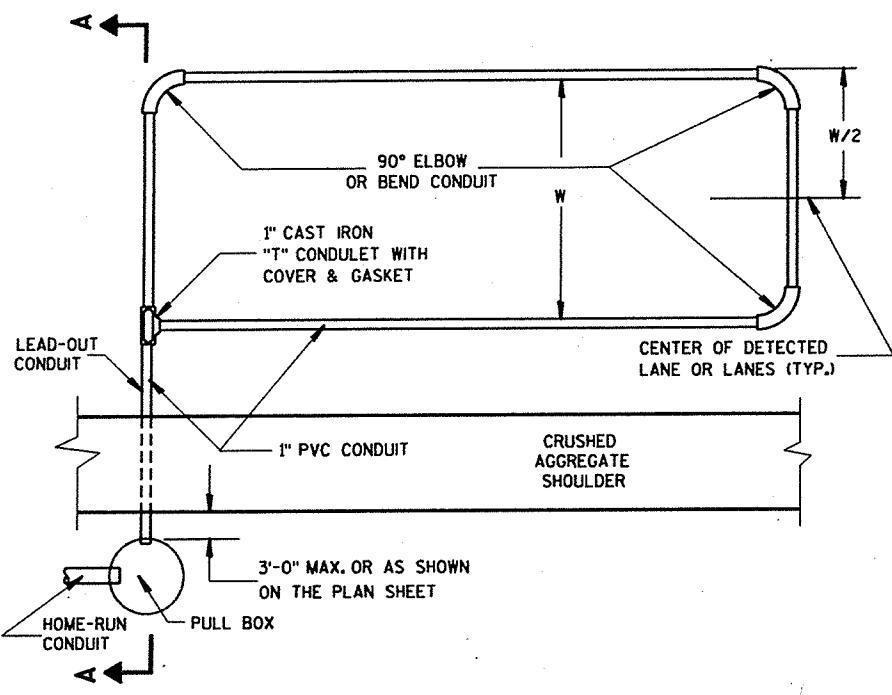

TYPICAL PLAN OF LOOP DETECTOR

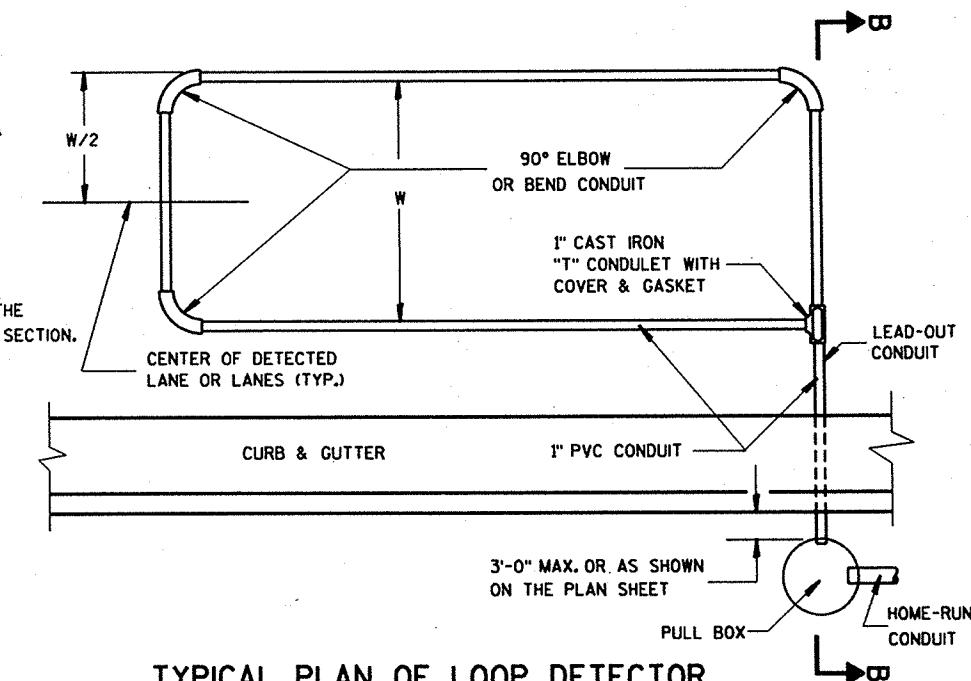

TYPICAL PLAN OF LOOP DETECTOR

LOOP DETECTOR PLACED  
IN CRUSHED AGGREGATE BASE  
(NEW ASPHALTIC PAVEMENT)

STATE OF WISCONSIN  
DEPARTMENT OF TRANSPORTATION

APPROVED

4/21/93  
DATE  
STATE ELECTRICAL ENGR FOR HWYS  
4/21/93  
DATE  
STATE TRAFFIC ENGINEER FOR HWYS  
FHWA

## GENERAL NOTES

DETAILS OF CONSTRUCTION, MATERIALS AND WORKMANSHIP NOT SHOWN ON THIS DRAWING SHALL CONFORM TO THE PERTINENT REQUIREMENTS OF THE CONTRACT.

LOOP SIZE, LOCATION, NUMBER OF TURNS OF WIRE AND ASSOCIATED SIGNAL PHASE SHALL BE AS SHOWN ON THE PLANS.

PITCH LEAD OUT CONDUIT TO DRAIN TO ROADSIDE PULL BOX.

SPlices shall be installed by using cast in place splice kits such as 3M type 82A1 or approved equal. Non-insulated butt splices to fit #12 AWG stranded wire shall be used. Splices shall be soldered and insulated from each other as per instructions, included in the splice kit.

THE GROUND RESISTANCE READING OF THE LOOP SHALL READ "INFINITY" TO GROUND ON AN OHMMETER USING A MULTIPLIER SCALE OF 1MEGOMH AND AN INPUT RESISTANCE OF 11MEGOMHS MINIMUM BEFORE SPLICING THE LOOP TO THE LEAD-IN CABLE.

AFTER SPLICING THE LOOP WIRE TO THE LOOP LEAD-IN CABLE, THE CONTRACTOR SHALL MEASURE INDUCTANCE, GROUND RESISTANCE AND WIRE RESISTANCE AT THE CABINET END OF THE LEAD-IN CABLE AND FURNISH A COPY OF THE READINGS TO THE PROJECT ENGINEER FOR EVALUATION.

ANTI-SIEZE LUBRICATING MATERIAL SHALL BE USED ON ALL THREADS OF THREADED ASSEMBLIES BEFORE INSTALLATION.


LOOP DETECTOR LEADS SHALL BE IDENTIFIED WITH THEIR ASSOCIATED LOOP BY USE OF WATERPROOF TAGS AT BOTH ENDS OF THE CABLE. A LISTING OF THE CABLE IDENTIFICATION PER INDIVIDUAL LOOP LEAD-IN SHALL BE PLACED IN THE CABINET.

THE #12 AWG LOOP WIRE FROM THE LOOP TO THE ROADSIDE PULL BOX, SHALL BE HAND TWISTED AT LEAST 3 TURNS PER FOOT BEFORE INSTALLATION.

SPlices of loop wire to lead-in cable shall be made only in pull boxes at the side of the road.

THE #12 AWG LOOP WIRE SHALL BE INSTALLED FROM THE ROADSIDE PULL BOX, THROUGH THE LOOP DUCT, BACK TO THE ROADSIDE PULL BOX, AND BE INSTALLED IN ONE, NON-SPliced, CONTINUOUS LENGTH.


PROTECTION OF THE CONDUIT, CONDULET AND PULL BOX SHALL BE REQUIRED AFTER INSTALLATION AND BEFORE THE NEW CONCRETE PAVEMENT IS PLACED.

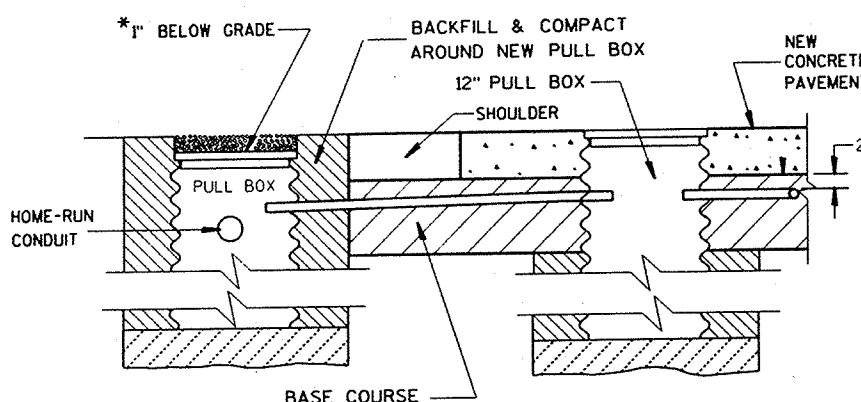

NO CURB & GUTTER  
SECTION A-A


## LOOP DETECTOR INSTALLATION DETAILS

\*RECESS PULL BOX SO THAT THE COVER IS 3" BELOW GRADE IN SHOULDER AREAS OF CRUSHED AGGREGATE. BACKFILL OVER COVER WITH THE CRUSHED AGGREGATE TO BRING THE AREA TO GRADE LEVEL.

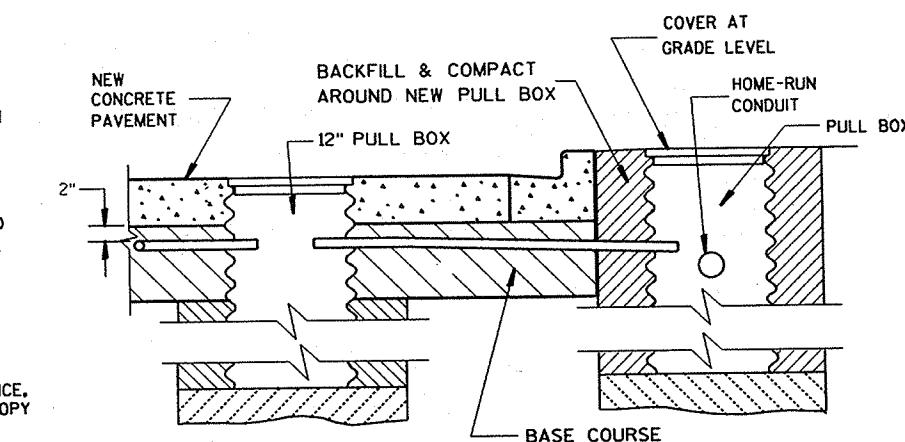


CURB & GUTTER  
SECTION B-B

## LOOP DETECTOR INSTALLATION DETAILS

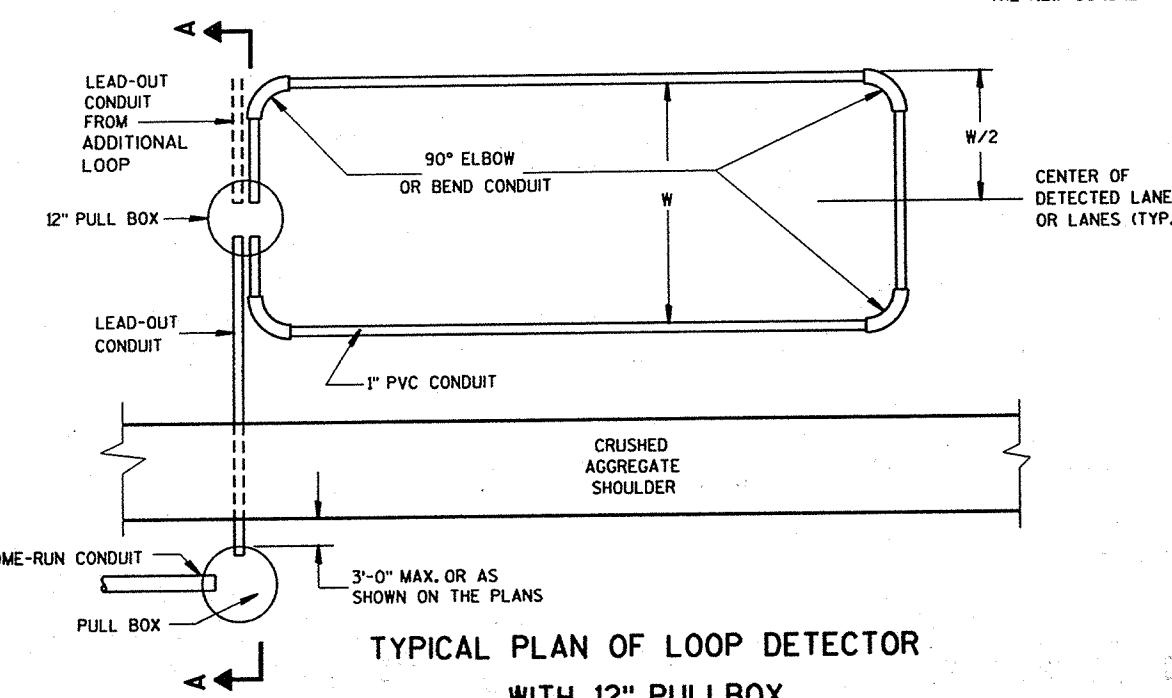

TYPICAL PLAN OF LOOP DETECTOR  
WITH 12" PULLBOX

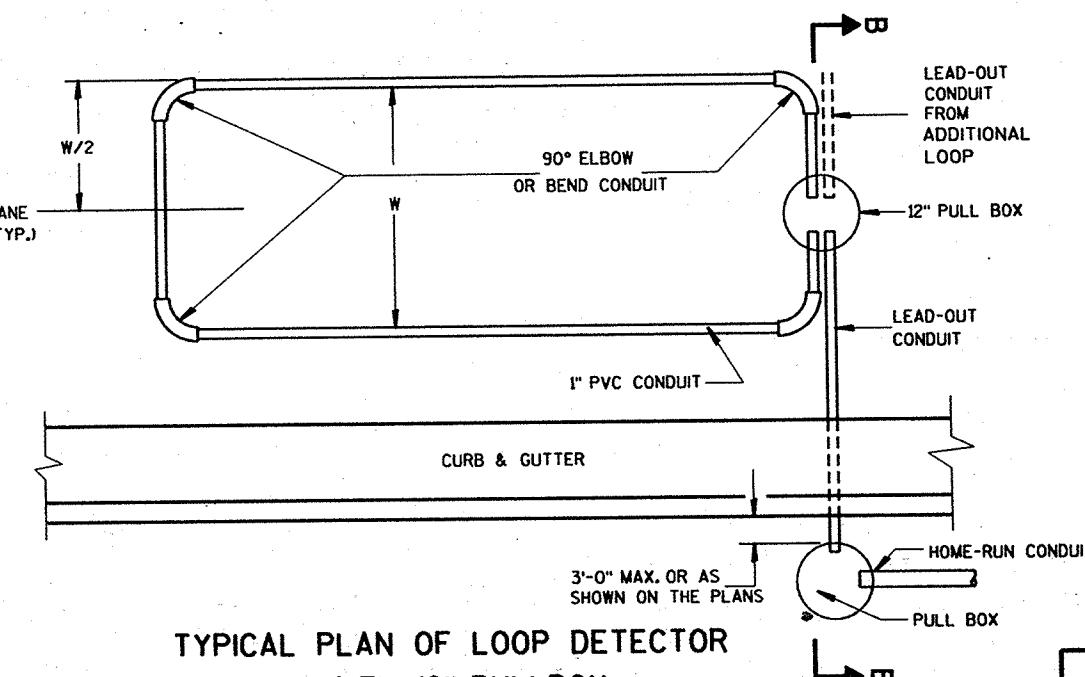

TYPICAL PLAN OF LOOP DETECTOR  
WITH 12" PULLBOX

LOOP DETECTOR PLACED IN CRUSHED AGGREGATE BASE (NEW CONCRETE PAVEMENT)
--

STATE OF WISCONSIN  
DEPARTMENT OF TRANSPORTATION

APPROVED

4/21/93

DATE

STATE ELECTRICAL ENGR FOR HWYS


4/21/93

DATE


STATE TRAFFIC ENGINEER FOR HWYS

FHWA


S.D.D. 9 F 9-1

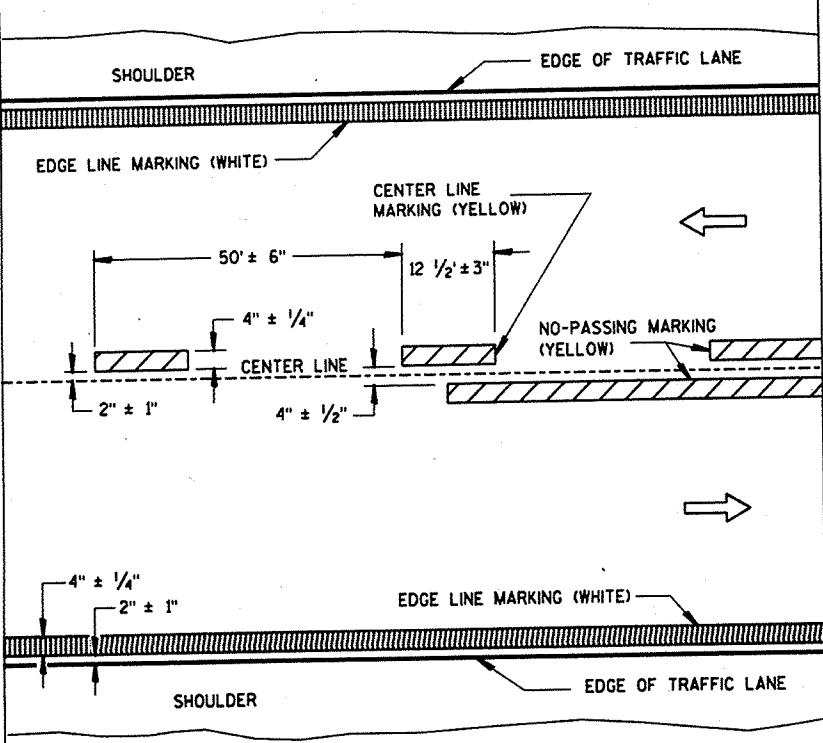

TWO WAY TRAFFIC

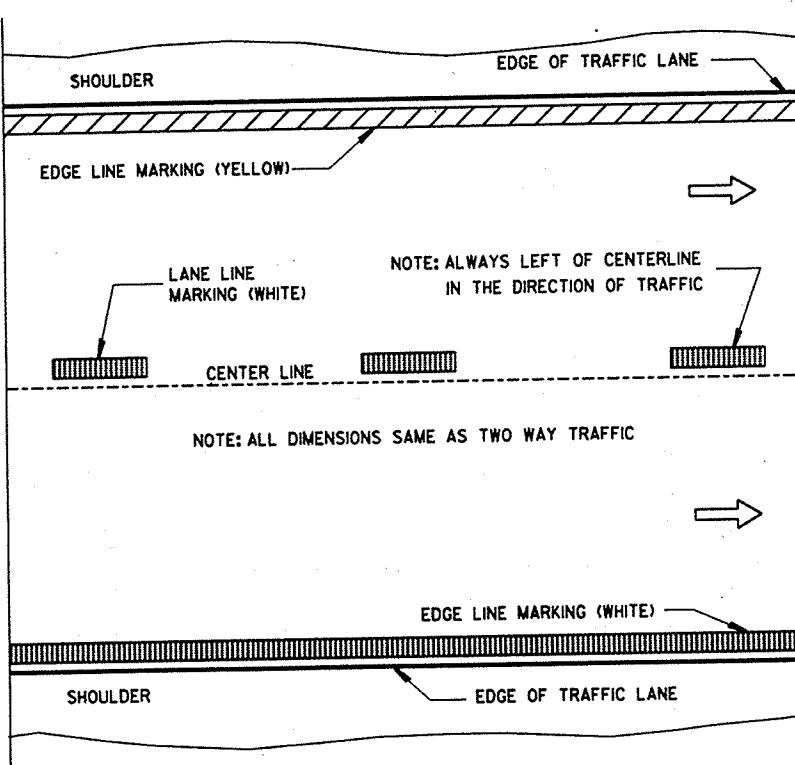

ONE WAY TRAFFIC

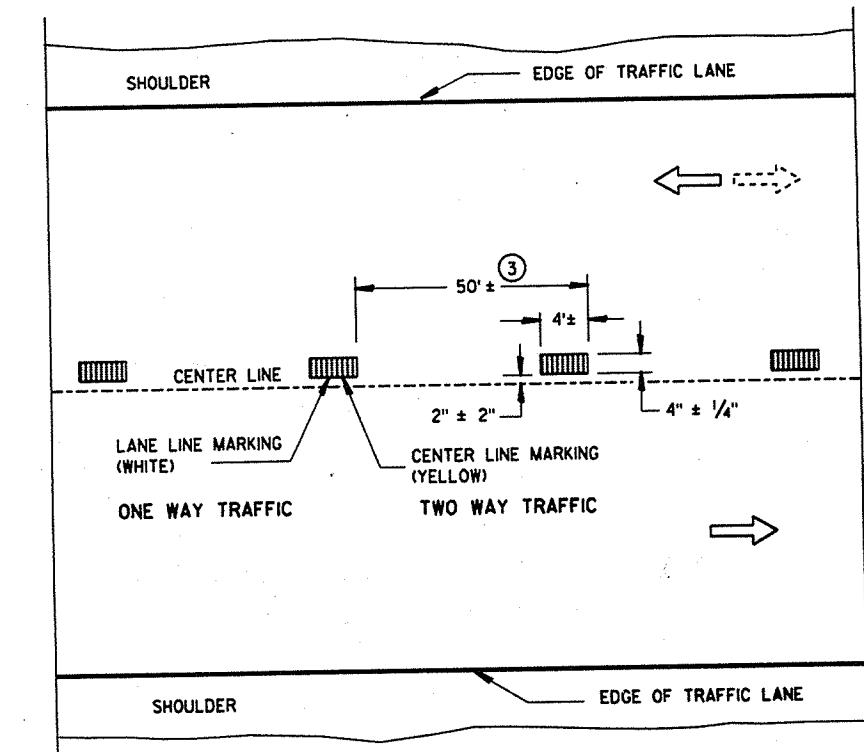


TEMPORARY PAVEMENT MARKING

(SHOWS CYCLE FOR TEMPORARY CENTER LINE MARKING)

### PERMANENT PAVEMENT MARKING

(SHOWS CYCLE FOR PERMANENT CENTER LINE MARKING)

NOTE:  
ARROW SYMBOL (→)  
SHOWS DIRECTION OF TRAVEL

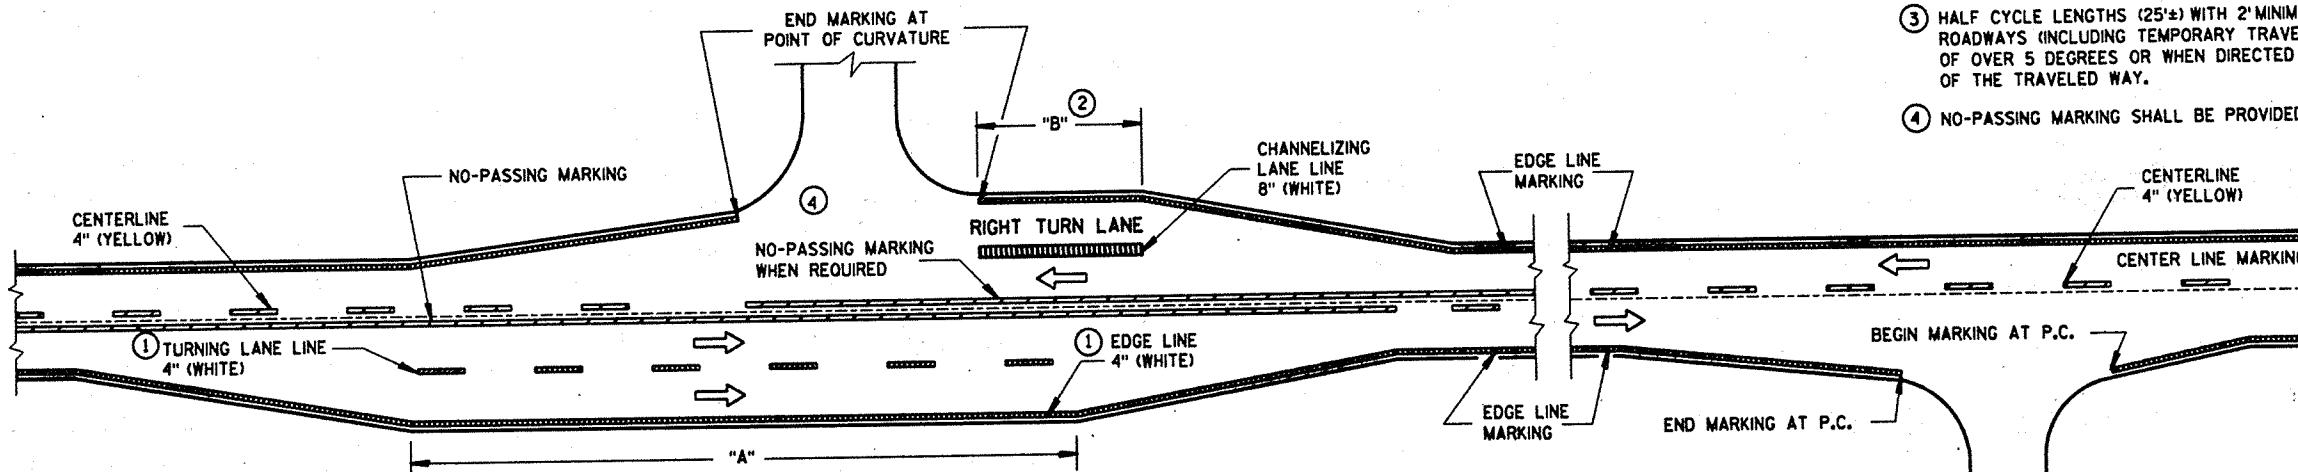

MAJOR INTERSECTION

TYPICAL PAVEMENT MARKING FOR RURAL INTERSECTIONS

### GENERAL NOTES

DETAILS OF PAVEMENT MARKING NOT SHOWN ON THIS DRAWING SHALL CONFORM TO THE STANDARD SPECIFICATIONS AND SPECIAL PROVISIONS.

EDGE LINES SHALL BE OMITTED THROUGH INTERSECTIONS. EDGE LINES SHALL BE CONTINUED THROUGH DRIVEWAYS.

- ① WHEN DISTANCE "A" IS LESS THAN 250 FEET, OMIT TURNING LANE MARKING.
- ② WHEN DISTANCE "B" IS LESS THAN 100 FEET, OMIT CHANNELIZING LANE LINE.
- ③ HALF CYCLE LENGTHS (25' ±) WITH 2' MINIMUM STRIPE LENGTHS SHALL BE PROVIDED ON ROADWAYS (INCLUDING TEMPORARY TRAVELED WAYS) WITH REVERSE CURVATURE, CURVATURE OF OVER 5 DEGREES OR WHEN DIRECTED BY THE ENGINEER TO MARK UNUSUAL ALIGNMENT OF THE TRAVELED WAY.
- ④ NO-PASSING MARKING SHALL BE PROVIDED WHERE SIGHT DISTANCE IS DEFICIENT.

NOTE:  
THIS DRAWING CONSISTS OF UP TO FOUR SHEETS. SHEET 5a MAY BE USED ALONE OR SUPPLEMENTED BY SHEET 5b, SHEET 5c AND/OR SHEET 5d AS APPLICABLE

PAVEMENT MARKING  
(MAINLINE & INTERSECTIONS)

STATE OF WISCONSIN  
DEPARTMENT OF TRANSPORTATION

APPROVED  
7/20/93  
DATE  
STATE TRAFFIC ENGINEER FOR HWYS  
FHWA

S.D.D. 15 C 8-5a

