

B-44-120 D

BRANCH OF EMBARRASS

C-44

Sheet No. 8 Cross Sections

TOTAL SHEETS = 18



STATE OF WISCONSIN
DEPARTMENT OF TRANSPORTATION

PLAN OF PROPOSED IMPROVEMENT


T.H. 76 - NORTH COUNTY LINE ROAD

BRANCH OF EMBARRASS RIVER BRIDGE AND APPROACHES

C.T.H. "D"

OUTAGAMIE COUNTY

STATE PROJECT NUMBER
6528-4-71

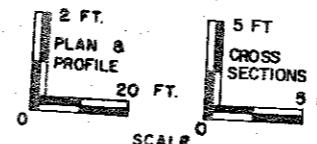

AS BUILT PLAN

NO.

SUPERVISOR
RESIDENT
CONTRACTOR
COMPLETED

AGRI Rozite
DON NEMETZ
OTTERFER Bls.
11-14-89

APPROVED
FOR
OUTAGAMIE COUNTY
44-97
DATE
COUNTY HIGHWAY COMMISSIONER
John H. McDonald



PLAN PREPARED
BY
AYRES ASSOCIATES
CONSULTING ENGINEERS
GREEN BAY, WISCONSIN

STATE OF WISCONSIN
DEPARTMENT OF TRANSPORTATION
Surveyor AYRES ASSOC. District Checker
Designer AYRES ASSOC. C.O. Checker
District Supervisor J.E.P. C.O. Coordinator
APPROVED
DATE: 11/14/89 TRCD
DISTRICT TRANSPORTATION DIRECTOR
John H. McDonald


APPROVED
DATE: 11/14/89 *James C. Smith*
STATE DESIGN ENGINEER FOR HBS.

DESIGNATION

AS.T. 1988 • 620
AS.T. 6888 • 710
D.V. 6888 • 80
• 60/40
• 18
• 60

BEGIN PROJECT
STA. 19+50.00
X = 2,326,100 ($\pm 100'$)
Y = 278,630 ($\pm 100'$)


END PROJECT
STA. 20+50.00

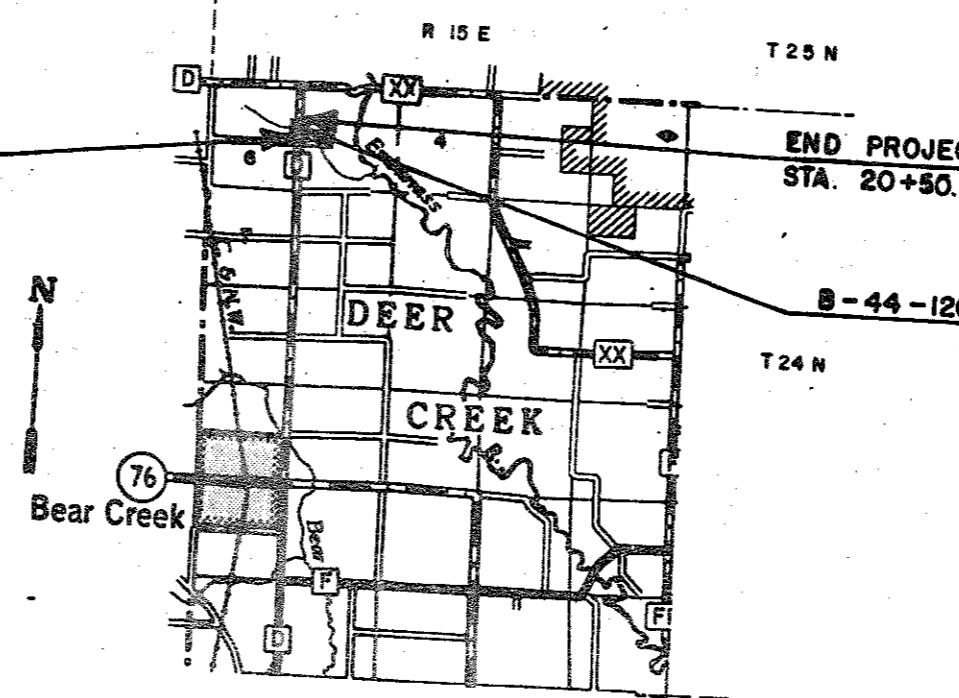

CONVENTIONAL SIGNS

PROPERTY LINE
LOT LINE
LIMITED HIGHWAY EASEMENT
EXTENDING RIGHT OF WAY
RIGHT OF WAY
POWER LINE
PIPELINE
PIPELINE INTERCEPT
POWER GROUND
WATER OR ROCK PROFILE
RIGHT OF PLACE
RIGHT OF WAY
REQUIRED (Profile)

COMBUSTIBLE FLUIDS
(UNDER PRESSURE)
UNDERGROUND UTILITIES
GAS
ELECTRIC
TELEPHONE
SERVICE PEDESTAL
CABLE MARKER
POWER POLE
TELEPHONE POLE
RAILROADS
MARSH
WOODED AREA

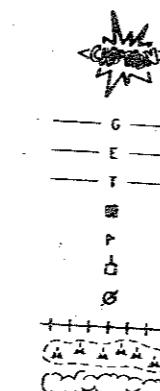


LAYOUT
SCALE 0 1 MI.

TOTAL NET LENGTH OF CENTERLINE = 0.018 MI. (RURAL)

* - COORDINATES SCALED FROM U.S.G.S. 7.5 MINUTE
TOPOGRAPHIC MAP, BEAR CREEK, WI., CENTRAL
ZONE, FOR IDENTIFICATION ONLY.

U.S. DEPARTMENT OF TRANSPORTATION
FEDERAL HIGHWAY ADMINISTRATION
PROJ. NO. 6528-4-71
APPROVED

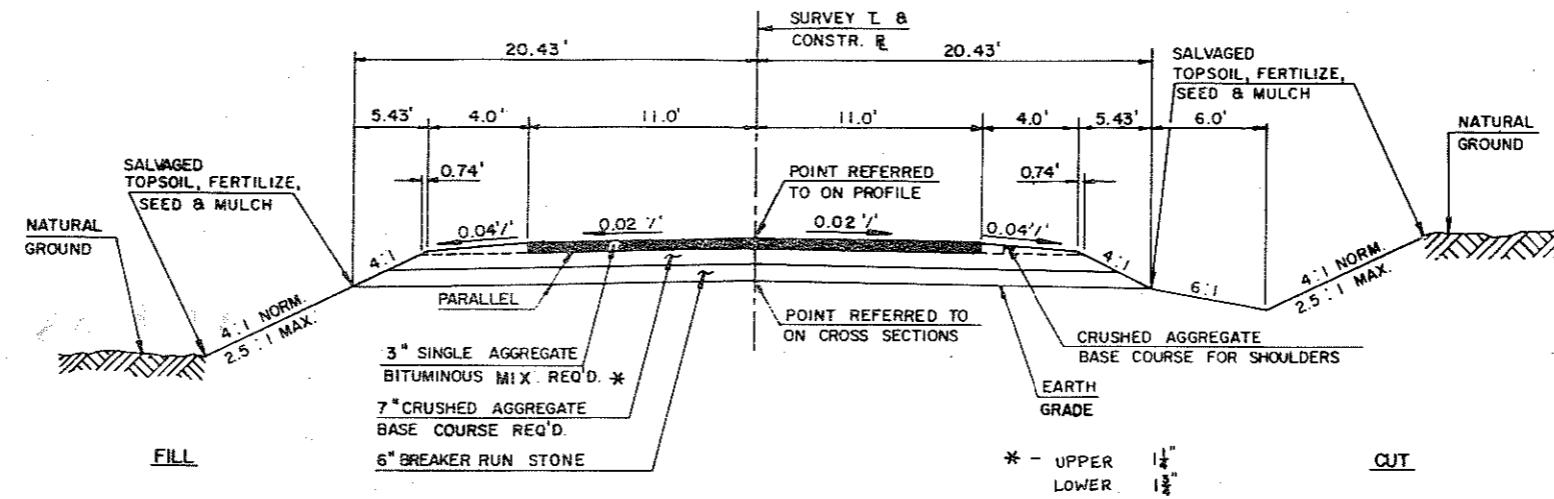

STANDARD DETAIL DRAWINGS

SILT FENCE	8E9 - 3
NAME PLATE-STRUCTURES	12A3 - 4
CLASS "A" STEEL PLATE BEAM GUARD (TWO SHEETS)	14H2 - 8 a 8 b
CONSTRUCTION BARRICADES AND STANDARD SIGNS	15C1 - 7
TRAFFIC CONTROL TO CLOSE HIGHWAY UNDER CONSTRUCTION	15C2 - 1
PAVEMENT MARKING	15C8 - 1
EROSION MAT	8E7-1

UTILITIES

WISCONSIN ELECTRIC POWER COMPANY	TELEPHONE 1-414-735-0708
APPLETON CENTER P.O. BOX 1699	
APPLETON, WISCONSIN 54913-1699	
ATTENTION: MR. N. P. SCHERF	
DIGGERS HOTLINE	TELEPHONE 1-800-242-8511 TOLL FREE
URBAN TELEPHONE COMPANY	TELEPHONE 1-715-823-5151
P.O. BOX 209	
CLINTONVILLE, WISCONSIN 54929	
ATTENTION: MR. RON BUELLOW - ASSISTANT PLANT SUPERINTENDENT	

GENERAL NOTES

THE LOCATION OF EXISTING AND PROPOSED UTILITY FACILITIES AS SHOWN ON THE PLANS ARE APPROXIMATE. THERE MAY BE OTHER UTILITY FACILITIES WITHIN THE PROJECT AREA THAT ARE NOT SHOWN.

THE UTILITIES SHALL ADJUST THEIR FACILITIES TO FIT THE NEW HIGHWAY CONSTRUCTION.

CUBIC YARDS OF FILL AS SHOWN ON THE PLAN SHEETS PERTAINS TO EMBANKMENT CONSTRUCTED FROM BORROW EXCAVATION AND UNCLASSIFIED EXCAVATION. THE VOLUME OF THE FILL WAS EXPANDED BY 43% TO DETERMINE THE AMOUNT OF MATERIAL NECESSARY TO COMPLETE THE EMBANKMENT. THE VOLUME OF FILL REPRESENTS MATERIAL REQUIRED BETWEEN THE TOP OF THE STRUCTURE AND THE BOTTOM OF THE ROADWAY.

ALL DISTANCES ARE GROUND DISTANCES.

ALL TIES ON THIS PLAN ARE HORIZONTAL.

PROPERTY LINES AS SHOWN ARE APPROXIMATE.

BEARINGS ON THIS PLAN ARE MAGNETIC BEARINGS.

DISTURBED AREAS WITHIN THE RIGHT OF WAY, EXCEPT THE AREAS WITHIN THE FINISHED SHOULDER POINTS, ARE TO BE FERTILIZED, SEEDED (#1) AND MULCHED, AS DIRECTED BY THE ENGINEER.

SILT FENCE SHALL MEET THE MATERIAL SPECIFICATIONS FOR SILTY SOIL.

POLYETHYLENE SHEETING SHALL BE USED FOR EROSION PROTECTION IF THE CONTRACTOR CONSTRUCTS A BY-PASS CHANNEL DURING THE CONSTRUCTION OF THE STRUCTURE.

THE EXACT LOCATION AND LIMITS OF THE SILT FENCE SHALL BE AS DIRECTED BY THE ENGINEER.

THE WISCONSIN DEPARTMENT OF TRANSPORTATION WILL FURNISH A MONUMENT TO BE SET BY THE CONTRACTOR AS DESIGNATED BY THE ENGINEER.

SAW CUTTING SHALL BE CONSIDERED INCIDENTAL.

SILT FENCE

LOCATION	QUANTITY (LIN. FT.)
NORTHEAST QUADRANT	30
NORTHWEST QUADRANT	30
SOUTHEAST QUADRANT	30
SOUTHWEST QUADRANT	30

STEEL PLATE BEAM GUARD

LOCATION	QUANTITY (LIN. FT.)	ANCHORAGES
EAST SIDE	158	2
WEST SIDE	158	2

EROSION MAT

LOCATION	S.Y.
DISCHARGE END OF CULVERT	15

DATE 01/27/89


ESTIMATE OF QUANTITIES

ITEM	ITEM DESCRIPTION	UNIT	TOTAL	QUANTITY
20353	REMOVING OLD BRIDGE, STATION 26+00	L.S.	1.00	1.00
20503	UNCLASSIFIED EXCAVATION	C.Y.	96.00	96.00
20622	EXCAVATION FOR STRUCTURES CULVERTS B-44-120	L.S.	1.00	1.00
20801	BORROW EXCAVATION	C.Y.	28.00	28.00
21303	FINISHING ROADWAY, PROJECT 6528-3-71	L.S.	1.00	1.00
30404	CRUSHED AGGREGATE BASE COURSE	TON	163.00	163.00
50401	CONCRETE MASONRY, CULVERTS	C.Y.	138.00	138.00
50505	HIGH-STRENGTH BAR STEEL REINFORCEMENT, CULVERTS	LB.	18,470.00	18,470.00
61406	ANCHORAGES FOR STEEL PLATE BEAM GUARD	EACH	4.00	4.00
61408	STEEL PLATE BEAM GUARD, CLASS A	L.F.	316.00	316.00
61910	MOBILIZATION	L.S.	.40	.40
62505	SALVAGED TOPSOIL	S.Y.	500.00	500.00
62702	MULCHING	S.Y.	500.00	500.00
62905	FERTILIZER, TYPE B	CWT.	.50	.50
63002	SEEDING	LB.	10.00	10.00
64204	FIELD OFFICE, TYPE A, PROJECT 6528-3-71	L.S.	1.00	1.00
64303	TRAFFIC CONTROL PROJECT 6528-3-71	L.S.	1.00	1.00
64402	PAVEMENT MARKING, COLD PAINT	L.F.	25.00	25.00
90359	BREAKER RUN STONE	TON	143.00	143.00
90379	SINGLE AGGREGATE BITUMINOUS MIX	TON	43.00	43.00
90644	EROSION MAT, DELIVERED	S.Y.	15.00	15.00
90645	EROSION MAT, INSTALLED	S.Y.	15.00	15.00
90646	SILT FENCE, DELIVERED	L.F.	120.00	120.00
90647	SILT FENCE, INSTALLED	L.F.	120.00	120.00
90648	SILT FENCE MAINTENANCE	L.F.	240.00	240.00
90651	POLYETHYLENE SHEETING, DELIVERED	S.Y.	150.00	150.00
90652	POLYETHYLENE SHEETING, INSTALLED	S.Y.	150.00	150.00

SHEET 3

STATE OF WISCONSIN
OUTAGAMIE COUNTY HIGHWAY DEPARTMENT
PLAT OF RIGHT OF WAY REQUIRED FOR
C.T.H. "D"

REVISION DATE	R/W PROJECT NUMBER 6528-4-00	SHEET NUMBER 40
	FEDERAL PROJECT NUMBER	
PLAT OF RIGHT OF WAY REQUIRED FOR C.T.H. "D" OUTAGAMIE COUNTY		
	SCALE 100 200FT.	DATE
CONSTRUCTION PROJECT NUMBER 6528-4-71 4		

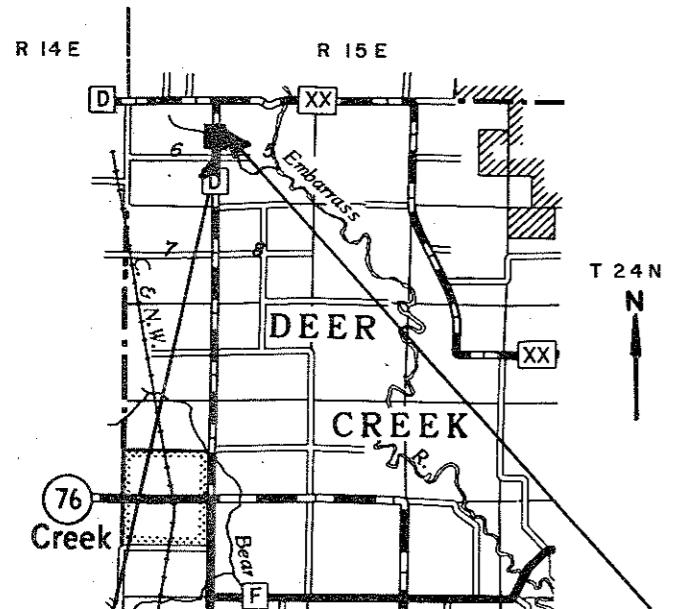

PARCEL NUMBER	OWNERSHIP	INTEREST REQUIRED	TOTAL ACRES OR SQUARE FEET	R/W ACRES OR SQUARE FEET			TOTAL ACRES REMAINING	L.H.E. ACRES (TEMP.)
				NEW	EXISTING	TOTAL		
1	NORMAN & LUCILLE PIETZ	FEES TITLE	79.75	0.04	0.15	0.19	79.56	—
2	RANDAL T. & CAROL A. ERICKSON	FEES TITLE	95.61	0.04	0.15	0.19	95.42	—
3								

SCHEDULE OF LANDS AND INTERESTS REQUIRED

NOTE:

ALL BEARINGS SHOWN ON THIS PLAT ARE MAGNETIC BEARINGS OF EACH TANGENT.

ALL COORDINATES SHOWN ON THIS PLAT ARE SCALED FROM THE U.S.G.S. TOPOGRAPHIC MAPS, 7.5 MINUTE QUADRANGLE, BEAR CREEK, WISCONSIN, CENTRAL ZONE, FOR IDENTIFICATION ONLY.

AREAS SHOWN IN THE TOTAL REMAINING ACRES COLUMN MAY BE APPROXIMATE AND ARE DERIVED FROM TAX ROLLS OR OTHER AVAILABLE SOURCES AND MAY NOT INCLUDE LANDS WHICH ARE NOT CONTIGUOUS TO THE AREA TO BE ACQUIRED.

END RELOCATION ORDER

STA. 21 + 00.00
LOCATED 1,925.46 FEET SOUTH AND
38.30 FEET WEST OF THE NORTH -
EAST CORNER OF SECTION 6,
TOWNSHIP 24 NORTH, RANGE 15 EAST.

Layout
SCALE 0 1 2 MILES

TOTAL LENGTH OF RELOCATION ORDER = 0.038 MILES

BEGIN RELOCATION ORDER


STA. 19 + 00.00
X = 2,326,100 (\pm 100')
Y = 276,540 (\pm 100')
LOCATED 1,134.94 FEET NORTH AND 23.30 FEET
EAST OF THE WEST ONE-QUARTER CORNER OF
SECTION 5, TOWNSHIP 24 NORTH, RANGE 15 EAST.

TOWN

N

NE - NE
6 - 24 - 15

GERALD L. AND ANN M. HOFFMANN

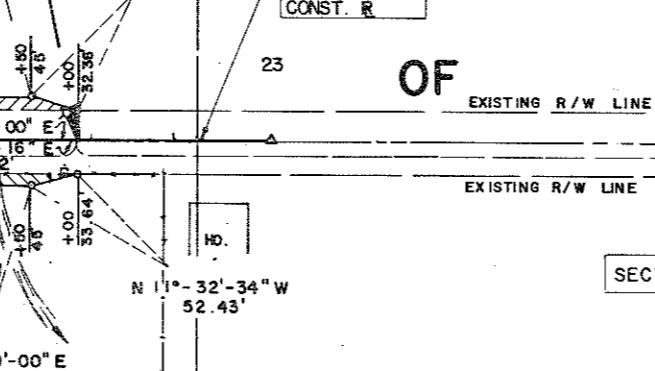

C.T.H. "D"

EXISTING R/W LINE
SECTION LINE

N 01° 07' 16" E 1925.81'



RANDAL T. AND CAROL A. ERICKSON

DEER CREEK


NW - NW
5 - 24 - 15

APPROVED
FOR
OUTAGAMIE COUNTY
1-1-87 *Malvina Erickson*
DATE
COUNTY HIGHWAY COMMISSIONER


PLAT PREPARED
BY
AYRES ASSOCIATES
CONSULTING ENGINEERS
GREEN BAY, WISCONSIN

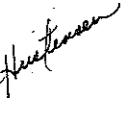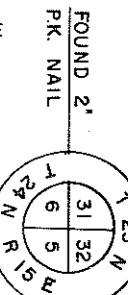

FOUND 5/8" REBAR

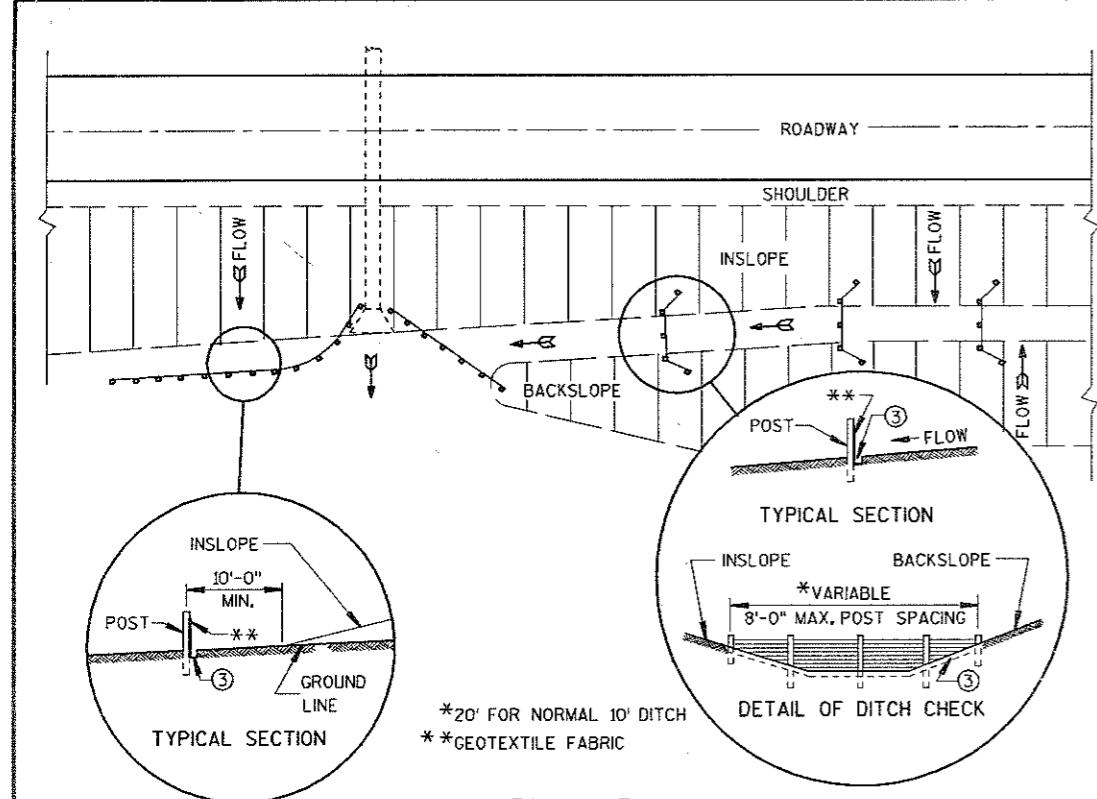

TYPICAL APPLICATIONS OF SILT FENCE

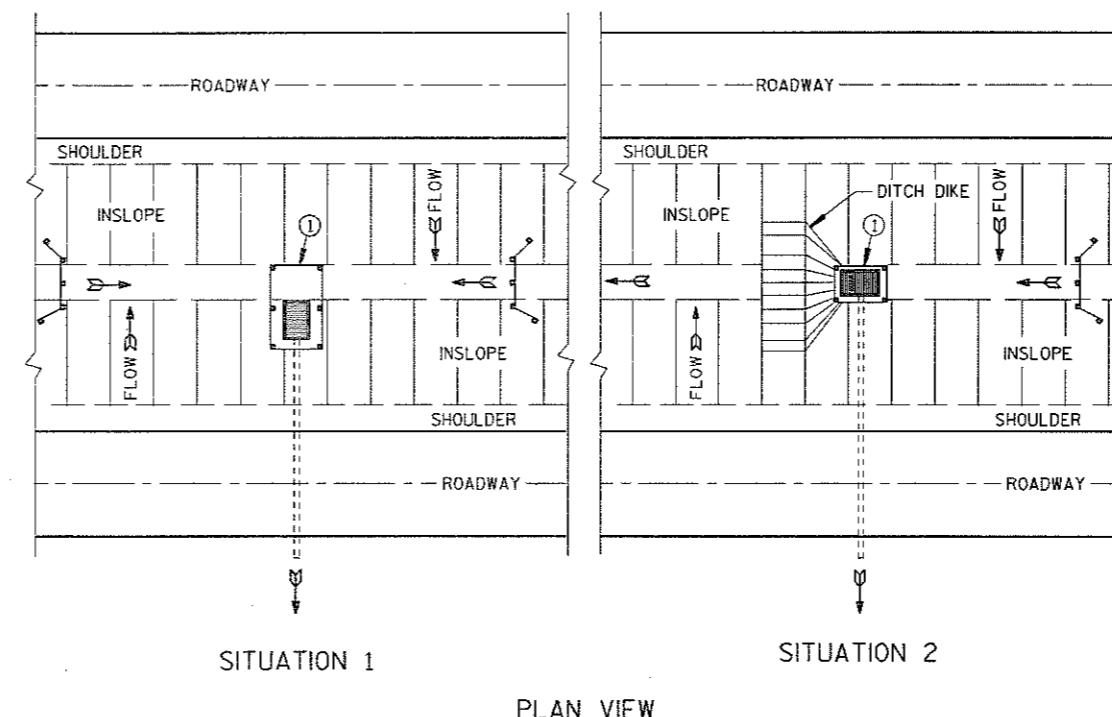

GENERAL NOTES



DETAIL OF CONSTRUCTION NOT SHOWN ON THIS DRAWING SHALL CONFORM TO THE PERTINENT REQUIREMENTS OF THE STANDARD SPECIFICATIONS AND APPLICABLE SPECIAL PROVISIONS.

WHEN POSSIBLE THE SILT FENCE SHOULD BE CONSTRUCTED IN AN ARC OR HORSESHOE SHAPE, WITH THE ENDS POINTING UPSLOPE TO MAXIMIZE BOTH STRENGTH AND EFFECTIVENESS.


- ① CROSS BRACE WITH 2" X 4" WOODEN FRAME OR EQUIVALENT AT TOP OF POSTS AS DIRECTED BY THE ENGINEER.
- ② MINIMUM 14 GAGE WIRE REQUIRED, FOLD FABRIC 3" OVER THE WIRE AND STAPLE OR PLACE WIRE RINGS ON 12" C-C.
- ③ EXCAVATE A TRENCH A MINIMUM OF 4" WIDE & 6" DEEP TO BURY AND ANCHOR THE GEOTEXTILE FABRIC. FOLD MATERIAL TO FIT TRENCH AND BACKFILL & COMPACT TRENCH WITH EXCAVATED SOIL.
- ④ WIRE SUPPORT FENCE SHALL BE 14 GAGE MINIMUM WOVEN WIRE WITH A MAXIMUM MESH SPACING OF 6". SECURE TOP OF GEOTEXTILE FABRIC TO TOP OF FENCE WITH STAPLES OR WIRE RINGS AT 12" C-C.
- ⑤ GEOTEXTILE FABRIC SHALL BE REINFORCED WITH AN INDUSTRIAL POLYPROPYLENE NETTING WITH A MAXIMUM MESH SPACING OF $\frac{3}{4}$ " OR EQUAL. A HEAVY DUTY NYLON TOP SUPPORT CORD OR EQUIVALENT IS REQUIRED.
- ⑥ STEEL POSTS SHALL BE STUDDED "TEE" OR "U" TYPE WITH A MINIMUM WEIGHT OF 128 LBS/LINEAL FOOT (WITHOUT ANCHOR). FIN ANCHORS SUFFICIENT TO RESIST POST MOVEMENT ARE REQUIRED. WOOD POSTS SHALL BE A MINIMUM SIZE OF 4" DIA. OR 1 $\frac{1}{2}$ " X 3 $\frac{1}{2}$ " EXCEPT WOOD POSTS FOR GEOTEXTILE FABRIC REINFORCED WITH NETTING SHALL BE A MINIMUM SIZE OF 1 $\frac{1}{2}$ " X 1 $\frac{1}{2}$ " OAK OR HICKORY.

ALTERNATES A & B ARE EQUAL AND EITHER MAY BE USED

SILT FENCE AT MEDIAN SURFACE DRAINS

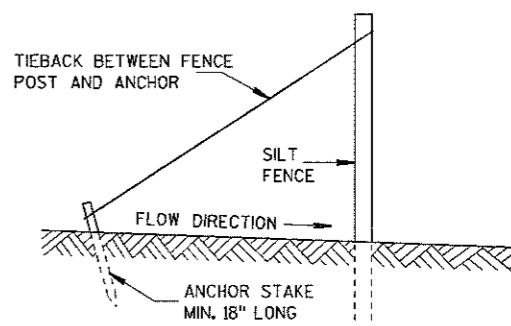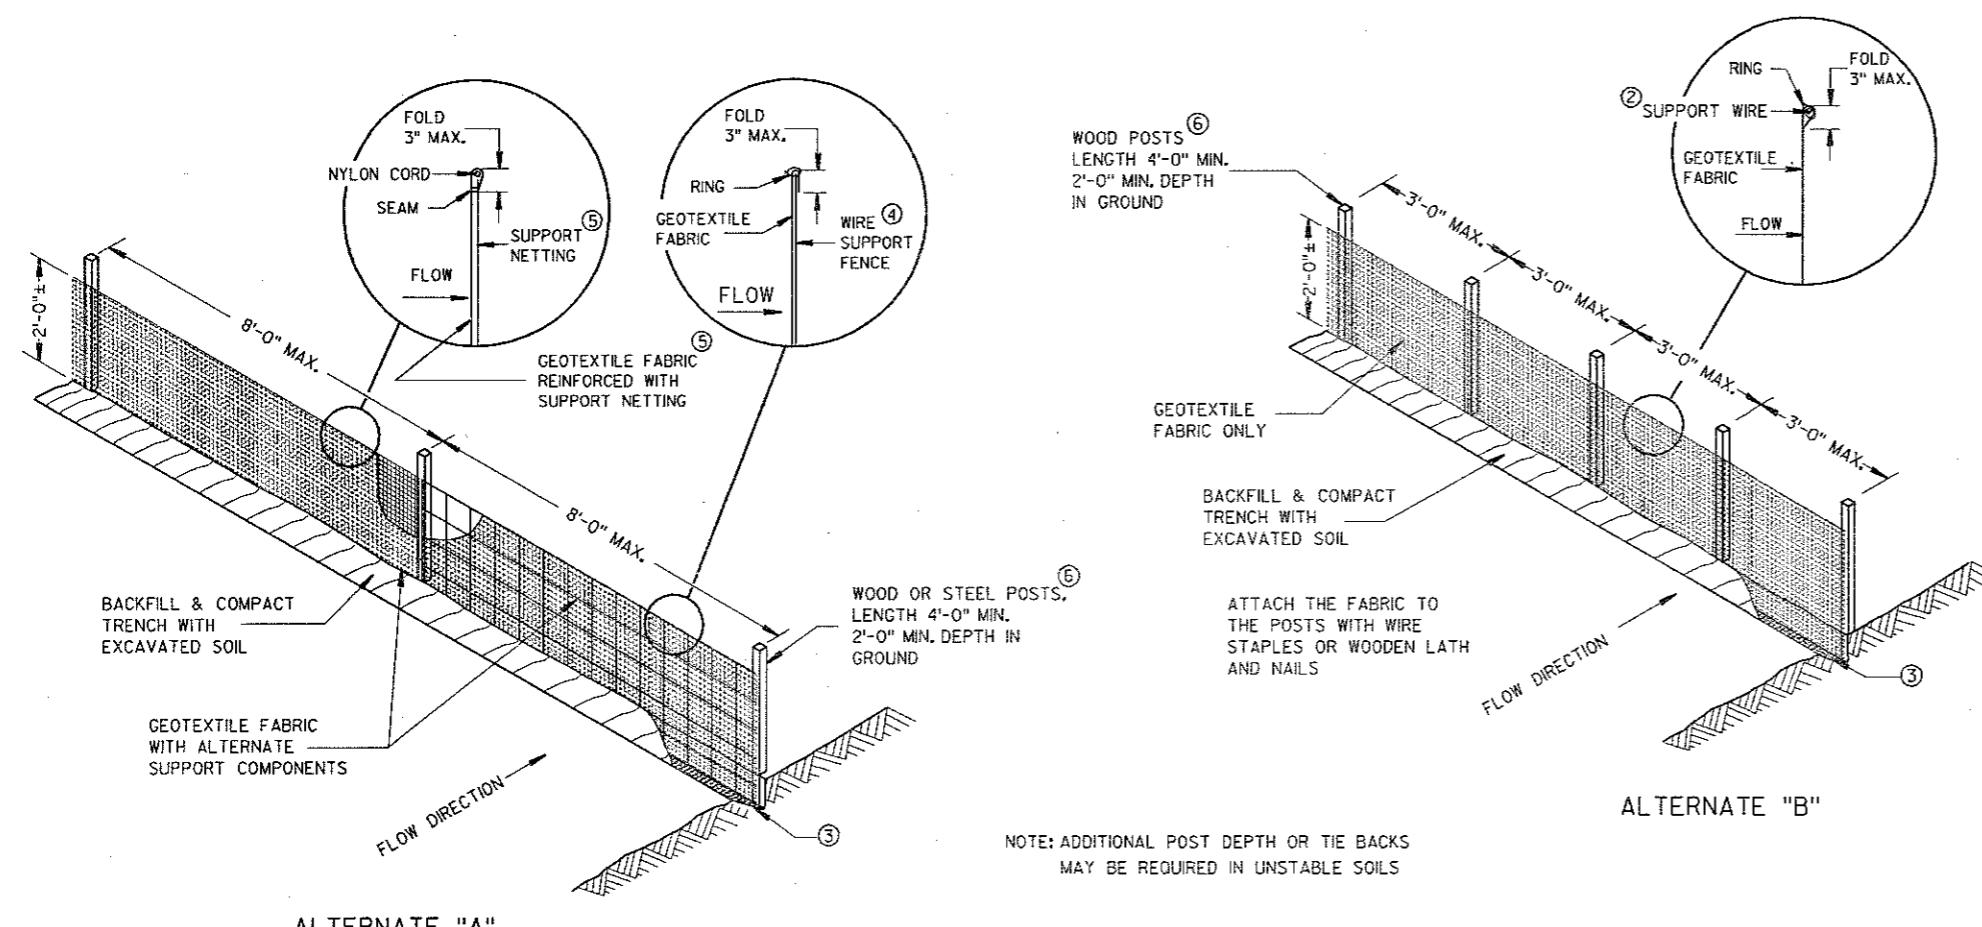


SILT FENCE TIE BACK
(WHEN REQUIRED BY THE ENGINEER)

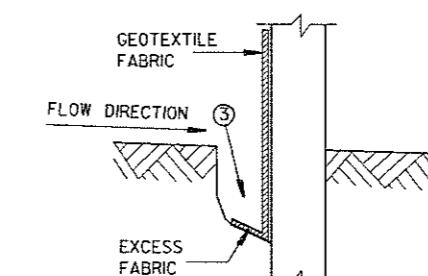


TRENCH DETAIL

SILT FENCE

STATE OF WISCONSIN
DEPARTMENT OF TRANSPORTATION

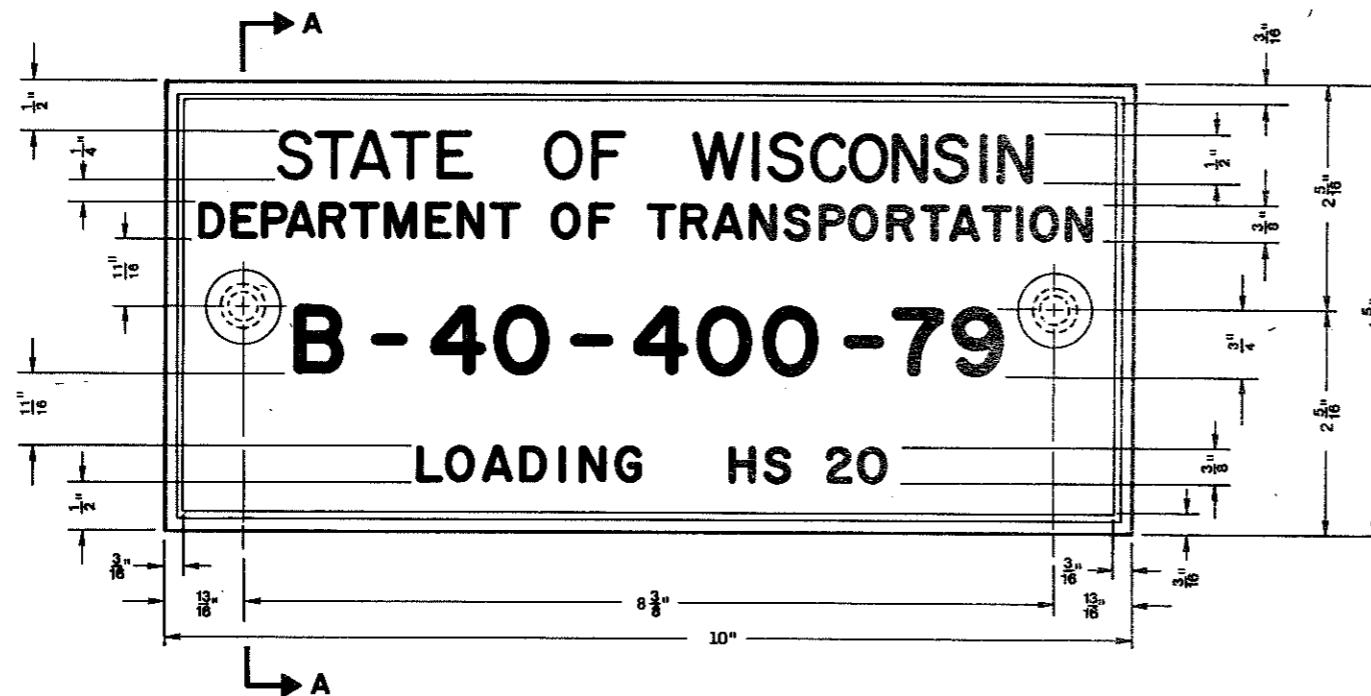


TYPICAL NAME PLATE
(BRIDGES, CULVERTS, AND RETAINING WALLS)

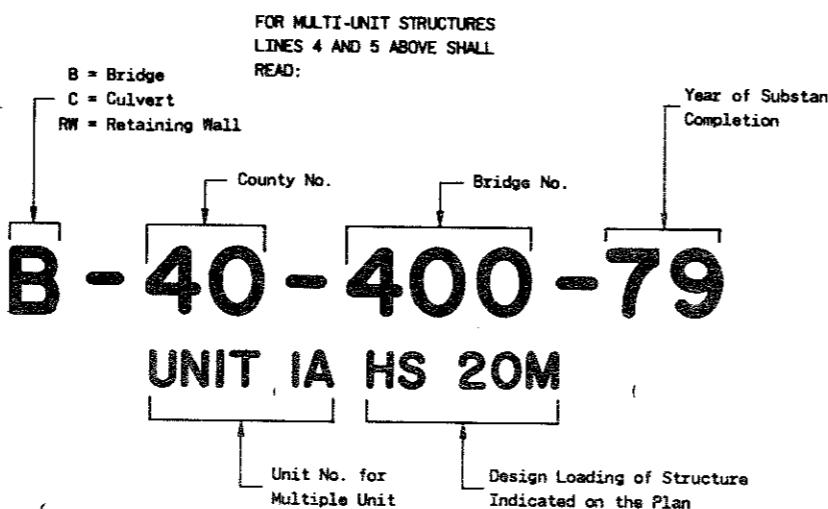


NUMBERING AND LOADING DESIGNATION

MULTI-UNIT STRUCTURES

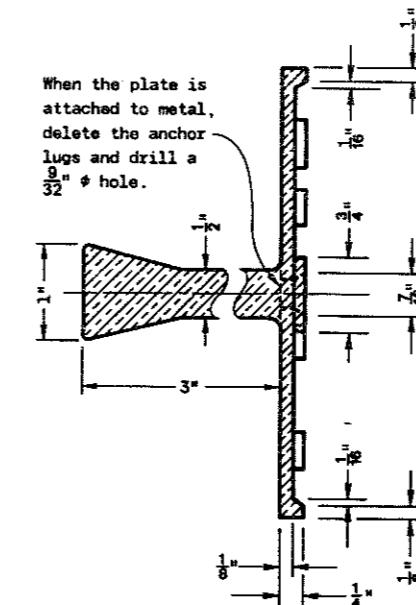

SECTION A-A

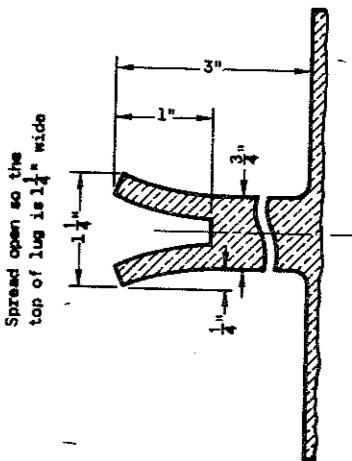

ALTERNATE LUG

GENERAL NOTES


Name Plates to be installed on Bridges, Culverts, and Retaining Walls shall conform to the requirements of Section 506.2.4 of the Standard Specifications.

The Bridge Number and Design Loading shown on this drawing are examples only. See Construction Plans for individual numbering and design loading.


**NAME PLATE
(STRUCTURES)**

State of Wisconsin
Department of Transportation
Division of Transportation Facilities

APPROVED
9-27-79 *D. J. Thomas*
DATE
CHIEF DESIGN ENGINEER


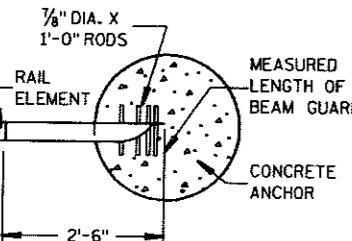


PLAN VIEW IN SECTION

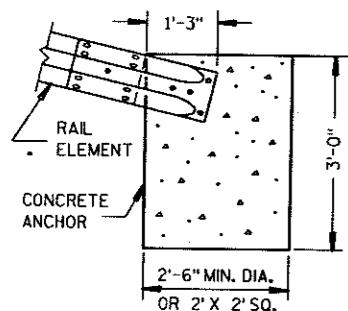

FRONT VIEW IN SECTION STANDARD ANCHORAGE DETAIL


(STANDARD SPECIFICATION ITEM "ANCHORAGE
FOR STEEL PLATE BEAM GUARD")

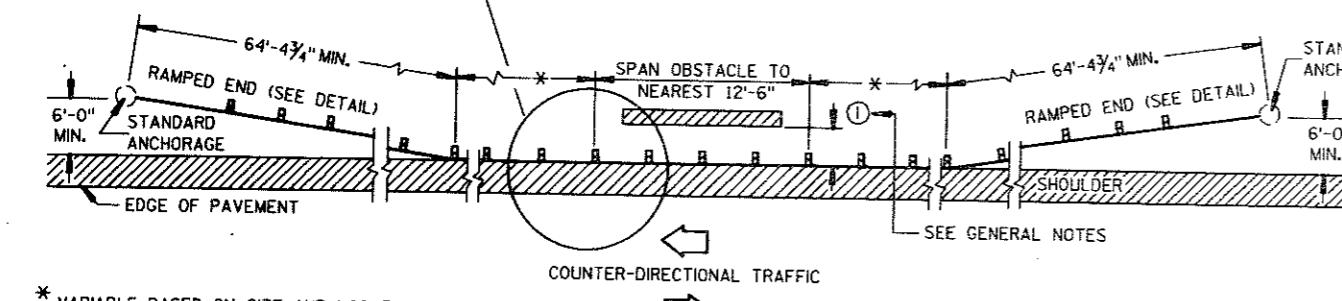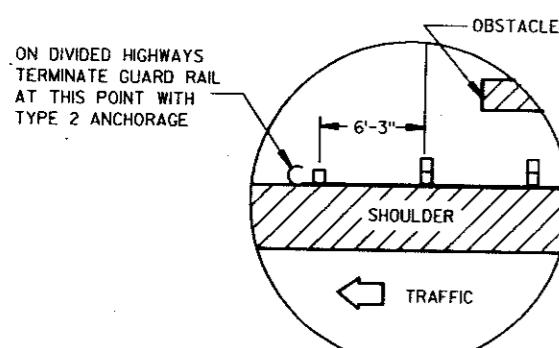


* VARIABLE BASED ON SIZE AND LOCATION OF OBSTACLE

PLAN VIEW

TYPICAL INSTALLATION AT OBSTACLES


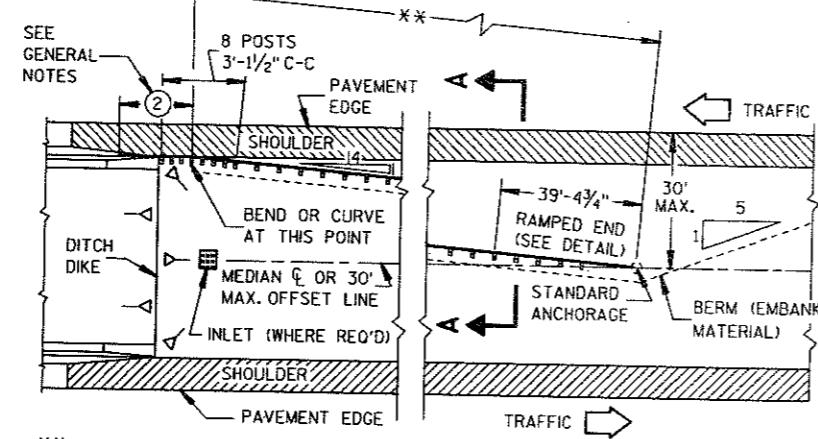


PLAN VIEW

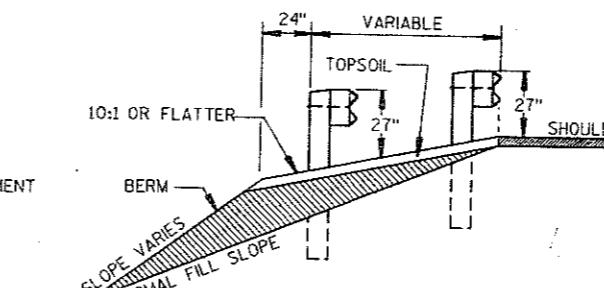


SECTION A-A

TYPICAL MEDIAN INSTALLATION AT STRUCTURES

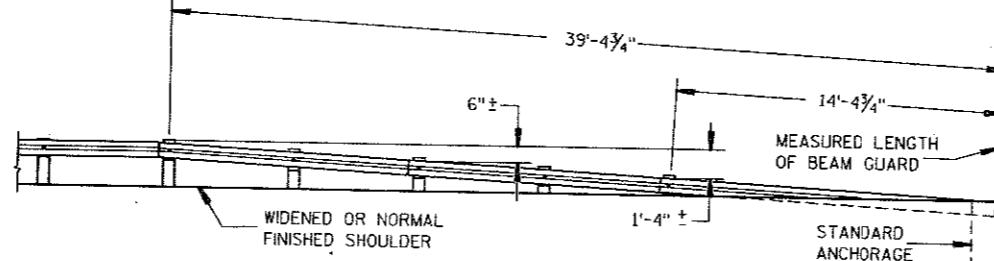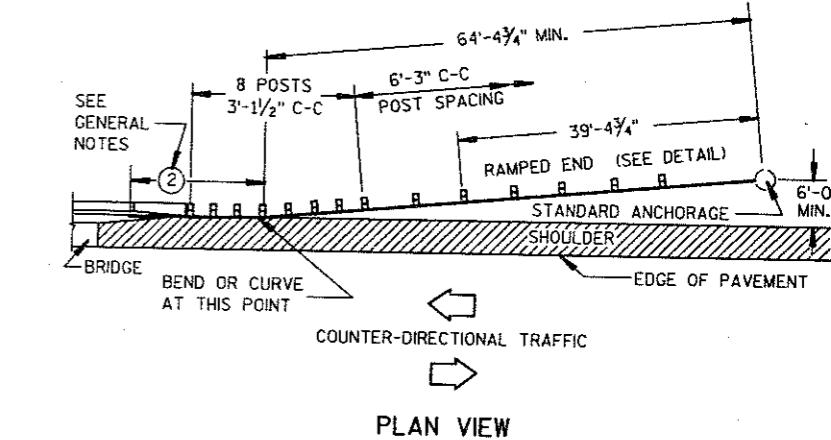FRONT VIEW
TYPICAL RAMPED END

PLAN VIEW

TYPICAL INSTALLATION AT FULL WIDTH STRUCTURES

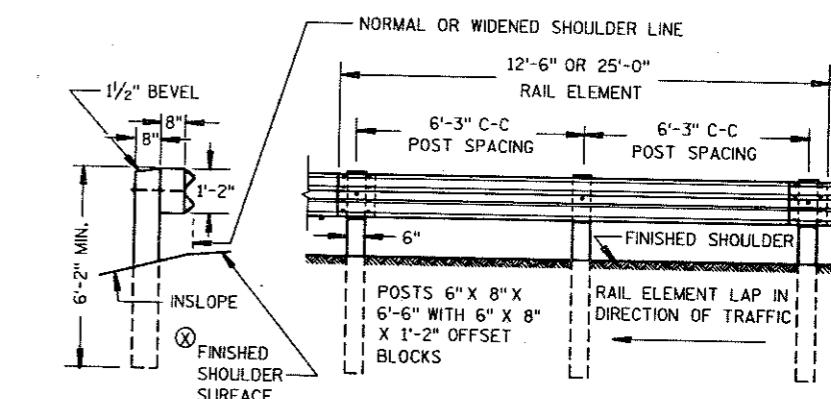


END VIEW

FRONT VIEW


TYPICAL STEEL PLATE BEAM GUARD INSTALLATION

⑧ SHOULDER OR EMBANKMENT SLOPE IN FRONT OF BEAM GUARD SHALL BE 10:1 OR FLATTER

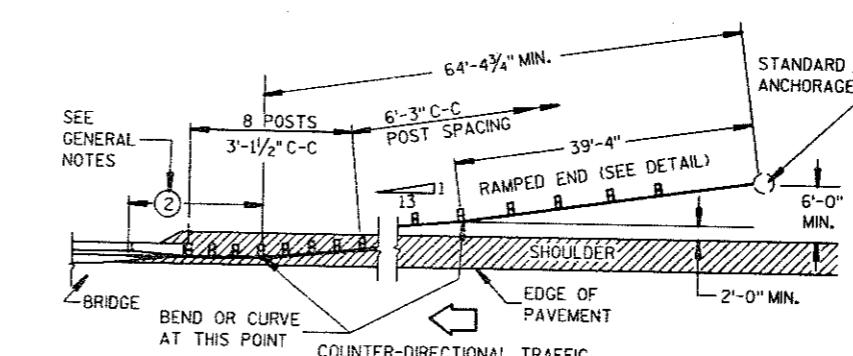

PLAN VIEW

END SECTION (ROUNDED)

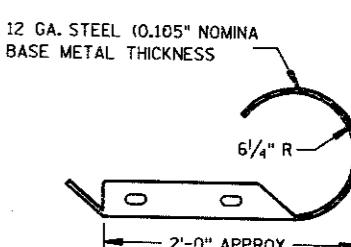

PLAN VIEW

TYPICAL INSTALLATION AT NARROW STRUCTURES


CLASS "A"
STEEL PLATE BEAM GUARD

STATE OF WISCONSIN
DEPARTMENT OF TRANSPORTATION


TABLE OF BARRICADE CHARACTERISTICS

BARRICADE TYPE	I	II	III
Height	3' Minimum	5' Minimum	
* Rail Width	8" Minimum to 12" Maximum		
Rail Length	2' Minimum	4' Minimum	
** Stripe Width	6" at 45° Angle		
Stripe Colors	Reflectorized Orange & White		

* Nominal dimensions when barricade is constructed of lumber.
** Shall be 4" for rail lengths less than 3'.

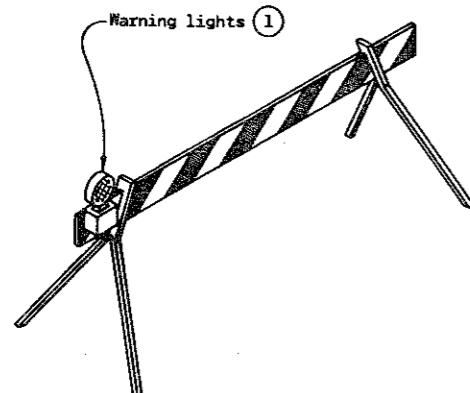

TYPICAL TYPE I BARRICADE

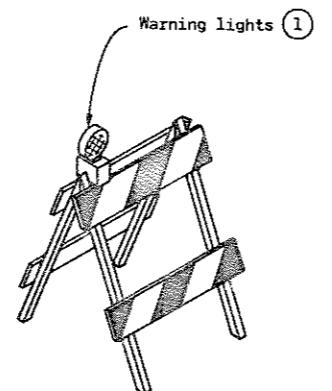

TYPICAL TYPE II BARRICADE



R11-2

48" x 30"

Black Lettering on Reflective
White Background
Letter Series "D"
Letter height 8"




W20-3

48" x 48"

Black Lettering on Reflective
Orange Background
Letter Series "D"
Letter height 7"

STANDARD SIGNS - TYPE II

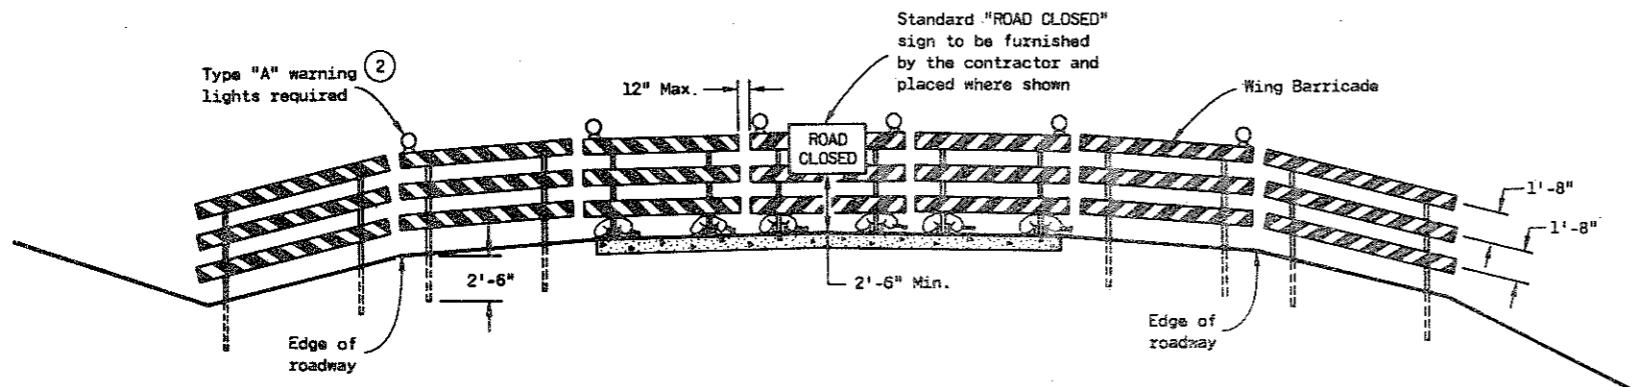

TYPICAL INSTALLATION SHOWING TYPE III BARRICADE

CONSTRUCTION BARRICADES

GENERAL NOTES

The contractor shall furnish, erect and maintain barricades and signs. Details regarding location, spacing, dimensions, fabrication, material, sign lettering, lighting devices and color of barricades and signs shall conform to this drawing, the Manual On Uniform Traffic Control Devices, the Standard Specifications, Special Provisions and/or plans.

Type III Barricades and Signs shall be erected at the termini of projects and at other road or street locations where it is necessary to control or eliminate public access to the construction area.

Type I and II Barricades shall be used on projects when traffic is to be maintained through the construction area.

The actual field location of barricade installations and advance signs shall be as directed by the Engineer.

Each barricade shall have the name and telephone number of a person responsible for 24 hour emergency service printed in letters at least $\frac{3}{4}$ inch in height on the barricade rails. Prior to May 1, 1983, such information may be shown on either front or back faces of the barricade rails. After May 1, 1983, all printed information or identification markings shall be shown only on the back side of barricade rails.

Type I Barricades may include other unstriped horizontal panels necessary to provide stability.

On high speed expressways or in other situations where barricades may be susceptible to overturning in the wind, sandbags should be used for ballasting. Sandbags may be placed on lower parts of the frame or stays to provide the required ballast but shall not be placed on top of any striped rail.

(1) Unless otherwise provided elsewhere in the contract, warning lights are required on all barricades which will be located near traffic operations during periods of inclement weather or hours of darkness. Barricades used to shield isolated hazards shall be equipped with Type "A" (low intensity - flashing) lights unless Type "B" (high intensity) - flashing lights are specified elsewhere in the contract documents. Barricades used for channelization or delineation of the travel path shall be equipped with Type "C" (steady burn) lights except for the initial barricade(s) in sequence, which shall be equipped with Type "A" or "B" lights as previously noted.


(2) Two warning lights shall be provided on the center barricade and at least one warning light shall be provided on each of the other barricades within the roadway limits. Spacing of the warning lights shall be uniform to the edge of roadway as shown.

CONSTRUCTION BARRICADES & STANDARD SIGNS

State of Wisconsin
Department of Transportation

APPROVED
9-14-81
DATE
FHWA

D. A. [Signature]
CHIEF DESIGN ENGINEER

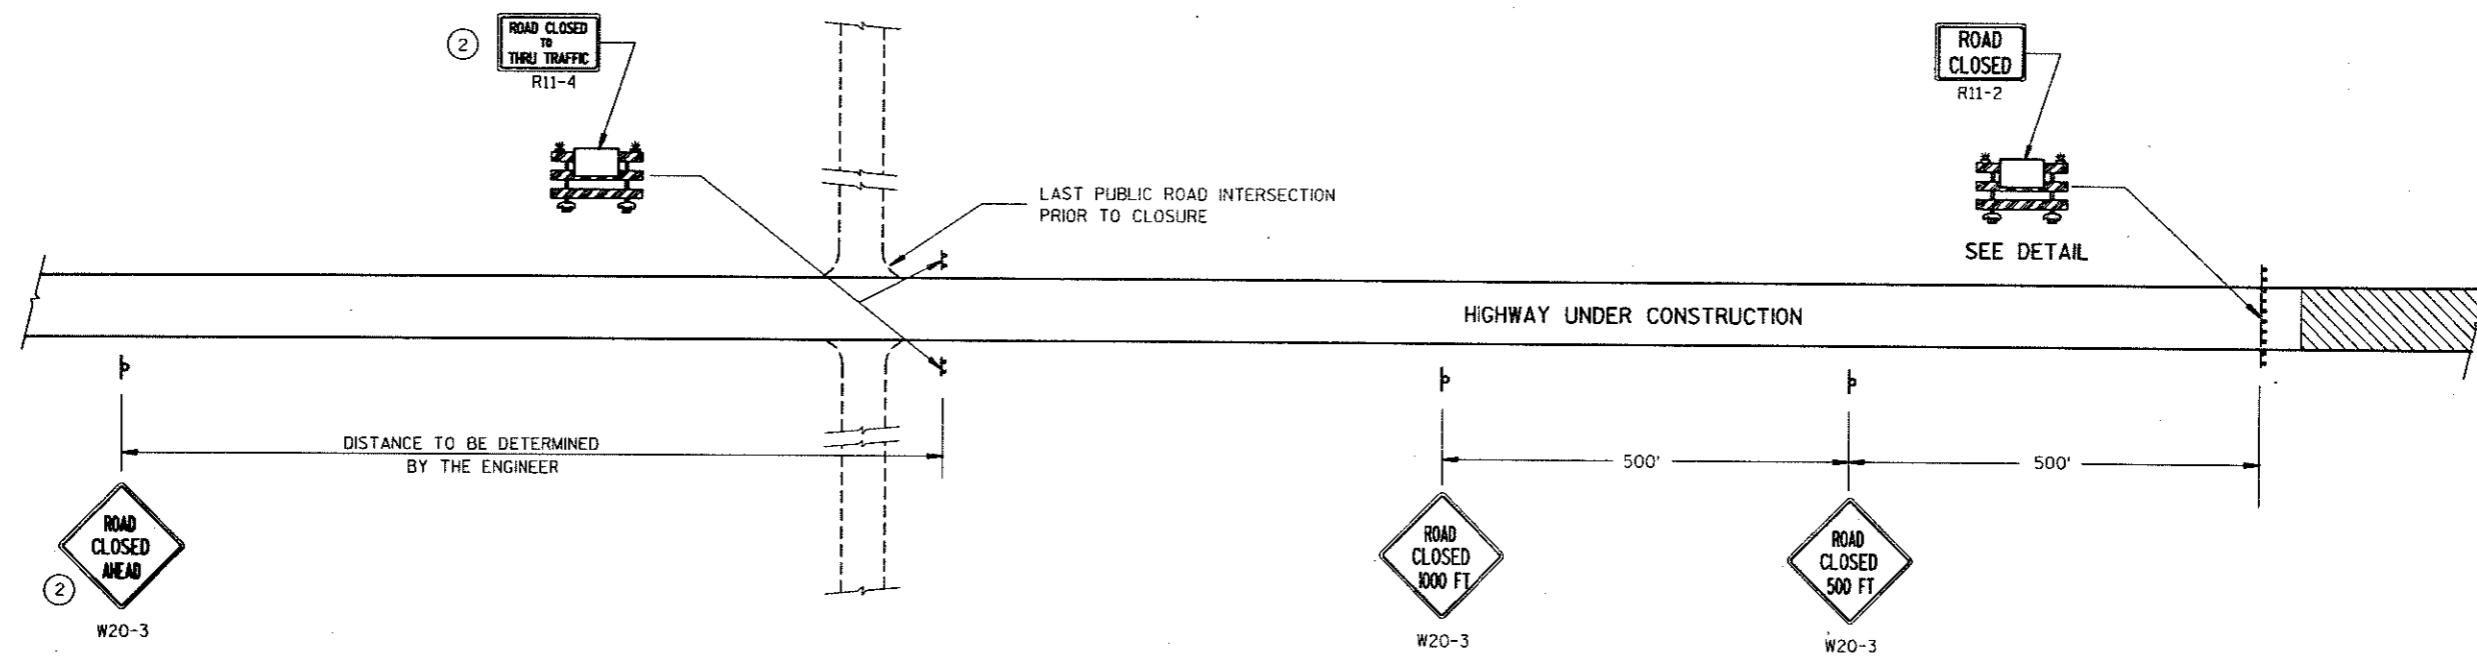

GENERAL NOTES


DETAILS OF TRAFFIC CONTROL DEVICES AND THEIR LOCATION NOT SHOWN ON THIS DRAWING SHALL CONFORM TO THE PERTINENT REQUIREMENTS OF THE MANUAL ON TRAFFIC CONTROL DEVICES, THE PLANS, SPECIFICATIONS AND CONTRACT.

SIGN AND BARRICADE LOCATIONS MAY BE ADJUSTED IN THE FIELD AS DIRECTED BY THE ENGINEER. ANY EXISTING TRAFFIC SIGNS THAT CONFLICT WITH THIS WORK SHALL BE COVERED AS DIRECTED BY THE ENGINEER.

- ① TWO WARNING LIGHTS SHALL BE PROVIDED ON THE CENTER BARRICADE AND AT LEAST ONE WARNING LIGHT SHALL BE PROVIDED ON EACH OF THE OTHER BARRICADES WITHIN THE ROADWAY LIMITS. SPACING OF THE WARNING LIGHTS SHALL BE UNIFORM TO THE EDGE OF ROADWAY AS SHOWN.
- ② THESE SIGNS ARE NOT REQUIRED IF THE INTERSECTION IS THE BEGINNING OF THE MARKED DETOUR.


LEGEND

- ▶ POST MOUNTED WARNING SIGN
- ▶ TYPE III BARRICADE (TYPE "A" LOW INTENSITY FLASHING WARNING LIGHT(S) REQUIRED FOR NIGHTTIME USE)
- ▶ TYPE "A" LOW INTENSITY FLASHING WARNING LIGHT
- ▨ WORK AREA

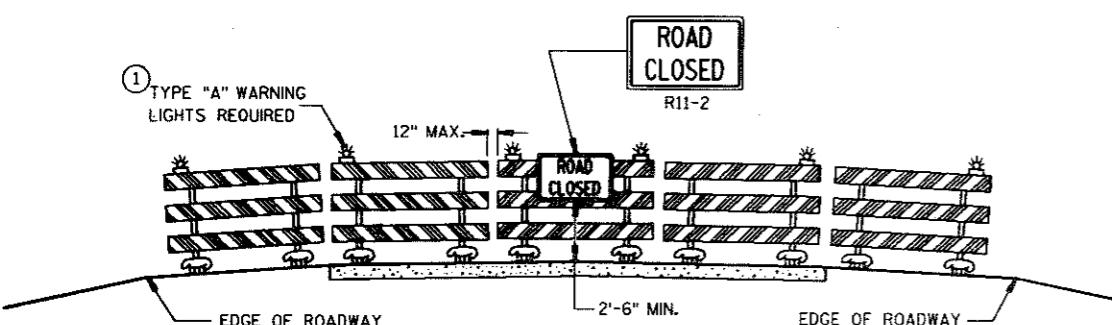


APPROACH VIEW
ROAD CLOSURE BARRICADE


TRAFFIC CONTROL TO CLOSE HIGHWAY UNDER CONSTRUCTION	
STATE OF WISCONSIN DEPARTMENT OF TRANSPORTATION	
APPROVED	<i>[Signature]</i>
6-5-85	DATE
CHIEF TRAFFIC ENGINEER	
FHWA	

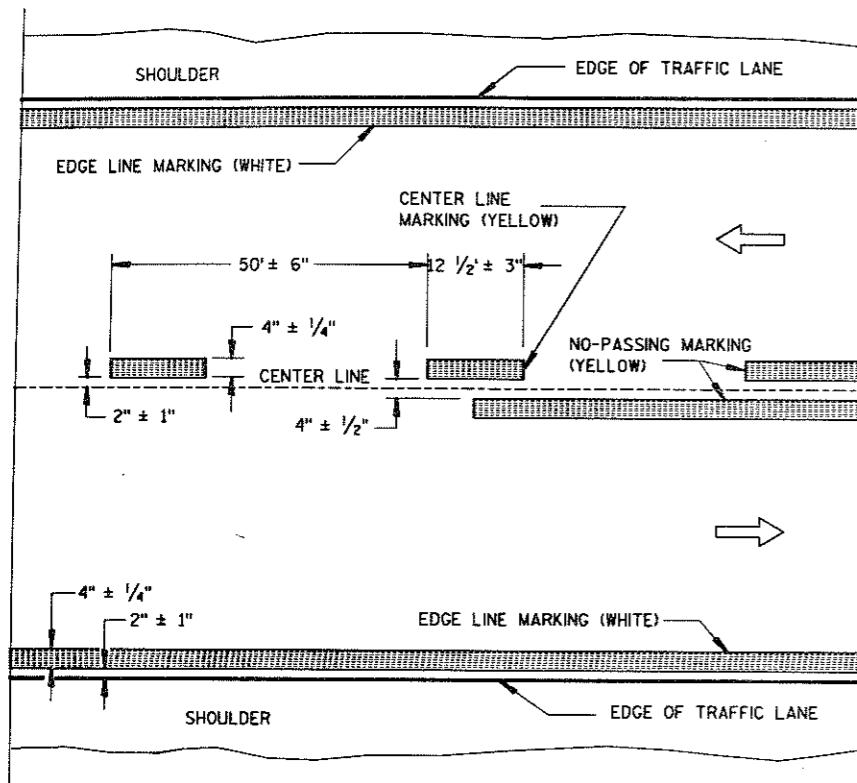

TWO WAY TRAFFIC

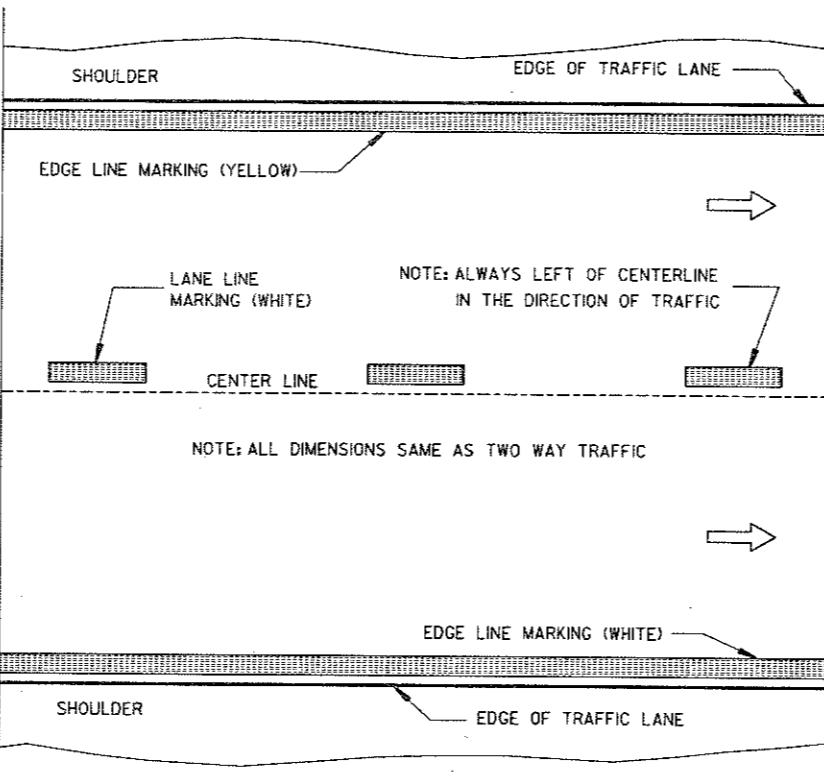

ONE WAY TRAFFIC

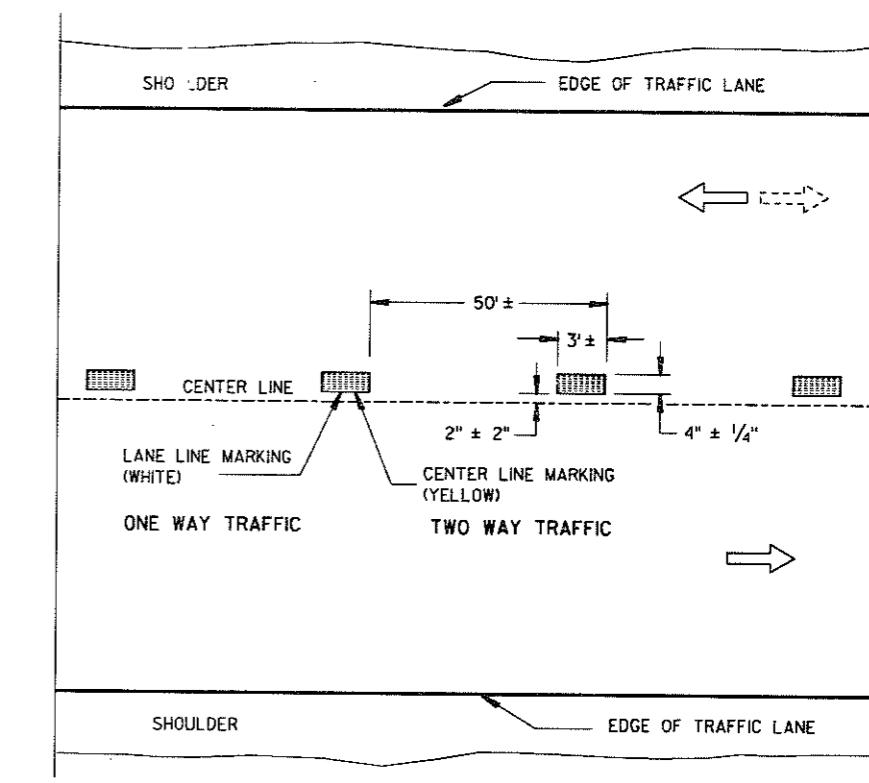

TEMPORARY PAVEMENT MARKING

PERMANENT PAVEMENT MARKING


GENERAL NOTES

DETAILS OF CONSTRUCTION NOT SHOWN ON THIS DRAWING SHALL CONFORM TO STANDARD SPECIFICATIONS AND SPECIAL PROVISIONS.

EDGE LINES SHALL BE OMITTED THROUGH INTERSECTIONS. EDGE LINES SHALL BE CONTINUED THROUGH DRIVEWAYS.

- ① WHEN DISTANCE "A" IS LESS THAN 250 * FEET, OMIT TURNING LANE MARKING AND EDGE LINE BETWEEN POINTS (a) AND (b).
- ② WHEN DISTANCE "B" IS LESS THAN 150 * FEET, OMIT CHANNELIZING LANE LINE.

*BASED ON RURAL SPEED LIMIT OF 55 MPH. REDUCE VALUES IN PROPORTION TO POSTED SPEED LIMIT. THE RIGHT TURN LANE SHOULD HAVE A DESIRABLE MINIMUM LENGTH OF 100 FEET.

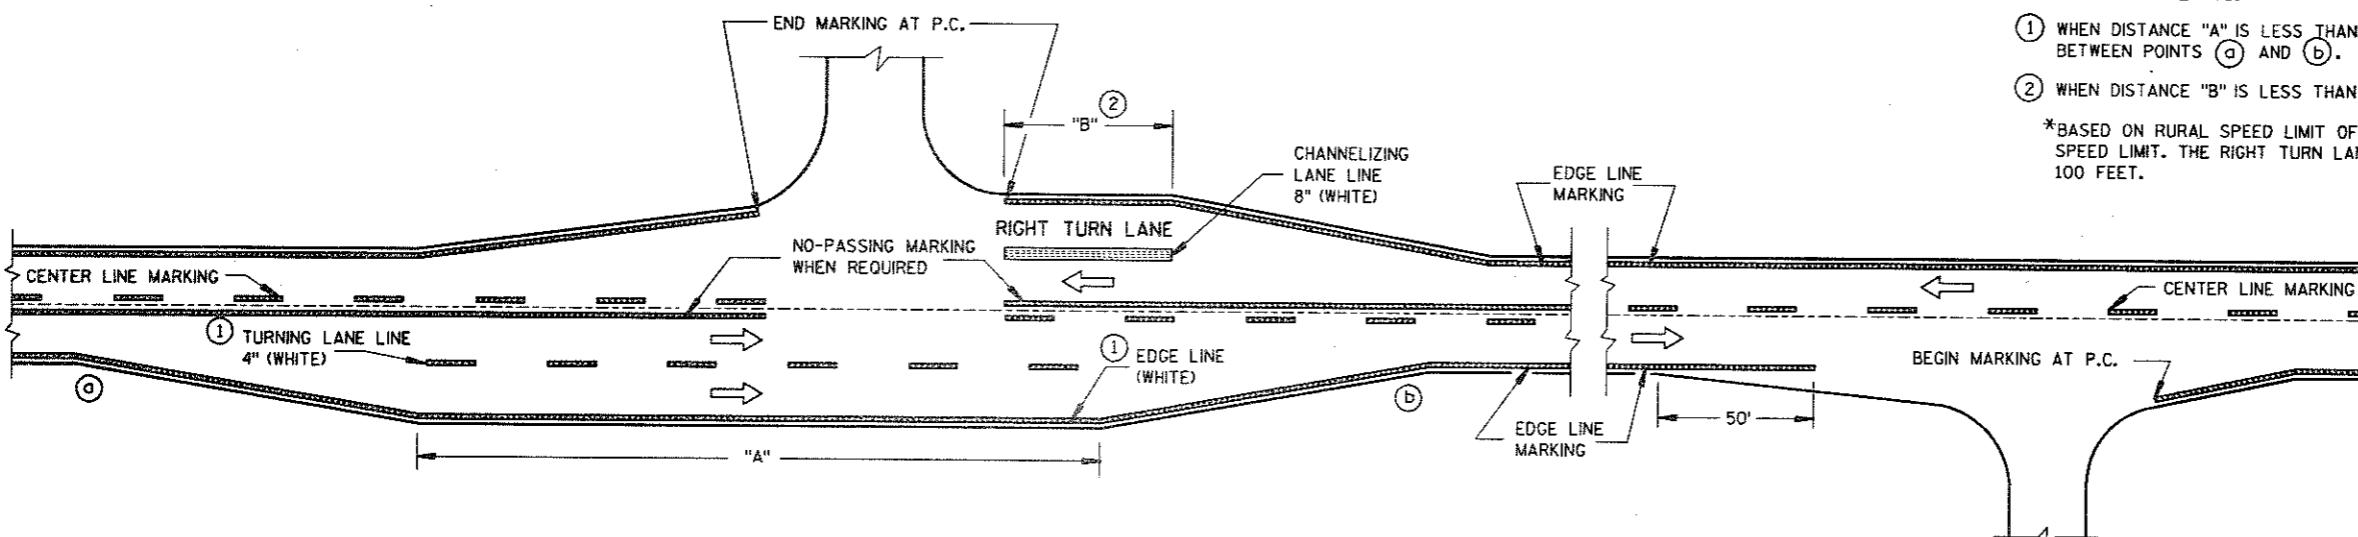


MAJOR INTERSECTION


MINOR INTERSECTION

TYPICAL PAVEMENT MARKING FOR RURAL INTERSECTIONS



PAVEMENT MARKING
STATE OF WISCONSIN
DEPARTMENT OF TRANSPORTATION

APPROVED
5-23-96
DATE
STATE TRAFFIC ENGINEER FOR HWYS
FHWA

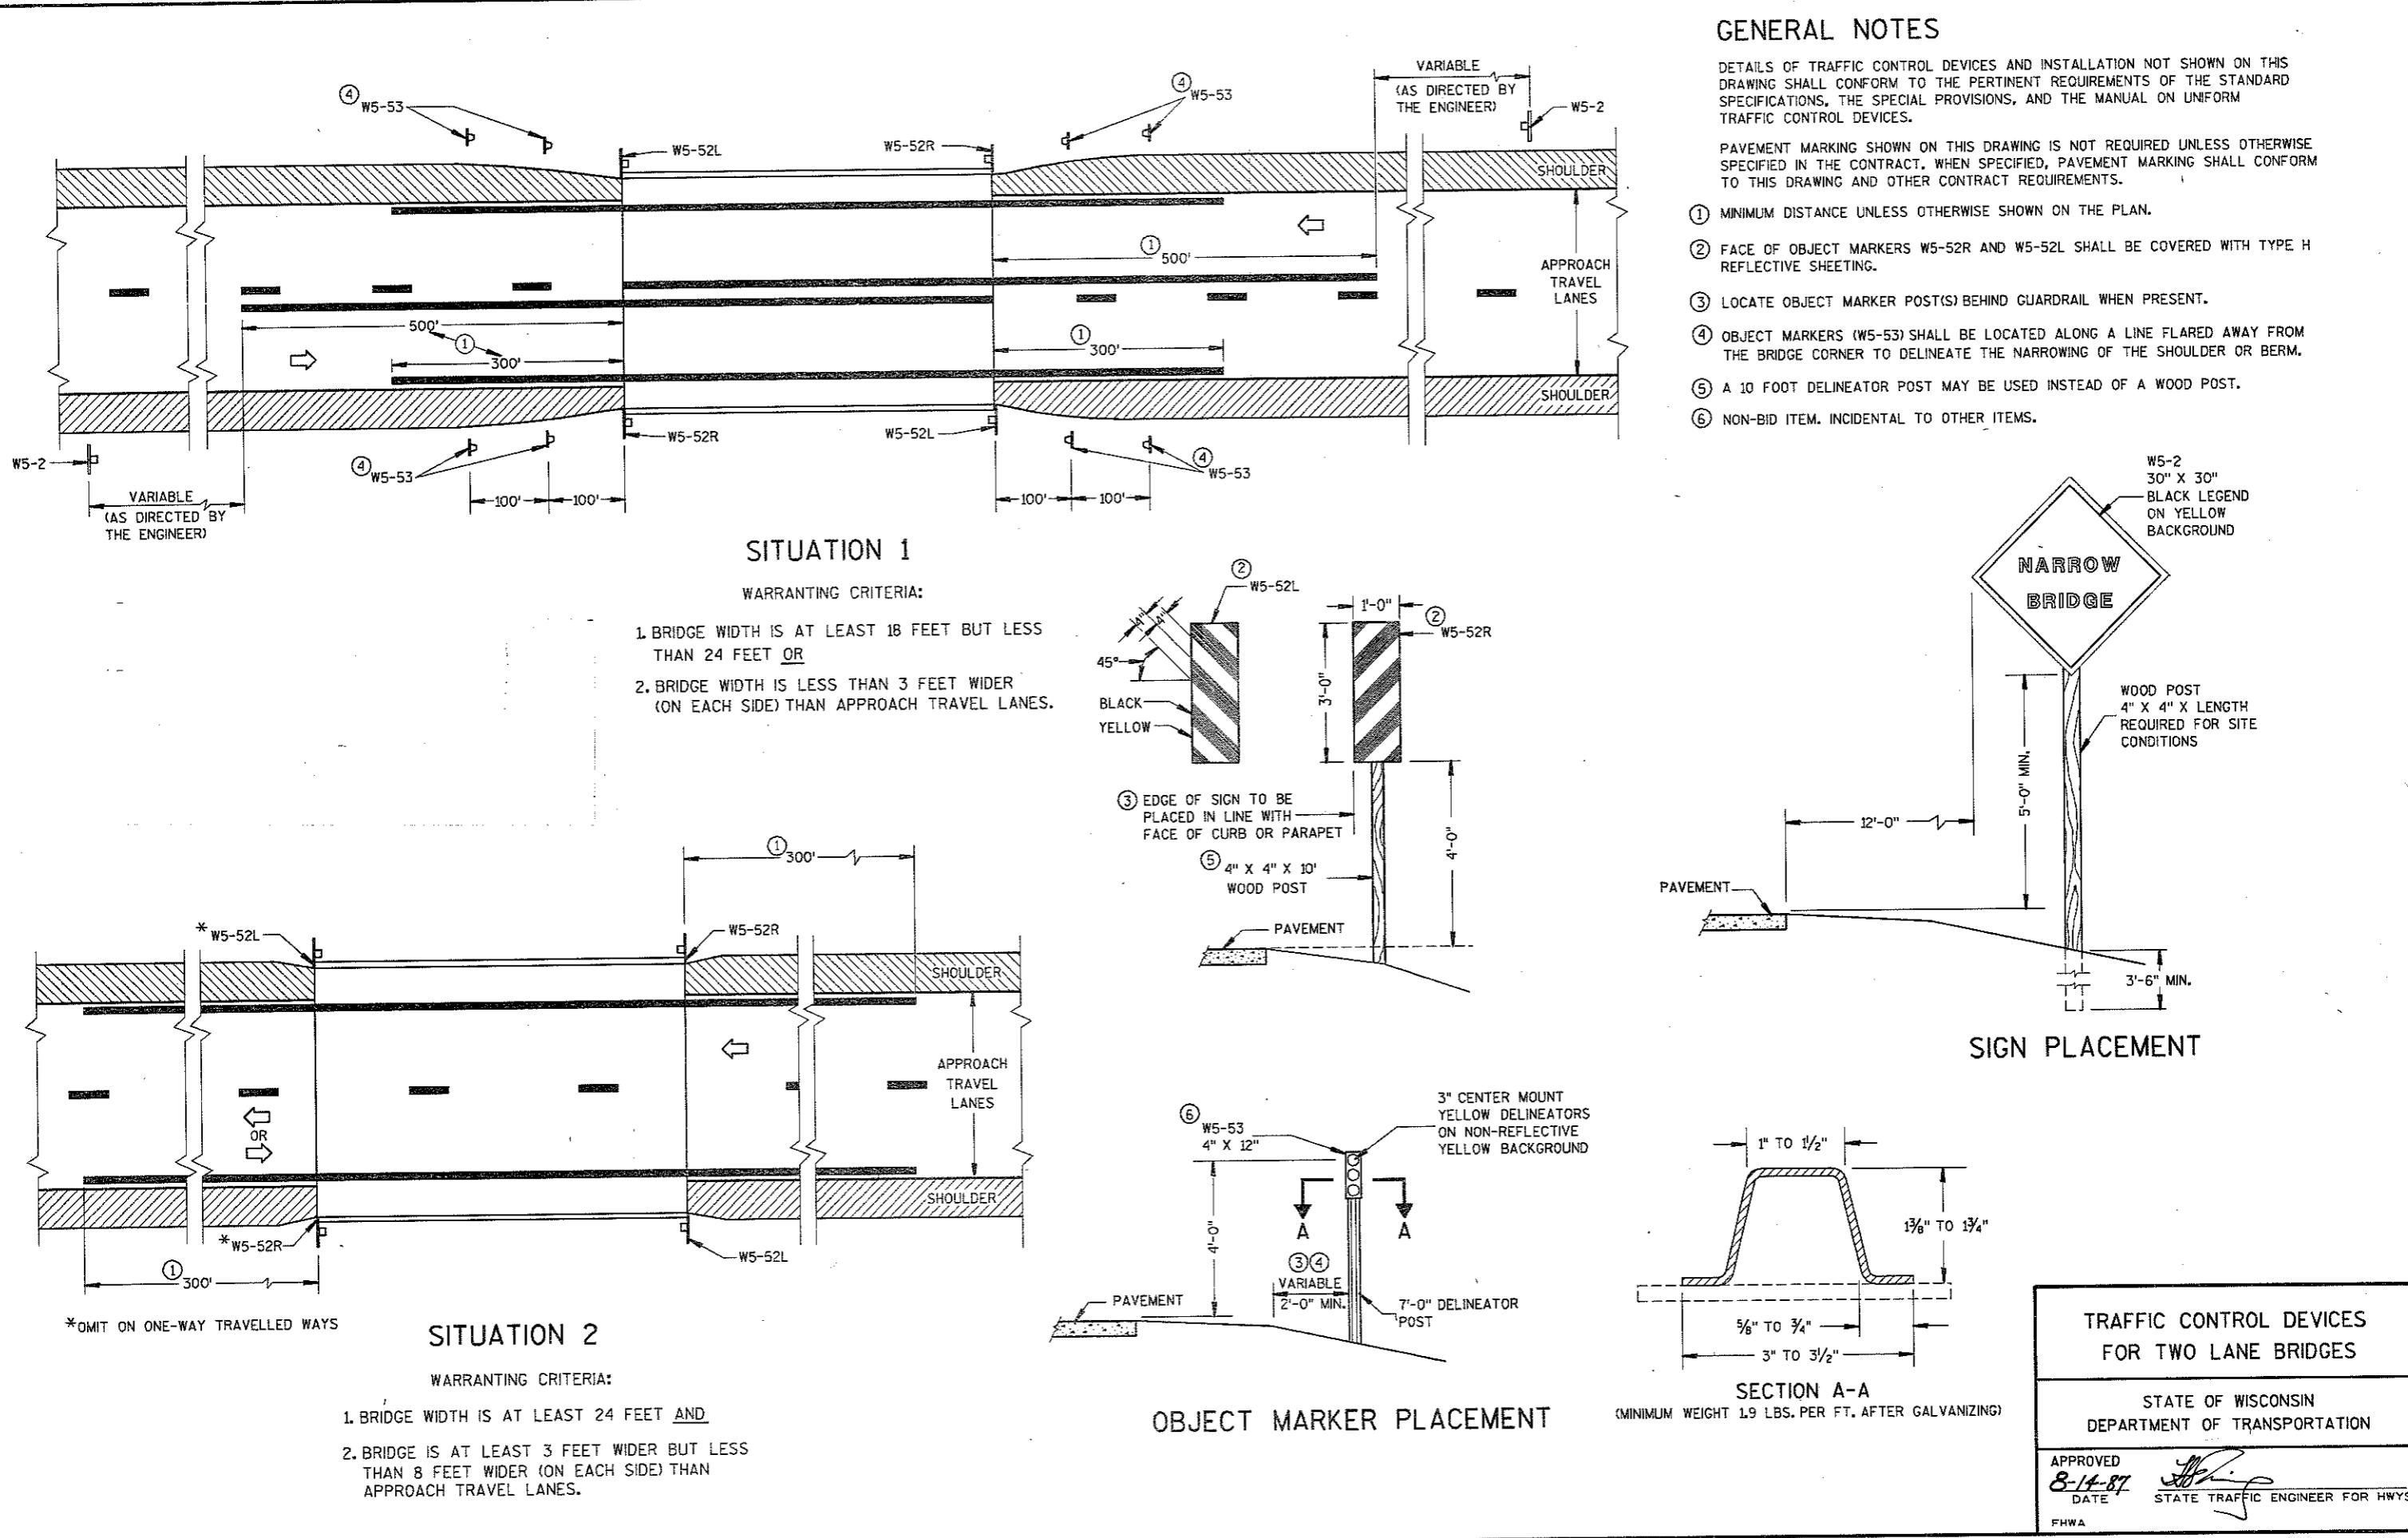

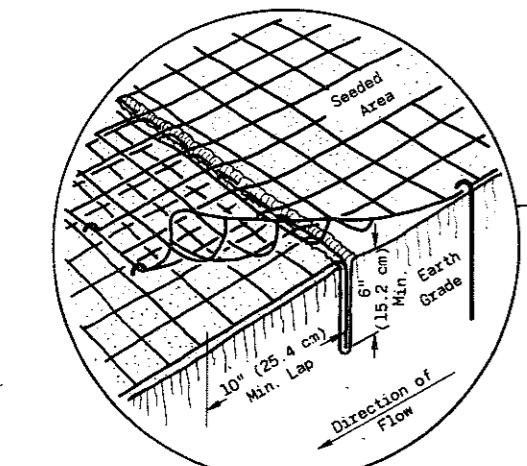


JUNCTION SLOT
(SEED ONLY)

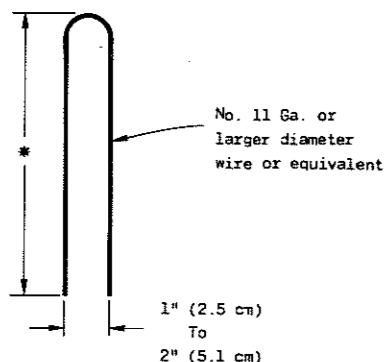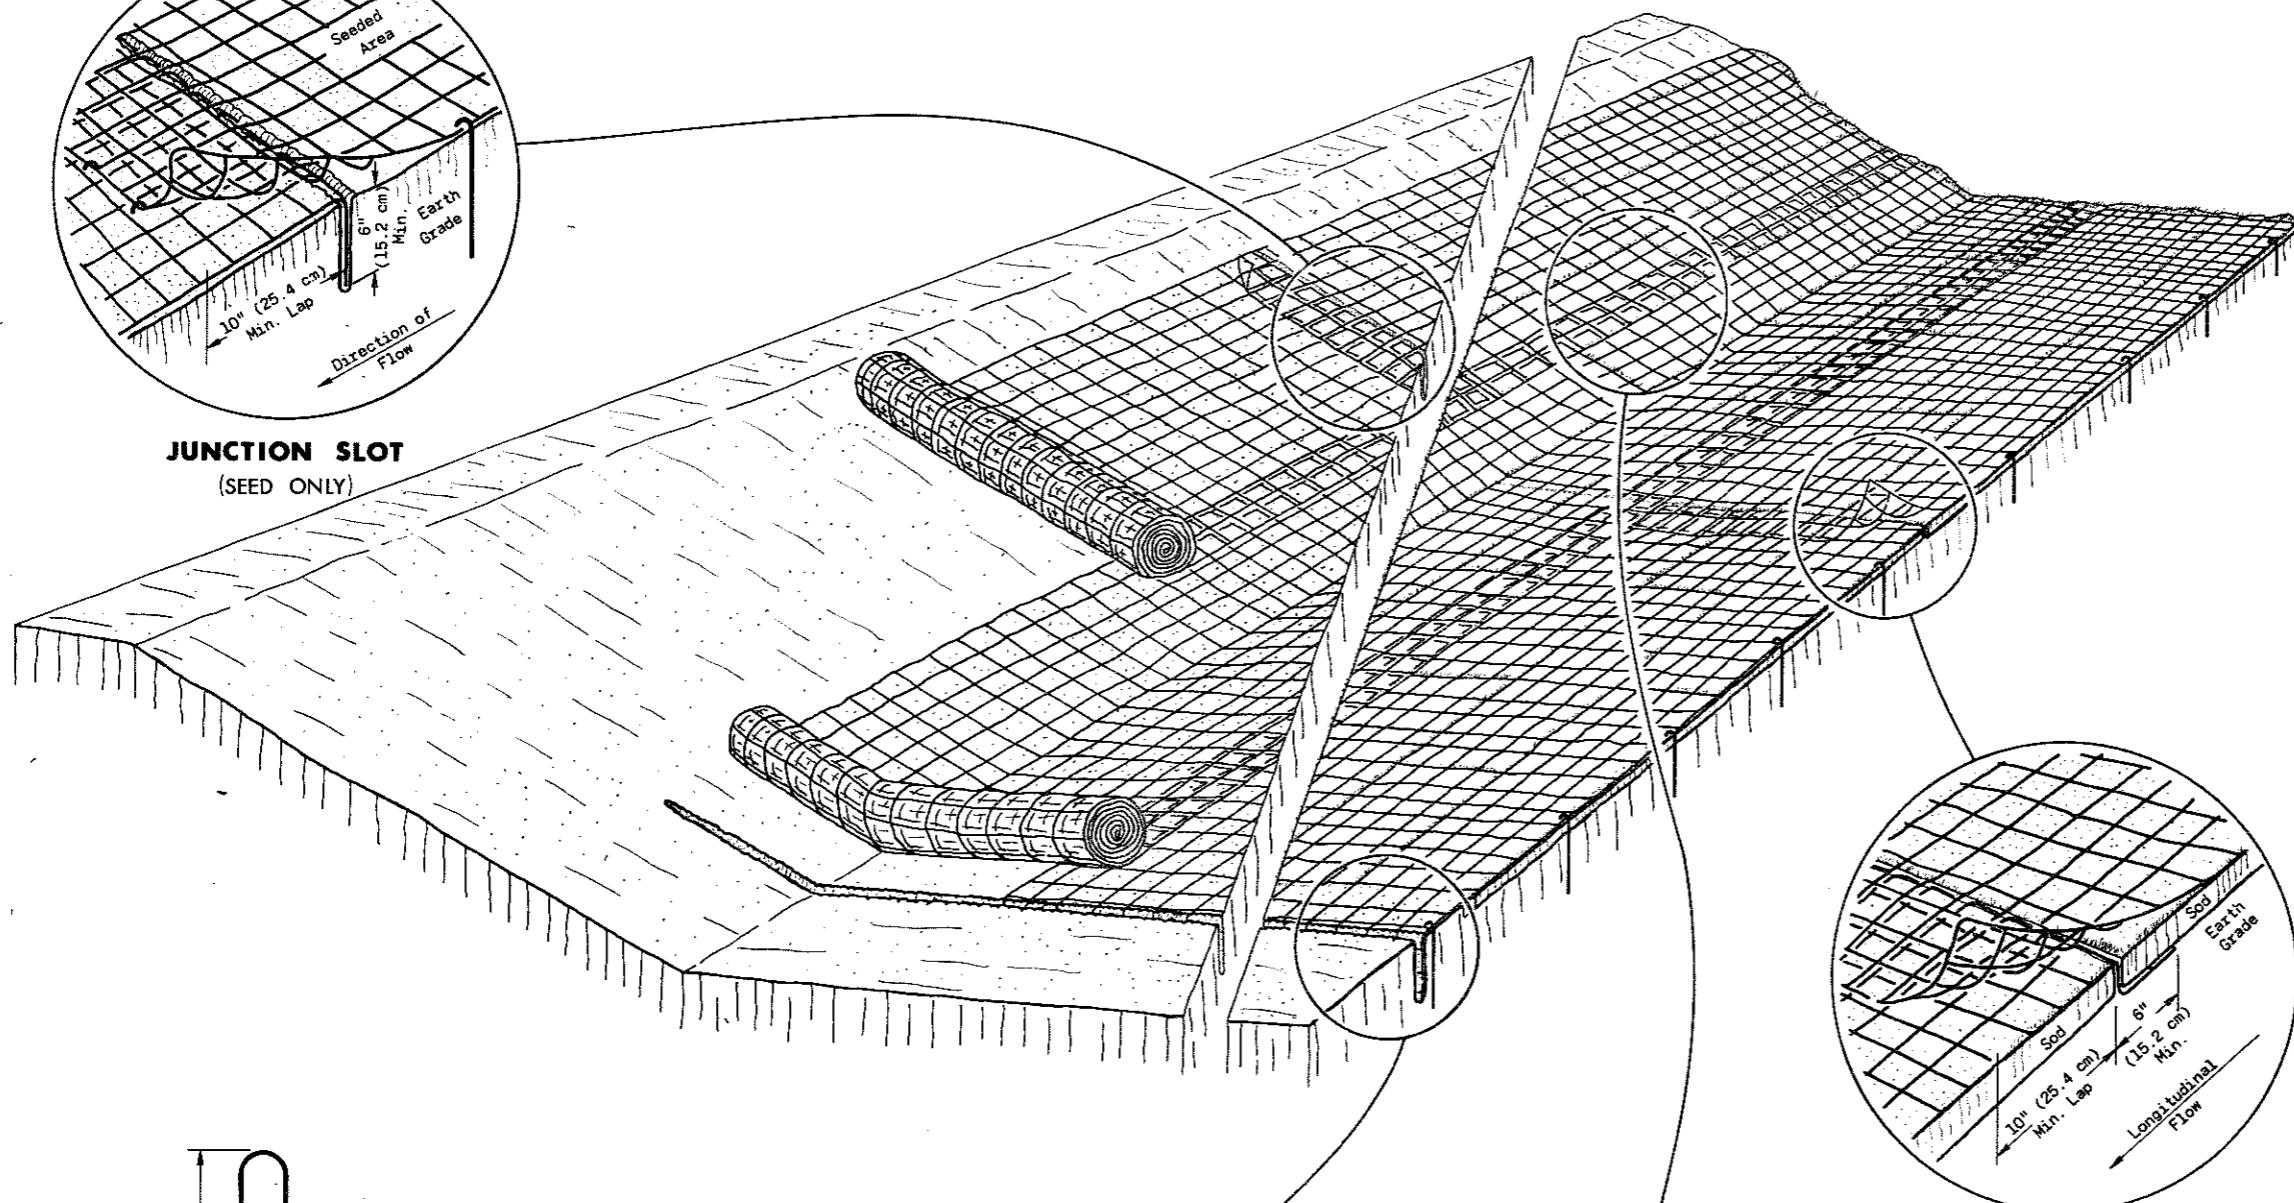


**DETAIL OF
TYPICAL STAPLE**

* 6" (15.2 cm) Min. for firm soils
12" (30.5 cm) Min. for loose soils
8" (20.3 cm) Min. where both sod and mats are being used.

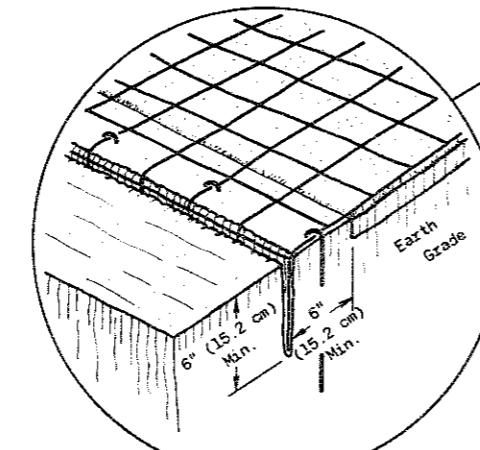

ANCHOR SLOT
AT BEGINNING AND END OF EROSION MAT
(SEED AND SOD)

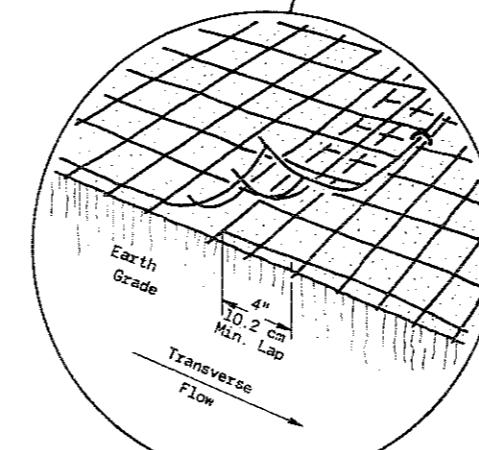

LAP JOINT
(SEED AND SOD)

GENERAL NOTES

Details of construction, materials and workmanship not shown on this drawing shall conform to the pertinent requirements of the Standard Specifications and the applicable Special Provisions.

Variations in the dimensions or materials shown hereon shall be permitted if they provide equivalent protection and material strength and if prior approval of the Engineer is obtained.

Lap Joints shall not be placed in the bottom of V-shaped ditches.

Junction Slots on adjacent strips of Matting shall be staggered a minimum of 4 feet (1.219 m) apart.

Edges of the Erosion Mat shall be impressed in the soil.


Erosion Mat shall be measured and paid for in accordance with the Standard Specifications.

EROSION MAT OVER SOD


- Only Jute Fabric will be permitted over sod.
- Wood Stakes for Sod may be omitted by the Engineer if the existing slope and soil conditions so warrant.
- The width of Erosion Mat shall always equal the Sod width.
- Sod strips may be placed either longitudinally or transversely to the flow line of the Ditch.

EROSION MAT OVER SEEDING

Junction or Anchor Slots shall be at minimum intervals of 100 feet (30.48 m) on grades up to and including 3 percent, and 50 feet (15.24 m) on grades exceeding 3 percent.

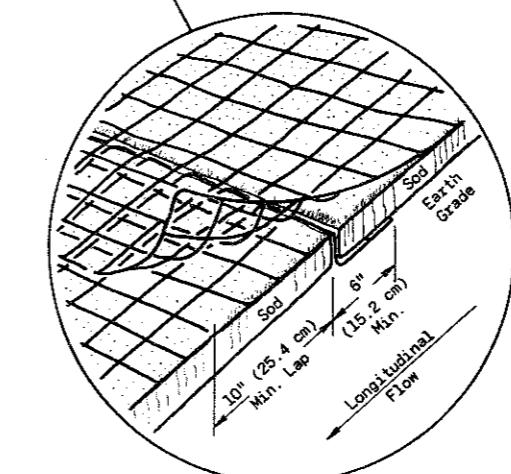

JUNCTION SLOT
(SOD ONLY)

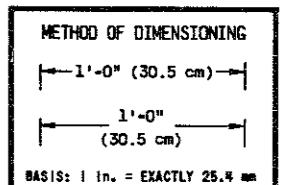

EROSION MAT


*State of Wisconsin
Department of Transportation
Division of Highways*

RECOMMENDED FOR APPROVAL:
12-3-73


J. C. Judd
CHIEF OF FACILITIES DEVELOPMENT

APPROVED
1-15-74


H. J. Siedler
STATE HIGHWAY ENGINEER

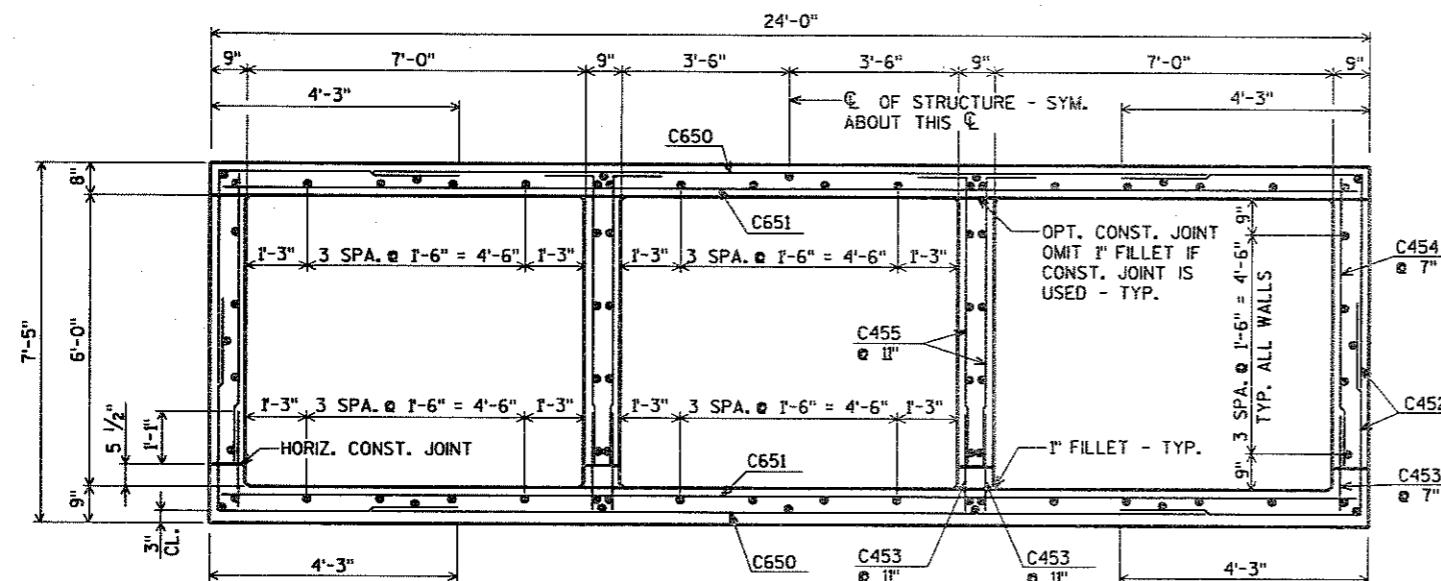


TYP. SECTION THRU BOX

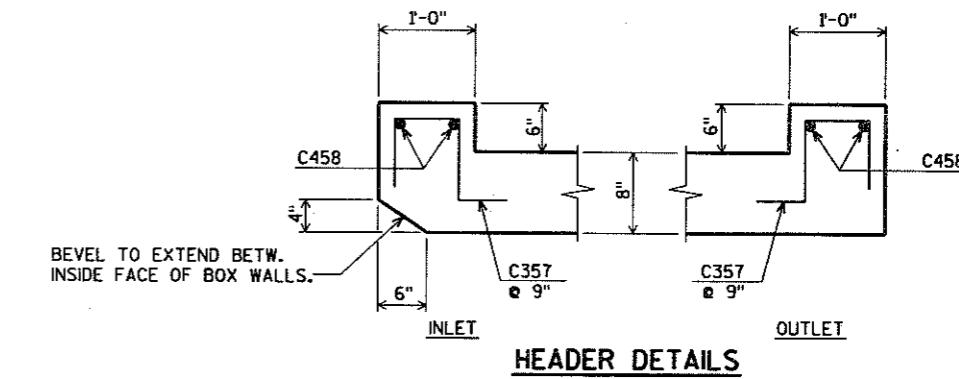NOTE: ALL LONGITUDINAL BARS
IN BOX ARE C449


HEADER DETAILS

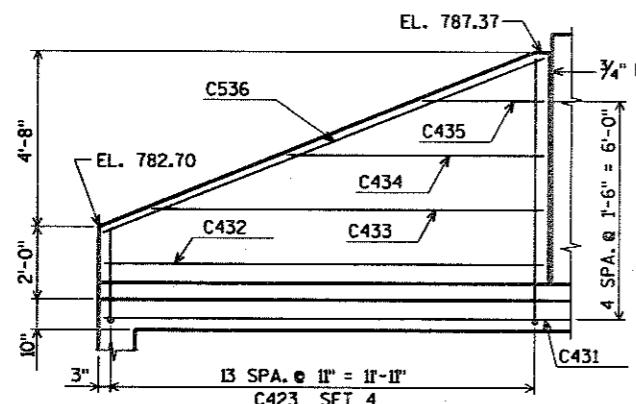


ELEVATION - WING 2

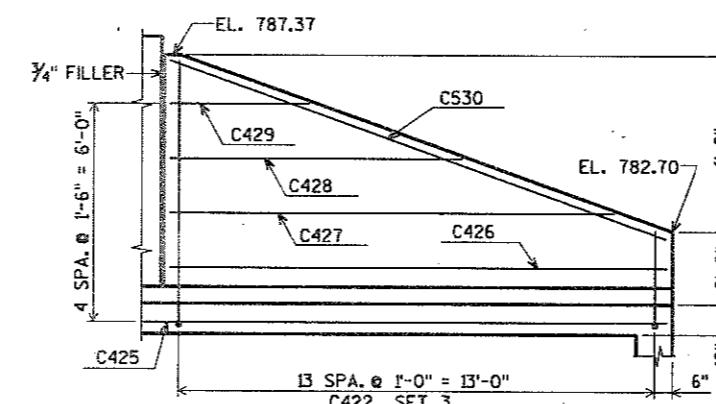


ELEVATION - WING 1

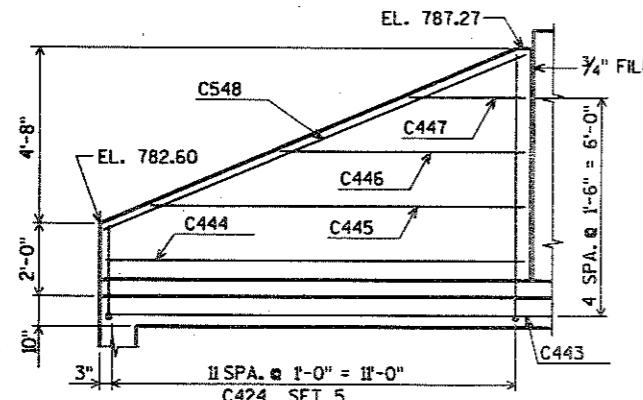

ELEVATION - WING 4

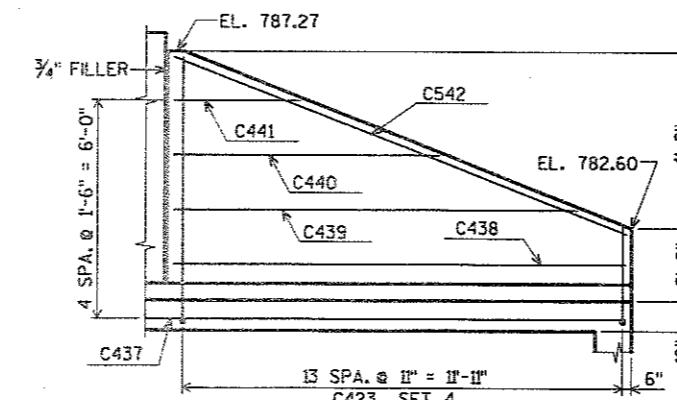


ELEVATION - WING 3

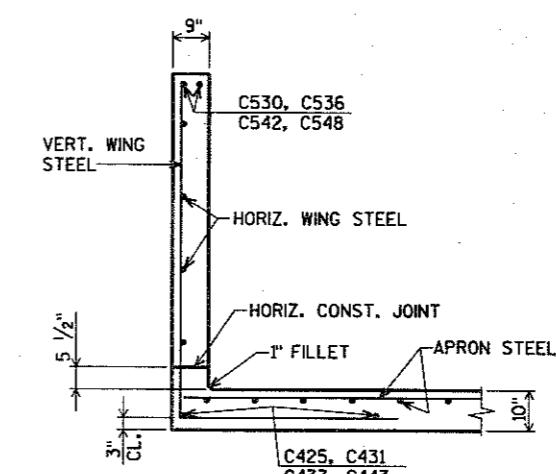

TYP. SECTION THRU WING


No.	Date	Revision	By
PLANS PREPARED BY AYRES ASSOCIATES Engineers/Architects Planners/Surveyors Owen Ayres & Associates Inc. Eau Claire, Wisconsin			
STATE OF WISCONSIN DEPARTMENT OF TRANSPORTATION			
STRUCTURE B-44-120			
Const. Spec.	1981	Drawn By	6. L. P.
Plots Checked		BHP	
BOX AND WING DETAILS			
SHEET 2 OF 5			

X 8/875

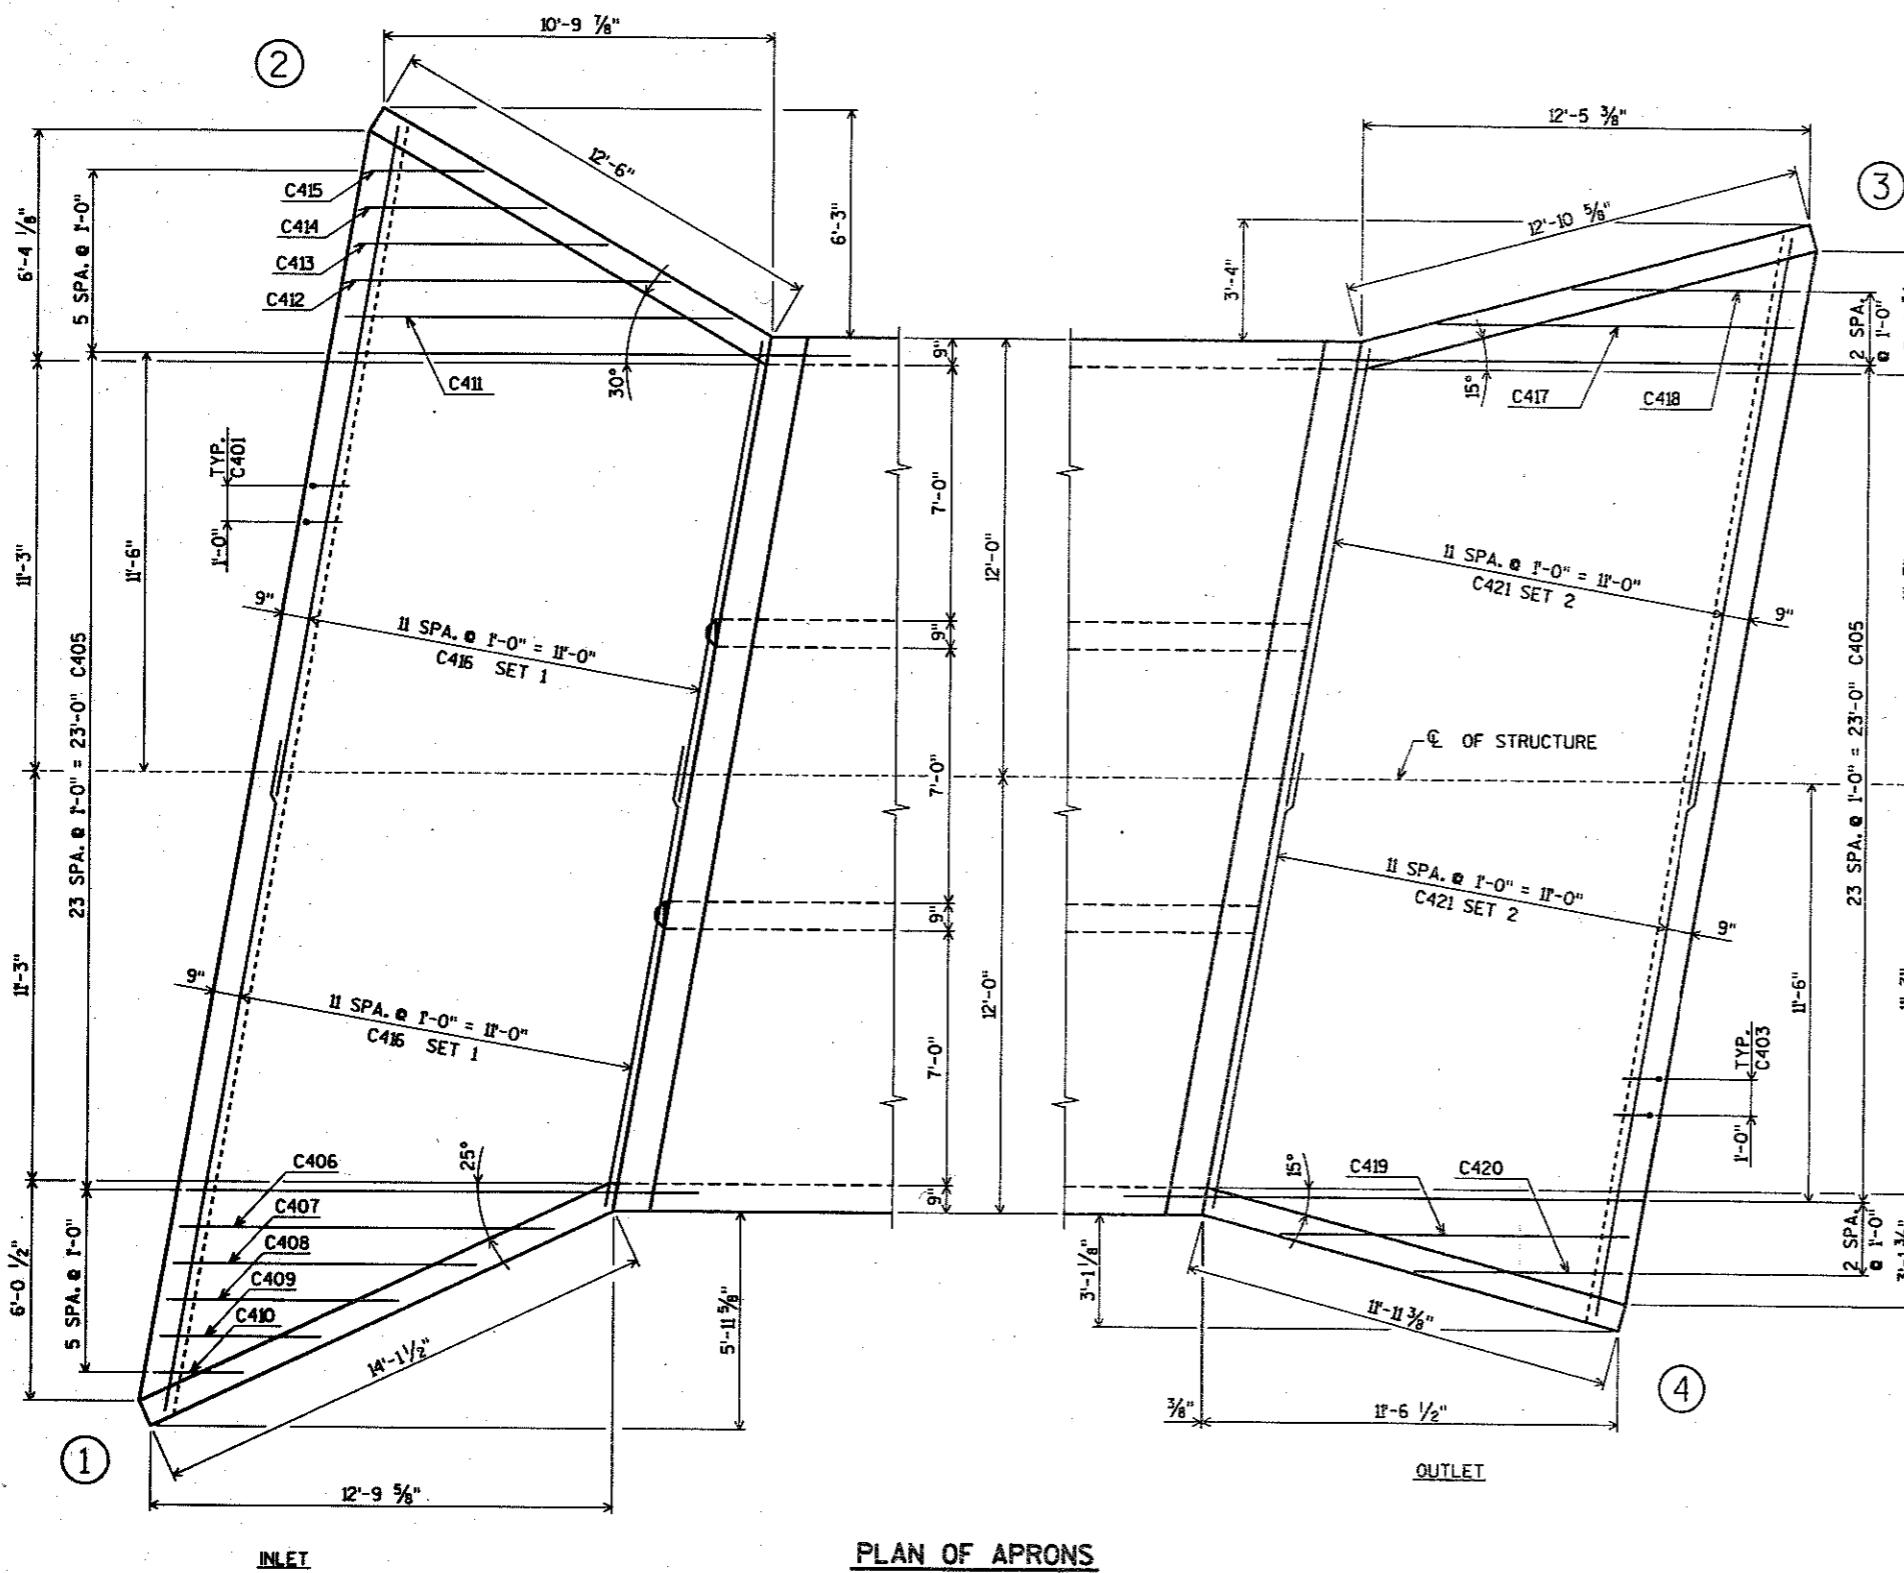

PLAN OF APRONS

STATE PROJECT NUMBER **6528-4-71** SHEET NO. **82**

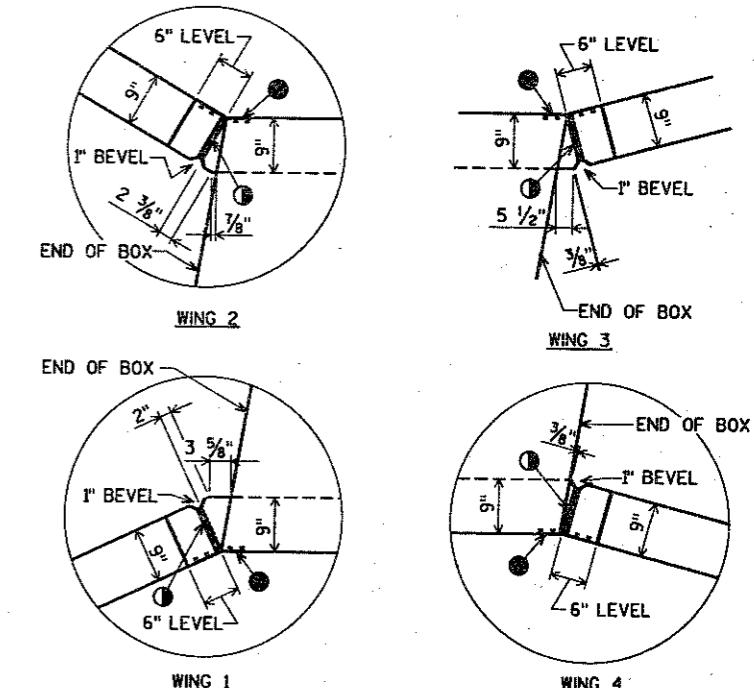

NOTE: DO NOT RUN ANY
BAR STEEL REINF.
THRU JOINT FILLER.

CORNER DETAILS



- POLYVINYL CHLORIDE WATERSTOP - EXTEND FROM HORIZ. CONST. JT. TO TOP OF WALL. (FLUSH WITH FACE OF CONCRETE.)
- $3/4"$ FILLER TO EXTEND FROM HORIZ. CONST. JT. TO TOP OF WING.

No.	Date	Revision	By
PLANS PREPARED BY			
AYRES Engineers/Architects			
Planners/Surveyors			
Owen Ayres & Associates Inc.			
Eau Claire, Wisconsin			
STATE OF WISCONSIN			
DEPARTMENT OF TRANSPORTATION			
STRUCTURE B-44-120			
Const. Spec.	1981	Drawn By	G.L.O. Checked D.H.P.
APRON DETAILS SHEET 3 OF 5			
X 81875			





BILL OF BARS

BAR. NO.	NO. REQ'D.	LENGTH	BENT BAR	COATED BAR	CUT. DIAGR.	18,470* UNCOATED	
						LOCATION	
C401	36	3'-7"	X			CUTOFF WALL - INLET	
C402	3	35'-4"				CUTOFF WALL - INLET	
C403	31	5'-7"	X			CUTOFF WALL - OUTLET	
C404	5	29'-6"				CUTOFF WALL - OUTLET	
C405	48	14'-3"				APRON - INLET & OUTLET	
C406	1	10'-5"				APRON - INLET @ WING 1	
C407	1	8'-5"				APRON - INLET @ WING 1	
C408	1	6'-6"				APRON - INLET @ WING 1	
C409	1	4'-6"				APRON - INLET @ WING 1	
C410	1	2'-6"				APRON - INLET @ WING 1	
C411	1	10'-9"				APRON - INLET @ WING 2	
C412	1	8'-10"				APRON - INLET @ WING 2	
C413	1	7'-0"				APRON - INLET @ WING 2	
C414	1	5'-1"				APRON - INLET @ WING 2	
C415	1	3'-2"				APRON - INLET @ WING 2	
C416	12	31'-6"	X			APRON - INLET SET 1	
C417	1	9'-11"				APRON - OUTLET @ WING 3	
C418	1	6'-5"				APRON - OUTLET @ WING 3	
C419	1	9'-9"				APRON - OUTLET @ WING 4	
C420	1	5'-10"				APRON - OUTLET @ WING 4	
C421	12	28'-7"	X			APRON - OUTLET SET 2	
C422	7	18'-6"	X	X		WING 1 - VERT. SET 3	
C423	7	18'-6"	X	X		WING 2 & 3 - VERT. SET 4	
C424	6	18'-6"	X	X		WING 4 - VERT. SET 5	
C425	2	16'-4"				WING 1 - HORIZ.	
C426	1	13'-8"				WING 1 - HORIZ.	
C427	1	12'-4"				WING 1 - HORIZ.	
C428	1	8'-1"				WING 1 - HORIZ.	
C429	1	3'-10"				WING 1 - HORIZ.	
C530	2	14'-6"				WING 1 - DIAG.	
C431	2	14'-7"				WING 2 - HORIZ.	
C432	1	12'-1"				WING 2 - HORIZ.	
C433	1	10'-10"				WING 2 - HORIZ.	
C434	1	7'-2"				WING 2 - HORIZ.	
C435	1	3'-5"				WING 2 - HORIZ.	
C536	2	13'-1"				WING 2 - DIAG.	
C437	2	15'-3"				WING 3 - HORIZ.	
C438	1	12'-6"				WING 3 - HORIZ.	
C439	1	11'-2"				WING 3 - HORIZ.	
C440	1	7'-4"				WING 3 - HORIZ.	
C441	1	3'-6"				WING 3 - HORIZ.	
C542	2	13'-5"				WING 3 - DIAG.	
C443	2	14'-1"				WING 4 - HORIZ.	
C444	1	11'-6"				WING 4 - HORIZ.	
C445	1	10'-4"				WING 4 - HORIZ.	
C446	1	6'-10"				WING 4 - HORIZ.	
C447	1	3'-3"				WING 4 - HORIZ.	
C548	2	12'-7"				WING 4 - DIAG.	
C449	152	26'-2"				BOX - LONG.	
C650	116	18'-8"				BOX - TRANS. BOT. & TOP SLAB	
C651	182	24'-0"				BOX - TRANS. BOT. & TOP SLAB	
C452	232	8'-4"	X			BOX - EXT. CORNERS	
C453	414	2'-1"				BOX - WALL DOWELS	
C454	182	6'-0"				BOX - EXT. WALL VERT.	
C455	232	6'-11"	X			BOX - INT. WALL VERT.	
C556	72	4'-0"				BOX - VERT. CONST. JOINT	
C357	64	2'-4"	X			BOX - HEADER	
C458	4	24'-0"				BOX - HEADER	

STATE PROJECT NUMBER 6528-4-71 SHEET NO. 83

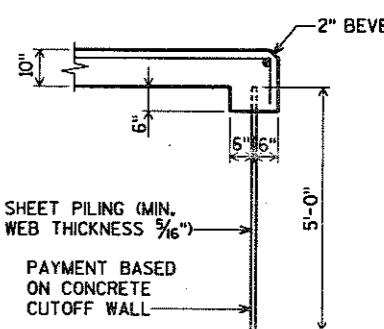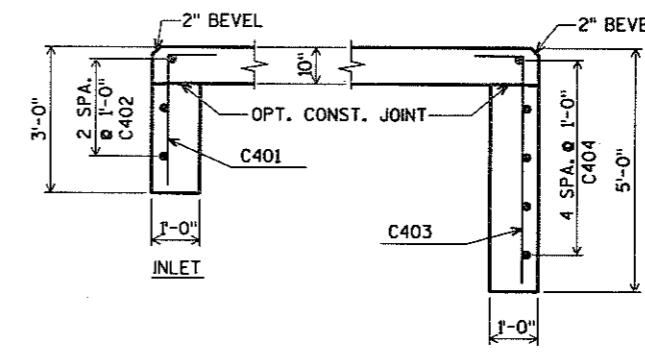

SECTION THRU CUTOFF WALL

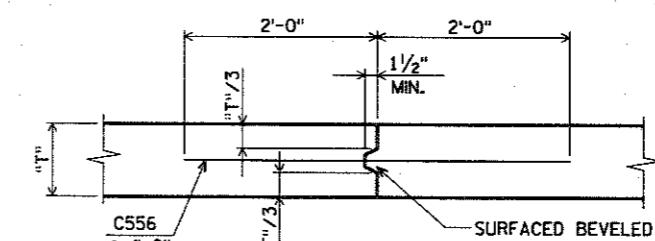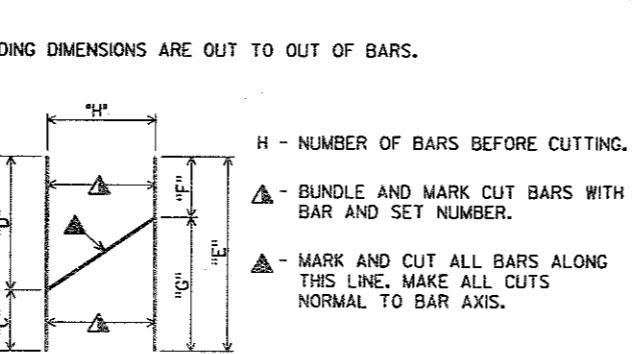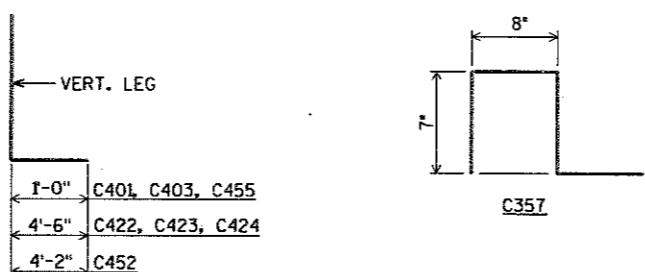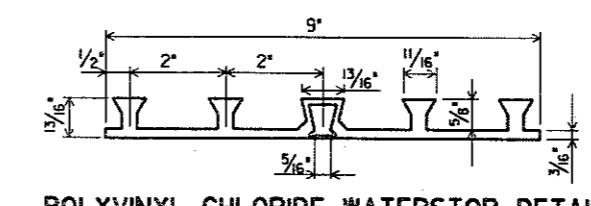VERT. CONST. JOINT
(ALL WALLS AND SLABS)POLYVINYL CHLORIDE WATERSTOP DETAIL
(P.C.W.)

No.	Date	Revision	By
PLANS PREPARED BY AVRES Engineers/Architects Planners/Surveyors Owen Ayres & Associates Inc. Eau Claire, Wisconsin			
STATE OF WISCONSIN DEPARTMENT OF TRANSPORTATION			
STRUCTURE B-44-120			
Const. Spec.	1981	Drawn By	G.L.D.
Plans Checked D.H.P.			
SHEET 4 OF 5			
BILL OF BARS AND DETAILS X 81875			

ADDITIONAL EVIDENCE 67

28.29 70.31 12.77 4.75 36.77 7.2 38.40 41.62 47.44 48.45 49.46

13. 14. 15. 17. 18. 19. 20. 21. 22. 23. 24. 25. 26. 27.

卷之三

卷之三

EMBARRASS RIVER

BORING #1

BORING #2

STA. 20+04.00

C OF C.T.H. "D"


19

20

21

BORINGS TAKEN BY:
SOILS & ENGINEERING SERVICES, INC.
MADISON, WISCONSIN
JUNE 4, 1987

NOTE:
UNCONFINED STRENGTH SHOWN
ESTIMATED BY POCKET PENETROMETER.

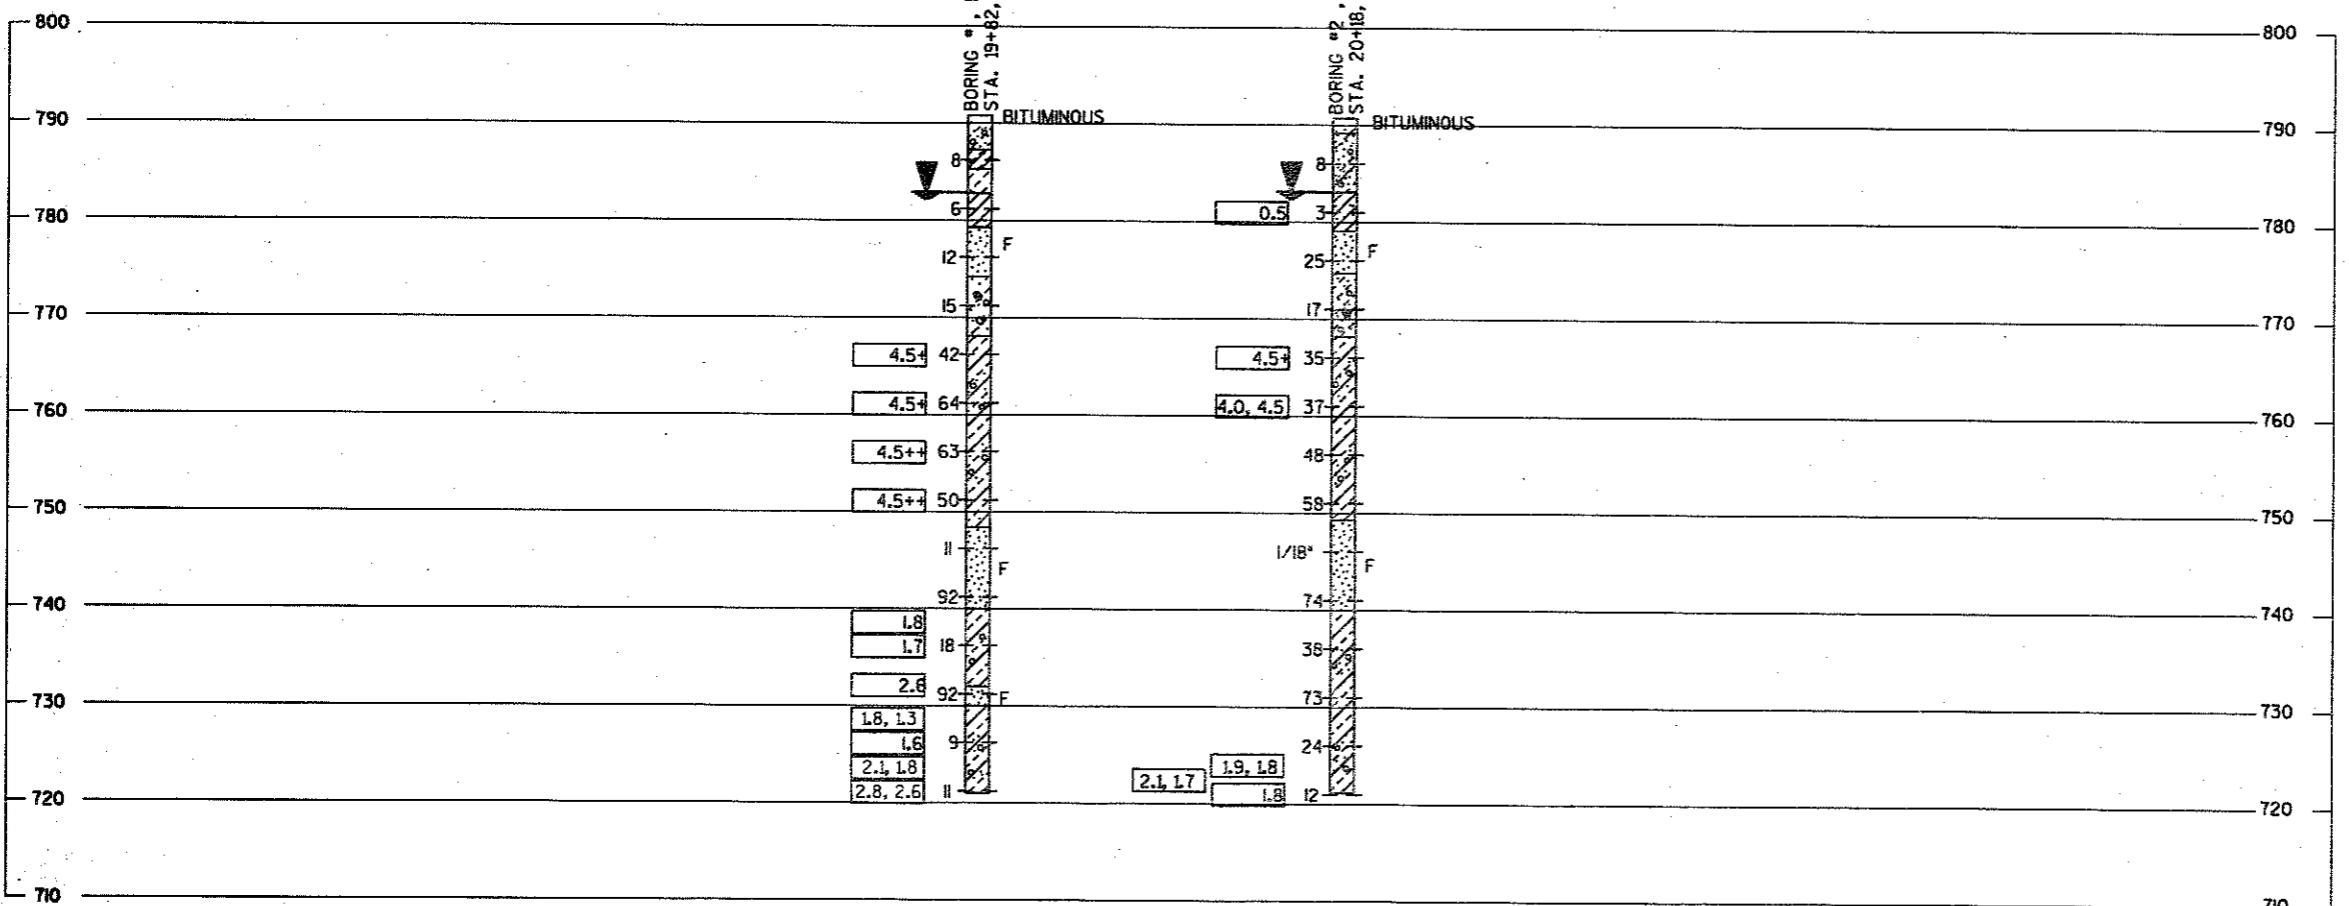

| | |
|----------------------|-----------|
| STATE PROJECT NUMBER | SHEET NO. |
| 528-4-71 | 84 |

ABBREVIATIONS

--- Fine M --- Medium C --- Coarse
 Ws --- Weathered So --- Sound

| MATERIAL SYMBOLS | | | | | |
|------------------|---------|--|------|--|--------------|
| | Topsoil | | Silt | | Sandstone |
| | Sand | | Peat | | Limestone |
| | Gravel | | Clay | | Igneous Rock |

LEGEND OF PROBING

95/6 = 95 Blows for 6'
 Penetration
 Probing taken with a
 350° wt.
 falling 18" on a 2"
 D.B. Point.

LEGEND OF BORING

Geological cross-section diagram showing soil test results and subsurface layers. The diagram includes a vertical column of soil samples labeled from top to bottom: Sandy Gravel, F, Boulders or Cobbles, Sand, Silty Clay, So, and Limestone. To the left, a table provides data for a soil sample at a depth of 7 feet, 7 inches, with a 140° angle of repose. The table also includes data for a sample taken at the surface (0 feet, 0 inches) and a sample taken at a depth of 10 feet, 0 inches. A note indicates that ground water was observed above the 10-foot elevation. A 'S.T.' label is placed next to the 0-foot sample.

| Depth (ft, in) | Angle of Repose | Strength (lb per foot) |
|----------------|-----------------|------------------------|
| 0, 0 | 30° | 7.7 |
| 7, 7 | 30° | 7.7 |
| 10, 0 | 30° | 7.7 |

Ground Water elevation
observed Above this Elevation

S.T.

ess otherwise specified, the blows per foot at locations indicated are based on driving a 5.0" x 14.7" split spoon sampler with a 10° hammer having a free fall of 30". The blow count taken in undisturbed soil immediately below a closed or open hole eliminating side friction on the pipe.

UBSURFACE EXPLORATION FOR FOUNDATION DESIGN AND BIDDERS INFORMATION

obtain relative data concerning the character of material in and upon which the foundation might be built, borings and/or soundings were made at points approximately as indicated on this drawing. The data presented herein represents the findings of the subsurface explorations made. However, because the depths investigated are limited and the area of the borings and/or soundings is very small in relation to the entire area, the DEPT. of TRANSPORTATION does not warrant conditions below the depths investigated or that the classification of material encountered in these investigations is necessarily typical of the entire site.

Digitized by srujanika@gmail.com

Revision
PLANS PREPARED BY
ES Engineers/Architects
Planners/Surveyors
Owen Ayres & Associates

STATE OF WISCONSIN
DEPARTMENT OF TRANSPORTATION

DEPARTMENT OF TRANSPORT

STRUCTURE B-44-120

SUBSURFACE EXPLORATION

X 81875

卷之三

END PROJECT
SAT 20/5/00

2150

400

50

200

१८८

306

290

790

STATE PROJECT NO.

SHEE
NUMBER
9

BEGIN PROJECT
STA. 9+50

| | | | | | | |
|------------|----|--|--|--|--|----|
| HEET TOTAL | 96 | | | | | 85 |
|------------|----|--|--|--|--|----|