

CTH 'S' RECONSTRUCTION

STH 76 - KELLY ROAD

OUTAGAMIE COUNTY

AS-BUILT PLAN

CONSTRUCTED BY: Outagamie County Highway Department
HIGHWAY COMMISSIONER: Al Geurts, P.E.
FIELD OPERATIONS MANAGER: Paul Sponholz, P.E.
FOREMAN: Joe Schumacher
WORK STARTED: May 2013
WORK COMPLETED: October 2014

TOWN OF ELLINGTON, WISCONSIN
COUNTY PROJECT NO. 585000

SHEET INDEX

- | | |
|-------|---------------------------------|
| 1 | ABBREVIATIONS, SYMBOLS & NOTES |
| 2-4 | TYPICAL SECTIONS |
| 5-8 | HORIZONTAL ALIGNMENT DETAIL |
| 9-16 | MISC. CONSTRUCTION DETAILS |
| 17-18 | PAVING DETAILS |
| 19-24 | EROSION & SEDIMENT CONTROL PLAN |
| 25-26 | MISC. QUANTITIES |
| 27-34 | RIGHT-OF-WAY PLAT |
| 35-42 | PLAN AND PROFILE |
| 43-44 | EARTHWORK DATA TABLES |
| 45-89 | CROSS SECTIONS |

91 TOTAL SHEETS

CONTACT INFORMATION

UTILITIES

WE ENERGIES
JIM QUINN (ELECTRIC)
800 SOUTH LYNNDAL DRIVE P.O. BOX 1699
APPLETON, WI 54912
(920) 380-3401 (ELECTRIC)
jim.quinn@we-energies.com

AT&T
MIKE HAHN
221 WEST WASHINGTON STREET FLOOR 4
APPLETON, WI 54911
(920) 735-3358
mh5151@att.com

TIME WARNER CABLE
VINCE ALBIN
1001 KENNEDY AVENUE PO BOX 145
KIMBERLY, WI 54136-0145
(920) 831-9211
vince.albin@twcable.com

OWNER CONTACT

OUTAGAMIE COUNTY
AL GEURTZ, HIGHWAY COMMISSIONER
1313 HOLLAND ROAD
APPLETON, WI 54911

DESIGN CONTACT

McMAHON
MIKE KOHLBECK, PROJECT ENGINEER
1445 McMAHON DRIVE
NEENAH, WI 54956
(920) 751-4200



Call 811 or Toll Free (800) 242-8511
Hearing Impaired TTY (800) 542-2289
www.DiggersHotline.com

McMAHON
ENGINEERS ARCHITECTS

1445 McMAHON DRIVE NEENAH, WI 54956
Mailing: P.O. BOX 1025 NEENAH, WI 54957-1025
Tel: (920) 751-4200 Fax: (920) 751-4284
www.mcmgrp.com

S-42



DATE
February, 2014
PROJECT NO.
00006 910308

mkohlbeck_w:\PROJECTS\00006\910308\08-Design\Title and General Notes\01 NOTES.dwg, 01 notes, Plot Date: 5/14/2014 11:01 AM, xref is none

STANDARD ABBREVIATIONS

AC	ACRE	LT	LEFT
AGG	AGGREGATE	LVC	LENGTH OF VERTICAL CURVE
AH	AHEAD	MAINT	MAINTENANCE
ASPH	ASPHALT PAVEMENT	MAT'L	MATERIAL
AVG	AVERAGE	MAX	MAXIMUM
B-B	BACK TO BACK	MIN	MINIMUM
BEG	BEGIN	MH	MANHOLE
BIT	BITUMINOUS	MP	MILE POST
BK	BACK	NB	NORTHBOUND
B/L	BASE LINE	NO	NUMBER
BLDG	BUILDING	NOR	NORMAL
BM	BENCH MARK	OD	OUTSIDE DIAMETER
BOC	BACK OF CURB	OBLIT	OBLITERATE
BRG	BEARING	PAV'T	PAVEMENT
C-C	CENTER TO CENTER	PC	POINT OF CURVATURE
CY	CUBIC YARD	PCC	PORTLAND CEMENT CONCRETE OR POINT OF COMPOUND CURVATURE
C&G	CURB AND GUTTER	PE	PRIVATE ENTRANCE
CB	CATCH BASIN	PED	PEDESTAL
CE	COMMERCIAL ENTRANCE	PGL	PROFILE GRADE LINE
CHD	CHORD	PI	POINT OF INTERSECTION
C/L	CENTER LINE	PL	PROPERTY LINE
CL	CLASS (FOR CONC PIPE)	P/L	PERMANENT LIMITED EASEMENT
CMP	CORRUGATED METAL PIPE	PP	POWER POLE
CO	CLEAN OUT	PRC	POINT OF REVERSE CURVATURE
CONC	CONCRETE	PROP	PROPOSED
CORR	CORRUGATED	PSD	PASSING SIGHT DISTANCE
CP	CONTROL POINT	PSI	POUNDS PER SQUARE INCH
CR	CRUSHED	PT	POINT OF TANGENCY
CS	CURB STOP	PVC	POLYVINYL CHLORIDE OR POINT OF VERTICAL CURVATURE
CSW	CONCRETE SIDEWALK	PVI	POINT OF VERTICAL INTERSECTION
CTH	COUNTY TRUNK HIGHWAY	R	RADIUS
CULV	CULVERT	RCP	REINFORCED CONCRETE PIPE
D	DEPTH OR DELTA	RD	ROAD
DI	DUCTILE IRON	REBAR	REINFORCEMENT ROD
DIA	DIAMETER	REM	REMOVE
DIS	DISCHARGE	RECON	RECONSTRUCT
EA	EACH	REQ'D	REQUIRED
EB	EASTBOUND	R/L	REFERENCE LINE
EBS	EXCAVATION BELOW SUBGRADE	RP	RADIUS POINT
EG	EDGE OF GRAVEL	RR	RAILROAD
ELEV	ELEVATION	RT	RIGHT
ELEC	ELECTRIC	R/W	RIGHT-OF-WAY
EMB	EMBANKMENT	SB	SOUTHBOUND
EMAT	EROSION MAT	SE	SUPERELEVATION
ENT	ENTRANCE	SF	SQUARE FEET
EOR	END OF RADIUS	SI	SLOPE INTERCEPT
EP	EDGE OF PAVEMENT	STH	STATE TRUNK HIGHWAY
EXC	EXCAVATION	SY	SQUARE YARD
EX	EXISTING	SALV	SALVAGED
EW	ENDWALL	SAN	SANITARY
F-F	FACE TO FACE	SEC	SECTION
FDN	FOUNDATION	SHLDR	SHOULDER
FE	FIELD ENTRANCE	S/L	SURVEY LINE
FERT	FERTILIZER	SQ	SQUARE
FG	FINISHED GRADE	STA	STATION
F/L	FLOW LINE	STD	STANDARD
FT	FOOT	STO	STORM
FTG	FOOTING	SW	SIDEWALK
GRAV	GRAVEL	TC	TOP OF CURB
GN	GRID NORTH	TEL	TELEPHONE
GV	GAS VALVE	TEMP	TEMPORARY
HDPE	HIGH DENSITY POLYETHYLENE	TLE	TEMPORARY LIMITED EASEMENT
HE	HIGHWAY EASEMENT	TV	TELEVISION
HMA	HOT MIX ASPHALT	TYP	TYPICAL
HP	HIGH POINT	UG	UNDERGROUND
HT	HEIGHT	USH	U.S. HIGHWAY
HYD	HYDRANT	VAR	VARIES
ID	INSIDE DIAMETER	VC	VERTICAL CURVE
IN	INCH	VERT	VERTICAL
INL	INLET	WB	WESTBOUND
INV	INVERT	WM	WATER MAIN
IP	IRON PIPE	WV	WATER VALVE
JCT	JUNCTION		
LB	POUND		
LF	LINEAR FOOT		
LP	LIGHT POLE		

GENERAL NOTES

- 1) THE UTILITIES SHOWN IN PLAN AND PROFILE ARE INDICATED IN ACCORDANCE WITH AVAILABLE RECORDS AT THE TIME OF DESIGN. THE COUNTY SHALL BE RESPONSIBLE FOR OBTAINING EXACT LOCATIONS AND ELEVATIONS OF ALL UTILITIES, INCLUDING ANY PRIVATE UTILITIES, FROM THE OWNERS OF THE RESPECTIVE UTILITIES. ALL UTILITIES SHALL BE NOTIFIED 72 HRS. PRIOR TO EXCAVATION.
- 2) EXISTING STREET RIGHT-OF-WAY AND INTERSECTING PROPERTY LINES ARE ESTABLISHED FROM FIELD LOCATED SURVEY MONUMENTATION, PREVIOUS SURVEYS, PLATS AND CURRENT PROPERTY DEEDS.
- 3) A SAWED JOINT IS REQUIRED WHERE NEW HMA PAVEMENT MATCHES EXISTING ASPHALTIC CONCRETE SURFACE.
- 4) ALL CURB RADII SHOWN ON THE PLAN SHEETS ARE TO THE BACK OF CURB UNLESS OTHERWISE NOTED.
- 5) DIMENSIONS ARE TO THE EDGE OF PAVEMENT/GUTTER FLANGE UNLESS OTHERWISE NOTED.
- 6) PROPOSED SPOT ELEVATIONS SHOWN ON THE PAVING DETAILS ARE FINISHED PAVEMENT GRADES AT THE EDGE OF PAVEMENT/EDGE OF GUTTER.
- 7) DISTURBED AREAS WITHIN THE RIGHT-OF-WAY, EXCEPT THE AREAS WITHIN FINISHED SHOULDER POINTS, SHALL BE FERTILIZED, SEEDED, AND MULCH OR EROSION MAT SHALL BE INSTALLED AS SPECIFIED IN THE EROSION CONTROL PLAN.
- 8) THE EXACT LOCATION AND WIDTH OF PRIVATE ENTRANCE DRIVEWAYS AND FIELD ENTRANCES WILL BE DETERMINED BY THE ENGINEER IN THE FIELD. DRIVEWAYS SHALL BE REPLACED IN KIND.

STANDARD SYMBOLS

	2" IRON PIPE FOUND		TELEPHONE CABLE -- BURIED
	1 1/4" REBAR FOUND		ELECTRIC CABLE -- BURIED
	1 1/4" x 30" IRON REBAR WEIGHING 4.30 LB/LF SET		UTILITIES -- OVERHEAD
	1" (1.315 OD) IRON PIPE FOUND		FIBER OPTIC CABLE -- BURIED
	1" IRON PIPE SET		GAS MAIN
	3/4" IRON REBAR FOUND		CABLE TELEVISION -- BURIED
	3/4" IRON PIPE FOUND		DITCH LINE
	3/4"x 24" IRON REBAR WEIGHING 1.5 LB/LF SET		STREET C/L OR R/L
	MAG NAIL FOUND		PROPERTY LINE
	MAG NAIL SET		RIGHT-OF-WAY LINE
	GEAR NAIL SET		SECTION LINE
	RAILROAD SPIKE FOUND		EXISTING CONTOURS
	RAILROAD SPIKE SET		PROPOSED CONTOURS
	CHISEL CROSS FOUND		EXISTING SANITARY SEWER
	CHISEL CROSS SET		PROPOSED SANITARY SEWER
	COUNTY MONUMENT		EXISTING WATER MAIN
	CONCRETE MONUMENT FOUND		PROPOSED WATER MAIN
	SOIL BORING or MONITORING WELL		EXISTING STORM SEWER
	POWER POLE		PROPOSED STORM SEWER
	POWER POLE W/GUY WIRE		EXISTING CURB & GUTTER
	TELEPHONE OR TELEVISION PEDESTAL		PROPOSED CURB & GUTTER
	MAILBOX		EXISTING CULVERT WITH END SECTIONS
	SIGN		PROPOSED CULVERT WITH END SECTIONS
	RAILROAD CROSS BUCK		BUILDING OUTLINE
	RAILROAD GATE ARM		FENCE LINE
	RAILROAD TRACKS		SAW CUT REQ'D
	LIGHT POLE		SILT FENCE
	WOOD POLE		GUARD RAIL
	TRAFFIC SIGNAL		DITCH CHECK
	TRAFFIC SIGNAL MAST ARM		INLET PROTECTION
	CONIFEROUS TREE		TRACKING PAD
	DECIDUOUS TREE		TURBIDITY BARRIER OR SHEET PILING
	TREE OR BRUSH LINE		SANDBAG COFFERDAM
	BED ROCK (IN PROFILE VIEW)		SLOPE INTERCEPT
	HANDICAPPED PARKING STALL		LIMITS OF DISTURBANCE
	EXISTING SPOT ELEVATION		DELINEATED WETLANDS
	PROPOSED SPOT ELEVATION		EXISTING PAVEMENT
	DRAINAGE HIGH POINT		RIP-RAP (SIZE AS SPECIFIED)
	DRAINAGE DIRECTION		EROSION MAT, CLASS I, TYPE B
	EXISTING MANHOLE		EROSION MAT, CLASS II, TYPE B
	PROPOSED MANHOLE		
	EXISTING INLET		
	PROPOSED INLET		
	EXISTING YARD DRAIN		
	PROPOSED YARD DRAIN		
	EXISTING CLEAN OUT		
	PROPOSED CLEAN OUT		
	EXISTING WATER VALVE		
	PROPOSED WATER VALVE		
	EXISTING CURB STOP		
	PROPOSED CURB STOP		
	EXISTING FIRE HYDRANT		
	PROPOSED FIRE HYDRANT		
	PROPOSED WATER FITTING		
	PROPOSED WATER REDUCER		
	PROPOSED ENDCAP		
	GAS VALVE		

EROSION & SEDIMENT CONTROL PLAN

BEST MANAGEMENT PRACTICES:

THE CONTRACTOR IS RESPONSIBLE FOR FURNISHING, INSTALLING, MAINTAINING AND REMOVING BEST MANAGEMENT PRACTICES IN ACCORDANCE WITH WISCONSIN DEPARTMENT OF NATURAL RESOURCES (DNR) TECHNICAL STANDARDS. THESE STANDARDS MAY BE FOUND ON THE DNR WEBSITE AT <http://www.dnr.wi.gov/runoff/stormwater/techstds.htm>. RIP-RAP SHALL BE IN ACCORDANCE WITH SECTION 606, WIS-DOT STANDARD SPECIFICATIONS FOR HIGHWAY AND STRUCTURE CONSTRUCTION, LATEST EDITION, UNTIL TECHNICAL STANDARD 1065 IS COMPLETED BY THE DNR. THE MINIMUM BEST MANAGEMENT PRACTICES SPECIFIED FOR THIS PROJECT ARE AS FOLLOWS:

[] LAND APPLICATION OF POLYACRYLAMIDE (1050)	[] DE-WATERING (1061)
[] WATER APPLICATION OF POLYMERS (1051)	[X] DITCH CHECK (1062)
[X] NON-CHANNEL EROSION MAT (1052)	[X] SEDIMENT TRAP (1063)
[X] CHANNEL EROSION MAT (1053)	[] SEDIMENT BASIN (1064)
[] VEGETATIVE BUFFER (1054)	[X] RIP-RAP (1065)
[X] SEDIMENT BALE BARRIER (1055)	[] CONSTRUCTION DIVERSION (1066)
[X] SILT FENCE (1056)	[X] GRADING PRACTICES (1067)
[X] TRACKING PAD & TIRE WASHING (1057)	[X] DUST CONTROL (1068)
[X] MULCHING (1058)	[] TURBIDITY BARRIER (1069)
[X] SEEDING (1059)	[] SILT CURTAIN (1070)
[X] STORM DRAIN INLET PROTECTION (1060)	

REFER TO THE "EROSION CONTROL PLAN" PORTION OF THIS PLAN FOR ADDITIONAL EROSION & SEDIMENT CONTROL PLAN INFORMATION.

THE CONTRACTOR IS RESPONSIBLE FOR COORDINATING CONSTRUCTION ACTIVITIES AND IMPLEMENTING BEST MANAGEMENT PRACTICES TO DO THE FOLLOWING TO THE MAXIMUM EXTENT PRACTICABLE:

- A. PRESERVE EXISTING VEGETATION WHERE POSSIBLE. TEMPORARILY STABILIZE EXPOSED SOILS THAT WILL NOT BE ACTIVE FOR 30 DAYS OR MORE. POLYACRYLAMIDE, MULCHING, SEEDING AND GRAVELING MAY BE USED TO TEMPORARILY STABILIZE EXPOSED SOILS.
- B. DIVERT CLEAR WATER AWAY FROM EXPOSED SOILS USING CONSTRUCTION DIVERSIONS.
- C. MANAGE SHEET FLOW THAT IS NOT CONTROLLED WITH A SEDIMENT TRAPPING DEVICE. SILT FENCE IS USED TO MANAGE SHEET FLOW. GRADING PRACTICES MAY BE USED TO SUPPLEMENT THE SILT FENCE.
- D. MANAGE CONCENTRATED FLOW WITH SEDIMENT TRAPPING DEVICES. STORM DRAIN INLET PROTECTION IS USED TO MANAGE CONCENTRATED FLOW.
- E. MINIMIZE THE AMOUNT OF SOIL EXPOSED AT ANY ONE TIME.
- F. PROTECT INLETS FROM RECEIVING SEDIMENT WITH STORM DRAIN INLET PROTECTION.
- G. PREVENT TRACKING OF SEDIMENT ONTO ROADS AND PAVED SURFACES USING TRACKING PADS AND/OR TIRE WASHING. MINIMIZE TRACKING AT ALL SITE EXITS AND ENTRANCES.
- H. CLEANUP OFFSITE SEDIMENT DEPOSITS AT THE END OF EACH WORK DAY & BEFORE A RAIN.
- I. MANAGE THE USE, STORAGE AND DISPOSAL OF CHEMICALS, CEMENT, AND OTHER COMPOUNDS AND MATERIALS TO PREVENT THEIR DISCHARGE INTO THE DRAINAGE SYSTEM.
- J. STABILIZE DRAINAGE WAYS AND EROSION DISCHARGE LOCATIONS WITH CHANNEL EROSION MAT, MULCHING, SEEDING, DITCH CHECKS & RIP-RAP AS SOON AS POSSIBLE.
- K. PERMANENTLY STABILIZE EXPOSED SOILS WITH NON-CHANNEL EROSION MAT, MULCHING AND SEEDING AS SOON AS POSSIBLE.
- L. CONTROL AND MINIMIZE DUST FROM VEHICULAR TRAFFIC AND WIND EROSION. PRESERVING VEGETATION, MULCHING, SEEDING, WATERING, GRADING PRACTICES, POLYACRYLAMIDE, SOIL STABILIZERS, CHLORIDES, & BARRIERS MAY BE USED FOR DUST CONTROL.
- M. PREVENT THE DISCHARGE OF SEDIMENT AS PART OF DE-WATERING. GEOTEXTILE BAGS, SEDIMENT TANKS, SEDIMENT TRAPS, SEDIMENT BASINS, AND FILTRATION SYSTEMS MAY BE USED FOR DE-WATERING. POLYMERS MAY BE USED TO ENHANCE SEDIMENT TRAPPING.

THE CONTRACTOR IS RESPONSIBLE FOR REPAIRING OR REPLACING BEST MANAGEMENT PRACTICES DESTROYED AS A RESULT OF CONSTRUCTION ACTIVITIES BY THE END OF THE WORK DAY. THE CONTRACTOR IS RESPONSIBLE FOR REPLACING BEST MANAGEMENT PRACTICES TEMPORARILY REMOVED FOR CONSTRUCTION ACTIVITY AS SOON AS THOSE ACTIVITIES ARE COMPLETED. THE CONTRACTOR IS RESPONSIBLE FOR REMOVING AND DISPOSING OF TEMPORARY BEST MANAGEMENT PRACTICES AFTER CONSTRUCTION IS COMPLETE AND PERMANENT VEGETATION IS ESTABLISHED.

INSPECTION & MAINTENANCE:

THE CONTRACTOR IS RESPONSIBLE FOR INSPECTING BEST MANAGEMENT PRACTICES WEEKLY, AND WITHIN 24 HOURS FOLLOWING A RAINFALL OF 0.5 INCHES OR GREATER. WRITTEN DOCUMENTATION OF EACH INSPECTION SHALL BE KEPT AT THE CONSTRUCTION SITE AND SHALL INCLUDE THE FOLLOWING INFORMATION: DATE, TIME, AND LOCATION OF INSPECTION; NAME OF INDIVIDUAL WHO PERFORMED THE INSPECTION; AN ASSESSMENT OF THE CONDITION OF BEST MANAGEMENT PRACTICES; A DESCRIPTION OF ANY BEST MANAGEMENT PRACTICE IMPLEMENTATION AND MAINTENANCE PERFORMED; AND A DESCRIPTION OF THE PRESENT PHASE OF CONSTRUCTION. THE CONTRACTOR IS RESPONSIBLE FOR MAINTAINING, REPAIRING, OR REPLACING BEST MANAGEMENT PRACTICES AS NECESSARY WITHIN 24 HOURS OF AN INSPECTION OR NOTIFICATION. THE CONTRACTOR IS RESPONSIBLE FOR INSPECTING, MAINTAINING, REPAIRING, OR REPLACING BEST MANAGEMENT PRACTICES UNTIL ALL LAND DISTURBING CONSTRUCTION ACTIVITY IS COMPLETED AND A UNIFORM PERENNIAL VEGETATIVE COVER IS ESTABLISHED WITH A DENSITY OF AT LEAST 70%.

THE CONTRACTOR IS RESPONSIBLE FOR POSTING THE PERMIT IN A CONSPICUOUS LOCATION ON THE CONSTRUCTION SITE. THE CONTRACTOR IS RESPONSIBLE FOR KEEPING A COPY OF THE APPROVED REPORTS, PLANS, AMENDMENTS, INSPECTION REPORTS, AND PERMITS AT THE CONSTRUCTION SITE AT ALL TIMES UNTIL ALL LAND DISTURBING CONSTRUCTION ACTIVITY IS COMPLETED AND A UNIFORM PERENNIAL VEGETATIVE COVER IS ESTABLISHED WITH A DENSITY OF AT LEAST 70%. THE CONTRACTOR IS RESPONSIBLE FOR NOTIFYING THE OWNER WHEN THE VEGETATIVE DENSITY REACHES AT LEAST 70%. THE OWNER IS RESPONSIBLE FOR TERMINATING DNR PERMIT COVERAGE.

AMENDMENTS:

THE CONTRACTOR IS RESPONSIBLE FOR AMENDING THE EROSION & SEDIMENT CONTROL PLAN IF: THERE IS A CHANGE IN CONSTRUCTION, OPERATION OR MAINTENANCE AT THE SITE WHICH HAS THE REASONABLE POTENTIAL FOR THE DISCHARGE OF POLLUTANTS; THE ACTIONS REQUIRED BY THE PLAN FAIL TO REDUCE THE IMPACTS OF POLLUTANTS CARRIED BY CONSTRUCTION SITE RUNOFF; OR IF THE DNR NOTIFIES THE APPLICANT OF CHANGES NEEDED IN THE PLAN. THE DNR AND OWNER SHALL BE NOTIFIED 5 WORKING DAYS PRIOR TO MAKING CHANGES TO THE PLAN.

CTH 'S' (STH 76 - KELLY ROAD)
OUTAGAMIE COUNTY, WISCONSIN
ABBREVIATIONS, SYMBOLS & NOTES

DESIGNED MPK	DRAWN MPK
-----------------	--------------

PROJECT NO.
00006 910308

DATE
FEBRUARY, 2014

SHEET NO.

01

McMahon provides this drawing and data, regardless of form, as instruments of service. The client and/or user of this drawing and data shall be responsible for obtaining all necessary permits, licenses, and approvals. The client and/or user shall indemnify and hold McMahon harmless from and against all claims, damages, losses, and expenses, including reasonable attorneys' fees, arising out of or from the use of this drawing and data without prior written consent by McMahon.


REVISION

DATE


NO.

McMAHON
ENGINEERS & ARCHITECTS
1445 McMAHON DRIVE NEENAH, WI 54956
MAILING: P.O. BOX 1025 NEENAH, WI 54957-1025
Tel: (920) 751-4200 Fax: (920) 751-4284
www.mcmgrp.com

w:\projects\00006\910308\08-Design\Typical Sections\02_Typical Sections.dwg, 02 Typical sections, Plot Date: 2/25/2014 3:36 PM, xrefs:none

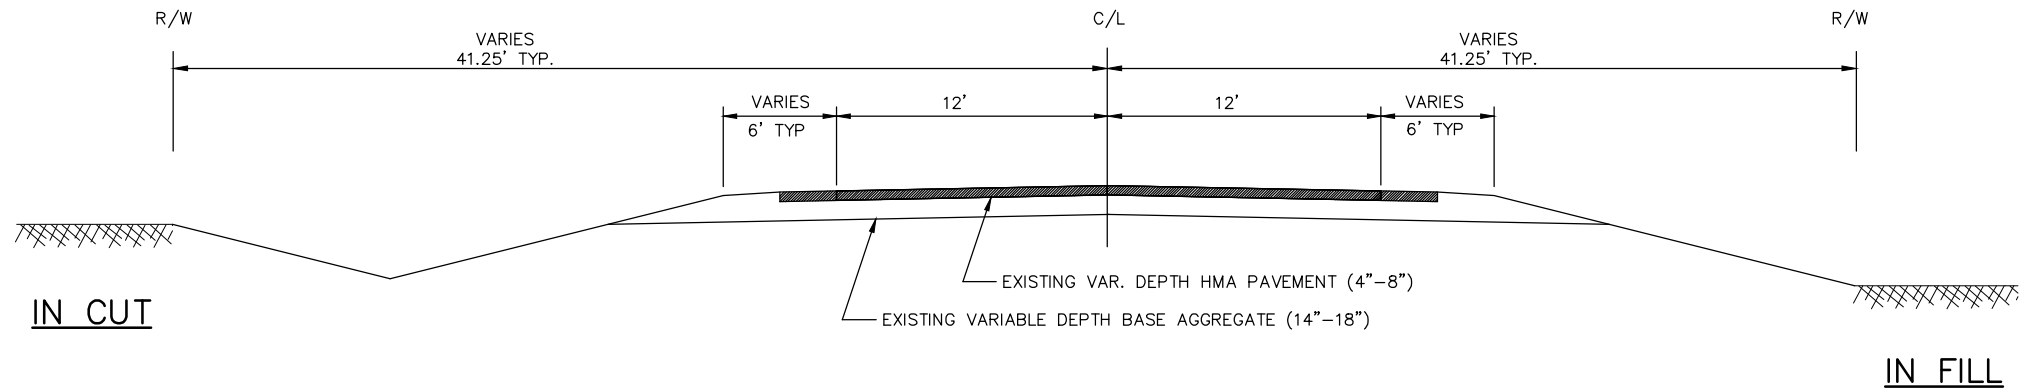


**EXISTING TYPICAL SECTION
CTH S**

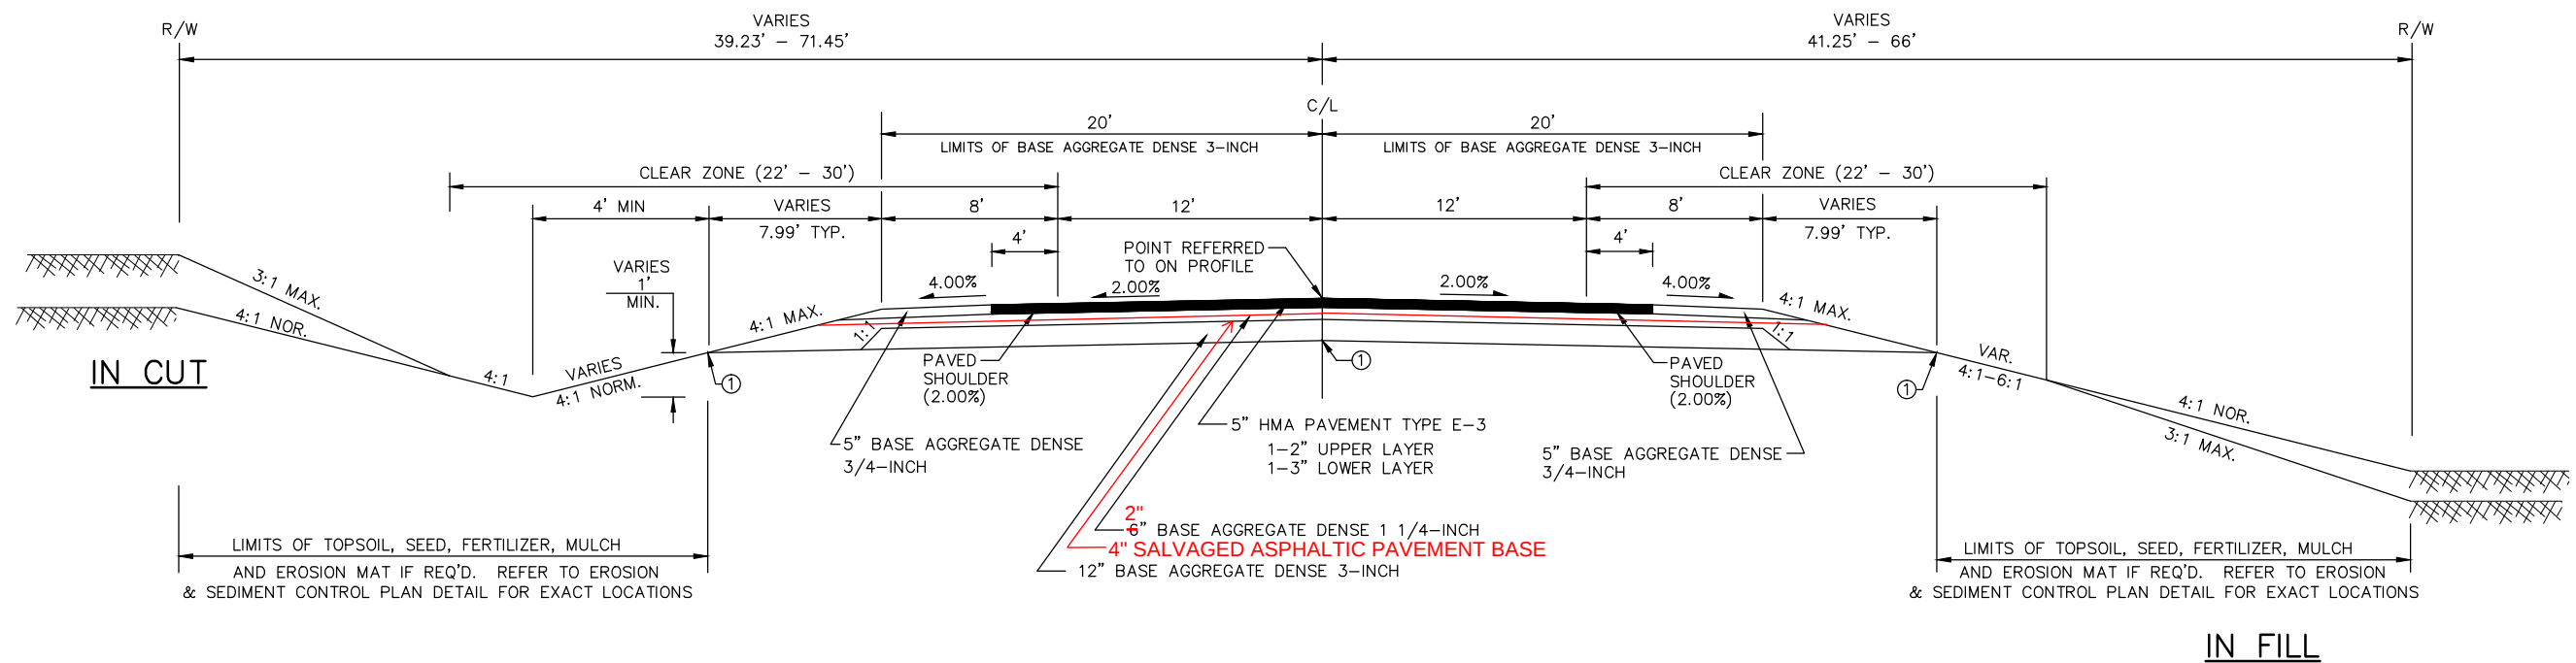

**FINISHED TYPICAL SECTION
CTH S
STA. 1+20.04 to 64+70.21**

① POINT REFERRED TO ON CROSS SECTIONS

w:\projects\00006\910308\08-Design\Typical Sections\03 Typical Sections.dwg, 03 Typical Sections, Plot Date: 2/25/2014 3:36 PM, xrefs:none

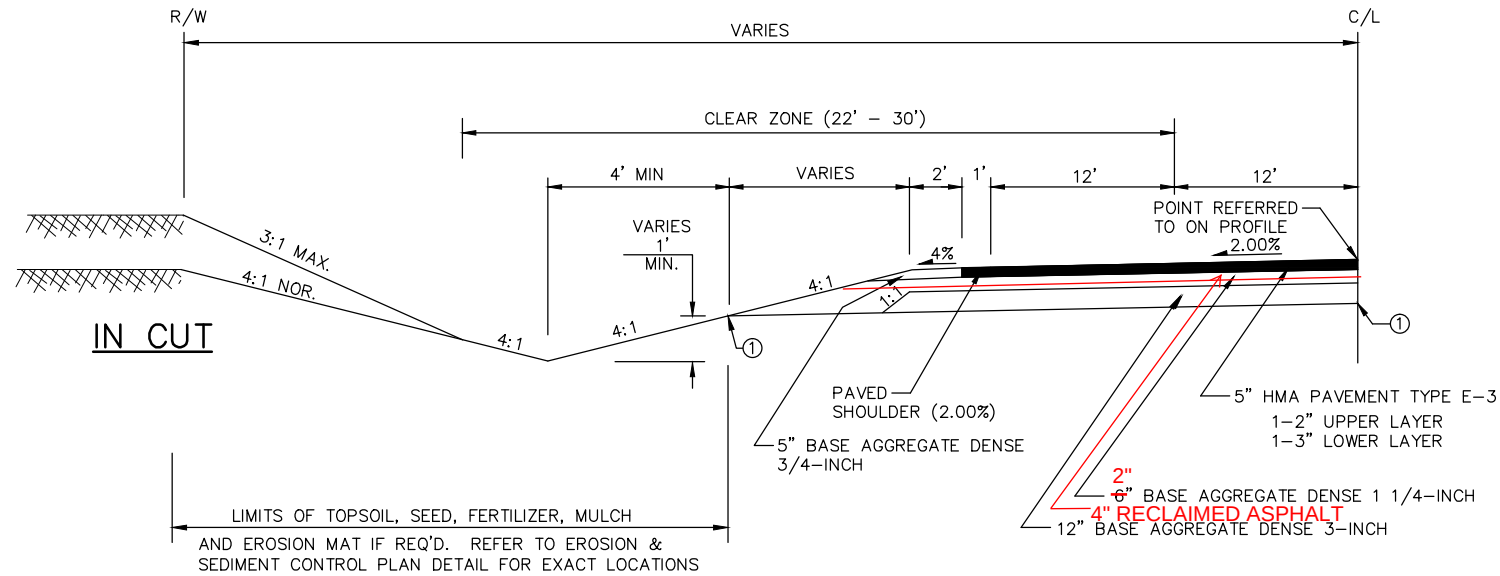

TYPICAL 1/2 SECTION FOR RURAL AREAS

(PASSING LANES AND RIGHT TURN LANES)

STA. 16+74.09 RT to 21+56.09 RT


STA. 45+52.19 RT to 51+80.95 RT

STA. 47+35.66 LT to 52+41.58 LT

STA. 61+24.24 RT to 64+70.00 RT

STA. 63+50.98 LT to 64+70.00 LT

① POINT REFERRED TO ON CROSS SECTIONS

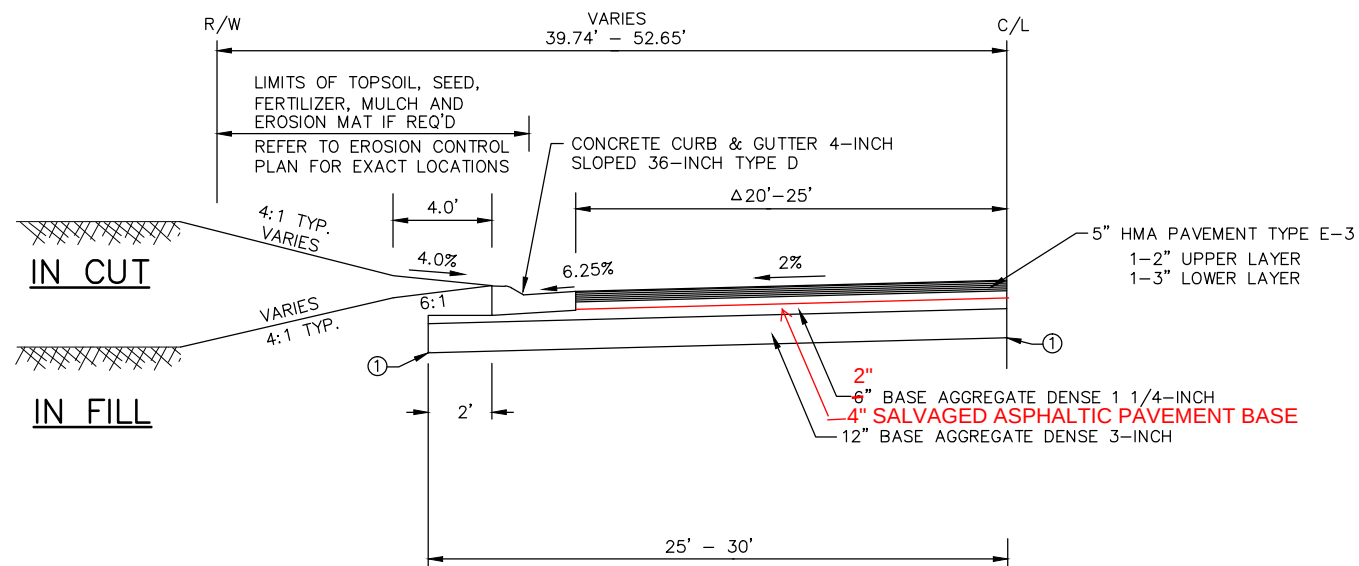

TYPICAL 1/2 SECTION FOR URBAN AREAS

Δ 20' - TYPICAL URBAN SECTION
25' - PASSING LANES


STA. 18+80.00 LT to 24+71.59 LT

STA. 42+00.00 RT to 44+50.00 RT

① POINT REFERRED TO ON CROSS SECTIONS

NO.	DATE	REVISION
1	7/22/14	1.1/4" aggregate replaced in part with Salvaged Asphaltic Pavement Base

w:\projects\00006\910308\08-Design\Typical Sections\04_Typical Sections.dwg, 04_Typical Sections, Plot Date: 2/25/2014 3:36 PM, xrefs:none

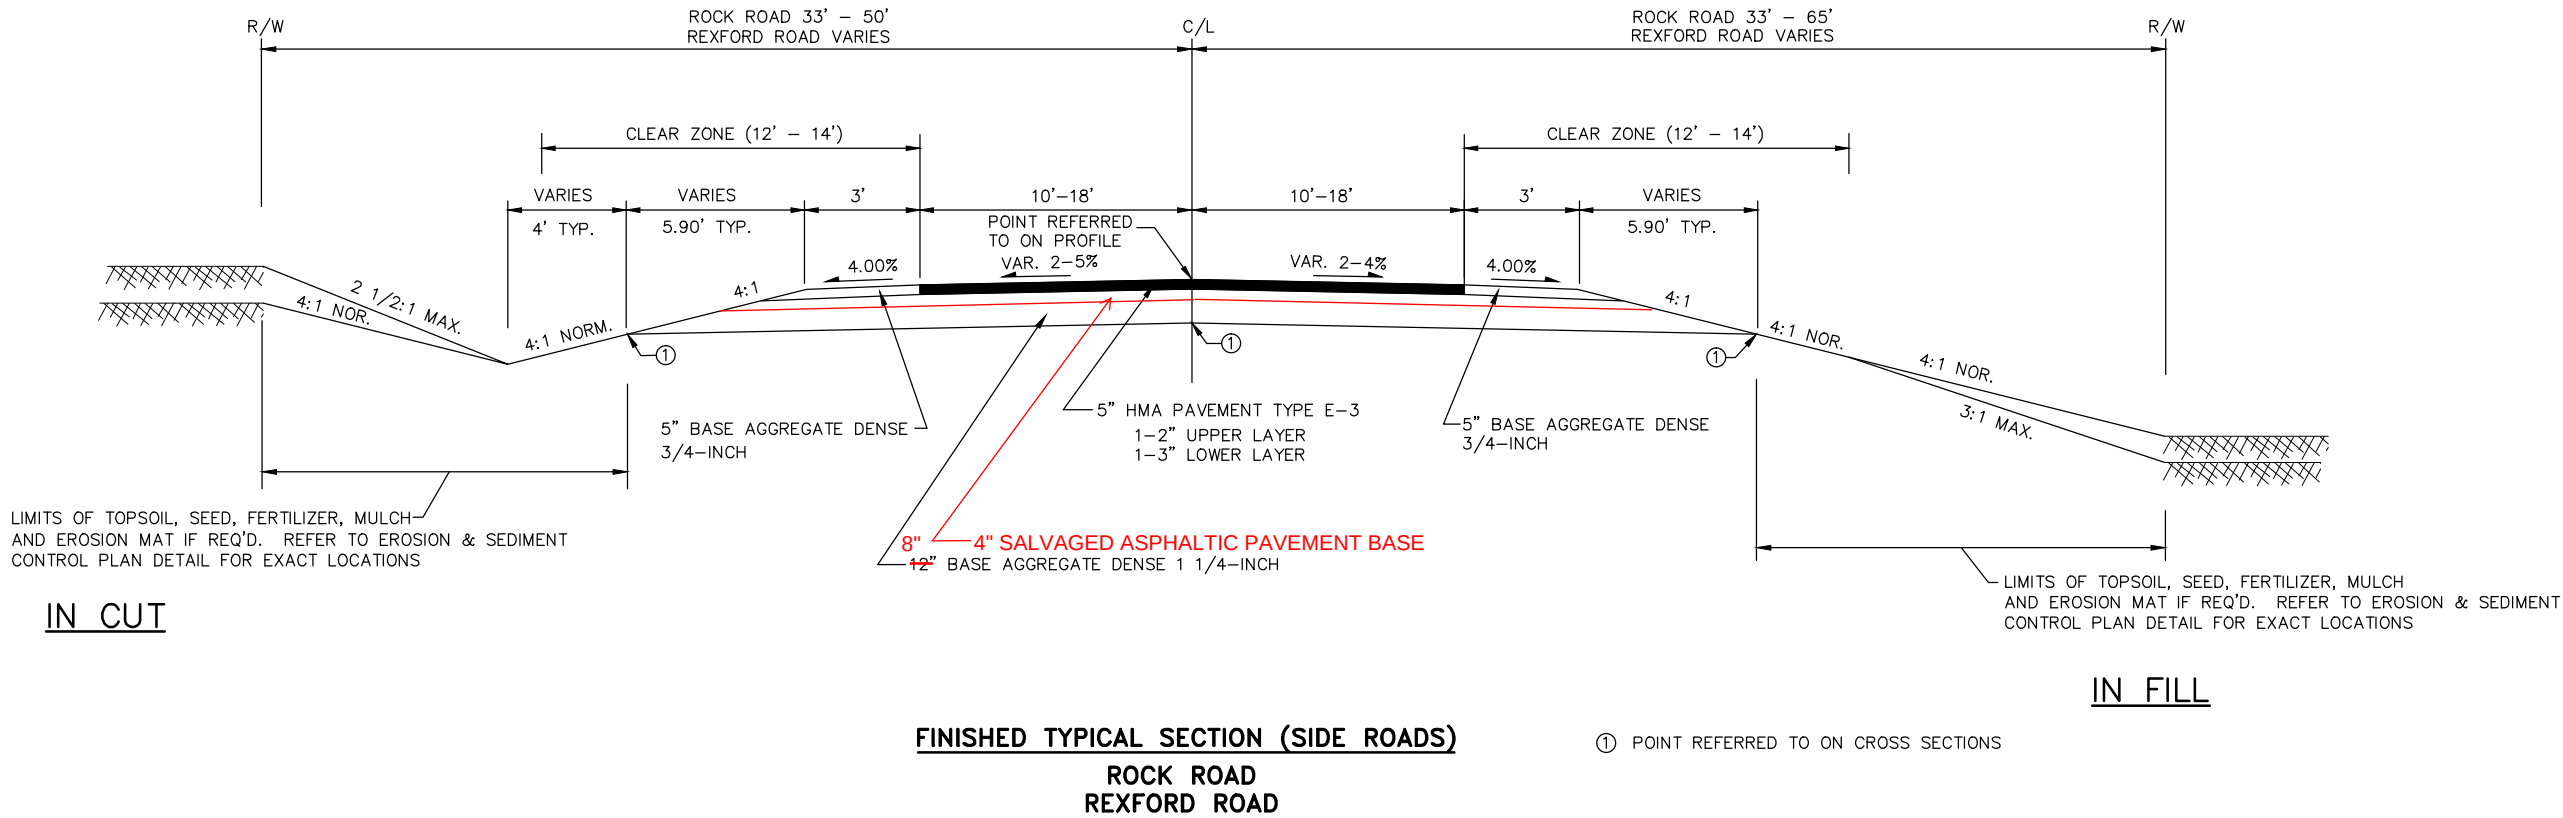

CTH 'S' (STH 76 - KELLY ROAD)
OUTAGAMIE COUNTY, WISCONSIN
TYPICAL SECTIONS

DESIGNED MPK	DRAWN MPK
PROJECT NO. 00006 910308	
DATE FEBRUARY, 2014	
SHEET NO.	


04

McMahon provides this drawing and data, regardless of form, as instruments of service. The user agrees to indemnify and hold McMahon harmless from and against all claims, damages, costs and expenses, including reasonable attorney's fees, arising out of or from the use of the drawing or data without prior written consent by McMahon.

NO.	DATE	REVISION
1	7/22/14	1. 1 1/4" aggregate replaced in part with Salvaged Asphaltic Pavement Base

McMAHON
ENGINEERS-ARCHITECTS
1445 McMAHON DRIVE NEENAH, WI 54956
Mailing: P.O. BOX 1025 NEENAH, WI 54957-1025
Tel: (920) 751-4200 Fax: (920) 751-4284
www.mcmgrp.com

w:\projects\00006\910308\08-Design\Horizontal Alignment Detail\05 HORIZONTAL ALIGNMENT DETAIL.dwg, 05 horizontal alignment detail, Plot Date: 2/25/2014 3:36 PM, xrefs:none

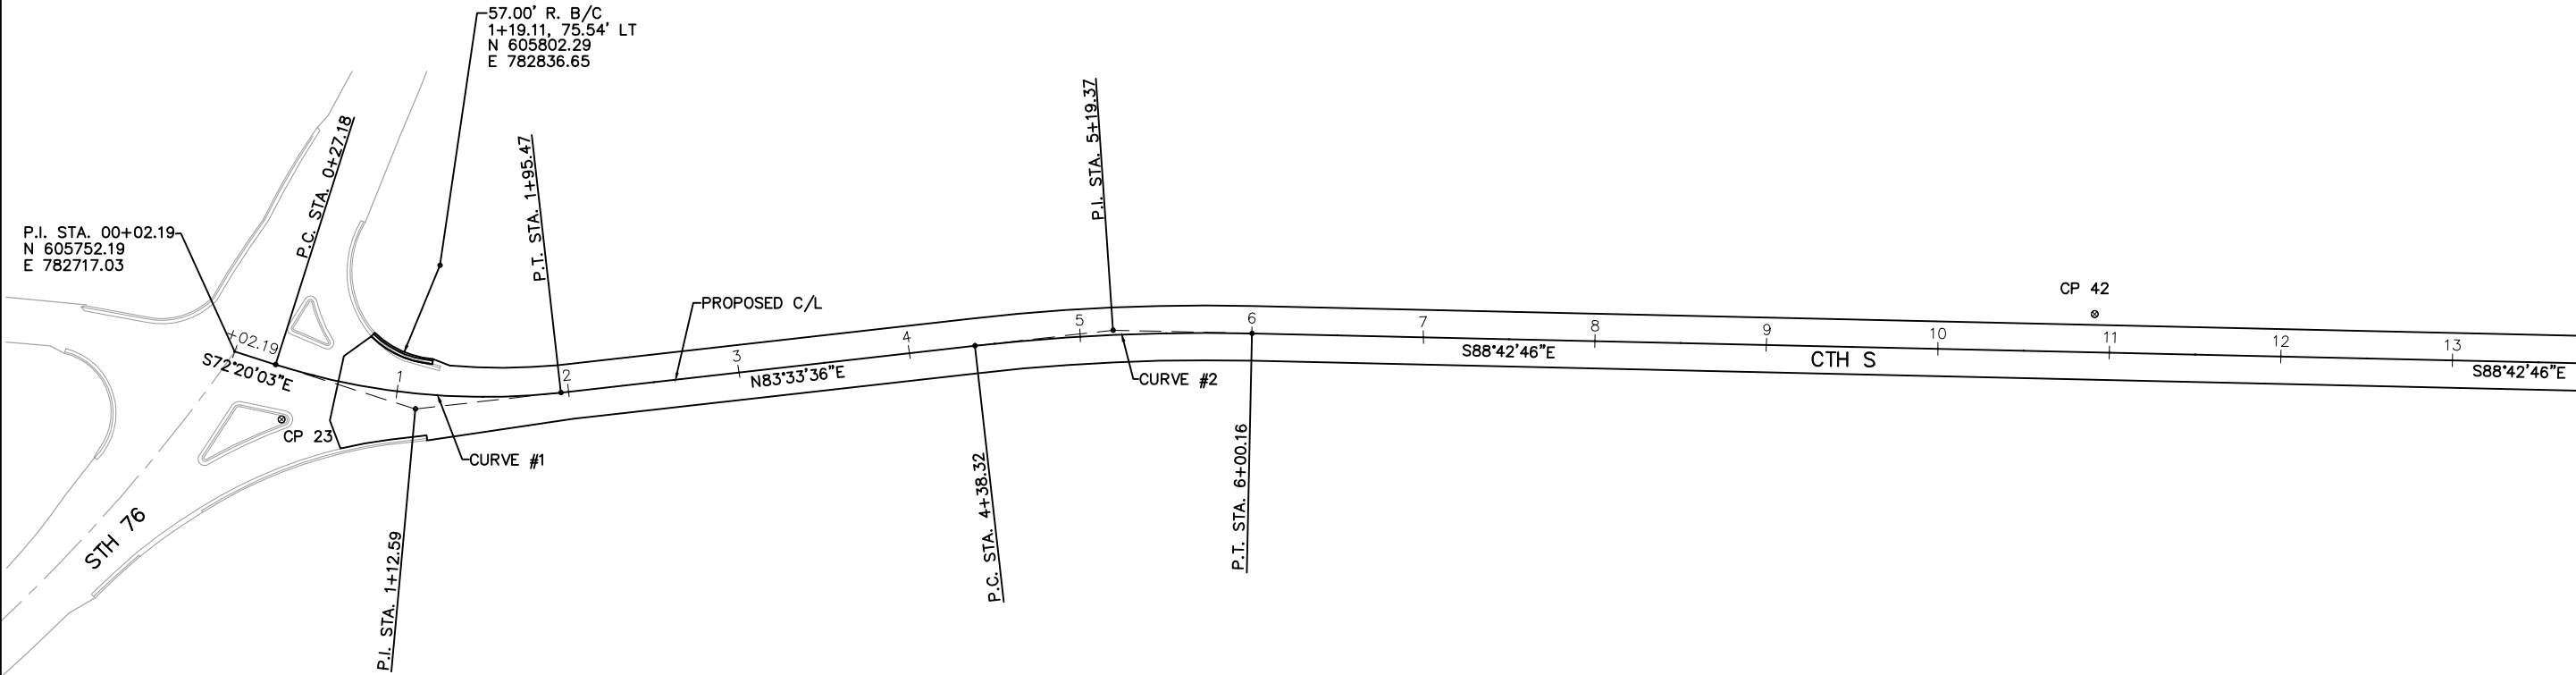

CURVE #1 VALUES

PI: 1+12.59
X 782822.23
Y 605718.68
PC: 0+27.18
X 782740.85
Y 605744.60
PT: 1+95.47
X 782907.10
Y 605728.26
Delta: 24°06'22"
D 14°19'26"
TAN 85.41'
L 168.29'
R 400.00'
LCH 167.05'
LCB N84°23'14"W
BK: S72°20'03"E
AH: N83°33'36"E

CURVE #2 VALUES

PI: 5+19.36
X 783228.95
Y 605764.59
PC: 4+38.32
X 783148.41
Y 605755.50
PT: 6+00.16
X 783309.97
Y 605762.77
Delta: 07°43'39"
D 04°46'29"
TAN 81.04'
L 161.84'
R 1200.00'
LCH 161.72'
LCB N87°25'25"E
BK: N83°33'36"E
AH: S88°42'46"E

McMAHON ENGINEERS & ARCHITECTS 1445 McMAHON DRIVE NEENAH, WI 54956 Mailing: P.O. BOX 1025 NEENAH, WI 54957-1025 Tel: (920) 751-4200 Fax: (920) 751-4284 www.mcmgrp.com		REVISION	
DESIGNED	DRAWN	DATE	NO.
MPK	MPK		
PROJECT NO.			
00006 910308			
DATE			
FEBRUARY, 2014			
SHEET NO.			
05			

CTH 'S' (STH 76 - KELLY ROAD)
OUTAGAMIE COUNTY, WISCONSIN
HORIZONTAL ALIGNMENT DETAIL

w:\projects\00006\910308\08-Design\Horizontal Alignment Detail\06 HORIZONTAL ALIGNMENT DETAIL.dwg, 06 HORIZONTAL Alignment Detail, Plot Date: 2/25/2014 3:36 PM, xrefs:none

HORIZONTAL CONTROL (CP #)			
CONTROL POINT	NORTHING	EASTING	DESCRIPTION
28	605820.34	784705.88	MAG NAIL
47	605692.36	784930.07	MAG NAIL
29	605369.86	785266.18	MAG NAIL

CURVE #3 VALUES

PI: 20+39.70 Delta: 54°19'39"
X 784749.15 D 05°22'48"
Y 605730.43 TAN 546.48'
PC: 14+93.22 L 1009.82'
X 784202.80 R 1065.00'
Y 605742.71 LCH 972.42'
PT: 25+03.05 LCB N64°07'25"E
X 785077.72 BK: S88°42'46"E
Y 606167.10 AH: N36°57'36"E

+36.59 CTH S =
10+00 ROCK ROAD
N 605866.62
E 784725.82

57.00' R. B/C
19+69.90, 84' RT
9+26.22, 75' LT
N 605760.71
E 784700.61


P.I. STA. 8+83.32
ROCK ROAD

P.I. STA. 20+39.70
ROCK ROAD

37.00' R. B/C
20+90.21, 64' RT
9+32.16, 55' RT
N 605837.98
E 784805.33

CURVE #7 VALUES

PI: 8+83.32 Delta: 23°53'33"
X 784781.74 D 12°27'20"
Y 605761.22 TAN 97.32'
PC: 7+83.92 L 191.82'
X 784859.32 R 460.00'
Y 605699.08 LCH 190.43'
PT: 9+75.74 LCB N39°53'29"W
X 784737.19 BK: N51°18'32"W
Y 605845.19 AH: N27°56'43"W

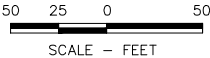

CTH 'S' (STH 76 - KELLY ROAD)
OUTAGAMIE COUNTY, WISCONSIN
HORIZONTAL ALIGNMENT DETAIL

DESIGNED MPK	DRAWN MPK
PROJECT NO. 00006 910308	
DATE FEBRUARY, 2014	
SHEET NO.	

06

McMahon provides this drawing and data, regardless of form, as instruments of service. The client and/or user of this drawing and data shall be responsible for obtaining all necessary permits and for verifying the accuracy of the data and the appropriateness of the design. McMahon and its employees shall not be held liable for any damages, including consequential damages, made to the original drawing or data without prior written consent by McMahon.

REVISION

DATE

NO.

McMAHON
ENGINEERS-ARCHITECTS
1445 McMAHON DRIVE NEENAH, WI 54956
Mailing: P.O. BOX 1025 NEENAH, WI 54957-1025
Tel: (920) 751-4200 Fax: (920) 751-4284
www.mcmgrp.com

CURVE #4 VALUES


PI: 32+21.76 Delta: 02°07'03"
X 785509.85 D 00°36'32"
Y 606741.39 TAN 173.91'
PC: 30+47.85 L 347.78'
X 785405.29 R 9410.00'
Y 606602.43 LCH 347.76'
PT: 33+95.63 LCB N38°01'07"E
X 785619.48 BK: N36°57'36"E
Y 606876.40 AH: N39°04'39"E

HORIZONTAL CONTROL (CP #)			
CONTROL POINT	NORTHING	EASTING	DESCRIPTION
44	606391.66	785246.67	MAG NAIL

CURVE #5 VALUES

PI: 44+95.86 Delta: 26°35'46"
X 786313.03 D 03°59'57"
Y 607730.50 TAN 338.62'
PC: 41+57.24 L 665.04'
X 786099.58 R 1432.69'
Y 607467.63 LCH 659.08'
PT: 48+22.28 LCB N52°22'32"E
X 786621.59 BK: N39°04'39"E
Y 607869.99 AH: N65°40'25"E

HORIZONTAL CONTROL (CP #)			
CONTROL POINT	NORTHING	EASTING	DESCRIPTION
30	607420.94	786081.18	MAG NAIL
32	607907.76	786627.69	MAG NAIL
33	608387.79	786871.09	MAG NAIL

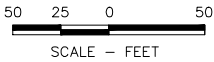


McMahon provides this drawing and data, regardless of form, as instruments of service. The client and/or user of this drawing and data shall be responsible for obtaining all necessary permits and licenses. The client and/or user shall indemnify and hold McMahon harmless from and against all claims, damages, costs and expenses, including reasonable attorneys' fees, arising out of or from the use of this drawing and data, whether or not such claims, damages, costs and expenses are caused in whole or in part by the negligence of McMahon.

NO.	DATE	REVISION

CTH 'S' (STH 76 - KELLY ROAD)
OUTAGAMIE COUNTY, WISCONSIN
HORIZONTAL ALIGNMENT DETAIL

DESIGNED MPK	DRAWN MPK
PROJECT NO. 00006 910308	
DATE FEBRUARY, 2014	
SHEET NO. 07	

w:\projects\00006\910308\08-Design\Horizontal Alignment Detail\08 HORIZONTAL ALIGNMENT DETAIL.dwg, 08 horizontal alignment detail, Plot Date: 2/25/2014 3:37 PM, xrefs:none

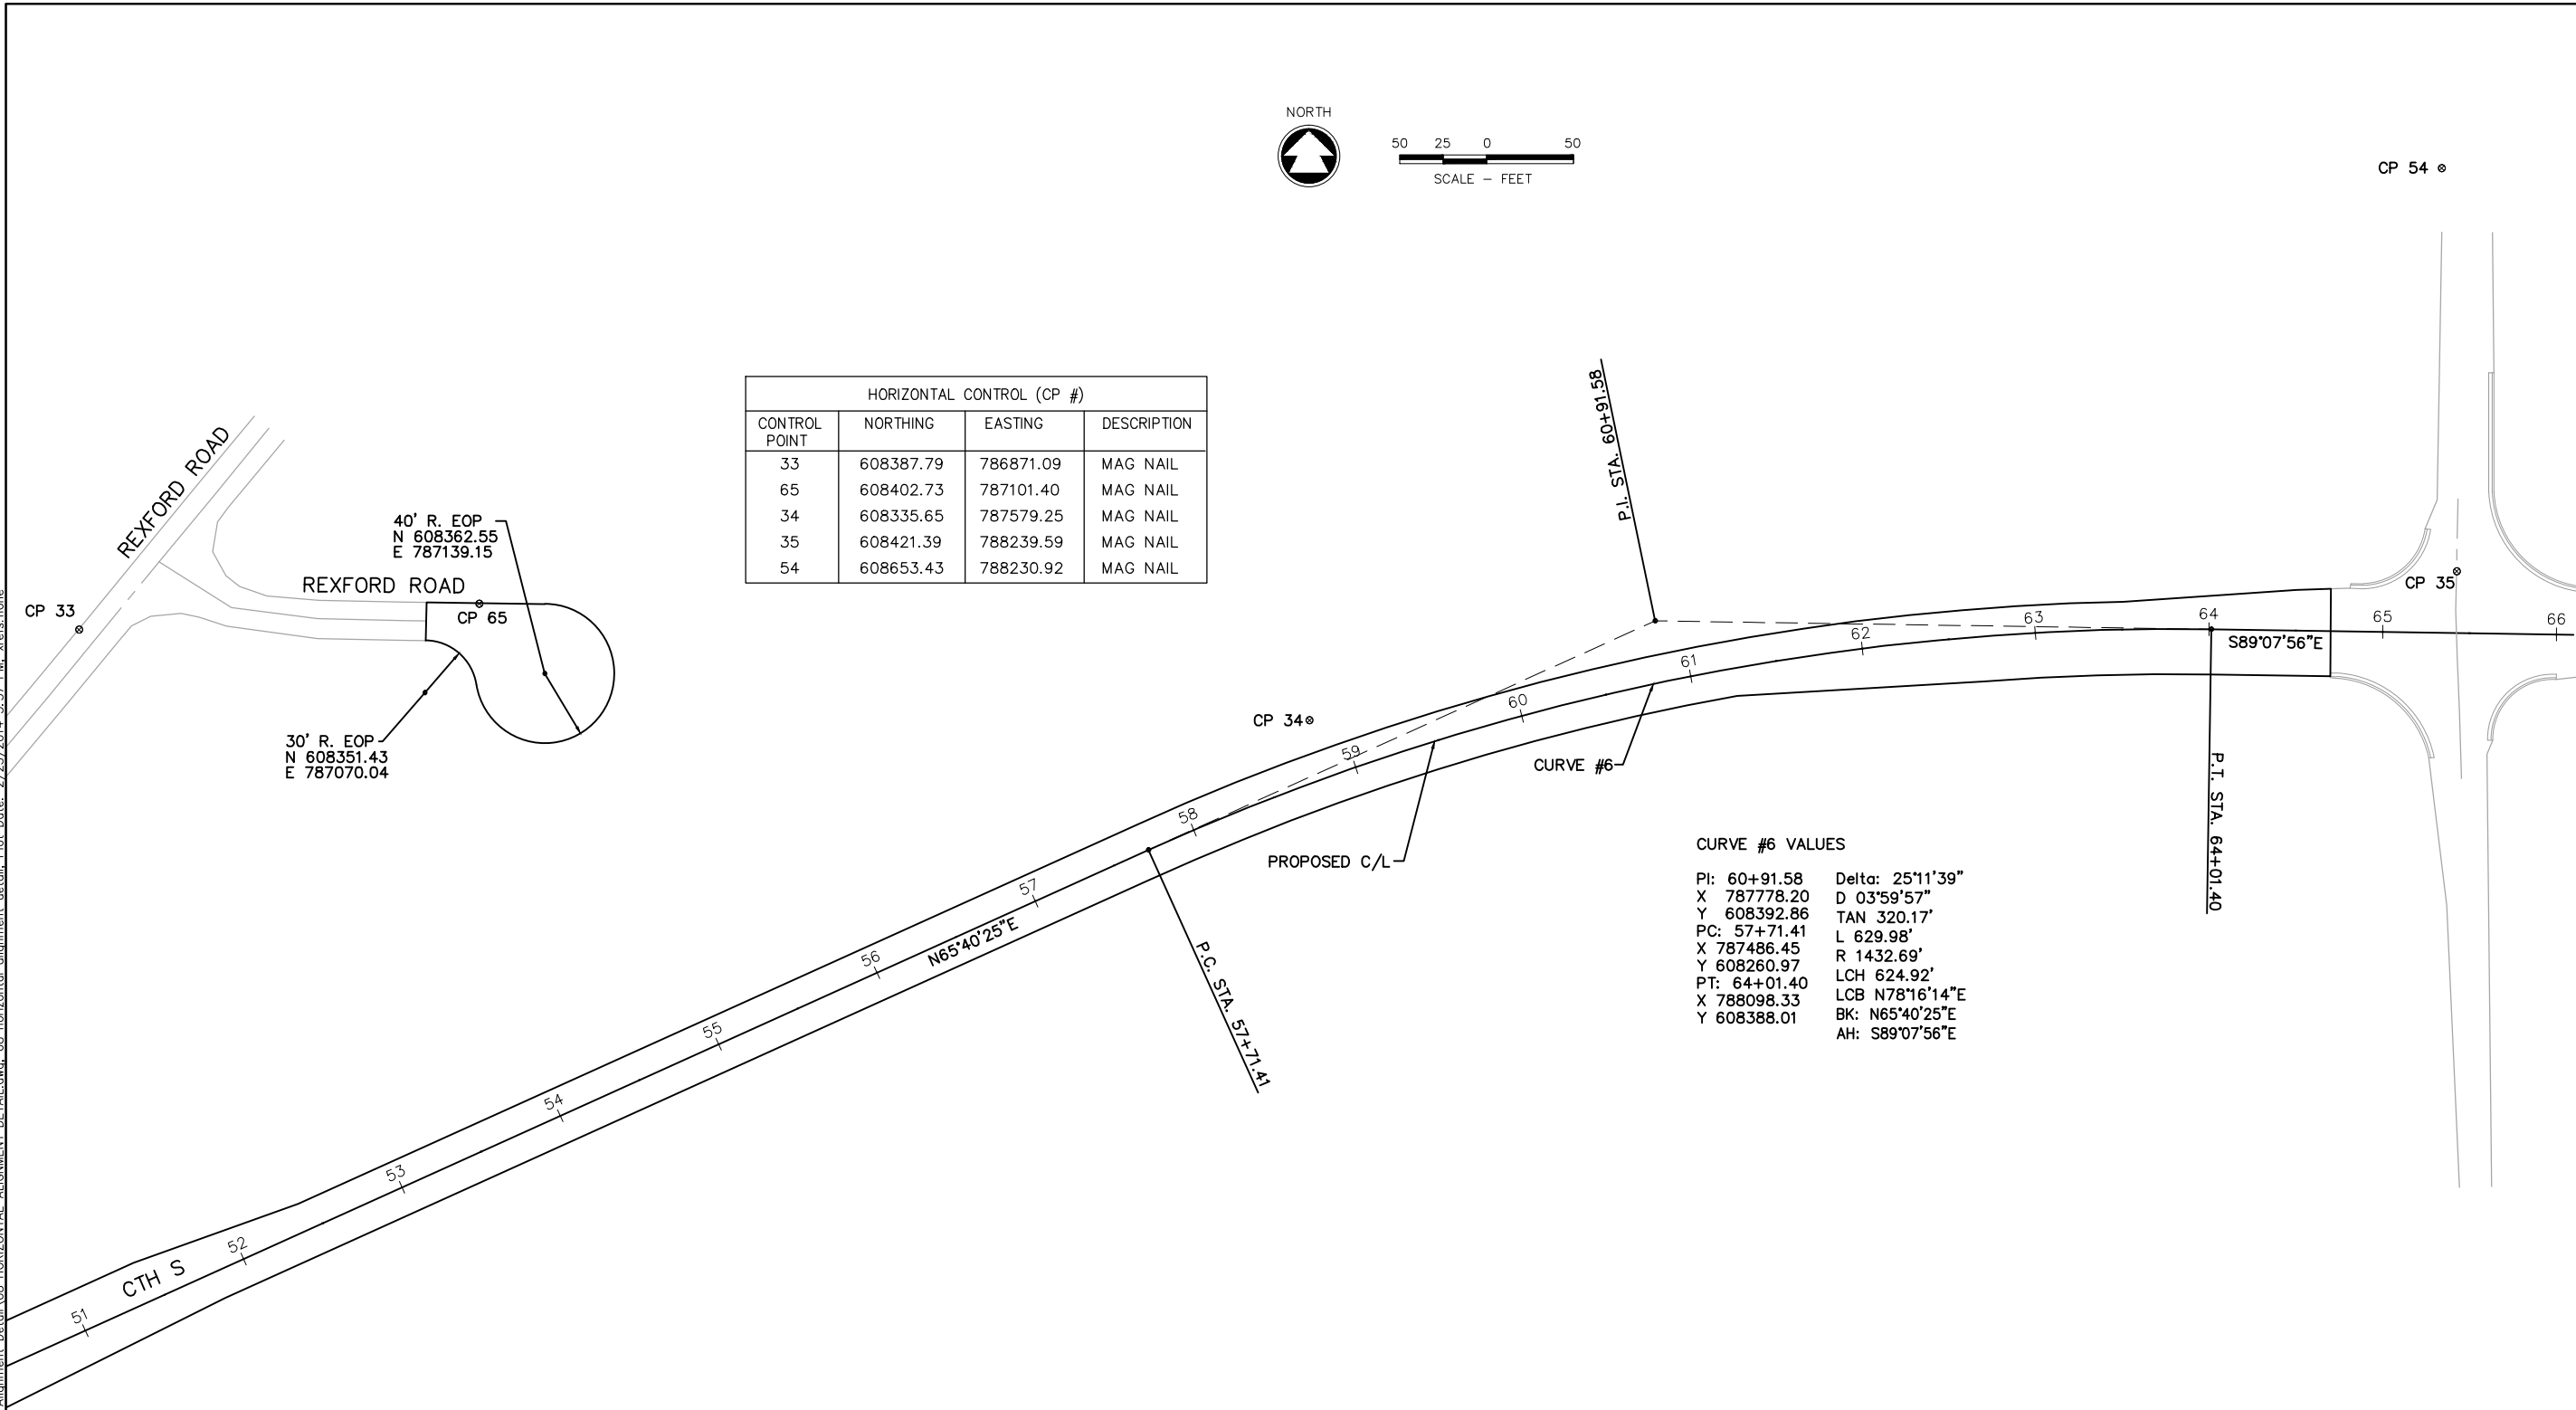

HORIZONTAL CONTROL (CP #)			
CONTROL POINT	NORTHING	EASTING	DESCRIPTION
33	608387.79	786871.09	MAG NAIL
65	608402.73	787101.40	MAG NAIL
34	608335.65	787579.25	MAG NAIL
35	608421.39	788239.59	MAG NAIL
54	608653.43	788230.92	MAG NAIL

CURVE #6 VALUES

PI: 60+91.58 Delta: 25°11'39"
X 787778.20 D 03°59'57"
Y 608392.86 TAN 320.17'
PC: 57+71.41 L 629.98'
X 787486.45 R 1432.69'
Y 608260.97 LCH 624.92'
PT: 64+01.40 LCB N78°16'14"E
X 788098.33 BK: N65°40'25"E
Y 608388.01 AH: S89°07'56"E

McMAHON

ENGINEERS ARCHITECTS

1445 McMAHON DRIVE NEENAH, WI 54956
Mailing: P.O. BOX 1025 NEENAH, WI 54957-1025
Tel: (920) 751-4200 Fax: (920) 751-4284
www.mcmgrp.com


McMahon provides this drawing and data, regardless of form, as instruments of service. The client and/or user of this drawing and data shall be responsible for obtaining all necessary permits and licenses to use this drawing and data. McMahon does not warrant the accuracy or completeness of this drawing and data. McMahon shall not be held liable for any damages, including consequential damages, arising from the use of this drawing and data without prior written consent by McMahon.

NO.	DATE	REVISION


CTH 'S' (STH 76 - KELLY ROAD)
OUTAGAMIE COUNTY, WISCONSIN
HORIZONTAL ALIGNMENT DETAIL

DESIGNED MPK	DRAWN MPK
PROJECT NO. 00006 910308	
DATE FEBRUARY, 2014	
SHEET NO. 08	


mkenbeck, W:\PROJECTS\00006\910308\08-Design\Construction Details\09_MISC Construction Details\09_MISC construction details, Plot Date: 5/14/2014 11:09 AM, xref:s:none

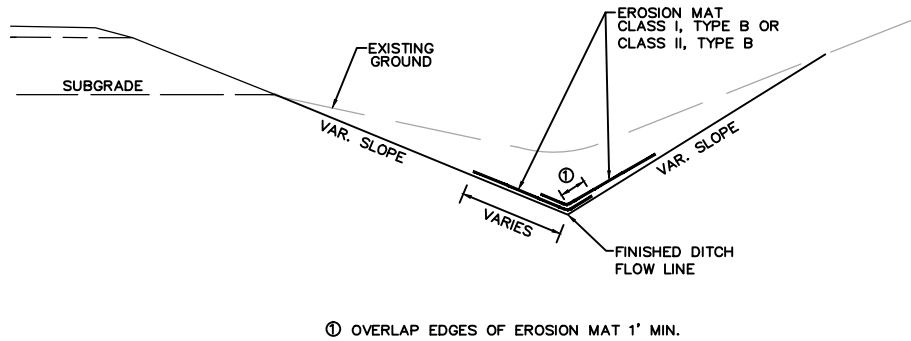

EROSION MAT INSTALLATION DETAIL – CHANNEL

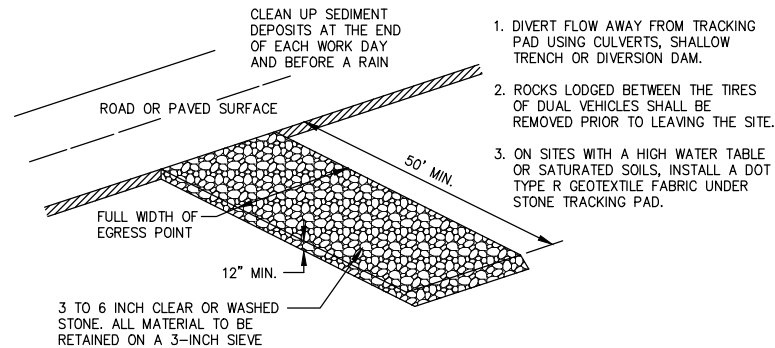

TRACKING PAD DETAIL

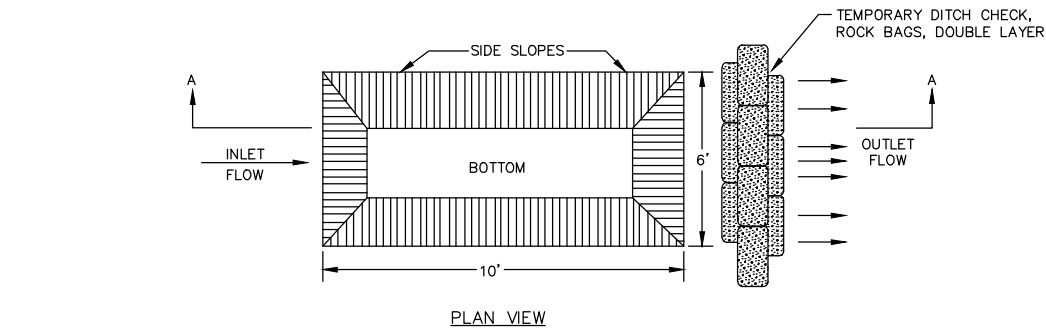

EXCAVATE FOR TEMPORARY SEDIMENT TRAPS WITHIN DITCHES BEFORE GROUND DISTURBING ACTIVITIES. INSTALL ROCK BAG DITCH CHECKS IMMEDIATELY DOWNSTREAM.


SAFETY FENCING SHALL BE ERECTED AROUND THE TEMPORARY SEDIMENT TRAP FOR PUBLIC SAFETY.

DEPTH OF THE TEMPORARY SEDIMENT TRAP SHALL BE 3' MINIMUM UNLESS THERE ARE SUBSTANTIATED CONFLICTS WITH THE MINIMUM DEPTH AND SIZE REQUIREMENTS. CONSIDER ADJUSTING THE LOCATION OF THE TEMPORARY SEDIMENT TRAP BEFORE CONSIDERING A DECREASED TRAP SIZE.

REMOVE THE TEMPORARY SEDIMENT TRAP AND RESTORE THE AREA AFTER UPSTREAM LANDSCAPED AREAS ARE STABILIZED.


GENERAL GUIDANCE FOR INSTALLATION, MAINTENANCE, AND REMOVAL SHALL FOLLOW WDNR CONSERVATION PRACTICE 1063.

TEMPORARY SEDIMENT TRAP


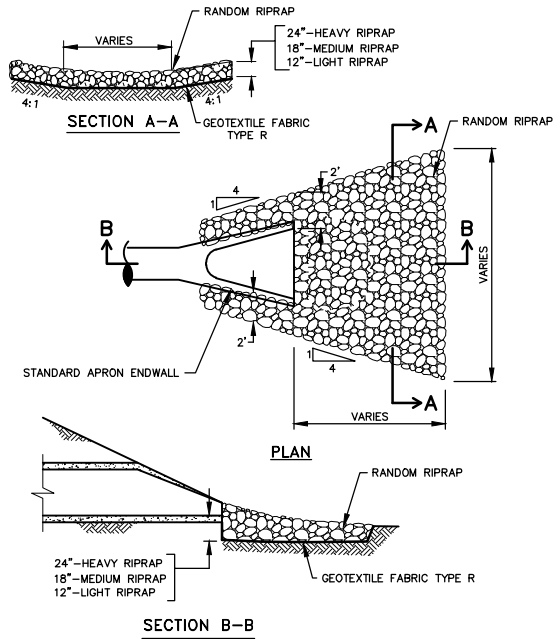


RIPRAP AT STORM SEWER OUTFALL

1. RIP-RAP SHALL BE IN ACCORDANCE WITH SECTION 606, WIS-DOT STANDARD SPECIFICATIONS FOR HIGHWAY AND STRUCTURE CONSTRUCTION, 1996 EDITION.
2. RIP-RAP SHALL BE ANGULAR. ROUND RIP-RAP IS NOT PERMITTED.

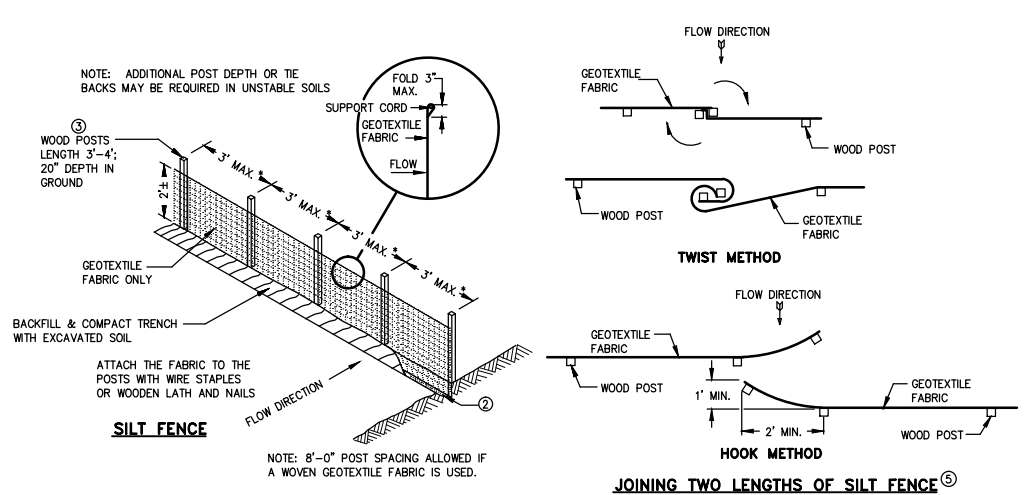


This drawing based on Wisconsin Department of Transportation Standard Detail Drawing 8 E 9-6.

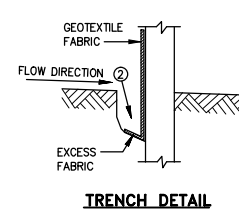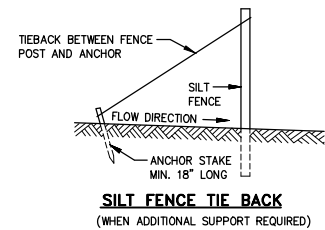

SILT FENCE DETAIL

GENERAL NOTES

- ① HORIZONTAL BRACE REQUIRED WITH 2" X 4" WOODEN FRAME OR EQUIVALENT AT TOP OF POSTS.
- ② TRENCH SHALL BE A MINIMUM OF 4" WIDE & 6" DEEP TO BURY AND ANCHOR THE GEOTEXTILE FABRIC. FOLD MATERIAL TO FIT TRENCH AND BACKFILL & COMPACT TRENCH WITH EXCAVATED SOIL.
- ③ WOOD POSTS SHALL BE A MINIMUM SIZE OF 1 1/8" X 1 1/8" OF OAK OR HICKORY
- ④ SILT FENCE TO EXTEND ACROSS THE TOP OF THE PIPE.
- ⑤ CONSTRUCT SILT FENCE FROM A CONTINUOUS ROLL IF POSSIBLE BY CUTTING LENGTHS TO AVOID JOINTS. IF A JOINT IS NECESSARY USE ONE OF THE FOLLOWING TWO METHODS; A) OVERLAP THE END POSTS AND TWIST, OR ROTATE, AT LEAST 180 DEGREES; B) HOOK THE END OF EACH SILT FENCE LENGTH.

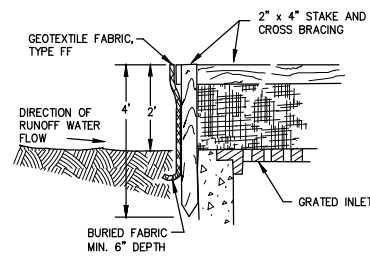


INLET PROTECTION, TYPE A

GENERAL NOTES

MANUFACTURED ALTERNATIVES APPROVED AND LISTED ON THE DEPARTMENT'S EROSION CONTROL PRODUCT ACCEPTABILITY LIST MAY BE SUBSTITUTED.


WHEN REMOVING OR MAINTAINING INLET PROTECTION, CARE SHALL BE TAKEN SO THAT THE SEDIMENT TRAPPED ON THE GEOTEXTILE FABRIC DOES NOT FALL INTO THE INLET. ANY MATERIAL FALLING INTO THE INLET SHALL BE REMOVED IMMEDIATELY.

- ① FINISHED SIZE, INCLUDING FLAP POCKETS WHERE REQUIRED, SHALL EXTEND A MINIMUM OF 10" AROUND THE PERIMETER TO FACILITATE MAINTENANCE OR REMOVAL.
- ② FOR INLET PROTECTION, TYPE C (WITH CURB BOX), AN ADDITIONAL 18" OF FABRIC IS WRAPPED AROUND THE WOOD AND SECURED WITH STAPLES. THE WOOD SHALL NOT BLOCK THE ENTIRE HEIGHT OF THE CURB BOX OPENING.
- ③ FLAP POCKETS SHALL BE LARGE ENOUGH TO ACCEPT WOOD 2X4.

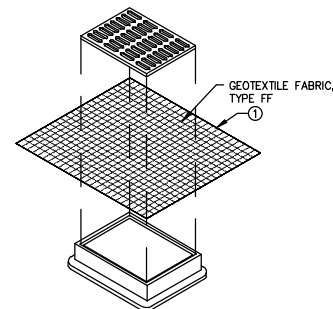

INLET PROTECTION, TYPE B (WITHOUT CURB BOX)

(CAN BE INSTALLED IN ANY INLET WITHOUT A CURB BOX)

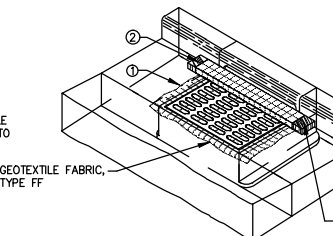

INLET PROTECTION, TYPE C (WITH CURB BOX)

INSTALLATION NOTES


TYPE B & C

TRIM EXCESS FABRIC IN THE FLOW LINE TO WITHIN 3" OF THE GRATE. THE CONTRACTOR SHALL DEMONSTRATE A METHOD OF MAINTENANCE, USING A SEWN FLAP. HAND HOLDS OR OTHER METHOD TO PREVENT ACCUMULATED SEDIMENT FROM ENTERING THE INLET.

TYPE D

DO NOT INSTALL INLET PROTECTION TYPE D IN INLETS SHALLOWER THAN 30", MEASURED FROM THE BOTTOM OF THE INLET TO THE TOP OF THE GRATE. TRIM EXCESS FABRIC IN THE FLOW LINE TO WITHIN 3" OF THE GRATE. THE INSTALLED BAG SHALL HAVE A MINIMUM SIDE CLEARANCE, BETWEEN THE INLET WALLS AND THE BAG, MEASURED AT THE BOTTOM OF THE OVERFLOW HOLES, OF 3". WHERE NECESSARY THE CONTRACTOR SHALL CNIG THE BAG, USING PLASTIC ZIP TIES, TO ACHIEVE THE 3" CLEARANCE. THE TIES SHALL BE PLACED AT A MAXIMUM OF 4" FROM THE BOTTOM OF THE BAG.

STORM DRAIN INLET PROTECTION

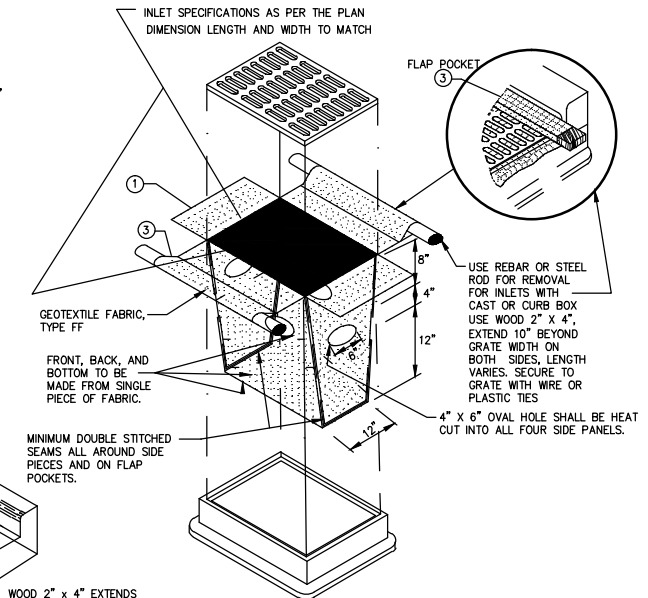

INLET PROTECTION, TYPE D

(CAN BE INSTALLED IN ANY INLET TYPE WITH OR WITHOUT A CURB BOX AS PER NOTE ②)

This drawing based on Wisconsin Department of Transportation Standard Detail Drawing 8 E 10-2.



CTH 'S' (STH 76 – KELLY ROAD)
OUTAGAMIE COUNTY, WISCONSIN
MISC CONSTRUCTION DETAILS

DESIGNED MPK	DRAWN MPK
PROJECT NO. 00006 910308	
DATE FEBRUARY, 2014	
SHEET NO. 09	

McMahon provides this drawing and data, regardless of form, as instruments of service. The client and/or contractor shall retain the copyright in this drawing. McMahon, the client and/or contractor shall not be liable for any damages, including consequential damages, arising out of the use of this drawing or data without prior written consent by McMahon.

McMAHON
ENGINEERS & ARCHITECTS
1445 McMAHON DRIVE NEENAH, WI 54956
MAILING: P.O. BOX 1025 NEENAH, WI 54957-1025
TEL: (920) 751-4200 FAX: (920) 751-4284
www.mcmahongrp.com

m\kohlbeck, W. \PROJECTS\00006\910308\08-Design\Construction Details\10 MISC CONSTRUCTION DETAILS.dwg, 10 misc construction details, Plot Date: 2/25/2014 3:37 PM, xrefs:none

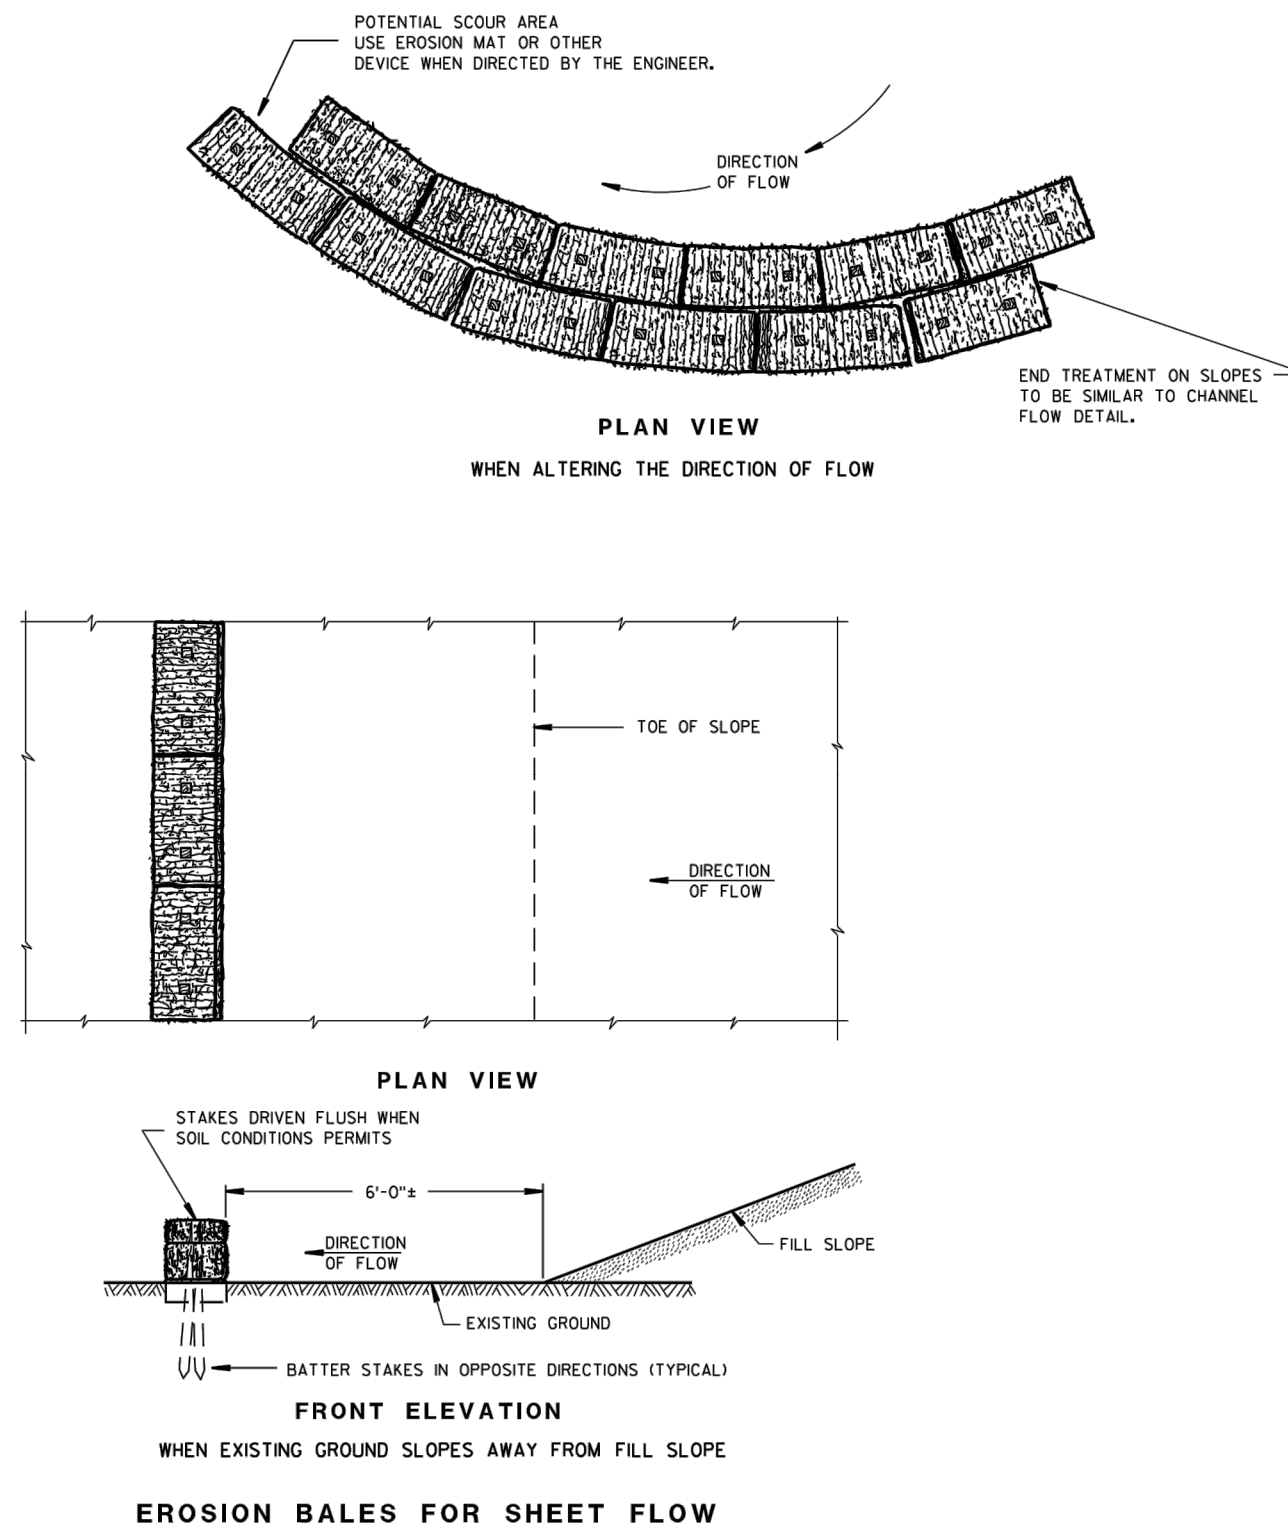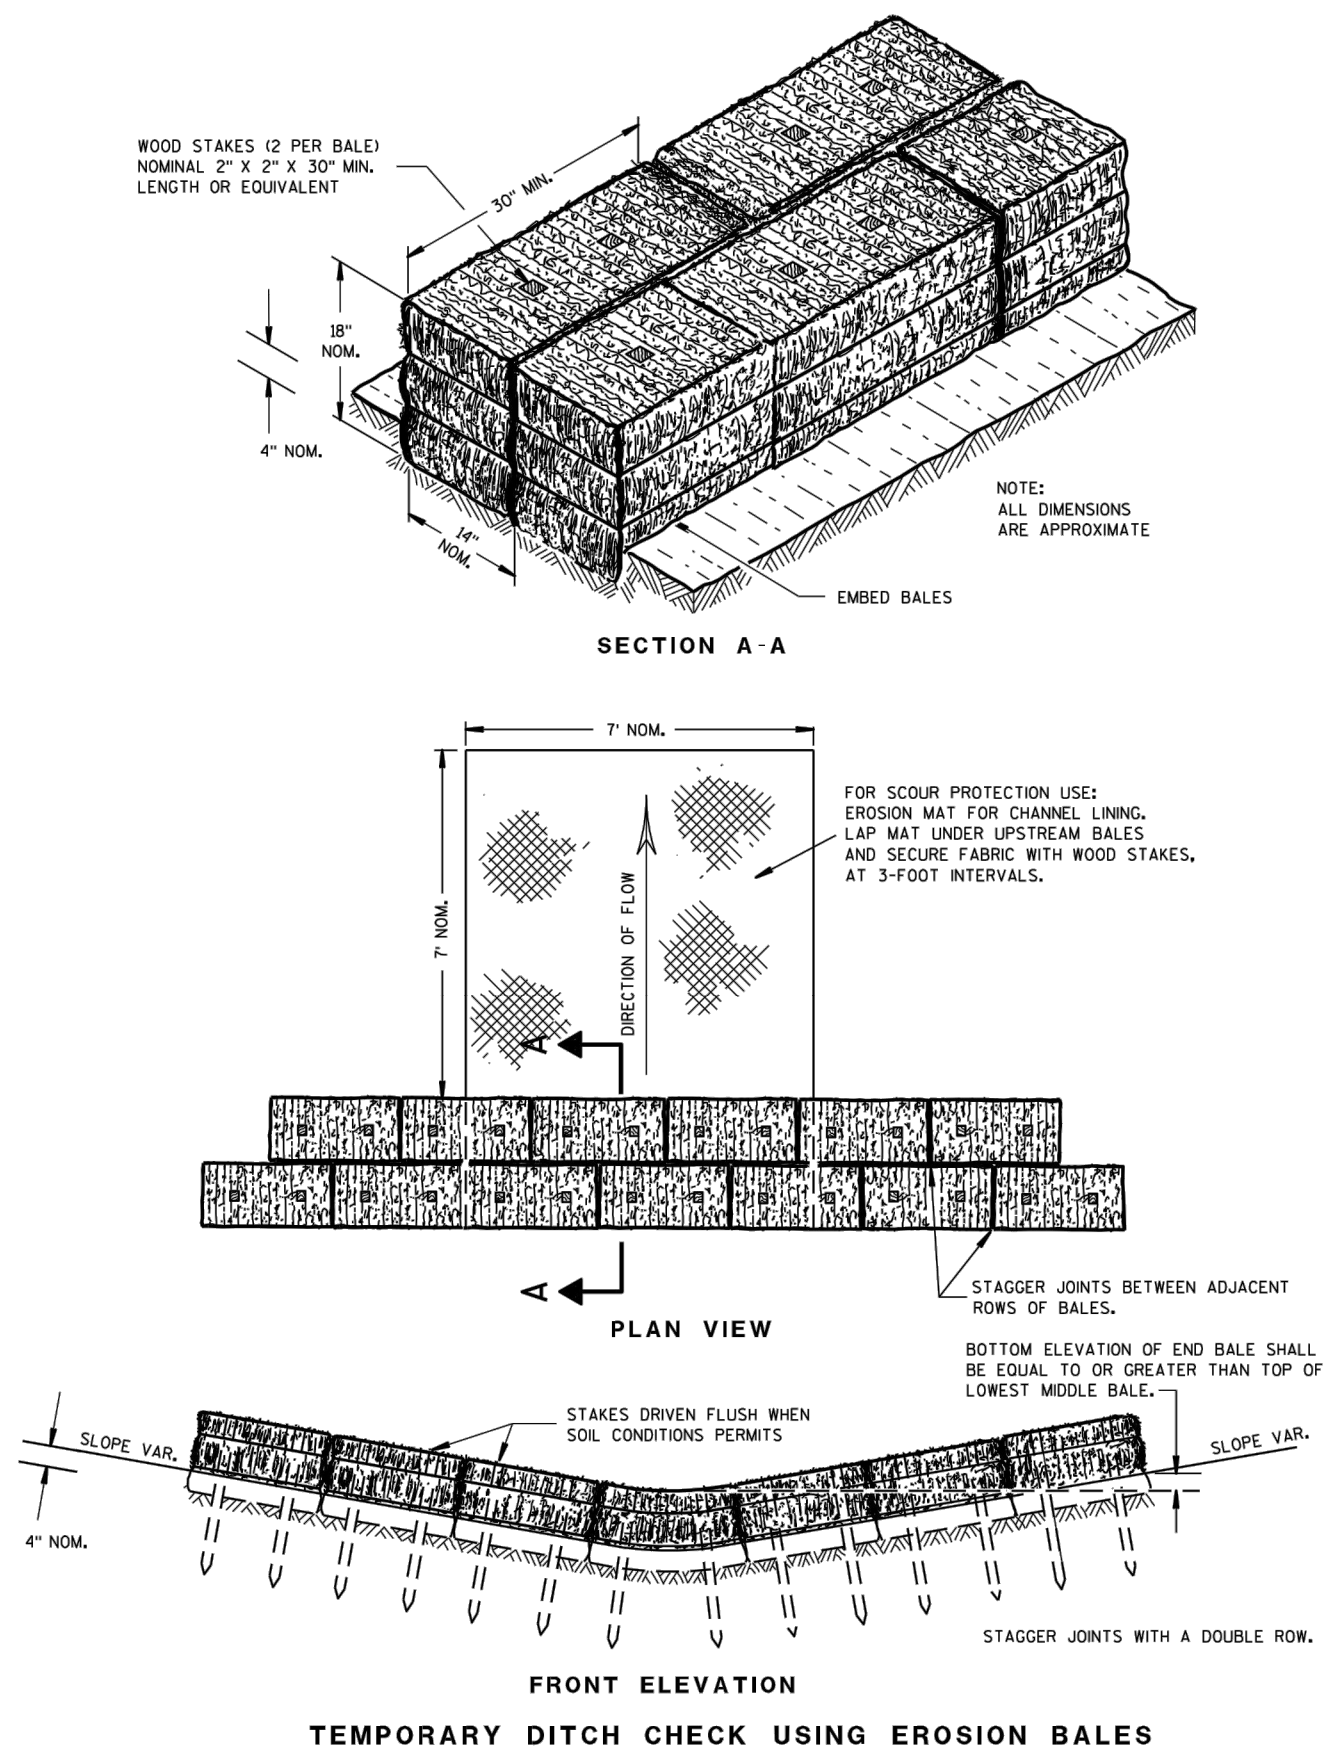




PRIVATE ENTRANCE IN URBAN AREA



TYPICAL CROSS SECTION

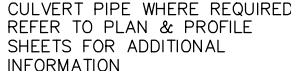


PROFILE VIEW




PRIVATE/FIELD ENTRANCE IN RURAL AREA


m:\projects\00006\910308\08-Design\Construction Details\12 misc construction details, Plot Date: 2/25/2014, 3:37 PM, xref:none

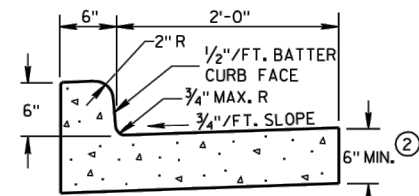


TYPES A & D ①

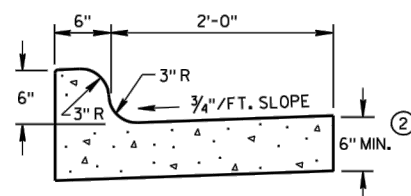


TYPES K & L ①

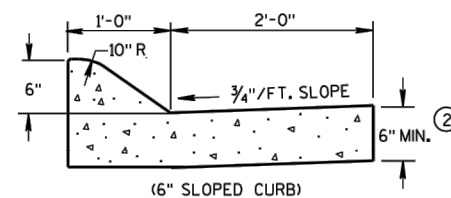


(6" SLOPED CURB)

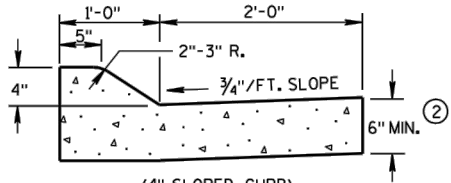


TYPES A & D ①

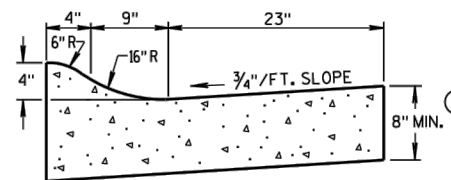


4" SLOPED CURB TYPES R & T ① ④

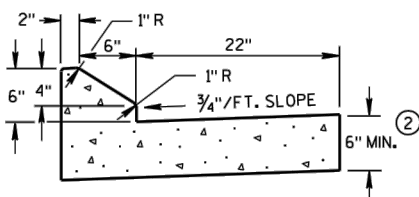

6" SLOPED CURB TYPES G & J ①

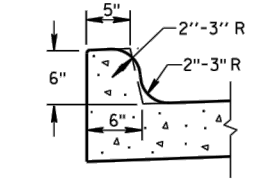


OPTIONAL CURB SHAPE
FOR TYPES K & L ①

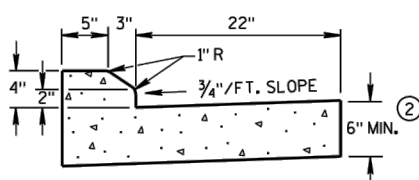


4" SLOPED CURB TYPES G & J ①


CONCRETE CURB & GUTTER 30"

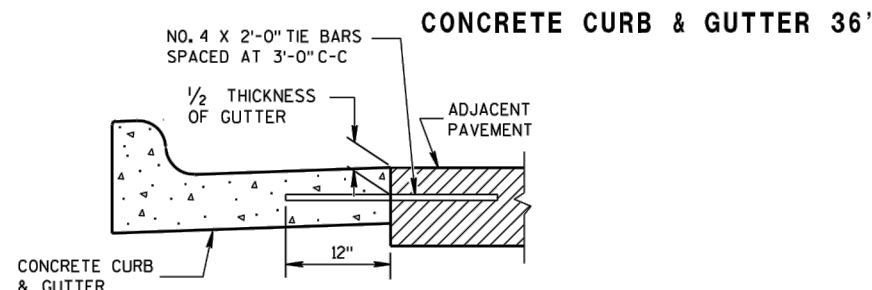


CONCRETE CURB & GUTTER 36"

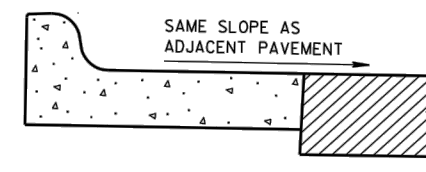

REVERSE SLOPE GUTTER
(TYPICAL FOR ALL CURB & GUTTER TYPES)

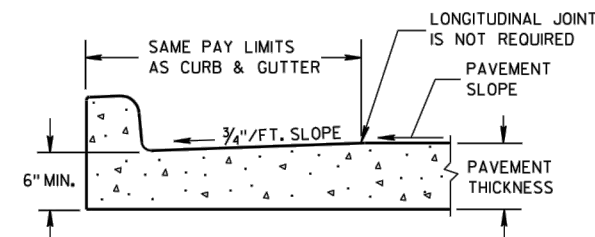


PARTIAL SECTION OF PAVEMENT
WITH INTEGRAL CURB & GUTTER

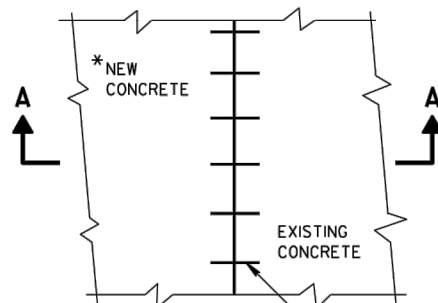


PLAN VIEW

*NEW CURB & GUTTER,
SURFACE DRAINS,
CONCRETE PAVEMENT
OR OTHER NEW CONCRETE.

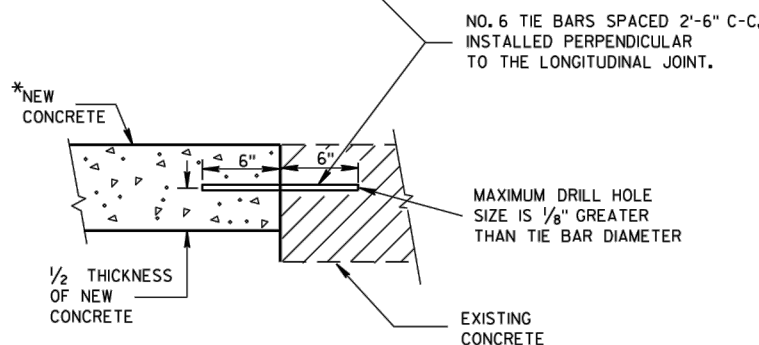


SECTION A-A
TIE BARS DRILLED
INTO EXISTING PAVEMENT


TYPICAL TIE BAR LOCATION ①

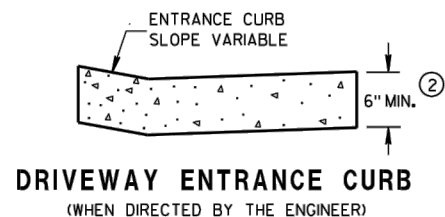


DRIVEWAY ENTRANCE CURB
(WHEN DIRECTED BY THE ENGINEER)

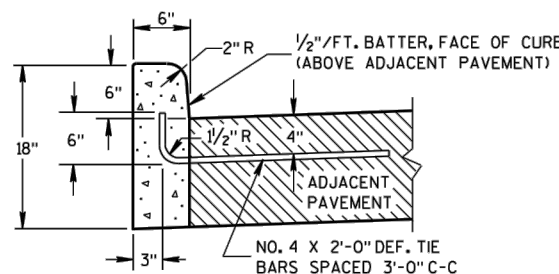

TYPES A & D

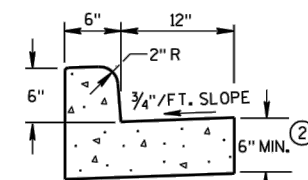

TYPES A & D
CONCRETE CURB & GUTTER 18"

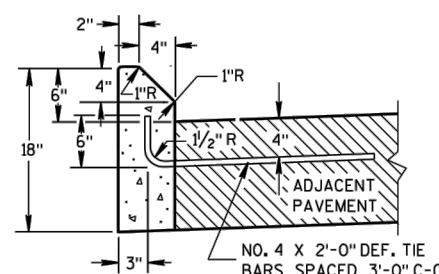

TYPES G & J


CONCRETE CURB

- ① TIE BARS ARE REQUIRED FOR CURB AND GUTTER TYPES A, G, K AND R.
- ② THE BOTTOM OF CURB AND GUTTER MAY BE CONSTRUCTED EITHER LEVEL OR PARALLEL TO THE SLOPE OF THE SUBGRADE OR BASE AGGREGATE PROVIDED A 6" MINIMUM GUTTER THICKNESS IS MAINTAINED.
- ③ THE BOTTOM OF CURB AND GUTTER MAY BE CONSTRUCTED EITHER LEVEL OR PARALLEL TO THE SLOPE OF THE SUBGRADE OR BASE AGGREGATE PROVIDED A 8" MINIMUM GUTTER THICKNESS IS MAINTAINED.
- ④ THE FACE OF CURB IS 6" FROM THE BACK OF CURB.
- ⑤ WHEN REVERSE SLOPE GUTTER IS REQUIRED, THE LOCATION(S) WILL BE SHOWN ELSEWHERE IN THE PLAN.

NO.	DATE	REVISION

w:\projects\00006\910308\08-Design\Construction Details\13 misc construction details.dwg, Plot Date: 2/25/2014, 3:37 PM, xreis:none


ASPHALTIC FLUME

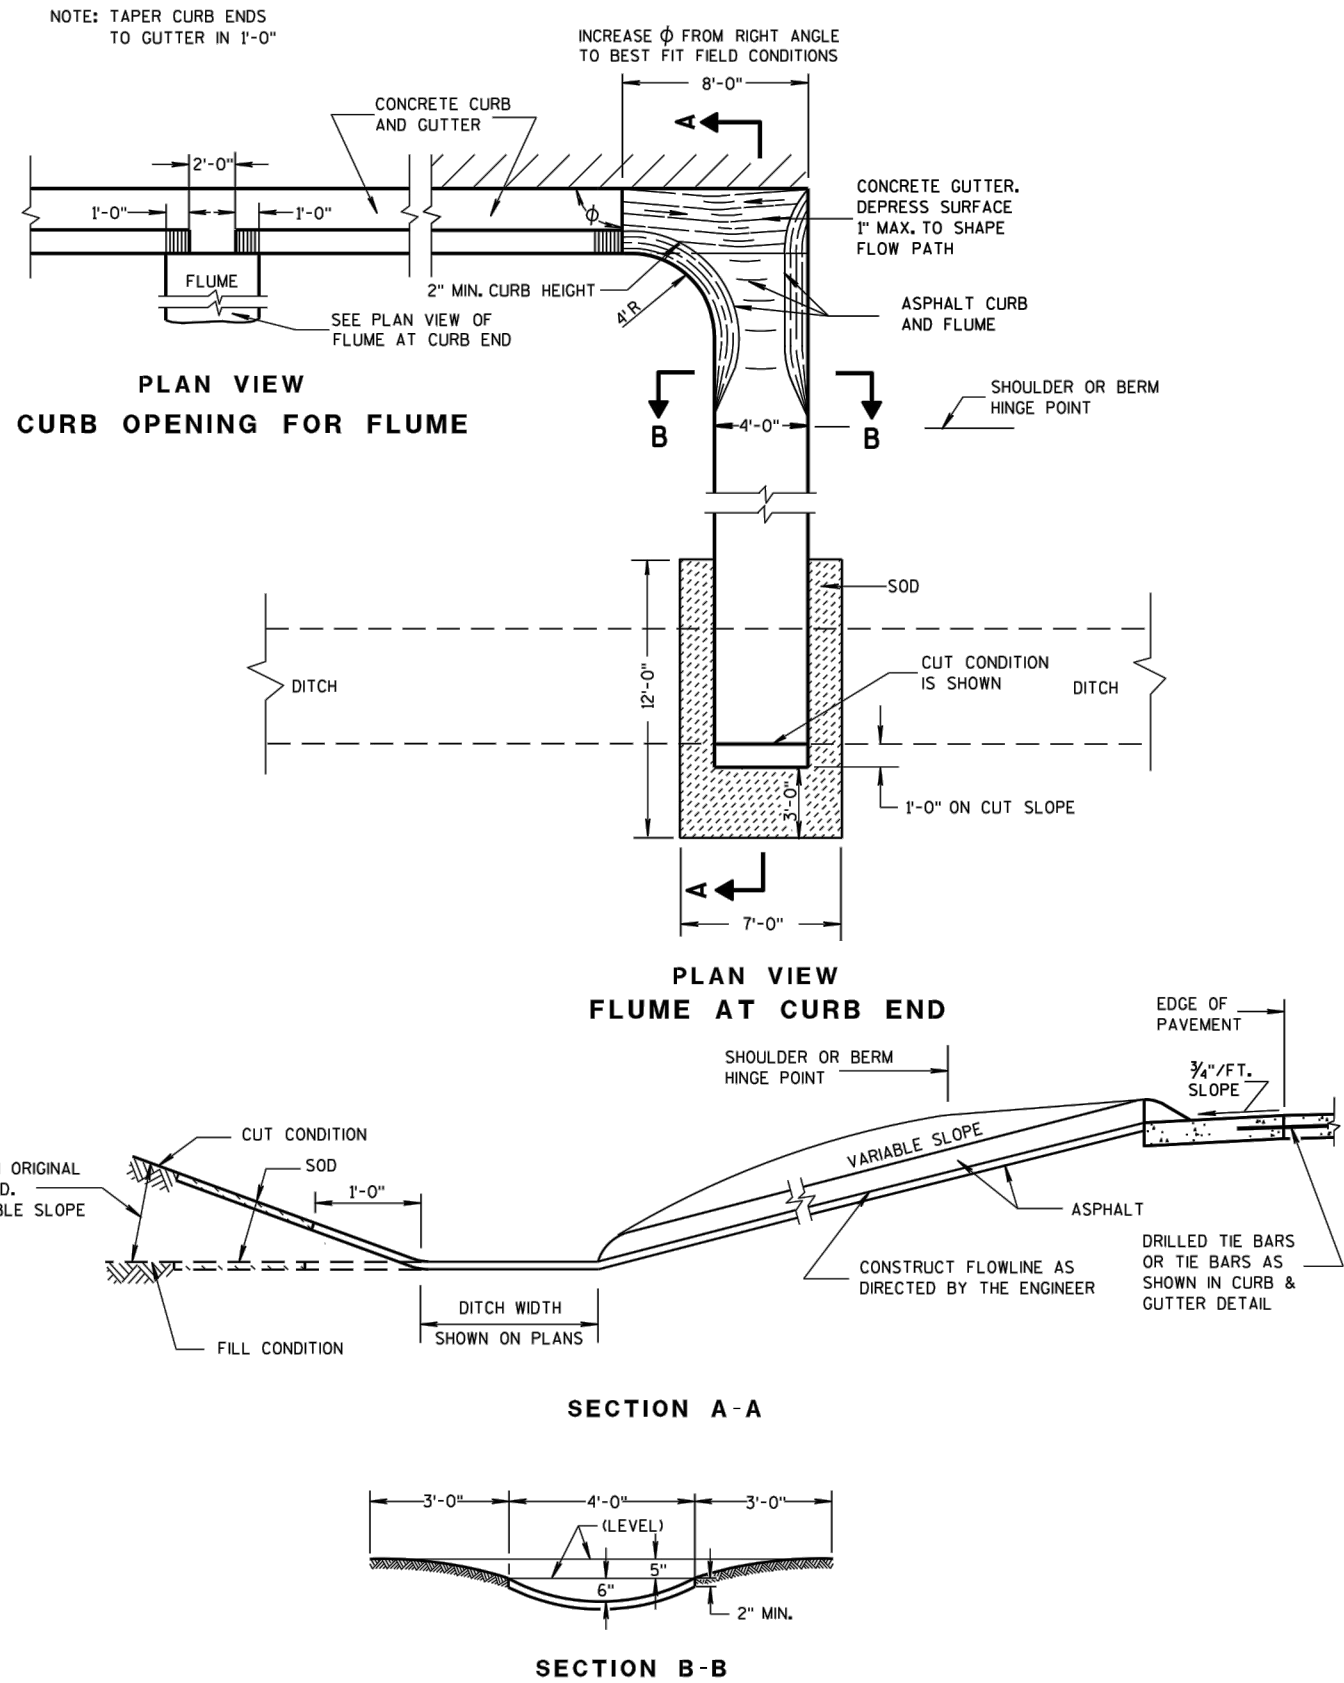

WELDED STEEL WIRE FABRIC SHALL BE IN ACCORDANCE WITH AASHTO SPECIFICATION M55.

- JOINTS SHALL BE $\frac{1}{8}$ TO $\frac{1}{4}$ INCH WIDE BY $1\frac{1}{2}$ INCHES DEEP AND SPACED AT UNIFORM INTERVALS OF APPROXIMATELY 4 FEET.
- GEOTEXTILE FABRIC TYPE "R" SHALL UNDERLAY THE FULL LENGTH AND WIDTH OF THE CONCRETE SURFACE DRAIN AND RIPRAP.
- CONCRETE SURFACE DRAIN WITHOUT CURB AND GUTTER MAY BE USED ON BACKSLOPES WHEN SPECIFIED

③ CONCRETE SURFACE DRAIN

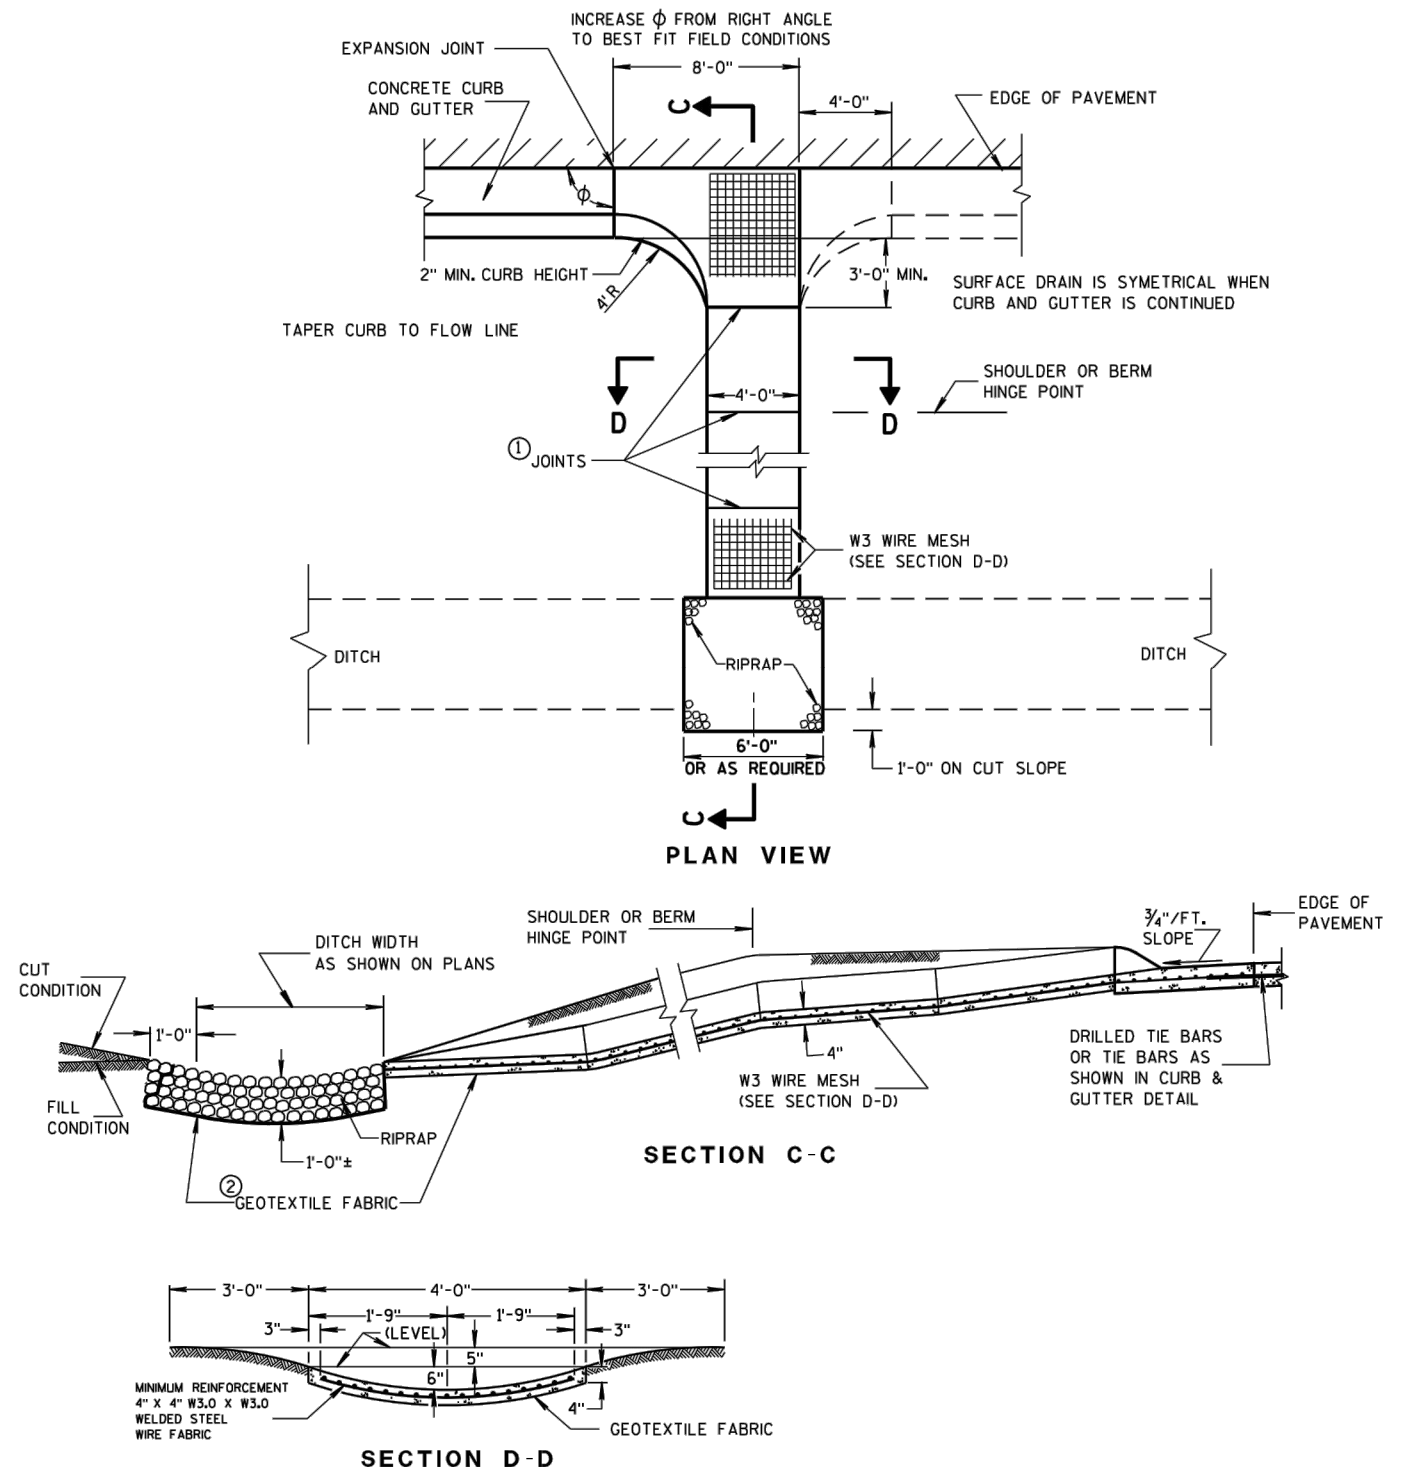


NO.	DATE	REVISION


DESIGNED MPK	DRAWN MPK
PROJECT NO. 00006 910308	DATE FEBRUARY, 2014
SHEET NO. 13	




9A1 sheet a: At-Grade Side Road Intersection, Types 'B1', 'B2', 'C' and 'D' and Tee Intersection Bypass Lane

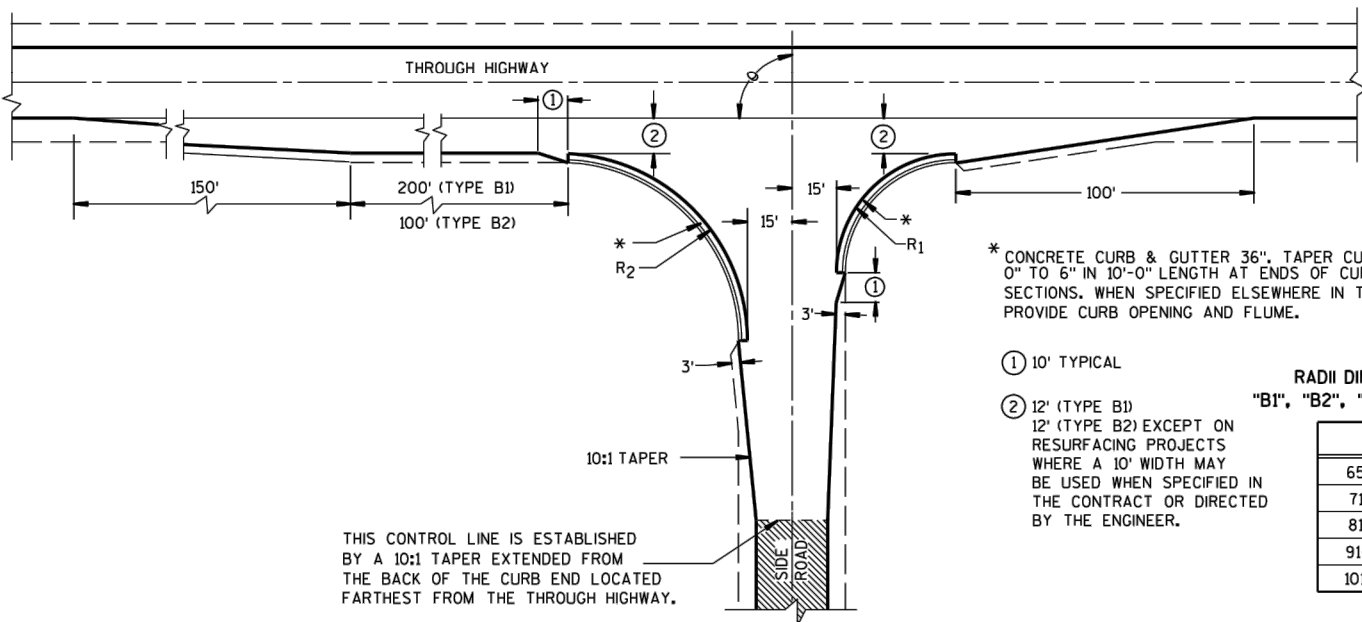


TYPE "B1" AND "B2"

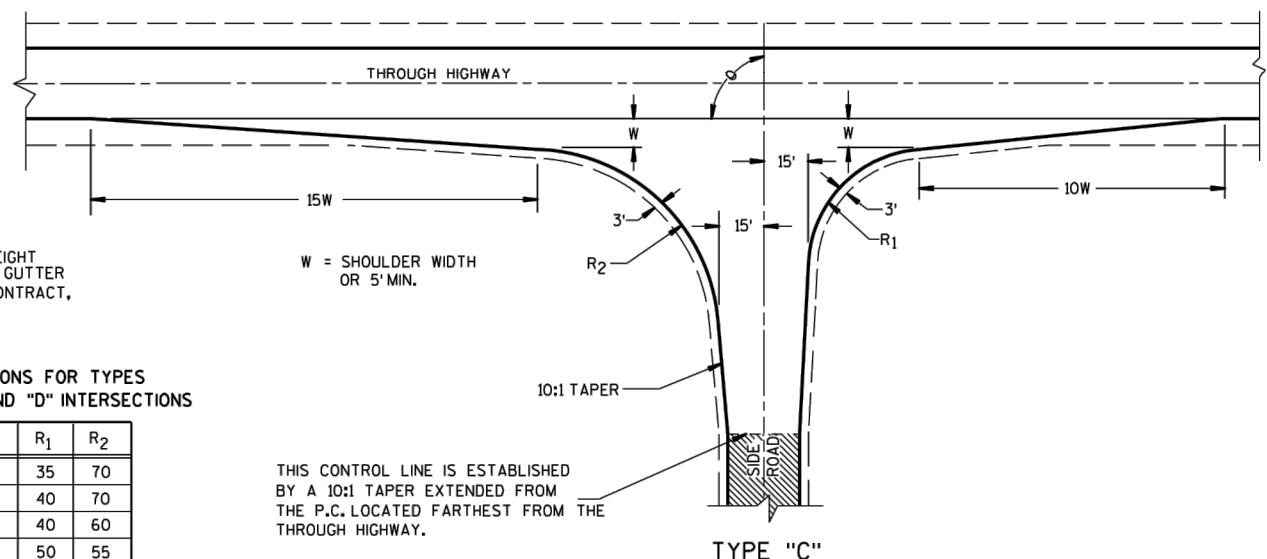


TYPE "C"

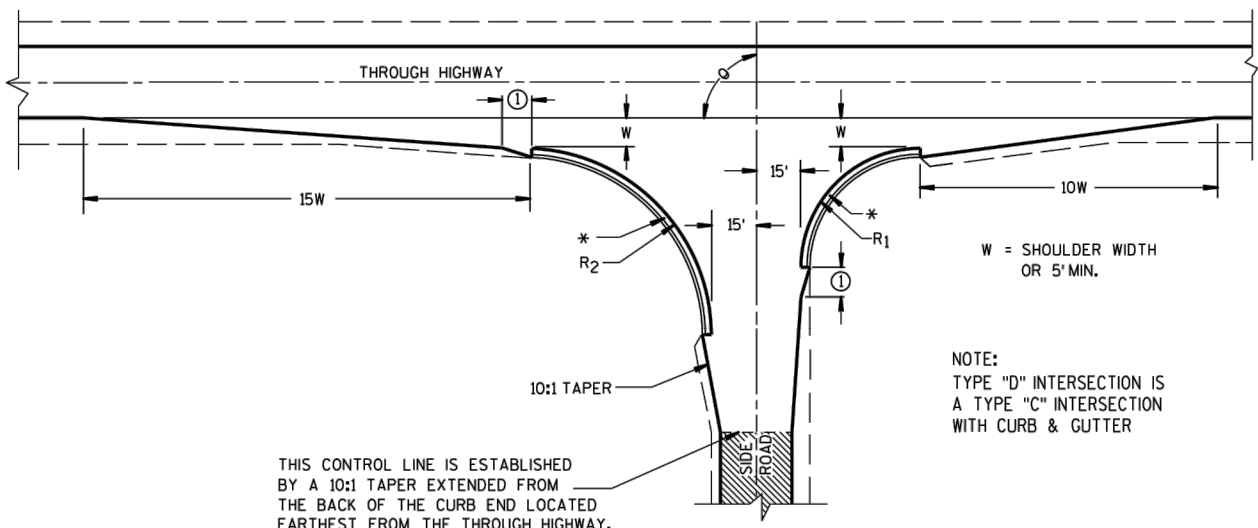

TYPE "D"

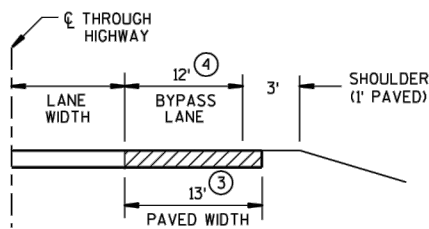

SECTION A-A
(SHOWING BYPASS LANE AND SHOULDER)

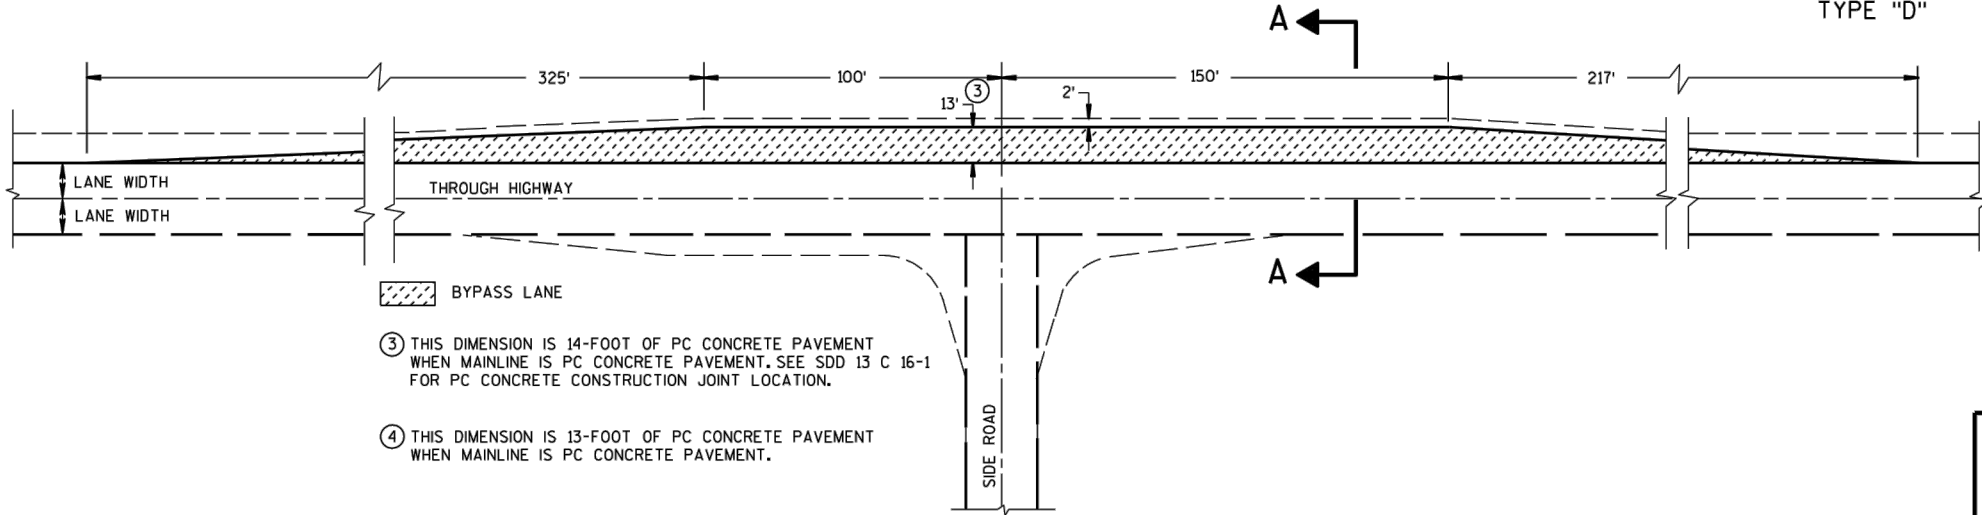

TEE INTERSECTION BYPASS LANE DETAIL

GENERAL NOTES

DESIGNS MAY BE USED INTERCHANGEABLY IN COMBINATION OR SEPARATELY FOR ANY ONE COMPLETE INTERSECTION DEPENDING UPON INTERSECTION ANGLE AND SURFACING OF EACH APPROACH ROADWAY.

SIDE ROAD SURFACING NOTE

WHEN THE SIDE ROAD IS NOT PRESENTLY PAVED, PAVEMENT SHALL BE PLACED TO THE LIMITS SHOWN UNLESS OTHERWISE PROVIDED IN THE CONTRACT. WHERE THE CONSTRUCTION LIMITS ARE BEYOND THE PAVING LIMITS, CRUSHED AGGREGATE SURFACING SHALL BE PLACED BETWEEN THE PAVING LIMITS AND CONSTRUCTION LIMITS.

WHEN THE SIDE ROAD IS PRESENTLY PAVED, NEW PAVEMENT SHALL BE PLACED TO THE LIMITS OF DESIGN AS SHOWN AND BEYOND, IF NECESSARY, TO MEET EXISTING PAVEMENT.

WHEN THE SIDE ROAD IS THE CONSTRUCTION PROJECT, THE INTERSECTION SURFACING SHALL BE THE SAME AS FOR THE PROJECT.

EXISTING SURFACE

6

S.D.D. 9 A 1-12a

6

S.D.D. 9 A 1-12a

CTH 'S' (STH 76 - KELLY ROAD)
OUTAGAMIE COUNTY, WISCONSIN
MISC CONSTRUCTION DETAILS

DESIGNED
MPK
DRAWN
MPK
PROJECT NO.
00006 910308
DATE
FEBRUARY, 2014
SHEET NO.

14

McMAHON
1445 McMAHON DRIVE NEENAH, WI 54956
MAILING: P.O. BOX 1025 NEENAH, WI 54957-1025
TEL: (920) 751-4200 FAX: (920) 751-4284
www.mcmahongrp.com

McMahon provides this drawing and data, regardless of form, as instruments of service. The client and/or user of this drawing and data shall be responsible for obtaining all necessary permits and licenses to use this drawing and data. McMahon shall not be held liable for any damages or losses resulting from the use of this drawing and data. Changes made to the original drawing or data without prior written consent by McMahon.




15C8 sheet a: Pavement Marking (Mainline)


m:\kohlbeck_w:\PROJECTS\00006\910308\08-Design\Construction Details\15 misc construction details.dwg, Plot Date: 2/25/2014, 3:37 PM, xref:none

6

S.D.D. 15 C 8-15a

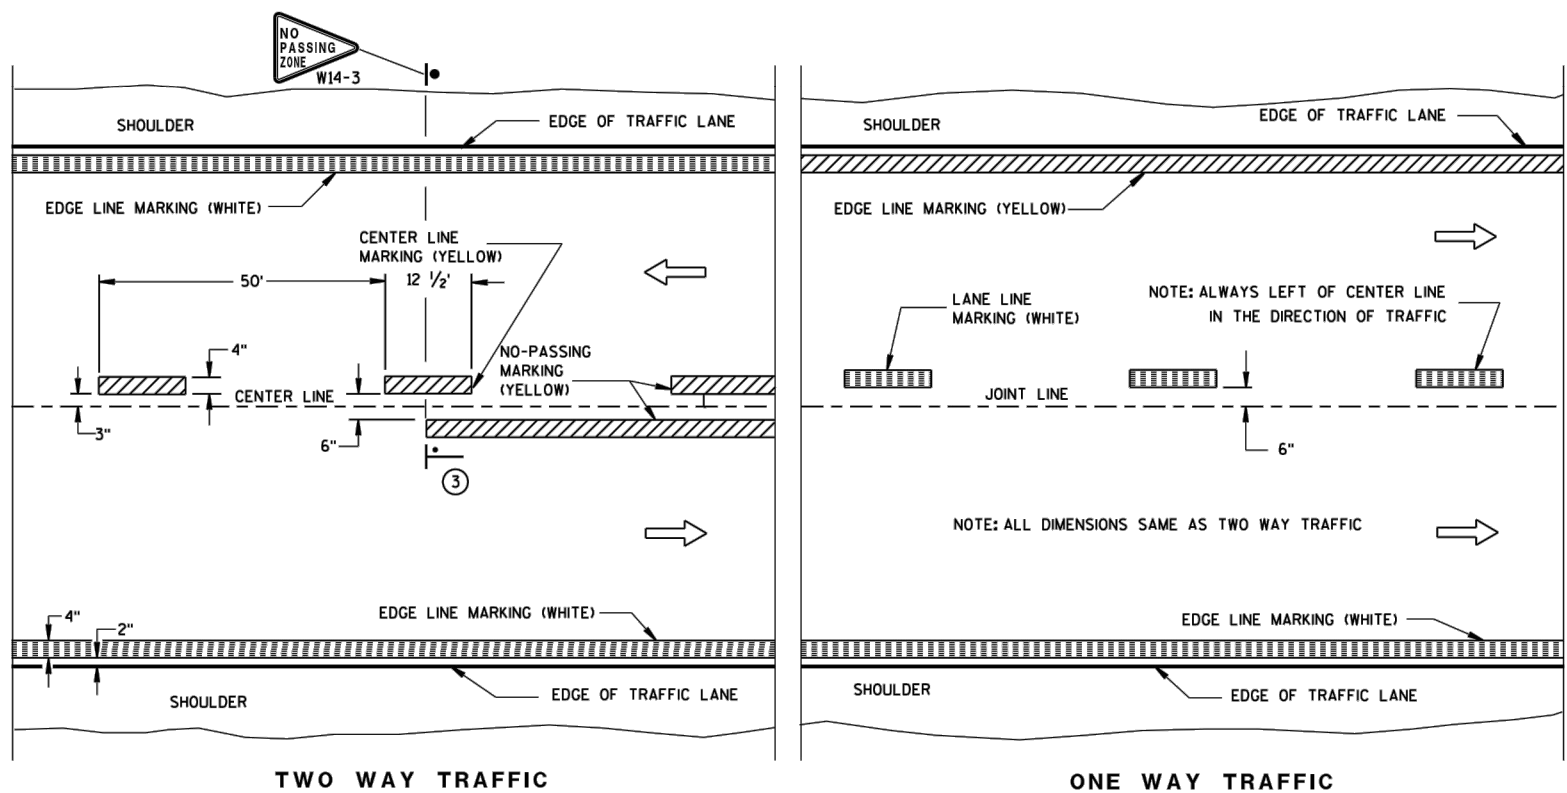

PERMANENT PAVEMENT MARKING

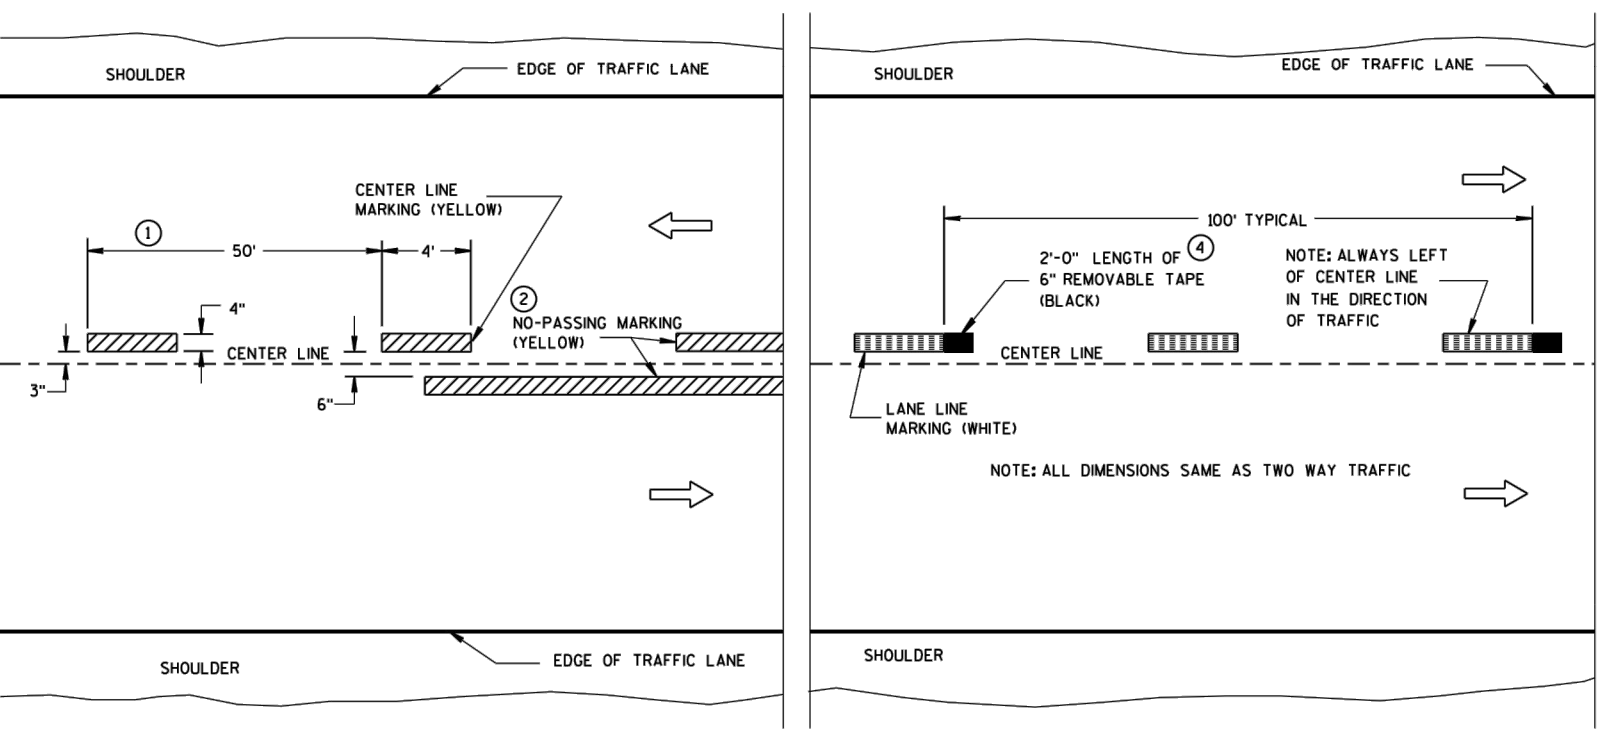

TEMPORARY (INTERMEDIATE) PAVEMENT MARKING

(SHOWS CYCLE FOR TEMPORARY CENTER LINE OR TEMPORARY LANE LINE MARKING)


GENERAL NOTES

DETAILS OF CONSTRUCTION NOT SHOWN ON THIS DRAWING SHALL CONFORM TO STANDARD SPECIFICATIONS AND SPECIAL PROVISIONS.

- 1 HALF CYCLE LENGTHS (25'±) WITH 2' MINIMUM STRIPE LENGTHS SHALL BE PROVIDED ON ROADWAYS (INCLUDING TEMPORARY TRAVELED WAYS) WITH REVERSE CURVATURE, CURVATURE OF OVER 5 DEGREES OR WHEN DIRECTED BY THE ENGINEER TO MARK UNUSUAL ALIGNMENT OF THE TRAVELED WAY.
- 2 NO PASSING ZONE TEMPORARY PAVEMENT MARKING IS REQUIRED TO BE PLACED, WHERE APPROPRIATE, ALONG WITH CENTERLINE TEMPORARY PAVEMENT MARKING WHEN A SAME DAY PERMANENT PAVEMENT MARKING ITEM IS INCLUDED IN THE CONTRACT.
- 3 NO PASSING ZONE MARKINGS ARE PLACED ACCORDING TO "T" MARKINGS. IF EXISTING NO PASSING ZONE W14-3 SIGNS ARE BEYOND 50 FEET IN EITHER DIRECTION, THE SIGNS SHALL BE MOVED TO THE "T" MARKINGS.
- 4 CONCRETE ONLY.

NOTE

ARROW SYMBOL (→) SHOWS DIRECTION OF TRAVEL

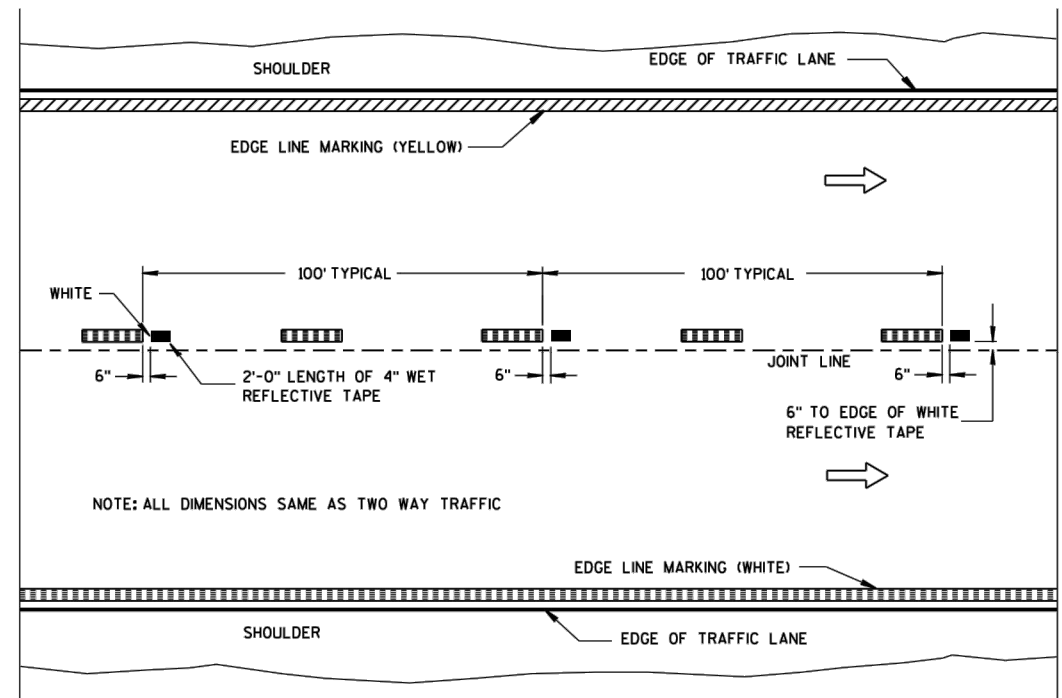

WET REFLECTIVE TAPE SUPPLEMENT TO SPRAYED OR NON WET REFLECTIVE TAPE LANE LINE

LEGEND

- "T" MARKING
- POST MOUNTED SIGN

PAVEMENT MARKING (MAINLINE)

STATE OF WISCONSIN
DEPARTMENT OF TRANSPORTATION

APPROVED
10-1-2012 /S/ Travis Feltes
DATE STATE TRAFFIC ENGINEER OF DESIGN
FHWA

S.D.D. 15 C 8-15a

6

CTH 'S' (STH 76 - KELLY ROAD)
OUTAGAMIE COUNTY, WISCONSIN
MISC CONSTRUCTION DETAILS

DESIGNED
MPK

DRAWN
MPK

PROJECT NO.
00006 910308


DATE
FEBRUARY, 2014

SHEET NO.
15

McMAHON
ENGINEERS & ARCHITECTS
1445 McMAHON DRIVE NEENAH, WI 54956
MAILING: P.O. BOX 1025 NEENAH, WI 54957-1025
TEL: (920) 751-4200 FAX: (920) 751-4284
www.mcmahongrp.com




15C8 sheet b: Pavement Marking (Intersections)

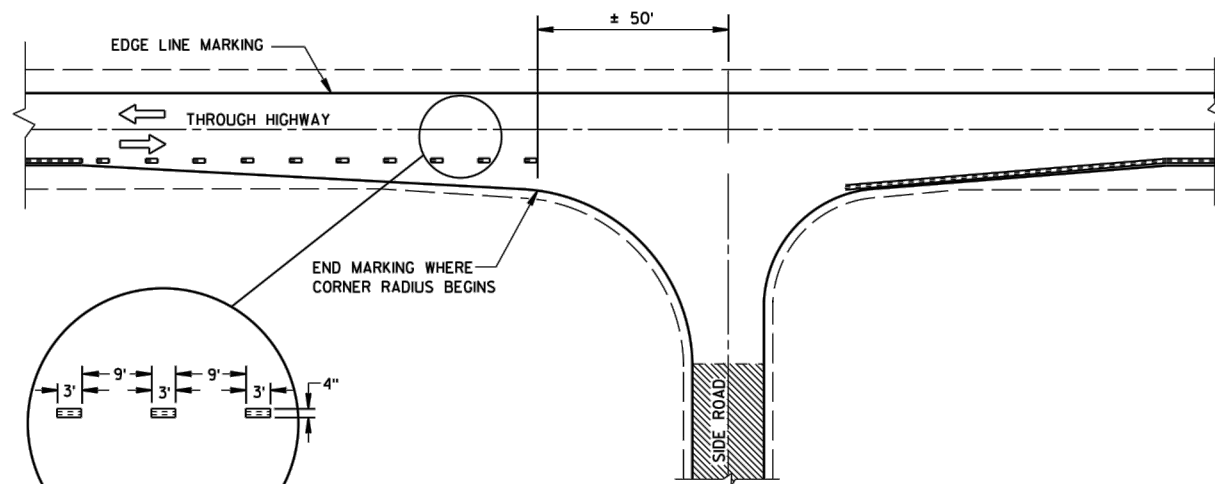

MINOR INTERSECTION WITHOUT CURBS

POSTED SPEED (MPH)	MINIMUM DISTANCE BETWEEN ZONES (FEET)
25 - 30	528
35 - 40	528
45 - 50	686
55	792

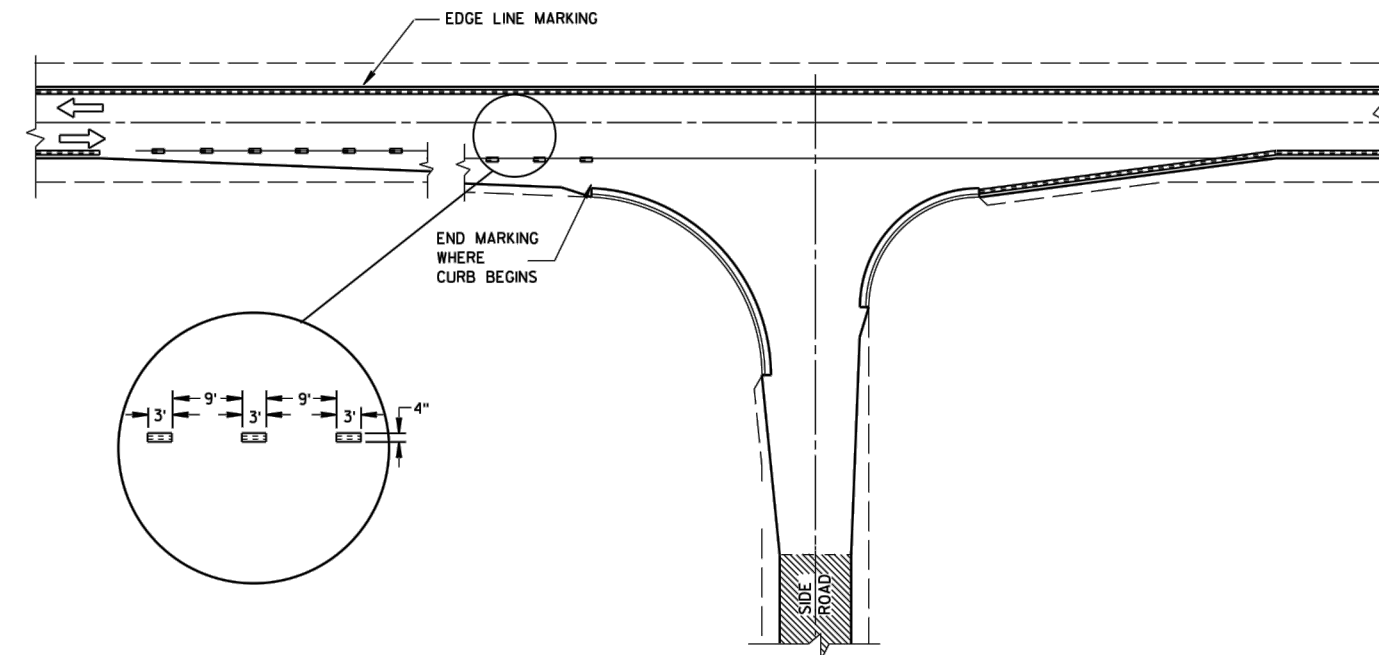

MINOR INTERSECTION WITH CURBS
(TYPICAL MARKING)


GENERAL NOTES

EDGE LINES SHALL BE OMITTED THROUGH INTERSECTIONS. EDGE LINES SHALL BE CONTINUED THROUGH DRIVEWAYS.


- 1 WHEN DISTANCE "A" IS LESS THAN 250 FEET, OMIT LANE LINE.
- 2 WHEN DISTANCE "B" IS LESS THAN 100 FEET, OMIT CHANNELIZING LANE LINE.
- 3 ALTERNATIVE MARKING SHALL BE PROVIDED WHEN SPECIFIED IN THE CONTRACT. TYPICAL SITUATIONS WHERE THIS MARKING MAY BE REQUIRED ARE WHERE THE INTERSECTION IS ON A SHARP HORIZONTAL CURVE OR CREST VERTICAL CURVE IN AN UNLIGHTED AREA SUCH THAT THE EDGE LINE MAY BE MISLEADING TO THE MOTORIST OR DISAPPEAR FROM SIGHT.
- 4 THE EDGE LINE IN THE TAPER AREAS OF THE BYPASS LANE AND THE BYPASS LANE SHALL BE LOCATED 1-FOOT FROM EDGE OF PAVEMENT TO THE OUTSIDE EDGE OF EDGE LINE.

- 5 BARRIER LINE ENDS AT SIDE ROAD PAVEMENT/SURFACE EDGE EXTENSION.
- 6 BARRIER LINE STARTS 500 FEET PRIOR TO THE BYPASS TAPER.
- 7 IF THE DISTANCE BETWEEN 2 SUCCESSIVE NO-PASSING ZONES IS LESS THAN THE MINIMUM DISTANCE BETWEEN ZONES, CONNECT THE 2 ZONES.
- 8 3' LINE 9' GAP, EXCEPT RETRACE THE EXISTING LINE - GAP PATTERN WHERE EXISTING MARKINGS ARE IN PLACE.

ARROW SYMBOL (→) SHOWS DIRECTION OF TRAVEL

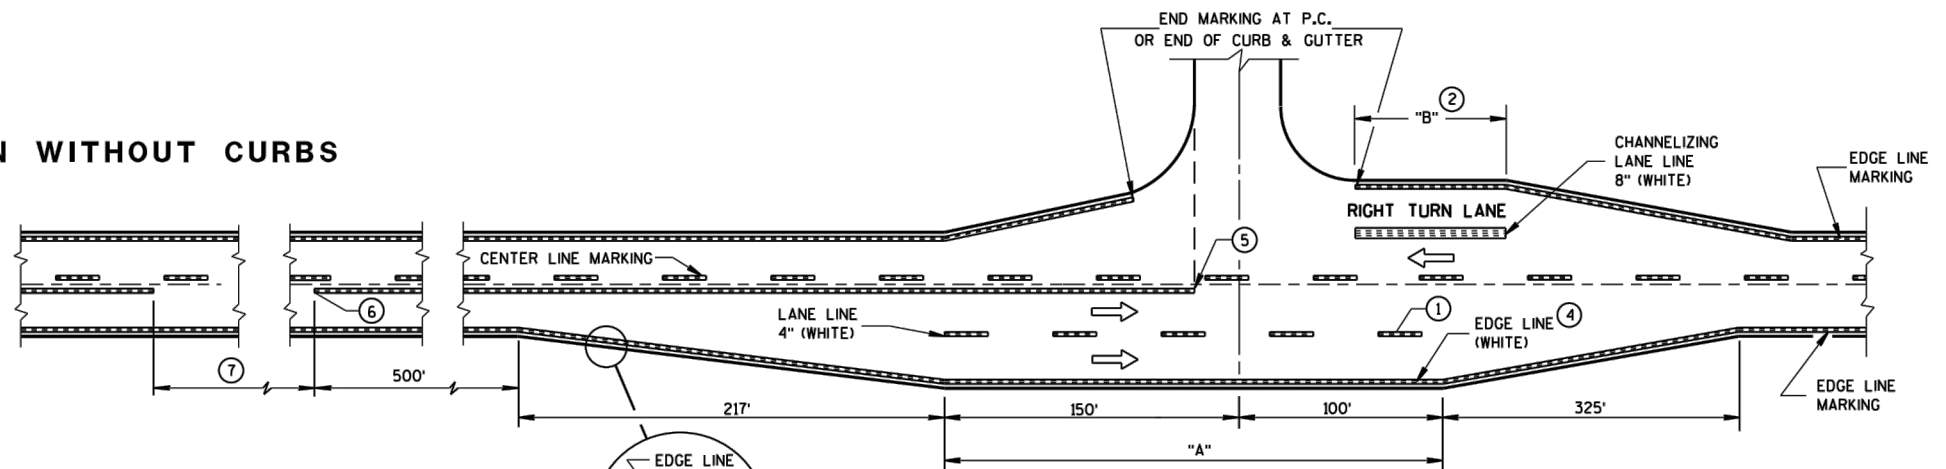

MAJOR INTERSECTIONS
(INTERSECTION WITH FULL RIGHT TURN LANE OR BYPASS LANES)



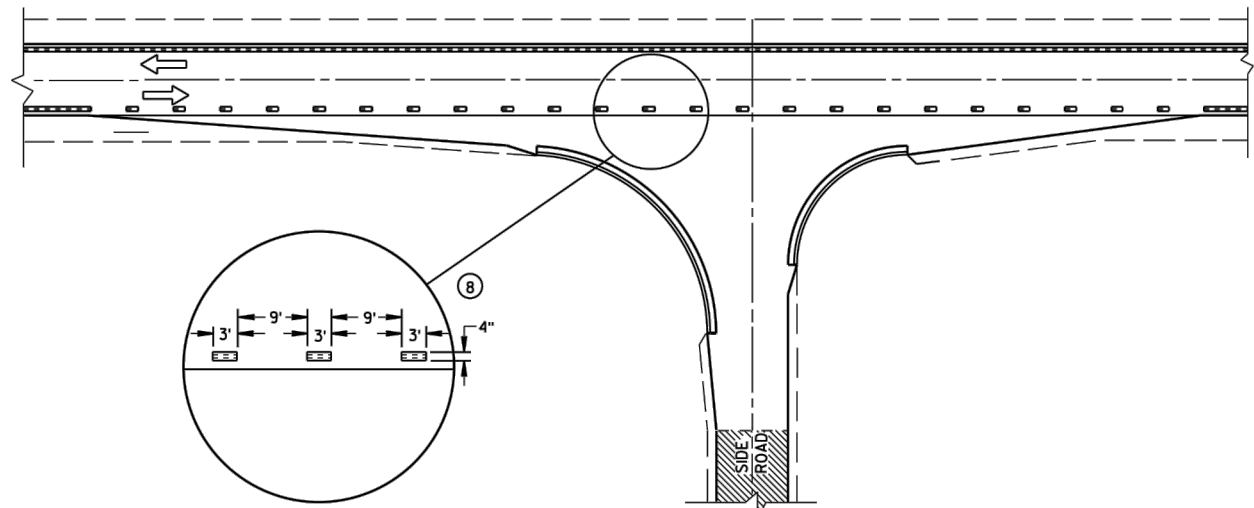


MINOR INTERSECTION WITH CURBS
(FOR SPECIAL CONDITIONS AS SPECIFIED)

PAVEMENT MARKING
(INTERSECTIONS)

STATE OF WISCONSIN
DEPARTMENT OF TRANSPORTATION

w:\projects\00006\910308\08-Design\paving details\17_paving details.dwg, 17_paving details, Plot Date: 2/26/2014 9:21 AM, xrefs:none

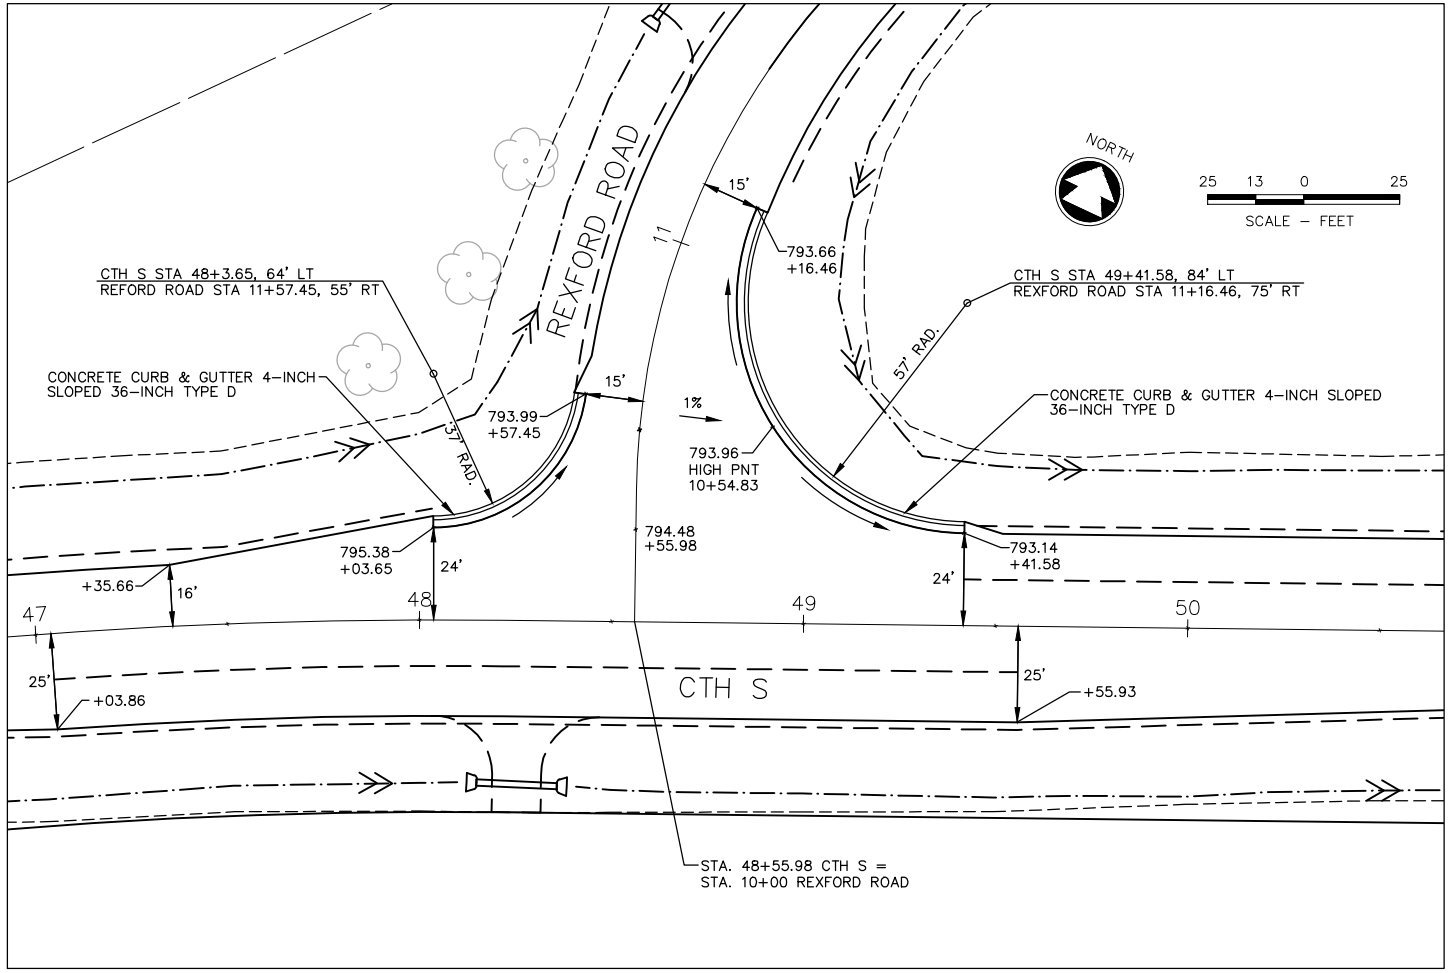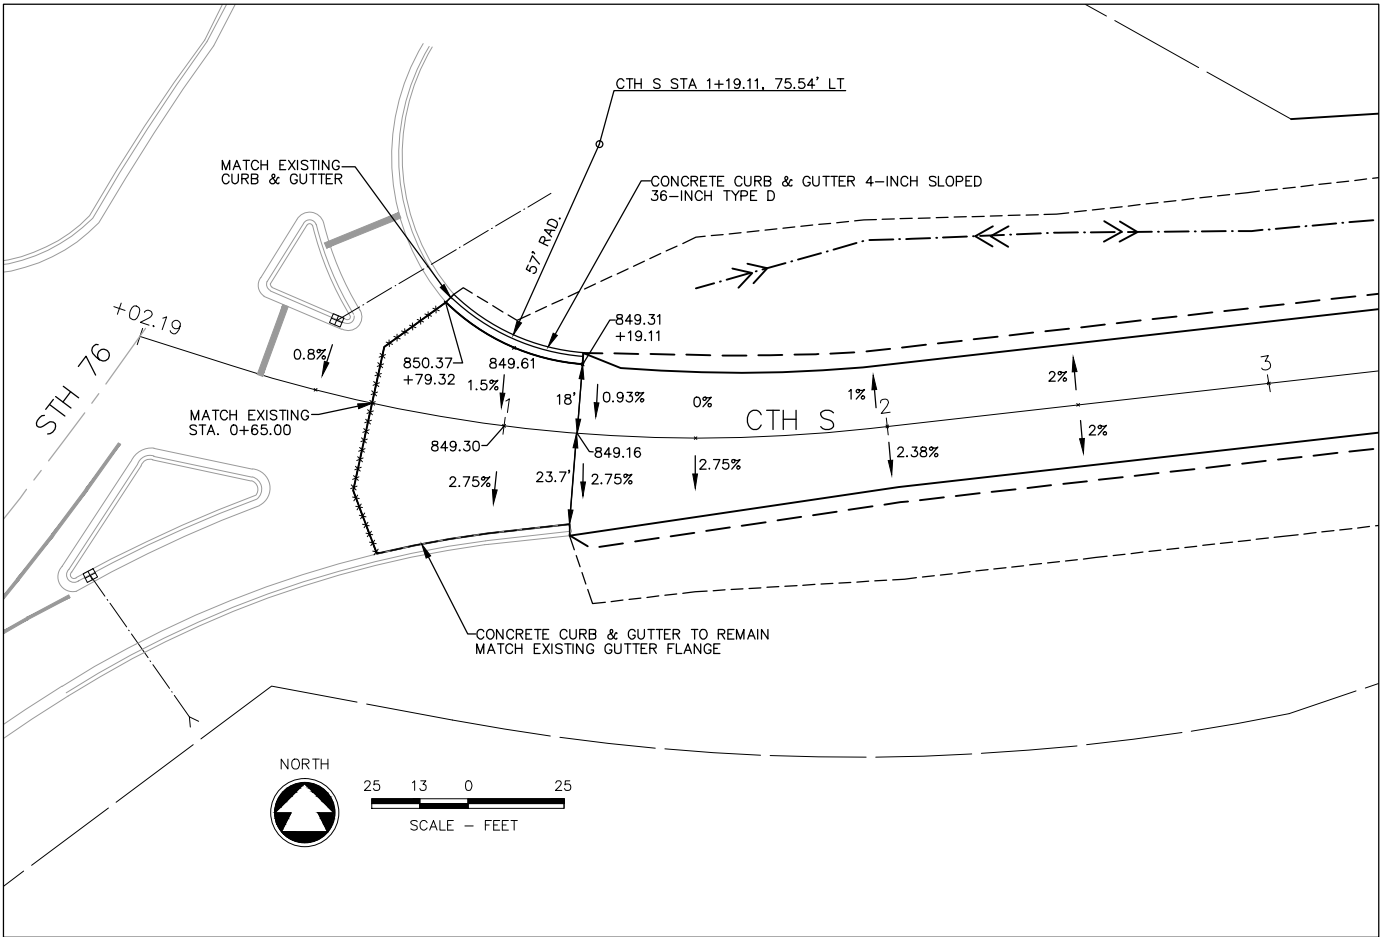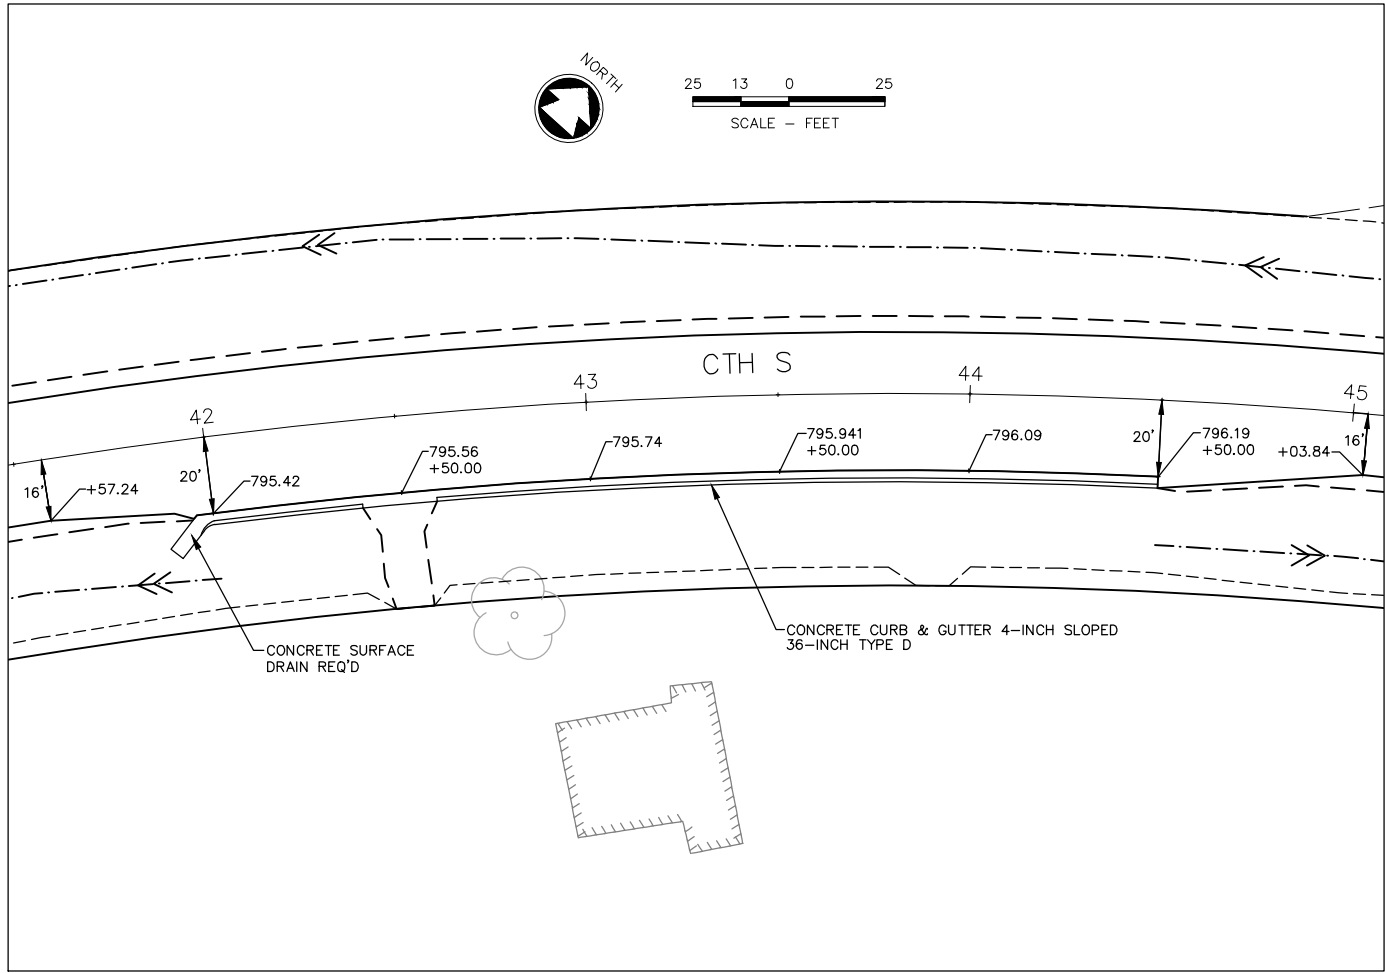

CTH 'S' (STH 76 - KELLY ROAD)
OUTAGAMIE COUNTY, WISCONSIN
PAVING DETAILS

DESIGNED
MPK
DRAWN
MPK
PROJECT NO.
00006 910308
DATE
FEBRUARY, 2014
SHEET NO.

17

McMahon provides this drawing and data, regardless of form, as instruments of service. The client and/or user of this drawing and data shall be responsible for obtaining all necessary permits and licenses. McMahon, the client and/or user shall be responsible for obtaining all necessary permits and licenses. McMahon, the client and/or user shall be responsible for obtaining all necessary permits and licenses.


REVISION

DATE

NO.

McMAHON
ENGINEERS ARCHITECTS
1445 McMAHON DRIVE NEENAH, WI 54956
Mailing: P.O. BOX 1025 NEENAH, WI 54957-1025
Tel: (920) 751-4200 Fax: (920) 751-4284
www.mcmgrpp.com

w:\projects\00006\910308\08-Design\paving details\17a paving details.dwg, Plot Date: 2/26/2014 9:21 AM, xrefis:none

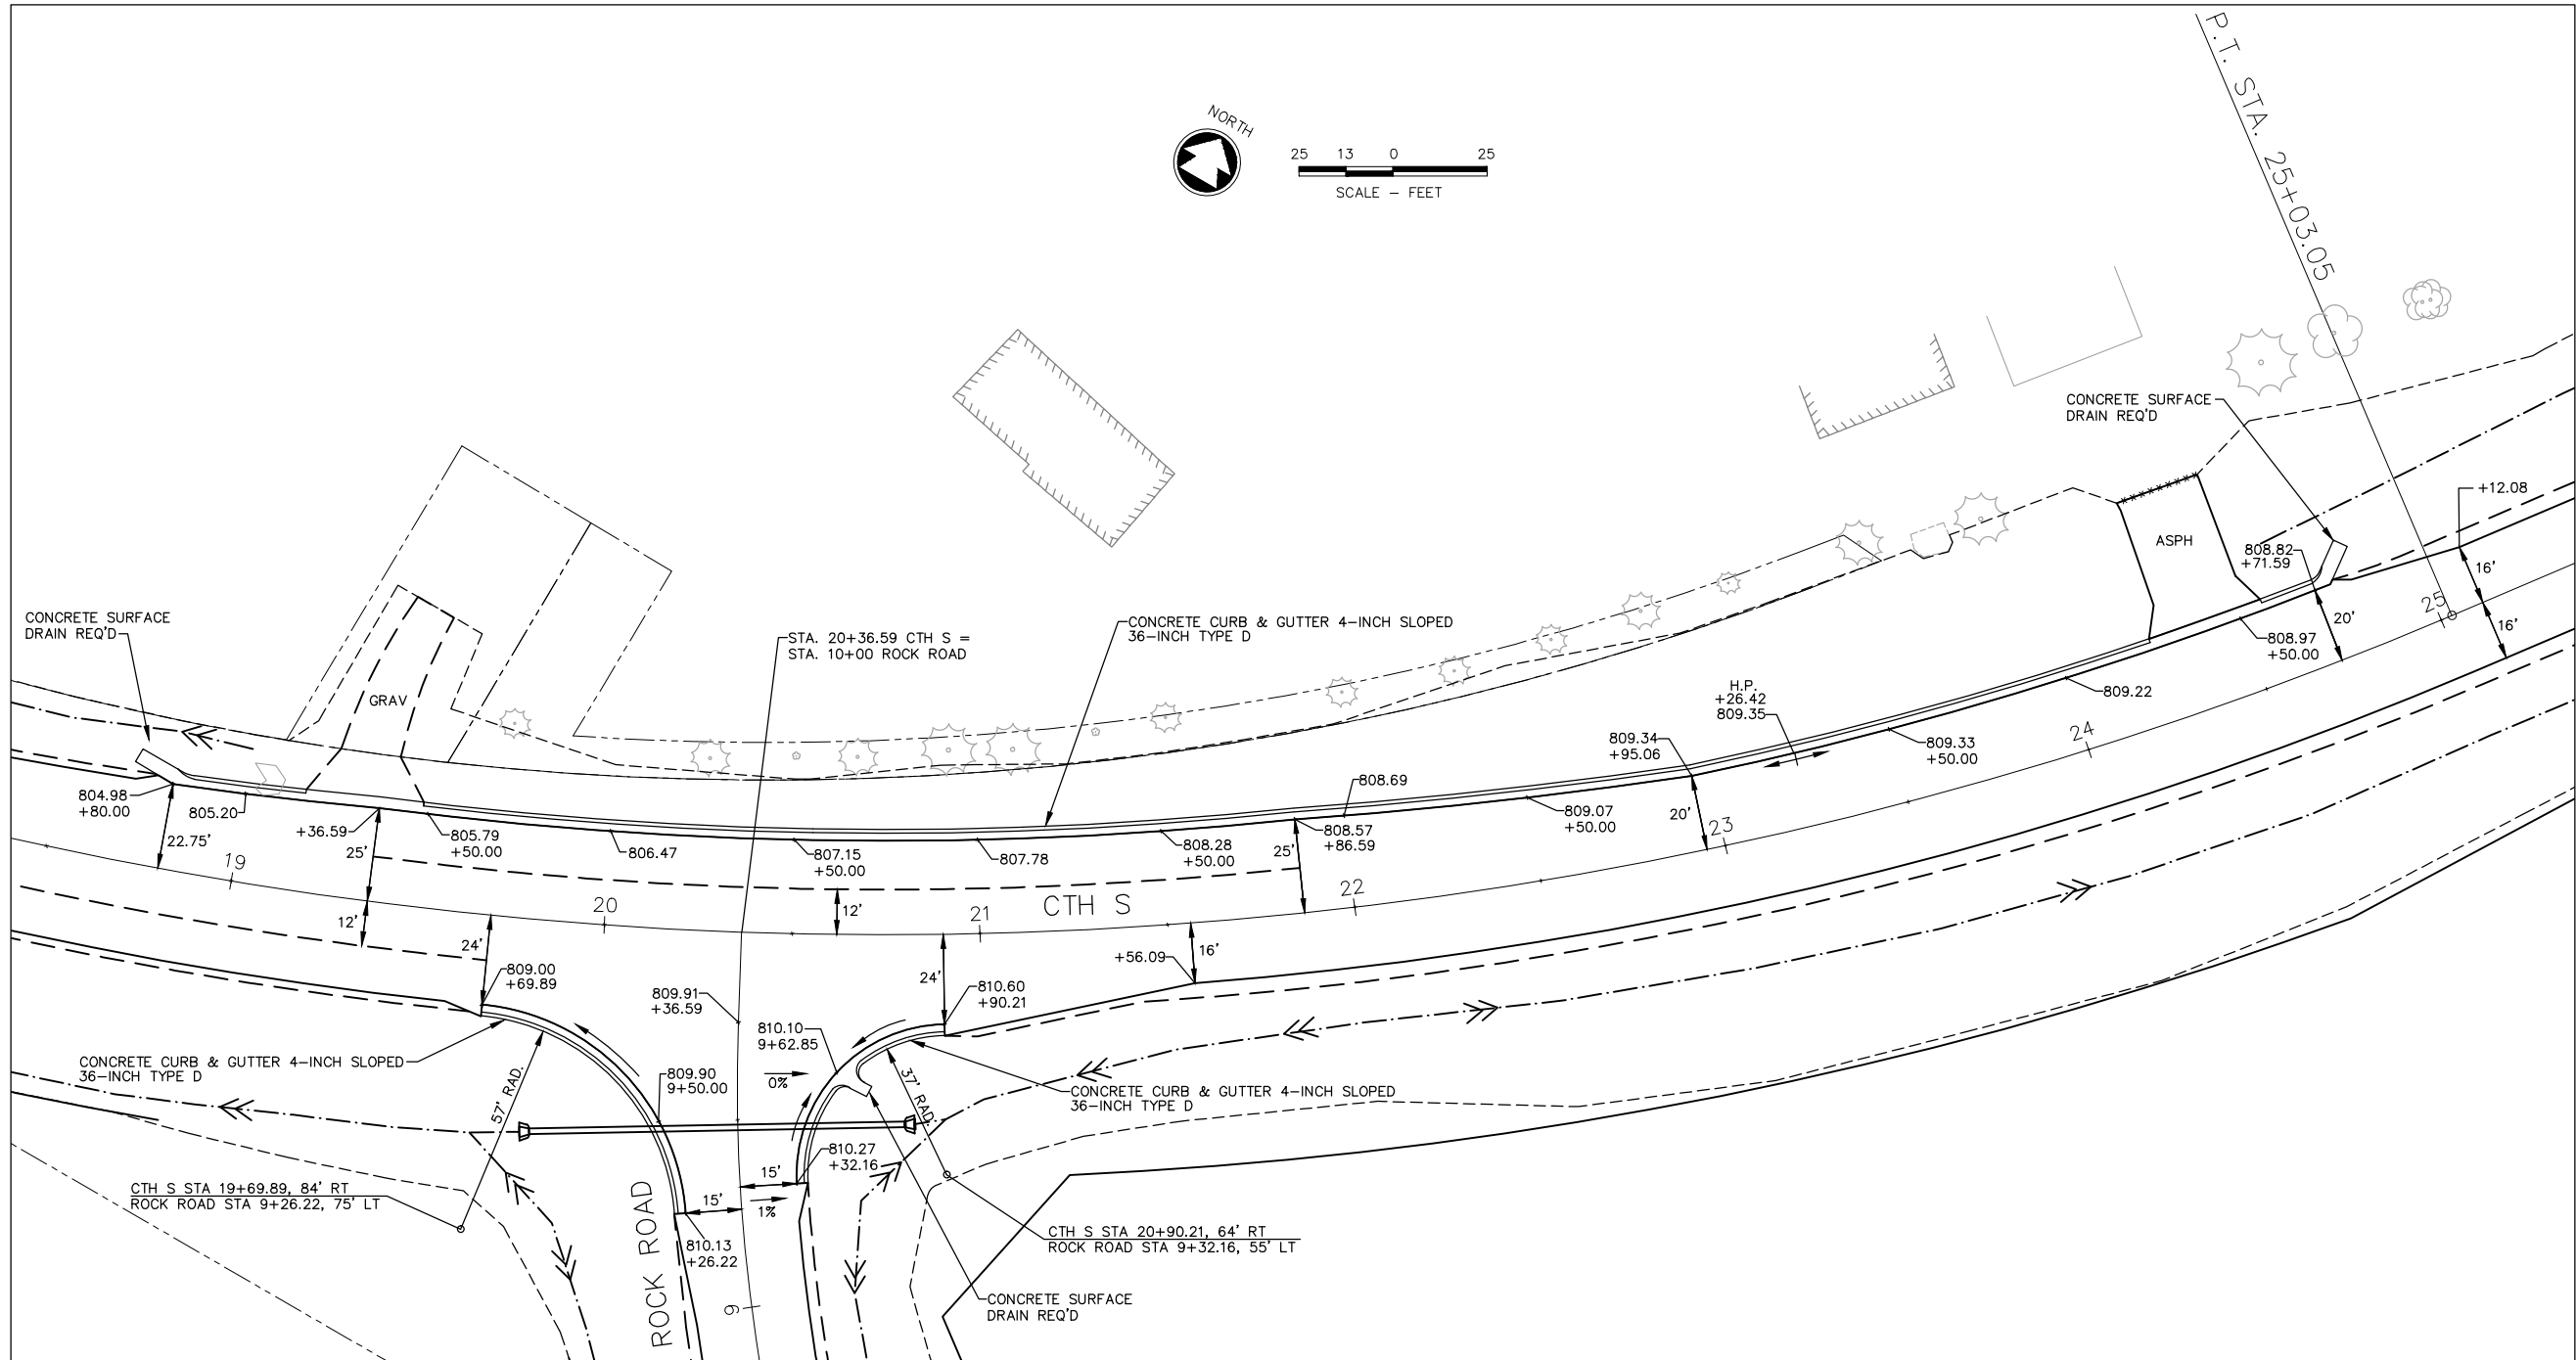


McMahon provides this drawing and data, regardless of form, as instruments of service, and the user agrees to hold McMahon harmless from and defend McMahon from any and all claims, damages, costs and expenses, including reasonable attorneys' fees, that may be asserted against McMahon by any third party, in any way, arising out of or from the use of this drawing and data, whether or not such claims, damages, costs and expenses are caused in whole or in part by the negligence of McMahon. The client and/or user agrees to hold McMahon harmless from and defend McMahon from any and all claims, damages, costs and expenses, including reasonable attorneys' fees, that may be asserted against McMahon by any third party, in any way, arising out of or from the use of this drawing and data, whether or not such claims, damages, costs and expenses are caused in whole or in part by the negligence of McMahon.

NO.	DATE	REVISION

CTH 'S' (STH 76 - KELLY ROAD)
OUTAGAMIE COUNTY, WISCONSIN
PAVING DETAILS

DESIGNED MPK	DRAWN MPK
PROJECT NO. 00006 910308	
DATE FEBRUARY, 2014	
SHEET NO. 17A	

 rmkohlbeck, W:\PROJECTS\00006\910308\08-Design\Paving Details\18 REXFORD ROAD CUL DE SAC DETAIL.dwg, 18 rexford road cul de sac detail, Plot Date: 4/12/2014 2:53 PM, xrefs: (x= cth s paving detail)



McMahon provides this drawing and data, regardless of form; as instruments of service. All rights including copyrights are retained by McMahon. The client and/or recipient agrees to the fullest extent permitted by law to indemnify and hold McMahon harmless for any reuse of changes made to the original drawing or data without prior written consent by McMahon.

CTH 'S' (STH 76 – KELLY ROAD)
 OUTAGAMIE COUNTY, WISCONSIN
 REXFORD ROAD CUL DE SAC DETAIL


DESIGNED MPK	DRAWN MPK
PROJECT NO. 00006 910308	
DATE FEBRUARY, 2014	
SHEET NO. 18	

DESIGNED MPK	DRAWN MPK
PROJECT NO. 00006 910308	
DATE FEBRUARY, 2014	
SHEET NO. 18	

m:\hoback\w:\PROJECTS\00006\910308\10-DNR\WQC\19. EROSION & SEDIMENT CONTROL PLAN DETAIL.dwg, 19. erosion & sediment control plan detail, Plot Date: 5/14/2014 11:02 AM, xrefs: (x-cth s topo, x-proposed cth s revised, x- cth s ec plan, rw comps dew, x-line 26, 2013


EROSION & SEDIMENT CONTROL PLAN NOTES

- REFER TO THE "ABBREVIATIONS, SYMBOLS & NOTES" PLAN SHEET (SHEET 01) FOR ADDITIONAL EROSION & SEDIMENT CONTROL PLAN NOTES.
- CONSTRUCT TEMPORARY SEDIMENT TRAPS PRIOR TO ANY GROUND DISTURBING OPERATIONS. TEMPORARILY DIRECT EXISTING DITCH FLOWLINES TO THE TEMPORARY SEDIMENT TRAPS UNTIL THE PROPOSED DITCH LINES ARE CONSTRUCTED.
- TEMPORARY DITCH CHECKS SHALL BE INSTALLED AFTER STRIPPING THE TOPSOIL AND MAINTAINED DURING ALL GROUND DISTURBING OPERATIONS.
- INSTALL ONE TEMPORARY DITCH CHECK FOR EVERY TWO FEET OF DROP IN THE DITCH.
- EROSION MAT SHALL BE INSTALLED IMMEDIATELY AFTER PLACEMENT OF SALVAGED TOPSOIL.
- RIPRAP MEDIUM SHALL BE INSTALLED IMMEDIATELY FOLLOWING CULVERT INSTALLATION.
- AREAS BETWEEN THE BACK OF CURB AND THE SLOPE INTERCEPTS AND THE EDGE OF GRAVEL SHOULDER AND THE SLOPE INTERCEPTS SHALL BE SEEDED, FERTILIZED AND MULCHED IMMEDIATELY AFTER PLACEMENT OF TOPSOIL. EROSION MAT SHALL BE INSTALLED AT THIS TIME IF REQUIRED.
- STONE TRACKING PADS SHALL BE INSTALLED AT ALL POINTS OF CONSTRUCTION EGRESS. LOCATIONS ARE TO BE DETERMINED AT THE TIME OF CONSTRUCTION.

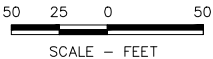

LEGEND

- ① SILT FENCE
- ② EROSION MAT, CLASS I, TYPE B
- ③ EROSION MAT, CLASS II, TYPE B
- ④ RIPRAP, MEDIUM WITH GEOTEXTILE FABRIC, TYPE HR (PERMANENT)
- ⑤ TEMPORARY DITCH CHECKS (HAY BALES OR APPROVED ALTERNATIVES)
- ⑥ STONE DITCH CHECKS OR ROCK FILTER BAGS
- ⑦ INLET PROTECTION, TYPE C
- ⑧ TRACKING PAD

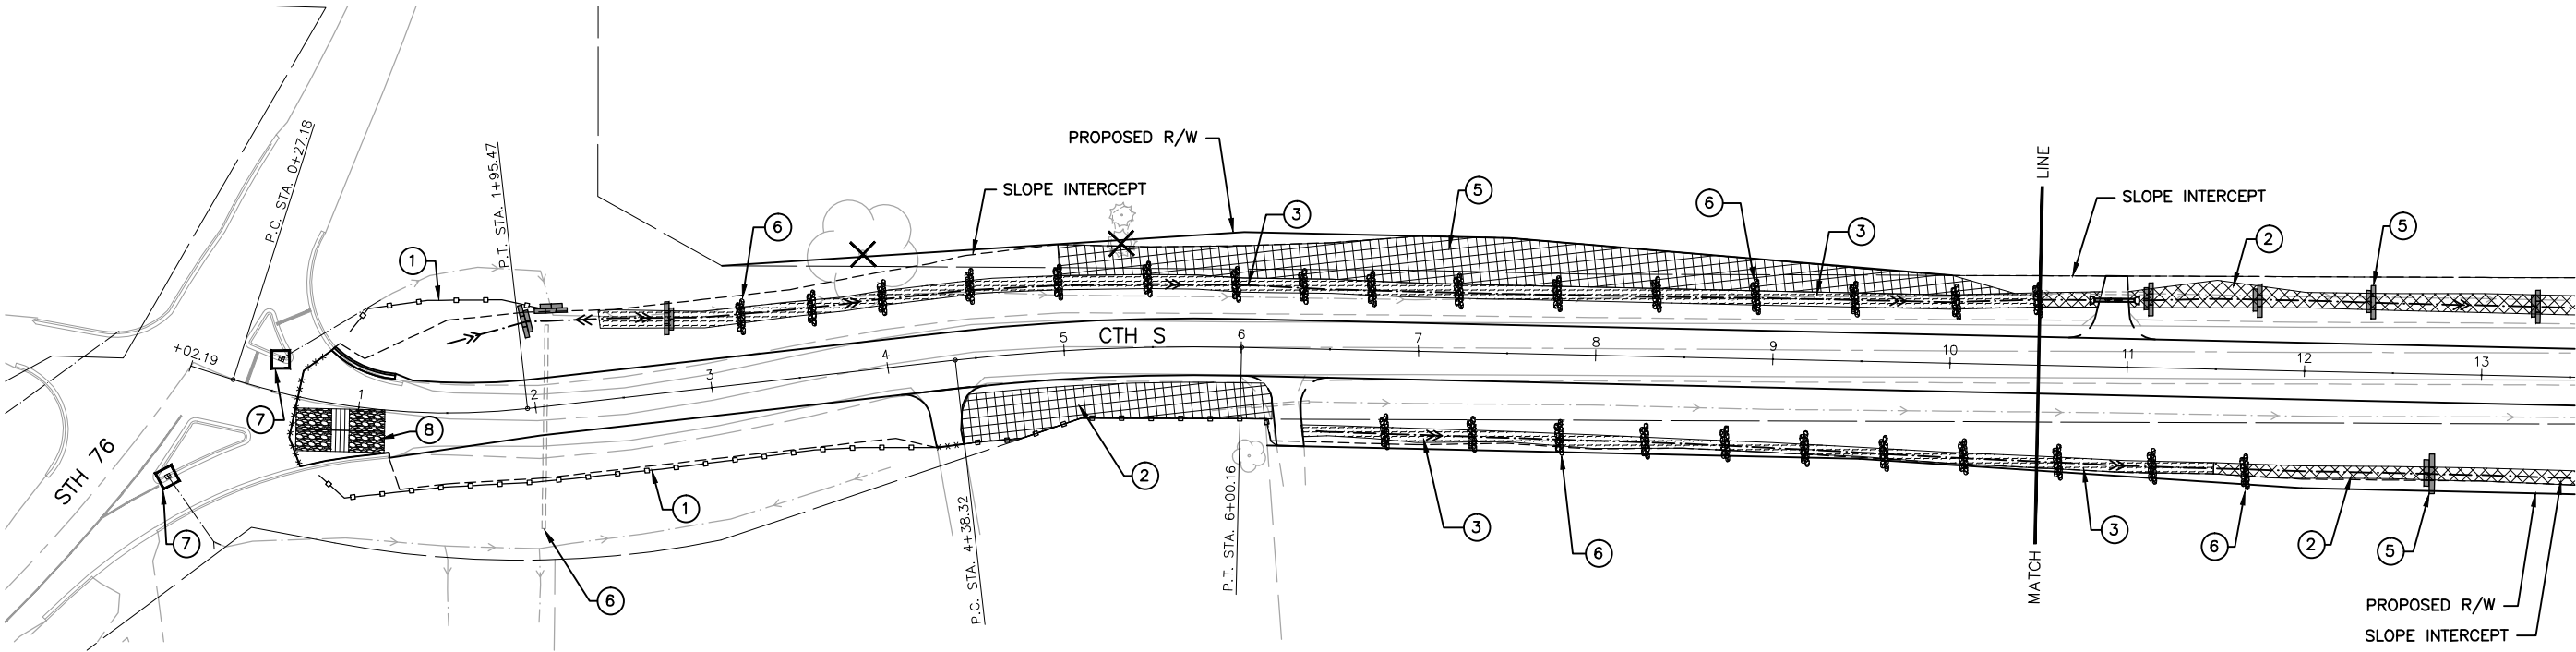

PROJECT DESCRIPTION

THE SITE IS LOCATED ALONG THE CORRIDOR OF CTH 'S' IN THE TOWN OF ELLINGTON, SECTION 16, T22N, R16E, TOWN OF ELLINGTON, OUTAGAMIE COUNTY, WISCONSIN. THE PROJECT BEGINS AT THE EAST APPROACH OF THE CTH 'S' AND STH 76 INTERSECTION AND EXTENDS EAST 6,405 FEET TO THE INTERSECTION OF KELLY ROAD AND CTH 'S'.

THE PROJECT CONSISTS OF RECONSTRUCTING THE 1.213 MILE SEGMENT OF CTH 'S' TO CORRECT A SUBSTANDARD HORIZONTAL CURVE AND TO UPGRADE THE SUBSTANDARD ROADWAY CROSS SECTION TO CURRENT OUTAGAMIE COUNTY HIGHWAY DEPARTMENT STANDARDS. THE PURPOSE OF THE PROJECT IS TO IMPROVE PUBLIC SAFETY FOR THOSE TRAVELING THIS SEGMENT OF CTH 'S'. THE PROJECT IS CURRENTLY SCHEDULED TO BE CONSTRUCTED IN 2014.

THE EXISTING FACILITY CONSISTS OF TWO 12-FT TRAVEL LANES AND 6-FT SHOULDERS OF WHICH 3 FEET ARE PAVED. THE EXISTING ROADSIDE DITCHES ARE DEEP AND THE DITCH INSLOPES ARE STEEP. AS PART OF THE RECONSTRUCTION THE ROADWAY WILL BE WIDENED TO TWO 12-FT TRAVEL LANES AND 8-FOOT SHOULDERS OF WHICH 4 FEET WILL BE PAVED. THE STEEP DITCH INSLOPES WILL BE FLATTENED. IN ADDITION, TO ADDRESS SUBSTANDARD AND UNSAFE HORIZONTAL CURVES, PORTIONS OF THE ROADWAY WILL REALIGNED. THE LARGEST SUCH REALIGNMENT WILL OCCUR JUST EAST OF THE ROCK ROAD INTERSECTION. THE ROADWAY NEAR THIS INTERSECTION WILL BE REALIGNED BY AS MUCH AS 26-FEET TO THE SOUTHEAST.

THE TOTAL LAND DISTURBANCE ASSOCIATED WITH THIS PROJECT IS 17 ACRES. WETLANDS ARE PRESENT WITHIN THE THE PROJECT LIMITS PRIMARILY WITHIN THE EXISTING ROADSIDE DITCHES. THE ROADWAY WIDENING, REQUIRED TO BRING THE ROADWAY UP TO CURRENT COUNTY STANDARDS, WILL IMPACT WETLANDS AS SHOWN IN THE PLAN. WETLAND AREAS THAT WILL BE FILLED AS PART OF THE PROJECT WILL BE FILLED WITH SUITABLE EXCAVATED MATERIALS FROM THE PROJECT.

RUNOFF FROM CTH 'S' IS CURRENTLY DRAINED VIA VEGETATED DITCHES/SWALES. THE DITCHES/SWALES CONVEY THE STORMWATER RUNOFF INTO LARGER DRAINAGE WAYS THAT EVENTUALLY DRAIN INTO TRIBUTARIES TO BEAR CREEK AND THE WOLF RIVER. THE WOLF RIVER IS A 303D LISTED WATERBODY.

SOIL INFORMATION WAS OBTAINED FROM NRCS SOIL SURVEY MAP. THE PROJECT AREA CONTAINS HORTONVILLE SILT LOAM, KEWAUNEE SILT LOAM, MANAWA SILTY CLAY LOAM, MENOMINEE LOAMY FINE SAND, POYGAN SILTY CLAY LOAM, AND WINNECONNE SILTY CLAY LOAM.

BEDROCK IS NOT ANTICIPATED TO BE ENCOUNTERED DURING CONSTRUCTION. GROUNDWATER IS NOT ANTICIPATED TO BE ENCOUNTERED DURING CONSTRUCTION.

SEQUENCE OF CONSTRUCTION:

- THE FOLLOWING IS OUTAGAMIE COUNTY'S ANTICIPATED SEQUENCE OF CONSTRUCTION OPERATIONS:
- 1) POST PERMITS. NOTIFY THE DNR AT LEAST 5 DAYS PRIOR TO THE START OF CONSTRUCTION.
 - 2) INSTALL INLET PROTECTION AND TEMPORARY DITCH CHECKS IN THE EXISTING DITCH FLOWLINES AND TEMPORARY SEDIMENT TRAPS IN PROPOSED DITCH FLOWLINES PRIOR TO ANY LAND DISTURBANCE.
 - 3) PULVERIZE THE EXISTING ASPHALT WITHIN THE PROJECT LIMITS AND LEAVE IN PLACE.
 - 4) CONSTRUCT THE ROADWAY SUBGRADE AND ROADWAY BASE AGGREGATE IN TWO PHASES.
 - A. PHASE 1 - STA. 0+65.00 TO APPROXIMATELY STA. 30+00
 1. REMOVE PULVERIZED ASPHALT AND EXISTING GRAVEL BASE AND STOCKPILE ON SITE. MAINTAIN VEHICULAR ACCESS FOR LOCAL TRAFFIC.
 2. INSTALL TRACKING PADS AND EROSION CONTROL MEASURES AS SHOWN ON THE PLAN BEFORE BEGINNING LAND DISTURBING ACTIVITIES. ITEMS INCLUDE BUT ARE NOT LIMITED TO SILT FENCE, CULVERT PIPE CHECKS, AND TEMPORARY DITCH CHECKS.
 3. STRIP TOPSOIL FROM DITCHES. STOCKPILE TOPSOIL ON SITE. RE-INSTALL TEMPORARY DITCH CHECKS IN THE DITCH LINES AFTER TOPSOIL HAS BEEN STRIPPED.
 4. EXCAVATE, WIDEN THE ROADWAY, AND SHAPE THE ROADWAY SUBGRADE AND DITCHES. INSTALL CROSS DRAINS AND DRIVEWAY CULVERTS. INSTALL CULVERT PIPE CHECKS AND RIP RAP AS SHOWN ON THE PLAN. CONSTRUCT FILL EMBANKMENTS FROM MATERIALS EXCAVATED ON THE PROJECT. EXCAVATED MATERIAL NOT USED THE PROJECT WILL BE LOADED ON TRUCKS AND HAULED TO AN OFFSITE LOCATION TO BE SELECTED BY THE COUNTY. ONCE THE ULTIMATE TYPICAL SECTION IS COMPLETED, RE-INSTALL TEMPORARY DITCH CHECKS IN THE NEW DITCH FLOWLINE PER PER THE PLAN.
 5. FINE GRADE DITCHES AND INSTALL SALVAGED TOPSOIL, SEED, FERTILIZER, MULCH, RIPRAP, AND EROSION MAT. UPON COMPLETION OF THESE ITEMS RE-INSTALL TEMPORARY DITCH CHECKS.
 6. PLACE AND SHAPE SALVAGED GRAVEL BASE AND VIRGIN BASE MATERIAL FOR THE ROADWAY AS THE ROADWAY SUBGRADE IS COMPLETED AND APPROVED.
 - B. PHASE 2 - APPROXIMATELY STA. 30+00.00 TO STA. 64+70.00
 1. CONSTRUCT THE SAME AS 1 - 7 ABOVE.
 - 5) INSTALL CONCRETE CURB & GUTTER AND PLACE RIP RAP AT CONCRETE SURFACE DRAIN LOCATIONS.
 - 6) PLACE ASPHALT PAVEMENT AND SHOULDERING MATERIAL.
 - 7) INSTALL PERMANENT SIGNING AND PAVEMENT MARKINGS.
 - 8) THE PROJECT END DATE IS ESTIMATED TO BE OCTOBER 15, 2014.
 - 8) REMOVE EROSION CONTROL MEASURES AFTER SOIL IS AT LEAST 80% STABILIZED.

STORMWATER MANAGEMENT PLAN:

- IN ACCORDANCE WITH NR 216.47, A STORM WATER MANAGEMENT PLAN IS REQUIRED.
- 1) PERFORMANCE STANDARDS:
 - A. CONSTRUCTION SITE PERFORMANCE STANDARDS: PLEASE REFER TO THE EROSION CONTROL PLAN. (PLAN SHEETS 19 THROUGH 24)
 - B. POST CONSTRUCTION PERFORMANCE STANDARDS: EXEMPT PER NR 151.24(1)(D). THE CTH 'S' RECONSTRUCTION PROJECT IS EXEMPT FROM POST-CONSTRUCTION PERFORMANCE STANDARDS PER NR 151.24 (1)(D). MINOR RECONSTRUCTION OF A HIGHWAY, NOTWITHSTANDING THE PROTECTIVE AREA REQUIREMENTS IN SUB. (6). "MINOR RECONSTRUCTION" PER NR 151.21(5) IS DEFINED AS RECONSTRUCTION THAT IS LIMITED TO 1.5 MILES IN CONTINUOUS OR AGGREGATE TOTAL LENGTH OF REALIGNMENT AND THAT DOES NOT EXCEED 100 FEET IN WIDTH OF ROADBED WIDENING, AND THAT DOES NOT INCLUDE REPLACEMENT OF A VEGETATED DRAINAGE SYSTEM WITH A NON-VEGETATED DRAINAGE SYSTEM EXCEPT WHERE NECESSARY TO CONVEY RUNOFF UNDER A HIGHWAY, OR PRIVATE ROAD OR DRIVEWAY.
 - 2) PRACTICES DURING CONSTRUCTION: PLEASE REFER TO THE EROSION CONTROL PLAN. (PLAN SHEETS 19 THROUGH 24)
 - 3) GROUNDWATER LIMITATIONS: NOT APPLICABLE. PERMANENT INFILTRATION SYSTEMS WILL NOT BE PART OF THIS PROJECT.
 - 4) SEPARATION DISTANCES: NOT APPLICABLE. STORM WATER MANAGEMENT FEATURES BEYOND THE VEGETATED DRAINAGE SYSTEM WILL NOT BE PART OF THIS PROJECT.
 - 5) LONG-TERM MAINTENANCE: NOT APPLICABLE
 - 6) MANAGEMENT PRACTICES: THE INTENT OF THE PROJECT IS TO MINIMIZE DISTURBANCE AND TO MAINTAIN VEGETATIVE PROTECTIVE BUFFERS ALONG AREAS OF DISTURBANCE. THE TYPICAL ROADWAY SECTION IS PROPOSED TO MAINTAIN VEGETATIVE BUFFERS WITH AREAS OF GRASSES SWALES TO MINIMIZE AND CONTRAOL THE IMPACTS OF STORM WATER RUNOFF.

McMAHON

ENGINEERS & ARCHITECTS

1445 McMAHON DRIVE NEENAH, WI 54956
Mailing: P.O. BOX 1025 NEENAH, WI 54957-1025
Tel: (920) 751-4200 Fax: (920) 751-4284
www.mcmgrp.com

McMAHON PROVIDES THIS DRAWING AS A SERVICE TO ITS CLIENTS. IT IS NOT TO BE USED FOR ANY OTHER PURPOSE. THE CLIENT AND/OR USER OF THIS DRAWING SHALL BE RESPONSIBLE FOR OBTAINING ALL NECESSARY PERMITS AND FOR THE ACCURACY OF THE INFORMATION PROVIDED. THE CLIENT AND/OR USER SHALL INDEMNIFY AND HOLD McMAHON HARMLESS FROM AND AGAINST ALL CLAIMS, DAMAGES, LOSSES AND EXPENSES, INCLUDING REASONABLE ATTORNEY'S FEES, INCURRED BY McMAHON AS A RESULT OF THE USE OF THIS DRAWING OR DATA WITHOUT PRIOR WRITTEN CONSENT BY McMAHON.


NO.	DATE	REVISION

CTH 'S' (STH 76 - KELLY ROAD)

OUTAGAMIE COUNTY, WISCONSIN

EROSION & SEDIMENT CONTROL PLAN DETAIL

DESIGNED	DRAWN
MPK	MPK
PROJECT NO. 00006 910308	
DATE FEBRUARY, 2014	
SHEET NO. 19	

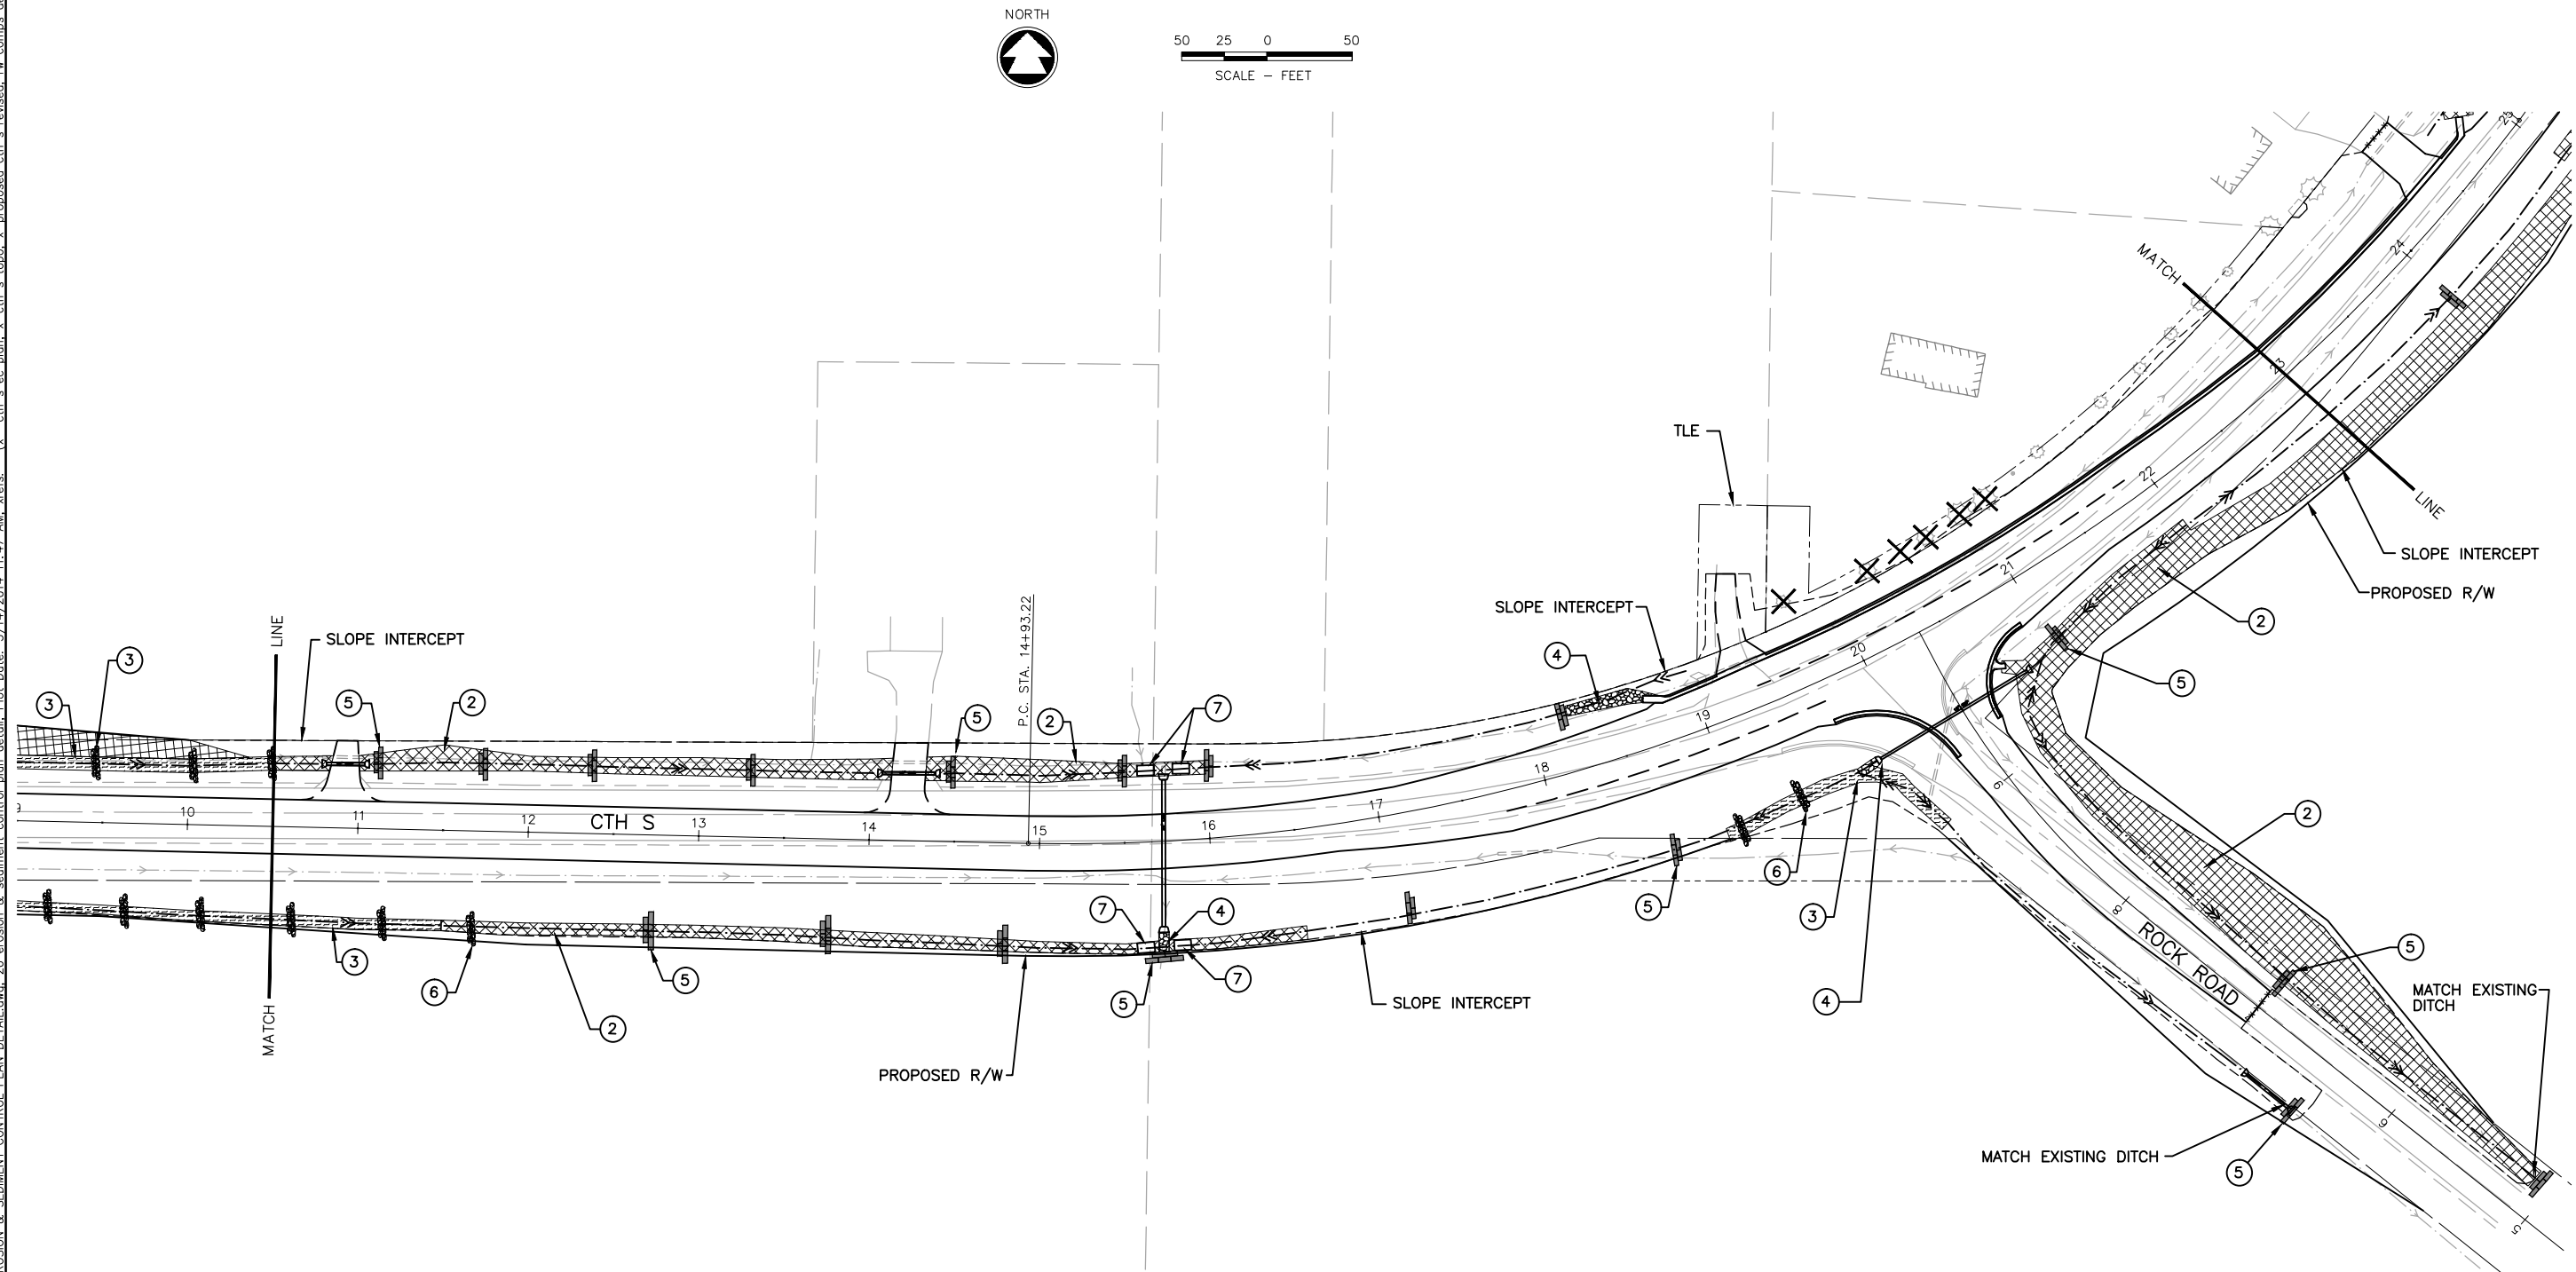


- ① SILT FENCE
- ② EROSION MAT, CLASS I, TYPE B
- ③ EROSION MAT, CLASS II, TYPE B
- ④ RIPRAP, MEDIUM WITH GEOTEXTILE FABRIC, TYPE HR (PERMANENT)
- ⑤ TEMPORARY DITCH CHECKS (HAY BALES OR APPROVED ALTERNATIVES)
- ⑥ STONE DITCH CHECKS OR ROCK FILTER BAGS
- ⑦ TEMPORARY SEDIMENT TRAP

[illegible]

CTH 'S' (STH 76 - KELLY ROAD)
OUTAGAMIE COUNTY, WISCONSIN
EROSION & SEDIMENT CONTROL PLAN DETAIL

DESIGNED MPK	DRAWN MPK
PROJECT NO. 00006 910308	
DATE FEBRUARY, 2014	
SHEET NO.	

w:\projects\00006\910308\10-DNR\WOC\21 EROSION & SEDIMENT CONTROL PLAN DETAIL.dwg, 21 erosion & sediment control plan detail, Plot Date: 5/14/2014 11:02 AM, xrefs:none

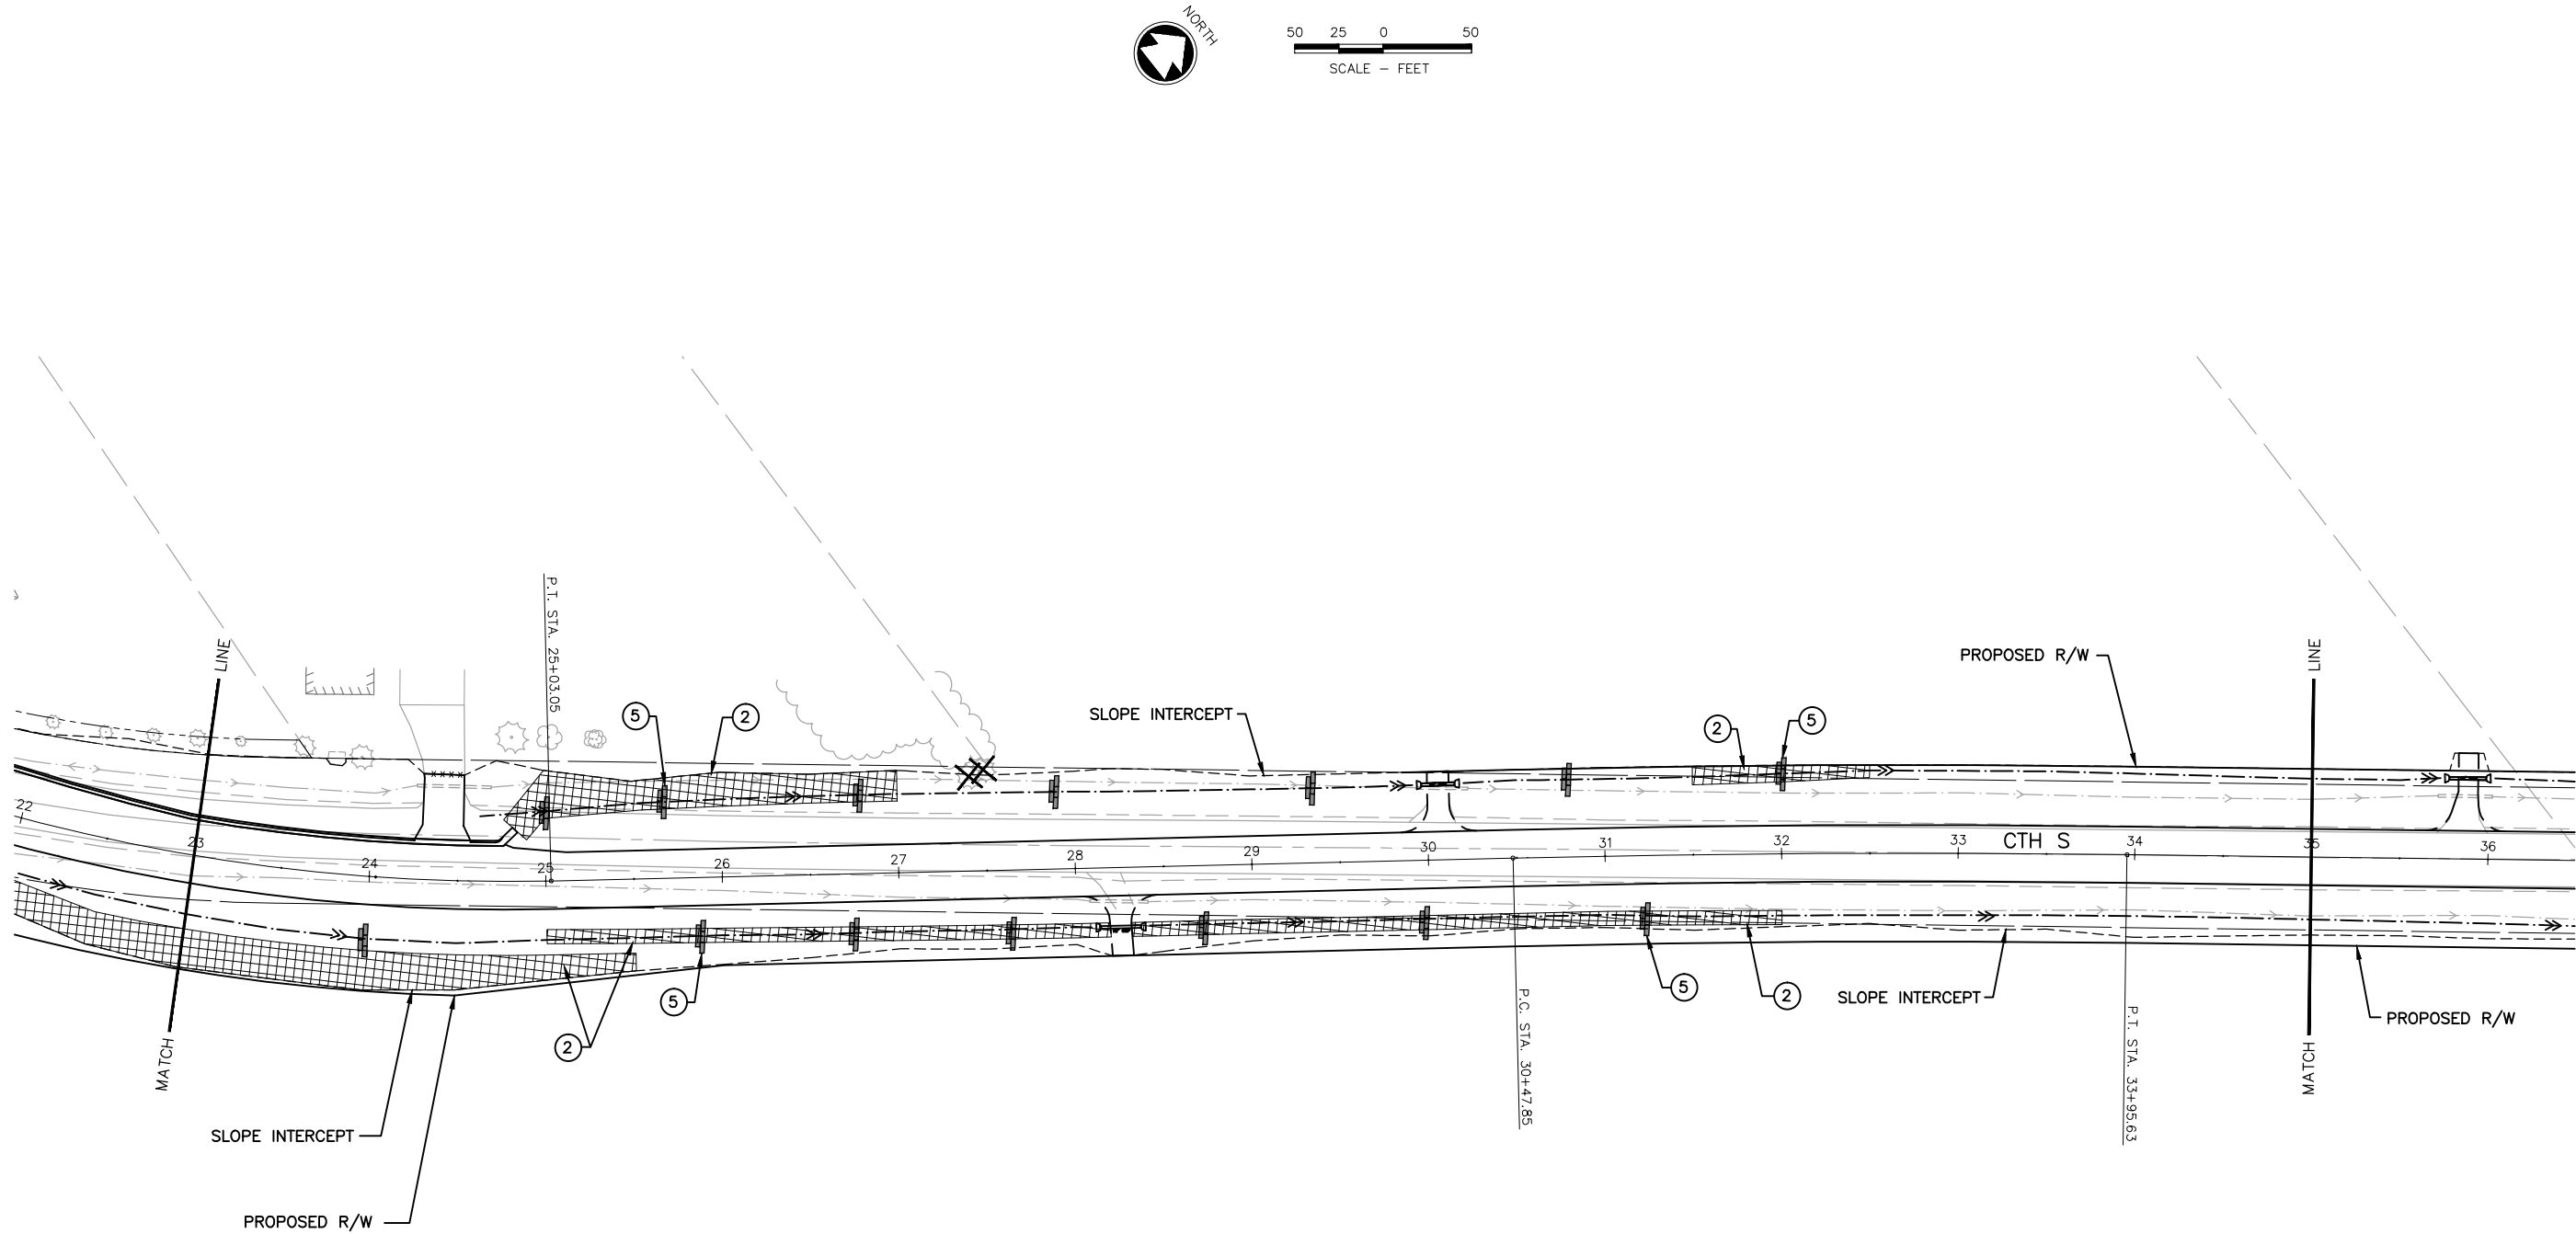


LEGEND	
①	SILT FENCE
②	EROSION MAT, CLASS I, TYPE B
③	EROSION MAT, CLASS II, TYPE B
④	RIPRAP, MEDIUM WITH GEOTEXTILE FABRIC, TYPE HR (PERMANENT)
⑤	TEMPORARY DITCH CHECKS (HAY BALES OR APPROVED ALTERNATIVES)
⑥	STONE DITCH CHECKS OR ROCK FILTER BAGS

McMAHON provides this drawing and data, regardless of form, as instruments of service. The client and/or user of this drawing and data shall be responsible for obtaining all necessary permits and for complying with all applicable laws and regulations. The client and/or user shall indemnify and hold McMAHON harmless from and against all claims, damages, costs and expenses, including reasonable attorneys' fees, arising out of or from the use of this drawing and data, whether or not such claims, damages, costs and expenses are caused in whole or in part by the negligence of McMAHON.

NO.	DATE	REVISION

CTH 'S' (STH 76 - KELLY ROAD) OUTAGAMIE COUNTY, WISCONSIN EROSION & SEDIMENT CONTROL PLAN DETAIL	
DESIGNED MPK	DRAWN MPK
PROJECT NO. 00006 910308	
DATE FEBRUARY, 2014	
SHEET NO. 21	

w:\projects\00006\910308\10-DNR_WOC\22 EROSION & SEDIMENT CONTROL PLAN DETAIL.dwg, 22 erosion & sediment control plan detail, Plot Date: 5/14/2014 11:02 AM, xrefs:none

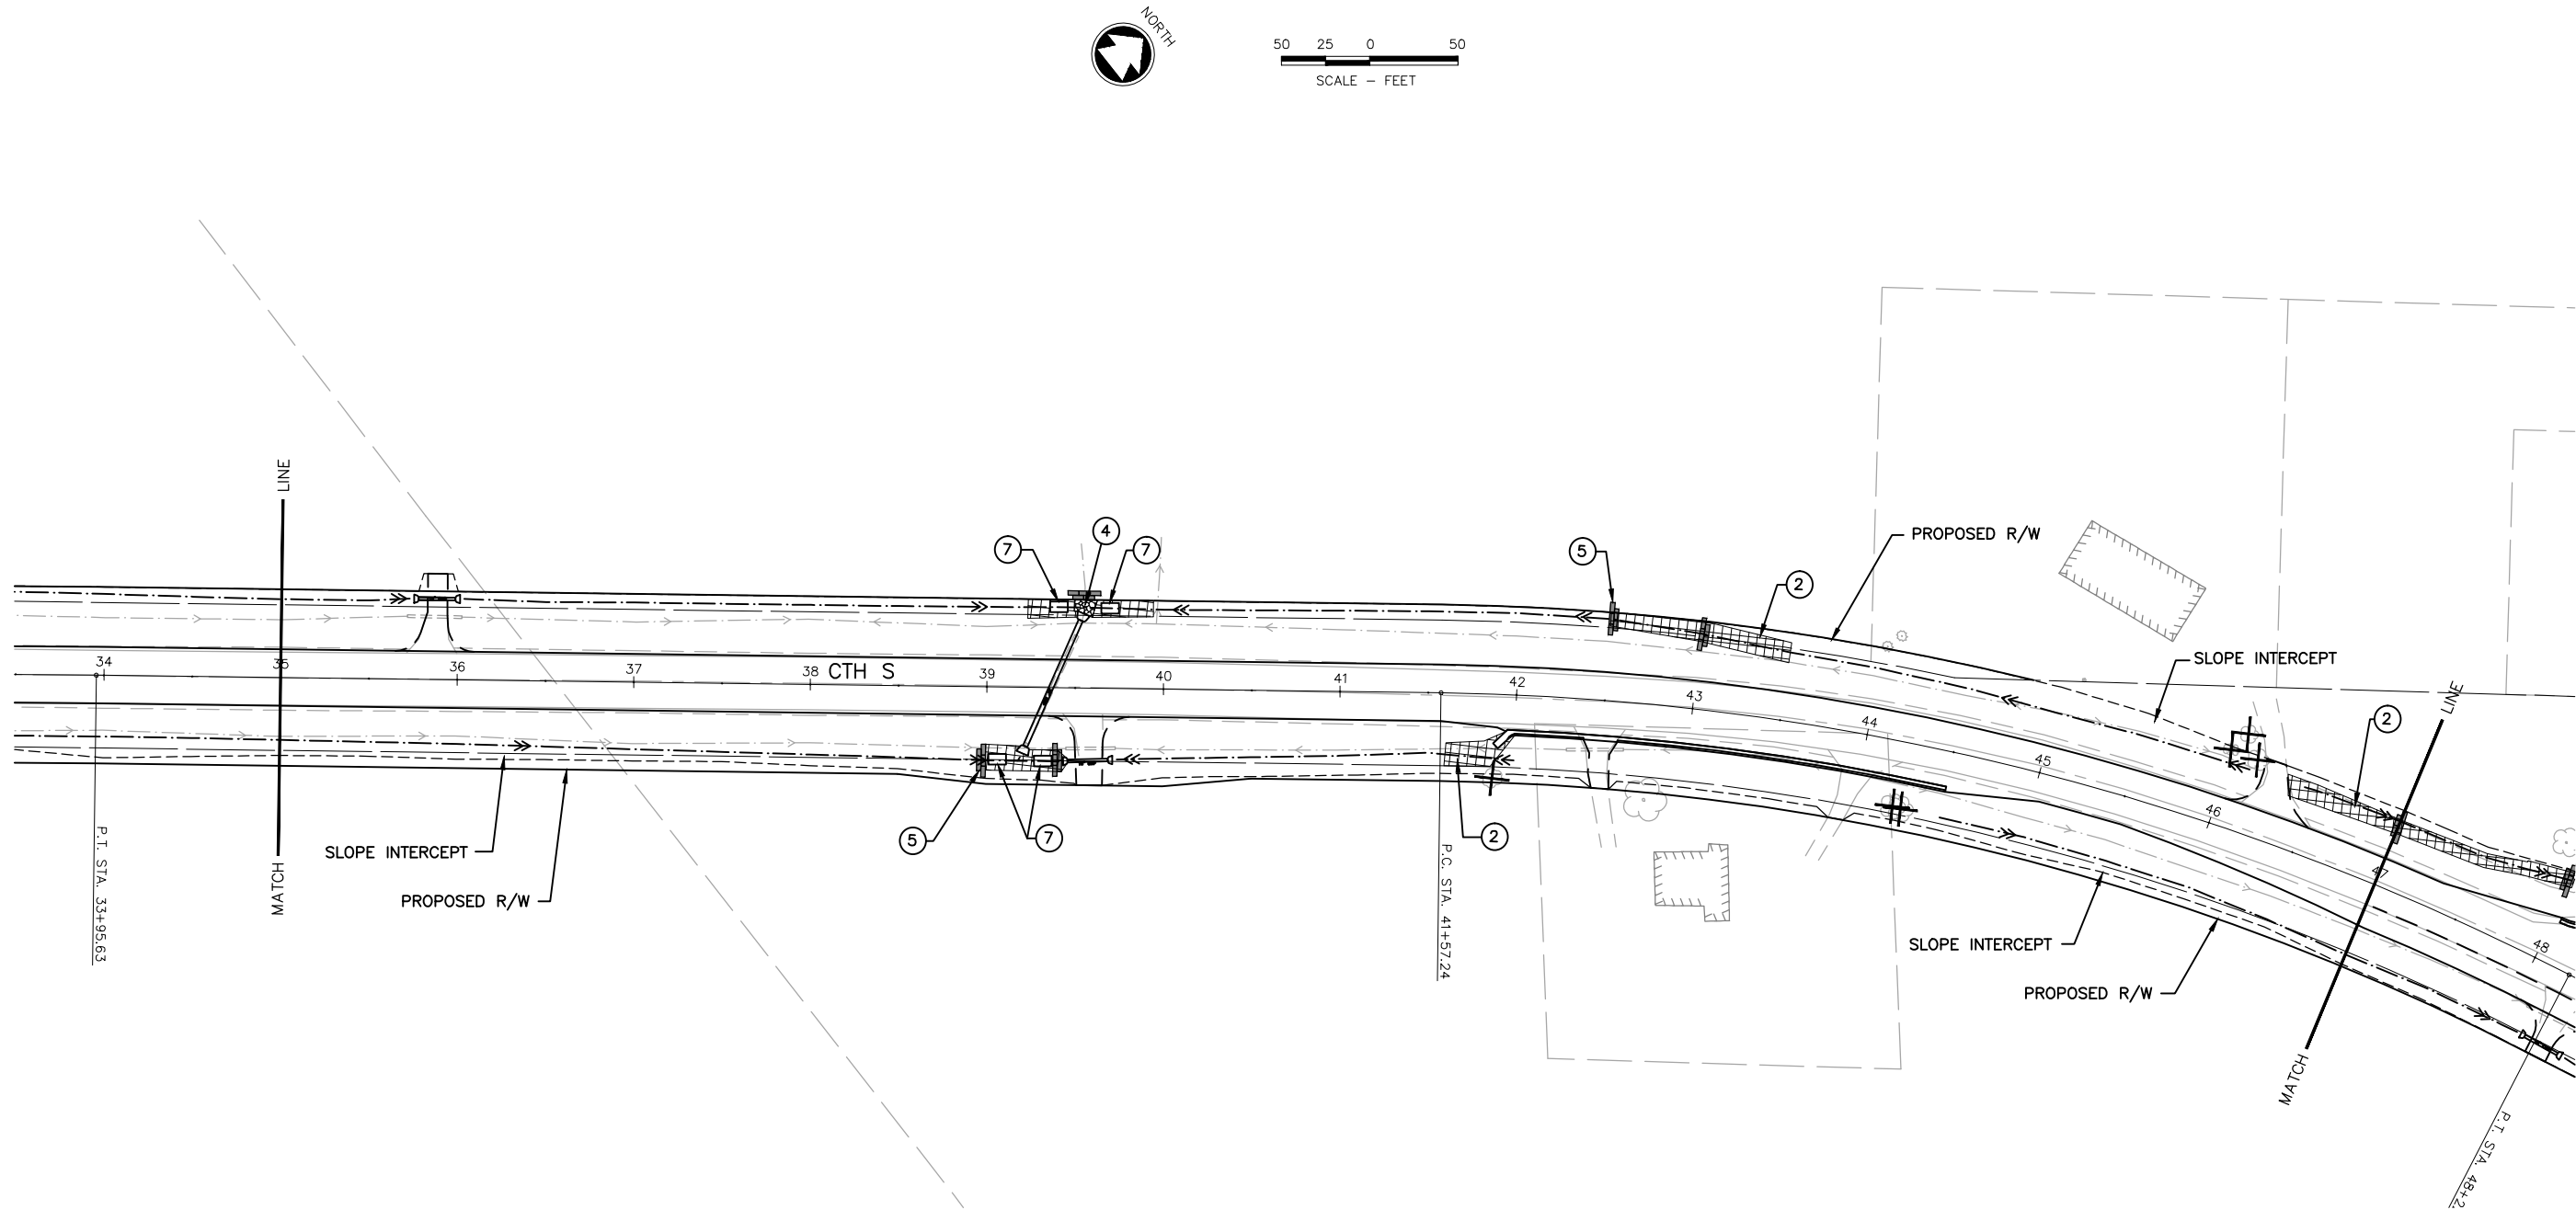



LEGEND	
①	SILT FENCE
②	EROSION MAT, CLASS I, TYPE B
③	EROSION MAT, CLASS II, TYPE B
④	RIPRAP, MEDIUM WITH GEOTEXTILE FABRIC, TYPE HR (PERMANENT)
⑤	TEMPORARY DITCH CHECKS (HAY BALES OR APPROVED ALTERNATIVES)
⑥	STONE DITCH CHECKS OR ROCK FILTER BAGS
⑦	TEMPORARY SEDIMENT TRAP

McMAHON provides this drawing and data, regardless of form, as instruments of service. The client and/or user of this drawing shall be responsible for obtaining all necessary permits and for complying with all applicable laws and regulations. The client and/or user shall indemnify and hold McMAHON harmless from and against all claims, damages, costs and expenses, including reasonable attorneys' fees, arising out of or from the use of this drawing or data without prior written consent by McMAHON.

NO.	DATE	REVISION

CTH 'S' (STH 76 - KELLY ROAD) OUTAGAMIE COUNTY, WISCONSIN EROSION & SEDIMENT CONTROL PLAN DETAIL	
DESIGNED MPK	DRAWN MPK
PROJECT NO. 00006 910308	
DATE FEBRUARY, 2014	
SHEET NO. 22	

w:\projects\00006\910308\10-DNR_WOC\23 EROSION & SEDIMENT CONTROL PLAN DETAIL.dwg, 23 erosion & sediment control plan detail, Plot Date: 5/14/2014 11:02 AM, xref:none

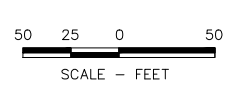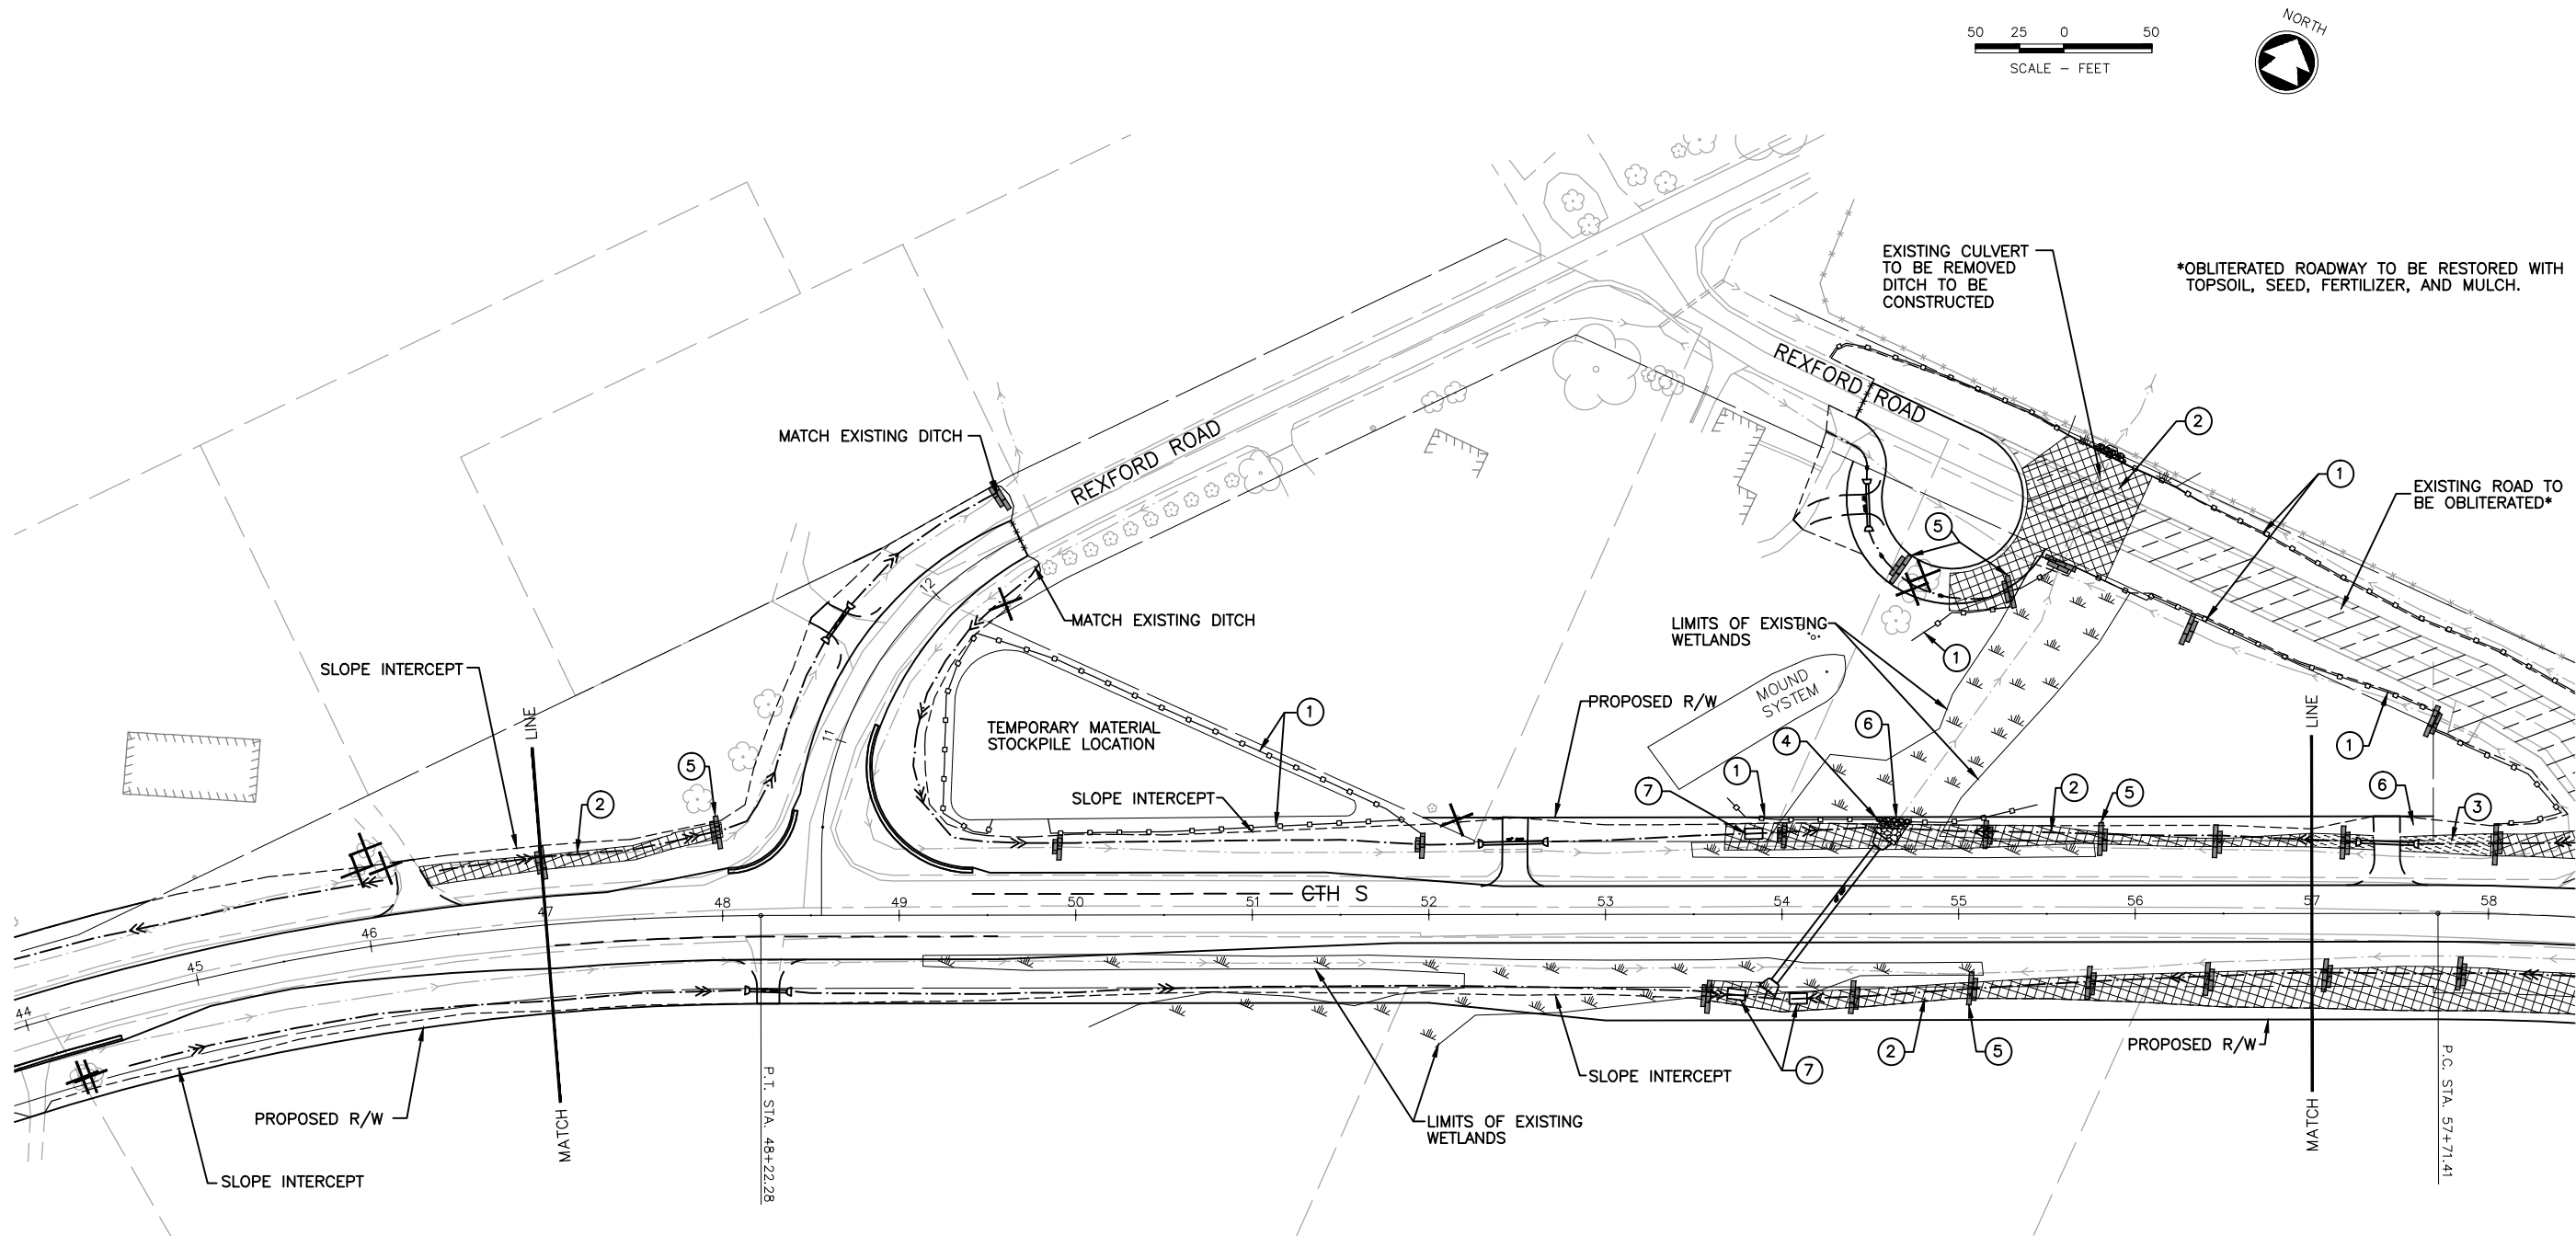

LEGEND	
①	SILT FENCE
②	EROSION MAT, CLASS I, TYPE B
③	EROSION MAT, CLASS II, TYPE B
④	RIPRAP, MEDIUM WITH GEOTEXTILE FABRIC, TYPE HR (PERMANENT)
⑤	TEMPORARY DITCH CHECKS (HAY BALES OR APPROVED ALTERNATIVES)
⑥	STONE DITCH CHECKS OR ROCK FILTER BAGS
⑦	TEMPORARY SEDIMENT TRAP


McMAHON provides this drawing and data, regardless of form, as instruments of service. The client and/or user shall be responsible for obtaining all necessary permits, licenses, and approvals. The client and/or user shall indemnify and hold McMAHON harmless from and against all claims, damages, and expenses, including reasonable attorneys' fees, arising out of or from the use of this drawing or data without prior written consent by McMAHON.

NO.	DATE	REVISION

CTH 'S' (STH 76 - KELLY ROAD)
OUTAGAMIE COUNTY, WISCONSIN
EROSION & SEDIMENT CONTROL PLAN DETAIL

DESIGNED MPK	DRAWN MPK
PROJECT NO. 00006 910308	
DATE FEBRUARY, 2014	
SHEET NO.	

w:\projects\00006\910308\10-DNR_WOC\24 EROSION & SEDIMENT CONTROL PLAN DETAIL.dwg, 24. erosion & sediment control plan detail, Plot Date: 5/14/2014 11:02 AM, xref:none

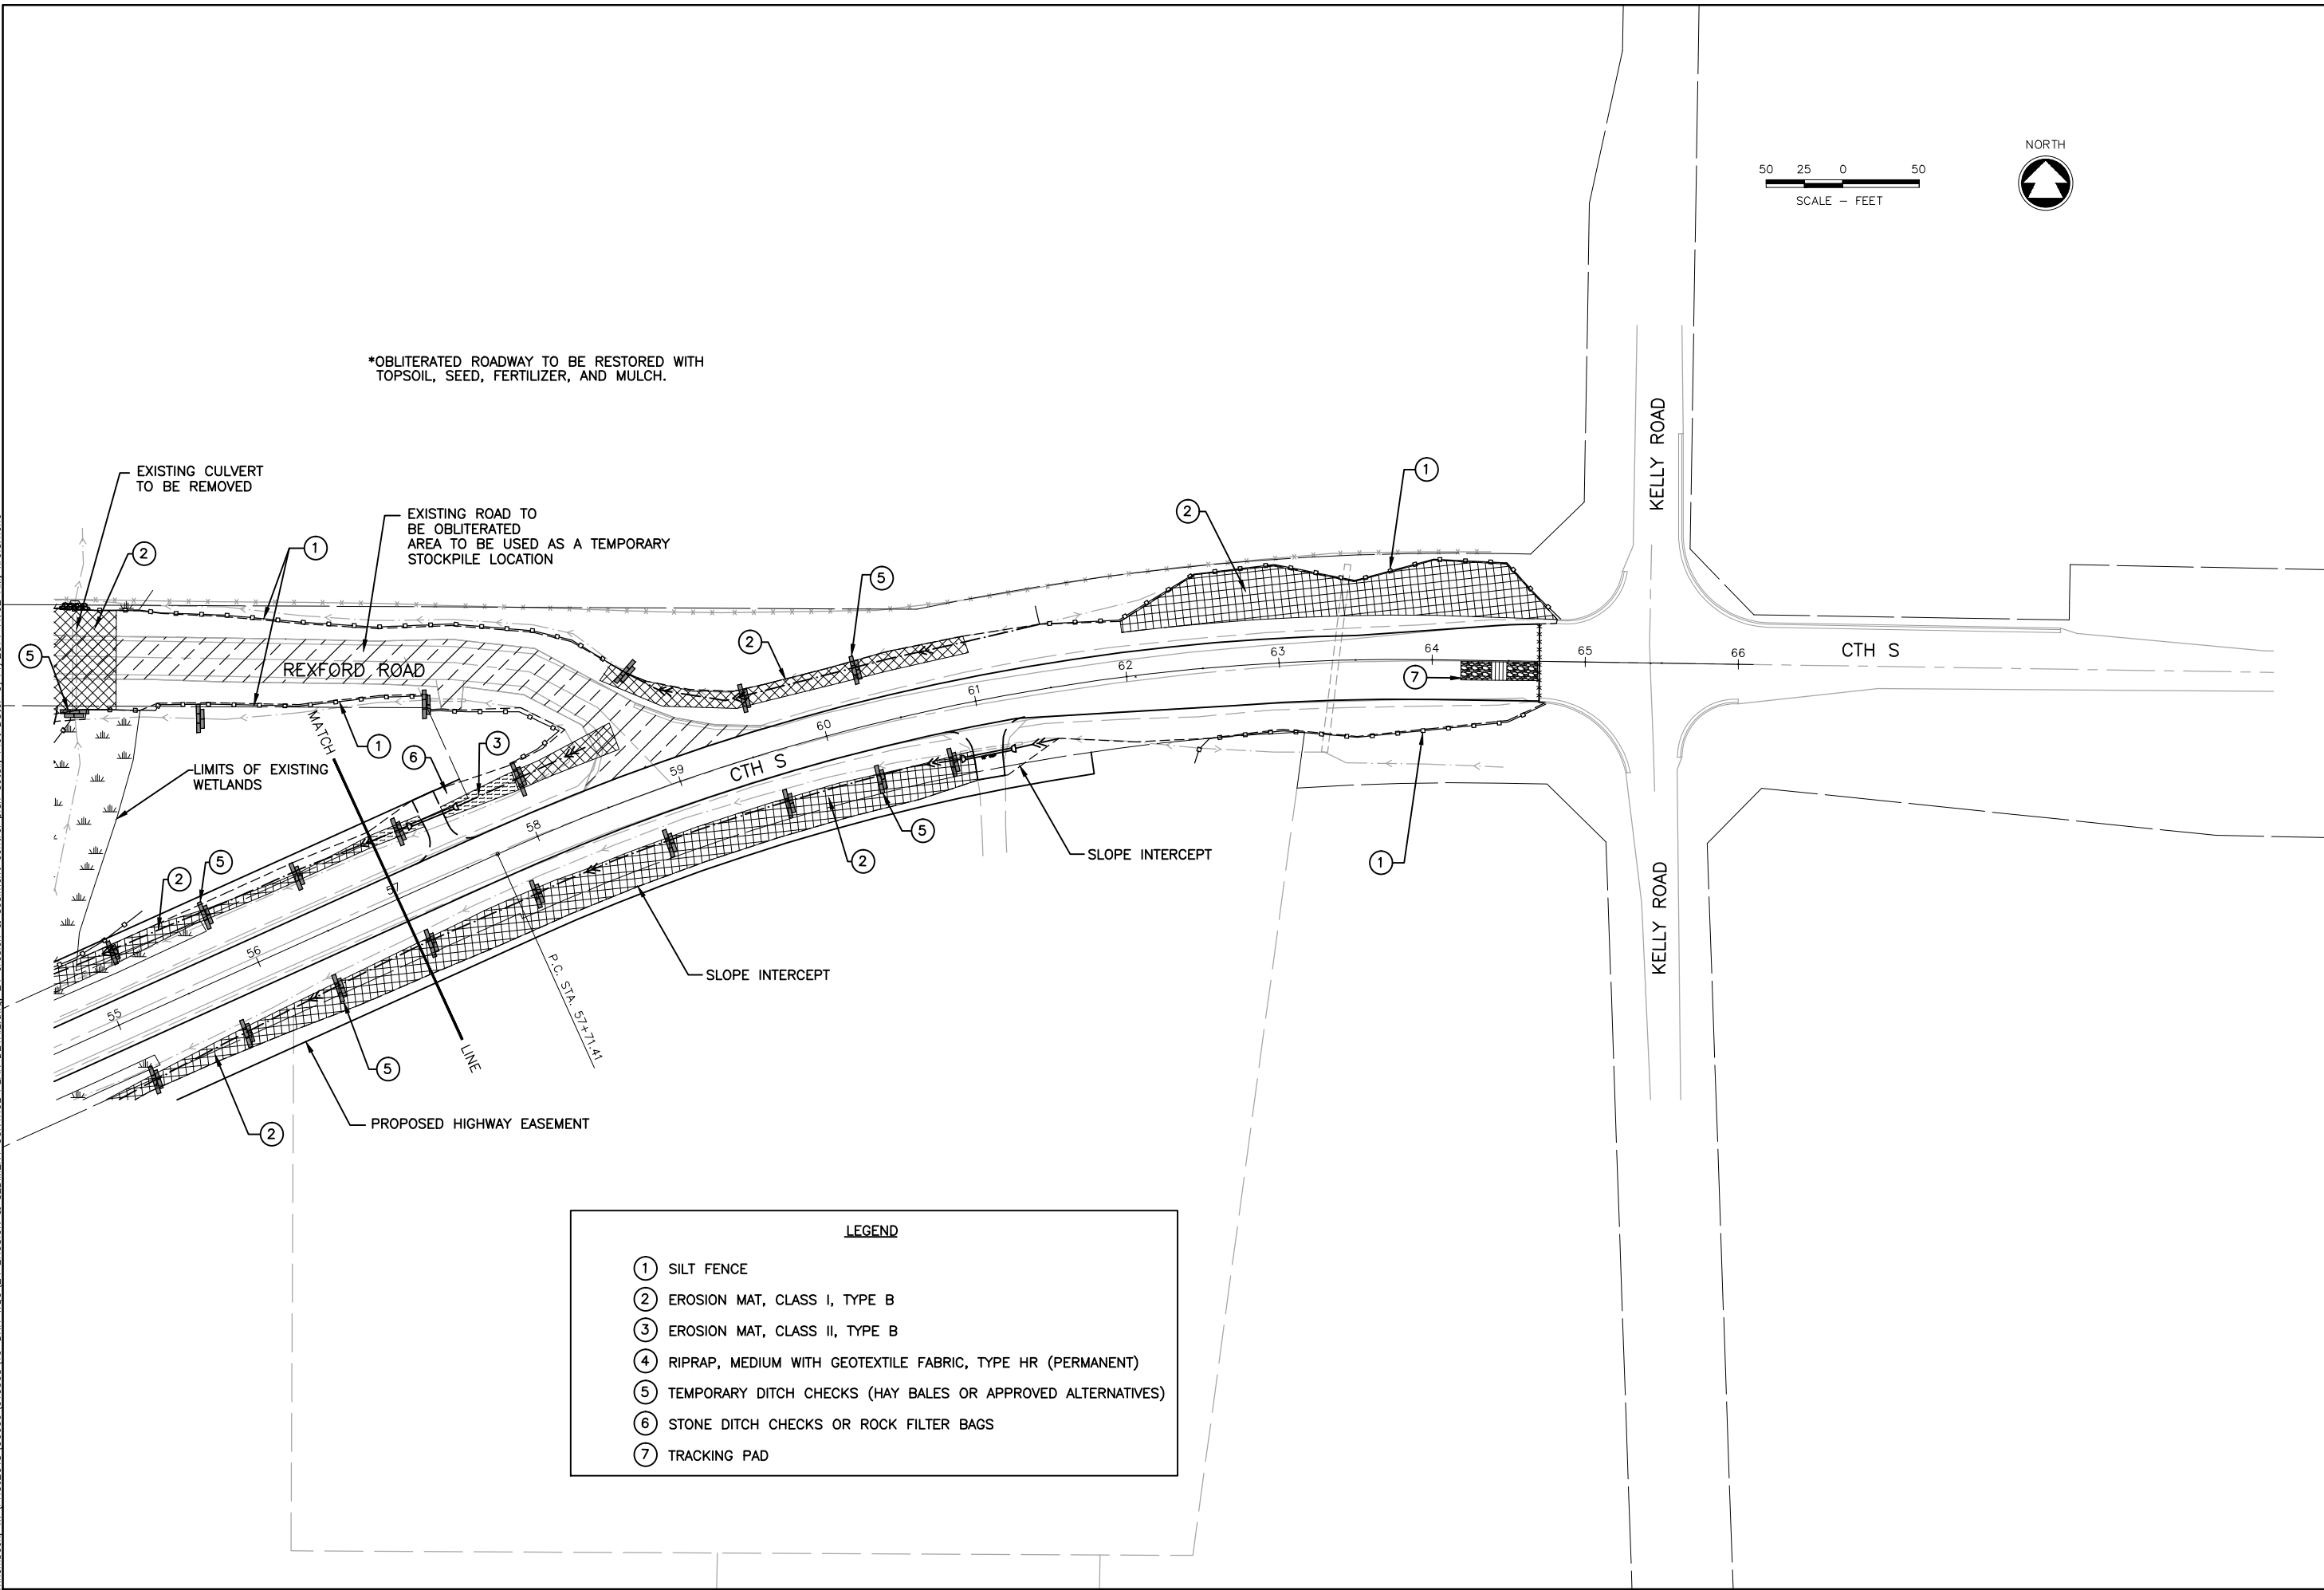

McMAHON

ENGINEERS ARCHITECTS

1445 McMAHON DRIVE NEENAH, WI 54956
Mailing: P.O. BOX 1025 NEENAH, WI 54957-1025
Tel: (920) 751-4200 Fax: (920) 751-4284
www.mcmgrp.com

McMAHON PROVIDES THIS DRAWING AND DATA, REGARDLESS OF FORM, AS INSTRUMENTS OF SERVICE. THE CLIENT AND/OR USER SHALL BE RESPONSIBLE FOR OBTAINING ALL NECESSARY PERMITS AND FOR THE ACCURACY OF THE DATA. THE CLIENT AND/OR USER SHALL BE RESPONSIBLE FOR THE PROTECTION OF THE DRAWING AND DATA. THE CLIENT AND/OR USER SHALL BE RESPONSIBLE FOR THE PROTECTION OF THE DRAWING AND DATA. THE CLIENT AND/OR USER SHALL BE RESPONSIBLE FOR THE PROTECTION OF THE DRAWING AND DATA.

McMAHON, THE CLIENT AND/OR USER SHALL BE RESPONSIBLE FOR THE PROTECTION OF THE DRAWING AND DATA. THE CLIENT AND/OR USER SHALL BE RESPONSIBLE FOR THE PROTECTION OF THE DRAWING AND DATA. THE CLIENT AND/OR USER SHALL BE RESPONSIBLE FOR THE PROTECTION OF THE DRAWING AND DATA. THE CLIENT AND/OR USER SHALL BE RESPONSIBLE FOR THE PROTECTION OF THE DRAWING AND DATA.

CTH 'S' (STH 76 - KELLY ROAD)
OUTAGAMIE COUNTY, WISCONSIN
EROSION & SEDIMENT CONTROL PLAN DETAIL

DESIGNED
MPK

DRAWN
MPK

PROJECT NO.
00006 910308

DATE
FEBRUARY, 2014

SHEET NO.
24

w:\PROJECTS\00006\910308\08-Design\MQ_SHEETS\26 MISC QUANTITIES.dwg, 26 misc quantities, Plot Date: 5/20/2014 9:01 AM, xref:none

TOPSOIL, FERTILIZER AND SEED					
STATION - STATION	LOCATION	TOPSOIL	FERTILIZER	SEEDING MIXTURE	SEEDING
		SY	TYPE B CWT	NO. 20 LB	TEMPORARY LB
1+00 - 4+22	RT	445	0.3	12	-
1+00 - 10+85	LT	3000	1.9	81	-
4+37 - 6+18	RT	280	0.2	8	-
6+34 - 20+22	RT	5000	3.2	135	-
11+00 - 14+13	LT	925	0.6	25	-
14+33 - 19+40	LT	1160	0.7	31	-
19+45 - 24+29	LT	1265	0.8	34	-
20+55 - 28+19	RT	2315	1.5	63	-
24+53 - 30+00	LT	1710	1.1	46	-
28+31 - 39+50	RT	2070	1.3	56	-
30+13 - 35+83	LT	1400	0.9	38	-
35+94 - 46+22	LT	2440	1.5	66	-
39+66 - 42+44	RT	640	0.4	17	-
42+55 - 48+19	RT	1110	0.7	30	-
46+34 - 48+39	LT	440	0.3	12	-
48+32 - 60+92	RT	3140	2.0	85	-
48+94 - 52+41	LT	610	0.4	16	-
52+56 - 64+70	LT	3145	2.0	85	-
61+11 - 64+70	RT	370	0.2	10	-
10+57 - 11+48	REXFORD LT	190	0.1	5	-
11+61 - 12+61	REXFORD LT	165	0.1	4	-
10+58 - 12+57	REXFORD RT	290	0.2	8	-
6+50 - 9+26	ROCK LT	690	0.4	19	-
5+11 - 9+32	ROCK RT	1320	0.8	36	-
CUL DE SAC/REXFORD RD	LT & RT	3090	1.9	83	-
UNDISTRIBUTED	-	-	-	-	100
TOTAL		37210	23.4	1005	100

PAVEMENT MARKING SUMMARY					
STATION - STATION	LOCATION	4-INCH EPOXY			8-INCH EPOXY
		LANE LINE	EDGE LINE	*CENTERLINE	CHANNELIZING
		DASHED (WHITE) LF	(WHITE) LF	(YELLOW) LF	(WHITE) LF
0+65 - 15+00	CTH S	-	2758	2870	-
15+00 - 30+00	CTH S	318	2875	2940	196
30+00 - 45+00	CTH S	-	3000	3000	-
45+00 - 64+70	CTH S	252	3797	3880	199
--	ROCK ROAD	-	-	-	-
--	REXFORD ROAD	-	-	-	-
TOTALS		570	12430	12690	395

* 4 INCH EPOXY CENTERLINE QUANTITIES ASSUME DOUBLE YELLOW THE ENTIRE LENGTH OF THE PROJECT
NO PASSING ZONES TO BE DETERMINED IN THE FIELD

EROSION MAT SUMMARY				
STATION - STATION	LOCATION	EROSION MAT	EROSION MAT	
		CLASS I TYPE B SY	CLASS II TYPE B SY	
2+41 - 11+00	LT	1150	742	
4+38 - 6+18	RT	425	-	
6+35 - 11+50	RT	-	360	
11+00 - 16+00	LT	600	-	
11+50 - 16+50	RT	410	-	
18+80 - 20+05	RT	-	150	
20+75 - 25+50	RT	1120	-	
24+50 - 27+00	LT	470	-	
25+00 - 32+00	RT	610	-	
31+50 - 32+50	LT	105	-	
39+00 - 39+46	RT	49	-	
39+23 - 39+95	LT	52	-	
41+50 - 42+00	RT	50	-	
42+50 - 43+50	LT	125	-	
46+34 - 48+00	LT	170	-	
53+59 - 61+00	RT	1505	-	
53+68 - 57+00	LT	366	-	
57+00 - 58+00	LT	-	90	
58+00 - 61+00	LT	425	-	
62+00 - 64+70	LT	880	-	
ROCK RD	RT	1200	-	
CUL-DE-SAC	-	570	-	
UNDISTRIBUTED	-	1000	-	
TOTAL		11282	1342	

MULCHING	
LOCATION	MULCHING SY
CTH 'S'	21818
ROCK ROAD	810
REXFORD ROAD	645
CUL DE SAC/REXFORD RD	2520
TOTAL	25793

TEMPORARY SEDIMENT BASIN		
STATION	LOCATION	EACH
15+64	LT	1
15+64	RT	1
15+85	LT	1
15+85	RT	1
39+06	RT	1
39+32	RT	1
39+40	LT	1
39+69	LT	1
53+74	RT	1
53+84	LT	1
54+09	RT	1
TOTAL		11

TEMPORARY CHECKS				
STATION - STATION	LOCATION	DITCH CHECK SEDIMENT BALES	DITCH CHECK ROCK BAGS	CULVERT PIPE CHECK
		LF	LF	EACH
2+00	LT	20	-	
2+10	LT	-	-	1
2+00 - 11+00	LT	-	160	-
6+00 - 12+00	RT	-	110	-
11+00 - 19+00	LT	80	-	-
12+00 - 19+00	RT	60	-	-
15+73	LT	-	-	1
19+00 - 20+00	RT	-	20	-
20+83	RT	-	-	1
25+00 - 32+00	LT	70	-	-
21+00 - 32+00	RT	80	-	-
39+00 - 40+00	LT & RT	30	-	-
39+18	RT	-	-	1
42+00 - 48+00	LT	40	-	-
53+00 - 61+00	RT	110	-	-
52+00 - 61+00	LT	90	-	-
53+92	RT	-	-	1
54+50	LT	-	10	-
-	ROCK ROAD	30	-	-
-	REFORD ROAD	10	-	-
-	CUL-DE-SAC	60	10	-
-	DRIVEWAY CULVERTS	-	-	13
TOTAL		680	310	18

SAWING SUMMARY			
STATION - STATION	LOCATION	SAWING ASPHALT LF	SAWING CONCRETE LF
0+65	CTH S, MATCH POINT	76	-
0+79	LT C&G MATCH POINT	-	3
4+15	DRIVEWAY RT	15	-
24+41	DRIVEWAY LT	23	-
64+70	CTH S, MATCH POINT	51	-
7+00	ROCK ROAD, MATCH POINT	23	-
12+57.21	REXFORD ROAD, MATCH POINT	22	-
-	CUL-DE-SAC MATCH POINT	22	-
TOTAL		232	3



McMahon provides this information as a service to the client and/or architect. The client and/or architect shall be responsible for the accuracy of the information and shall indemnify and hold McMahon harmless from and against all claims, damages, costs and expenses, including reasonable attorneys' fees, arising from or due to the use of the information, whether or not the same are caused in whole or in part by the negligence of McMahon. This disclaimer shall not be construed to limit the liability of McMahon for fraud or intentional misconduct.

REVISION		DATE		NO.	

CTH 'S' (STH 76 - KELLY ROAD)
OUTAGAMIE COUNTY, WISCONSIN
MISC QUANTITIES

DESIGNED MPK	DRAWN MPK
PROJECT NO. 00006 910308	
DATE FEBRUARY, 2014	
SHEET NO. 26	

microlbeck_wk\PROJECTS\00006\910308\20_RW_PLAT\27_TITLE.dwg, 27 title, Plot Date: 2/25/2014 3:39 PM, xref(s): (x-ctb s too, rw compa dew, x-line 26, 2013 additional topo)

CONVENTIONAL SIGNS AND ABBREVIATIONS

ANGLE

ACRE

BENCH MARK

CENTERLINE

CONCRETE

CORRUGATED METAL CULVERT PIPE

COUNTY TRUNK HIGHWAY

DELTA

DEGREE OF CURVE

EAST

EXTERNAL DISTANCE

ELEVATION

EXISTING

FIELD ENTRANCE

FLOWLINE

GRID NORTH

GAS VALVE

HECTARE

HOUSE

KILOMETER

LEFT

MANHOLE

MAXIMUM

MINIMUM

METER

NORTH

NUMBER

NORMAL

PRIVATE ENTRANCE

POINT OF INTERSECTION

POINT OF CURVATURE

POINT OF TANGENCY

PERMANENT LIMITED EASEMENT

PROPERTY LINE

PEDESTAL

RADIUS

REINFORCED CONCRETE CULVERT PIPE

REMAINING

REQUIRED

REFERENCE LINE

RIGHT OF WAY

R/W MONUMENT

3/4" REBAR FOUND

ROAD

RIGHT

SLOPE

SOUTH

STATION

STATE TRUNK HIGHWAY

TEMPORARY INTEREST

TEMPORARY LIMITED EASEMENT

TYPICAL

WATER VALVE/SHUTOFF

MONITORING WELLS

VAPOR EXTRACTION WELLS

3/4" x 24" ROUND IRON REBAR

WEIGHING 1.5 lbs./lineal ft. SET

PROPERTY LINE

SECTION LINE

EXISTING RIGHT OF WAY

NEW RIGHT OF WAY

REFERENCE LINE

SLOPE INTERCEPT

SECTION CORNER

UTILITY POLE

DOWN GUY

UNDERGROUND FIBRE OPTIC LINE

UNDERGROUND TELEPHONE LINE

UNDERGROUND CABLE TV LINE

OVERHEAD UTILITIES

EXISTING TREE

EXISTING WETLANDS

EXISTING CULVERT

EXISTING HOUSE/BUILDING

EXISTING CURB AND GUTTER

EXISTING FENCE LINE

NEW RIGHT-OF-WAY ACQUISITION AREAS

EXISTING RIGHT-OF-WAY ACQUISITION AREAS


ROAD RIGHT-OF-WAY TO BE VACATED BY SEPARATE INSTRUMENT

TEMPORARY LIMITED EASEMENT AREA

HIGHWAY EASEMENT

COORDINATE TABLE

POINT NO.	X	Y	POINT NO.	X	Y
200	783016.77	605808.75	222	785580.67	606907.92
201	783311.43	605827.76	223	785944.72	607197.61
202	783461.23	605824.39	224	785980.12	607233.27
203	783710.82	605803.35	225	786043.16	607310.90
204	783324.40	605707.43	226	786070.79	607352.86
205	783658.48	605699.93	227	786138.39	607436.11
206	783908.17	605683.31	228	786060.76	607499.15
207	784201.32	605676.73	229	786302.06	607735.32
208	784616.37	605745.68	230	786642.19	607824.43
209	784742.65	605745.52	231	786986.38	607980.03
210	784893.56	605607.59	232	787081.62	608012.11
211	785021.42	605527.14	233	787511.17	608206.30
212	785062.54	605578.77	234	787876.18	608313.46
213	784965.45	605697.35	235	787874.11	608327.61
214	784823.31	605804.73	236	787461.48	608310.04
215	784833.71	605854.30	237	786940.19	608074.38
216	785094.72	606083.91	238	787079.29	608358.44
217	785175.97	606214.51	239	787198.96	608357.82
218	785445.24	606572.37	240	608391.24	787686.96
219	785658.30	606844.88	241	608415.30	787734.63
220	785328.08	606582.98	242	608420.93	787760.38
221	785365.34	606632.49			

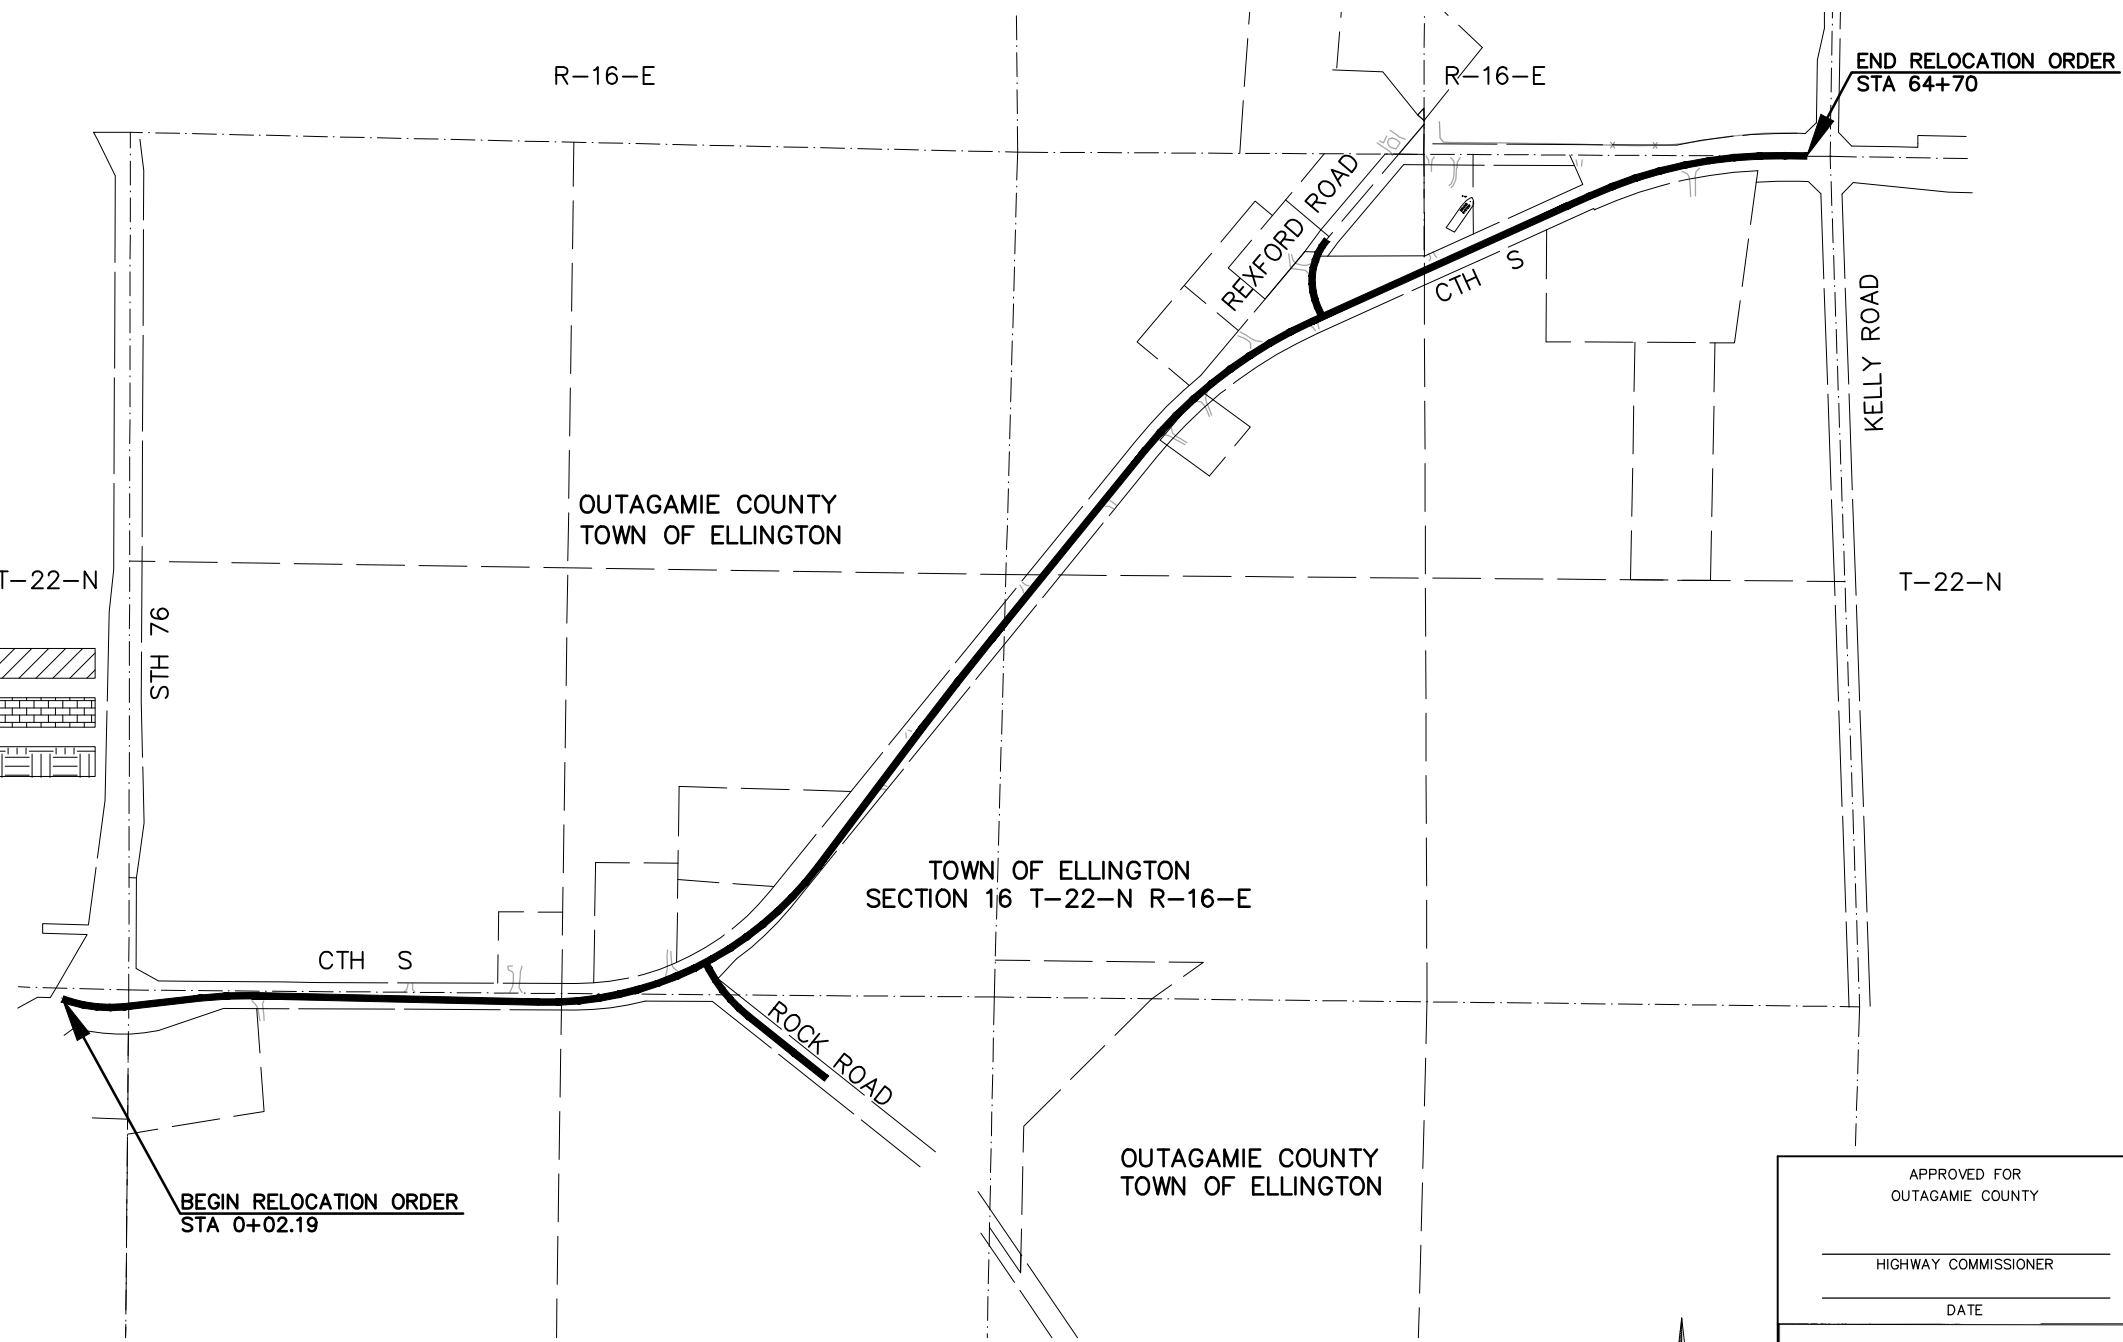

NOTES:

- COORDINATES AND BEARINGS SHOWN ON THIS PLAT ARE REFERENCED TO THE WISCONSIN COUNTY COORDINATE SYSTEM, (OUTAGAMIE COUNTY) COUNTY ZONE, NAD 1983 (1991 ADJUSTMENT). THE COORDINATES SHOWN ARE GRID COORDINATES AND ARE TO BE USED AS GRID OR GROUND VALUES ON THIS PLAT.
- RIGHT-OF-WAY MONUMENTS TO BE SET WITH 3/4" x 24" IRON REBAR WEIGHING 1.5 LBS./LINEAL FT. AND WILL BE PLACED PRIOR TO THE COMPLETION OF THE PROJECT.
- RIGHT-OF-WAY BOUNDARIES ARE DEFINED WITH COURSES OF THE PERIMETER OF THE HIGHWAY. LANDS REFERENCED TO THE U.S. PUBLIC LAND SURVEY OR OTHER SURVEYS OF RECORD.
- PROPERTY LINES SHOWN ON THIS PLAT ARE DRAWN FROM DATA DERIVED FROM MAPS AND DOCUMENTS OF PUBLIC RECORD AND/OR EXISTING OCCUPATIONAL LINES. EXCLUDING RIGHT-OF-WAY BOUNDARIES, THIS PLAT MAY NOT BE A TRUE REPRESENTATION OF EXISTING PROPERTY LINES AND SHOULD NOT BE USED AS A SUBSTITUTE FOR AN ACCURATE FIELD SURVEY.
- DIMENSIONS FOR THE NEW RIGHT-OF-WAY IS MEASURED ALONG AND PERPENDICULAR TO THE NEW REFERENCE LINES.
- A TEMPORARY LIMITED EASEMENT (TLE), IS A RIGHT FOR CONSTRUCTION PURPOSES, AS DEFINED HEREIN, INCLUDING THE RIGHT TO OPERATE NECESSARY EQUIPMENT THEREON AND THE RIGHT OF INGRESS AND EGRESS, AS LONG AS REQUIRED FOR SUCH PUBLIC PURPOSE, INCLUDING THE RIGHT TO PRESERVE, PROTECT, REMOVE, OR PLANT THEREON ANY VEGETATION THAT THE HIGHWAY AUTHORITIES MAY DEEM NECESSARY OF DESIRABLE. ALL TLE'S EXPIRE AT THE COMPLETION OF THE CONSTRUCTION PROJECT FOR WHICH THIS INSTRUMENT IS GIVEN.


TOTAL NET LENGTH OF CENTERLINE = 1.225 MILES

SURVEYOR'S CERTIFICATE

The property as shown and described on this map was surveyed under my direction and control according to the Wisconsin Administrative Code, Chapter A-27 of Minimum Standards for Property Surveys, and is a correct representation of said survey, to the best of my knowledge and belief.

date Registered Land Surveyor

R-16-E

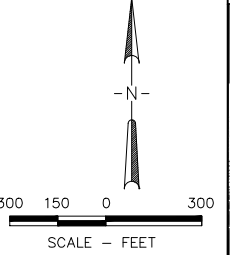

REVISION DATE	
05/03/2013	CHANGES PER UPDATED TITLE POLICY
07/16/2013	ADD UTILITIES, UPDATE SCHEDULE OF INTEREST
02/24/2014	REMOVED PARCEL 2 ACQUISITION

APPROVED FOR
OUTAGAMIE COUNTY

HIGHWAY COMMISSIONER

DATE

PLAT PREPARED
BY
McMAHON
NEENAH, WISCONSIN

David M. Schmalz
MAR. 13, 2013

m:\konibeck_w:\PROJECTS\00006\910308\20_RW_PLAT\28_SCHEDULE OF INTEREST.dwg, 28_schedule of interest_Plot_Date: 2/26/2014 10:58 AM_xref:none

SCHEDULE OF LAND & INTEREST REQUIRED															
PARCEL NO.	PAGE NO.	TAX KEY NO.	OWNERSHIP	INTEREST REQUIRED	TOTAL EXISTING ACRES	NEW R/W ACQUIRED SQUARE FEET	NEW R/W ACQUIRED ACRES	EXISTING R/W ACQUIRED SQUARE FEET	EXISTING R/W ACQUIRED ACRES	TOTAL ACQUIRED ACRES	NEW VACATED SQUARE FEET	NEW VACATED ACRES	REMAINING ACRES	HIGHWAY EASEMENT ACRES	T.L.E. REQUIRED SQUARE FEET
3	30, 31	08-0-0349-00 & 08-0-0342-00	ROBERT W. & LORRAINE SCHMIDT, LAND CONTRACT VENDORS RYAN R. & BOBBIE JO SCHMIDT, LAND CONTRACT PURCHASER	FEE	77.27	36421	0.84	61315	1.41	2.25			75.02		
4	31	08-0-0348-00	F&K PARTNERSHIP LLP LAND CONTRACT VENDOR JEROME SCHROTH & JEAN SCHROTH LAND CONTRACT PURCHASER	FEE/TLE	26.14	12842	0.29	21281	0.49	0.78			25.36		4413
8	31, 32	08-0-0344-02 & 08-0-0344-00	JEROME & JEAN SCHROTH	FEE	21.02	4328	0.10	24975	0.57	0.67			20.35		
9	31	08-0-0344-01	THOMAS G. & CINDEE LU YUNK	FEE/TLE	2.52			7228	0.17	0.17			2.35		3319
11	31	08-0-0346-00	BRIAN S. GOODING & STEPHANIE M. COTTRELL	FEE/TLE	1.53			11279	0.26	0.26			1.27		5243
12	31	08-0-0345-00	PATRICK MCHUGH	FEE	3.25			9621	0.22	0.22			3.03		
14	31, 32 33	08-0-0347-00 08-0-0343-00 08-0-0337-00 08-0-0334-00 & 08-0-0329-00	JEROME SCHROTH	FEE	100.24	75021	1.72	75065	1.72	3.44	17011	0.39	97.19		
18	33	08-0-0335-00	JOSHUA J. & JENNIFER L. BECHER	FEE	0.87	1771	0.04	4950	0.11	0.15			0.72		
19	33	08-0-0336-04	RICHARD G. & DIANE L. GJERTSON	FEE	1.15	627	0.01		0.00	0.01			1.14		
20	32, 33	08-0-0336-00	BUD SHEPARDSON REVOCABLE FAMILY TRUST	FEE	15.78	6851	0.16	36084	0.83	0.99			14.79		
23	33, 34	08-0-0333-00	DONALD S. & SUSAN M. LABUDDE	FEE	1.50	229	0.01		0.00	0.01			1.49		
24	33, 34	08-0-0332-00	FRANK VERGARA	FEE	1.00	4028	0.09	5049	0.12	0.21			0.79		
26	34	08-0-0330-00	WISCONSIN MICHIGAN POWER COMPANY	HIGHWAY EASEMENT	6.69				0.00	0.00			6.69	0.20	
27	34	08-0-0201-01	KENNETH E. & JILLENE M. DORN	FEE	32.34				0.00	0.00	17003	0.39	32.73		
TOTAL						142118 S.F.	3.26 ACRES		5.90 ACRES	9.16 ACRES					12975 S.F.

UTILITY SCHEDULE OF INTEREST		
PARCEL NUMBER	UTILITY OWNER	INTEREST REQUIRED
100	AMERICAN TRANSMISSION COMPANY, LLC	RELEASE
101	WISCONSIN POWER COMPANY	RELEASE
102	A T & T WISCONSIN	RELEASE
103	WE-ENERGIES	RELEASE

McMAHON

ENGINEERS ARCHITECTS

1445 McMAHON DRIVE NEENAH, WI 54956
Mailing: P.O. BOX 1025 NEENAH, WI 54957-1025
Tel: (920) 751-4200 Fax: (920) 751-4284
www.mcngroup.com

McMahon provides this drawing and data, regardless of form, as instruments of service to the client and/or third parties. The client and/or third parties shall be responsible for obtaining the necessary permits and licenses to use the drawing and data. McMahon does not warrant the accuracy or completeness of the drawing and data. McMahon shall not be held liable for any errors or omissions in the drawing and data. McMahon shall not be held liable for any damages, including consequential damages, arising from the use of the drawing and data. McMahon shall not be held liable for any changes made to the original drawing or data without prior written consent by McMahon.

REVISION		DATE	NO.

CTH 'S' (STH 76 – KELLY ROAD)
OUTAGAMIE COUNTY, WISCONSIN
SCHEDULE OF INTEREST

DESIGNED
MPK


DRAWN
MPK

PROJECT NO.
00006 910308


DATE
FEBRUARY, 2014

SHEET NO.
28

m:\kohlbeck_w:\PROJECTS\00006\910308\20_RW_PLAT.dwg, 30 cth s rw plat, Plot Date: 2/25/2014 3:39 PM, xrefs: (x-rw plat info, x-cth s topo, x-proposed cth s revised, x-rw hatching, x-rw comps dew, 50k)

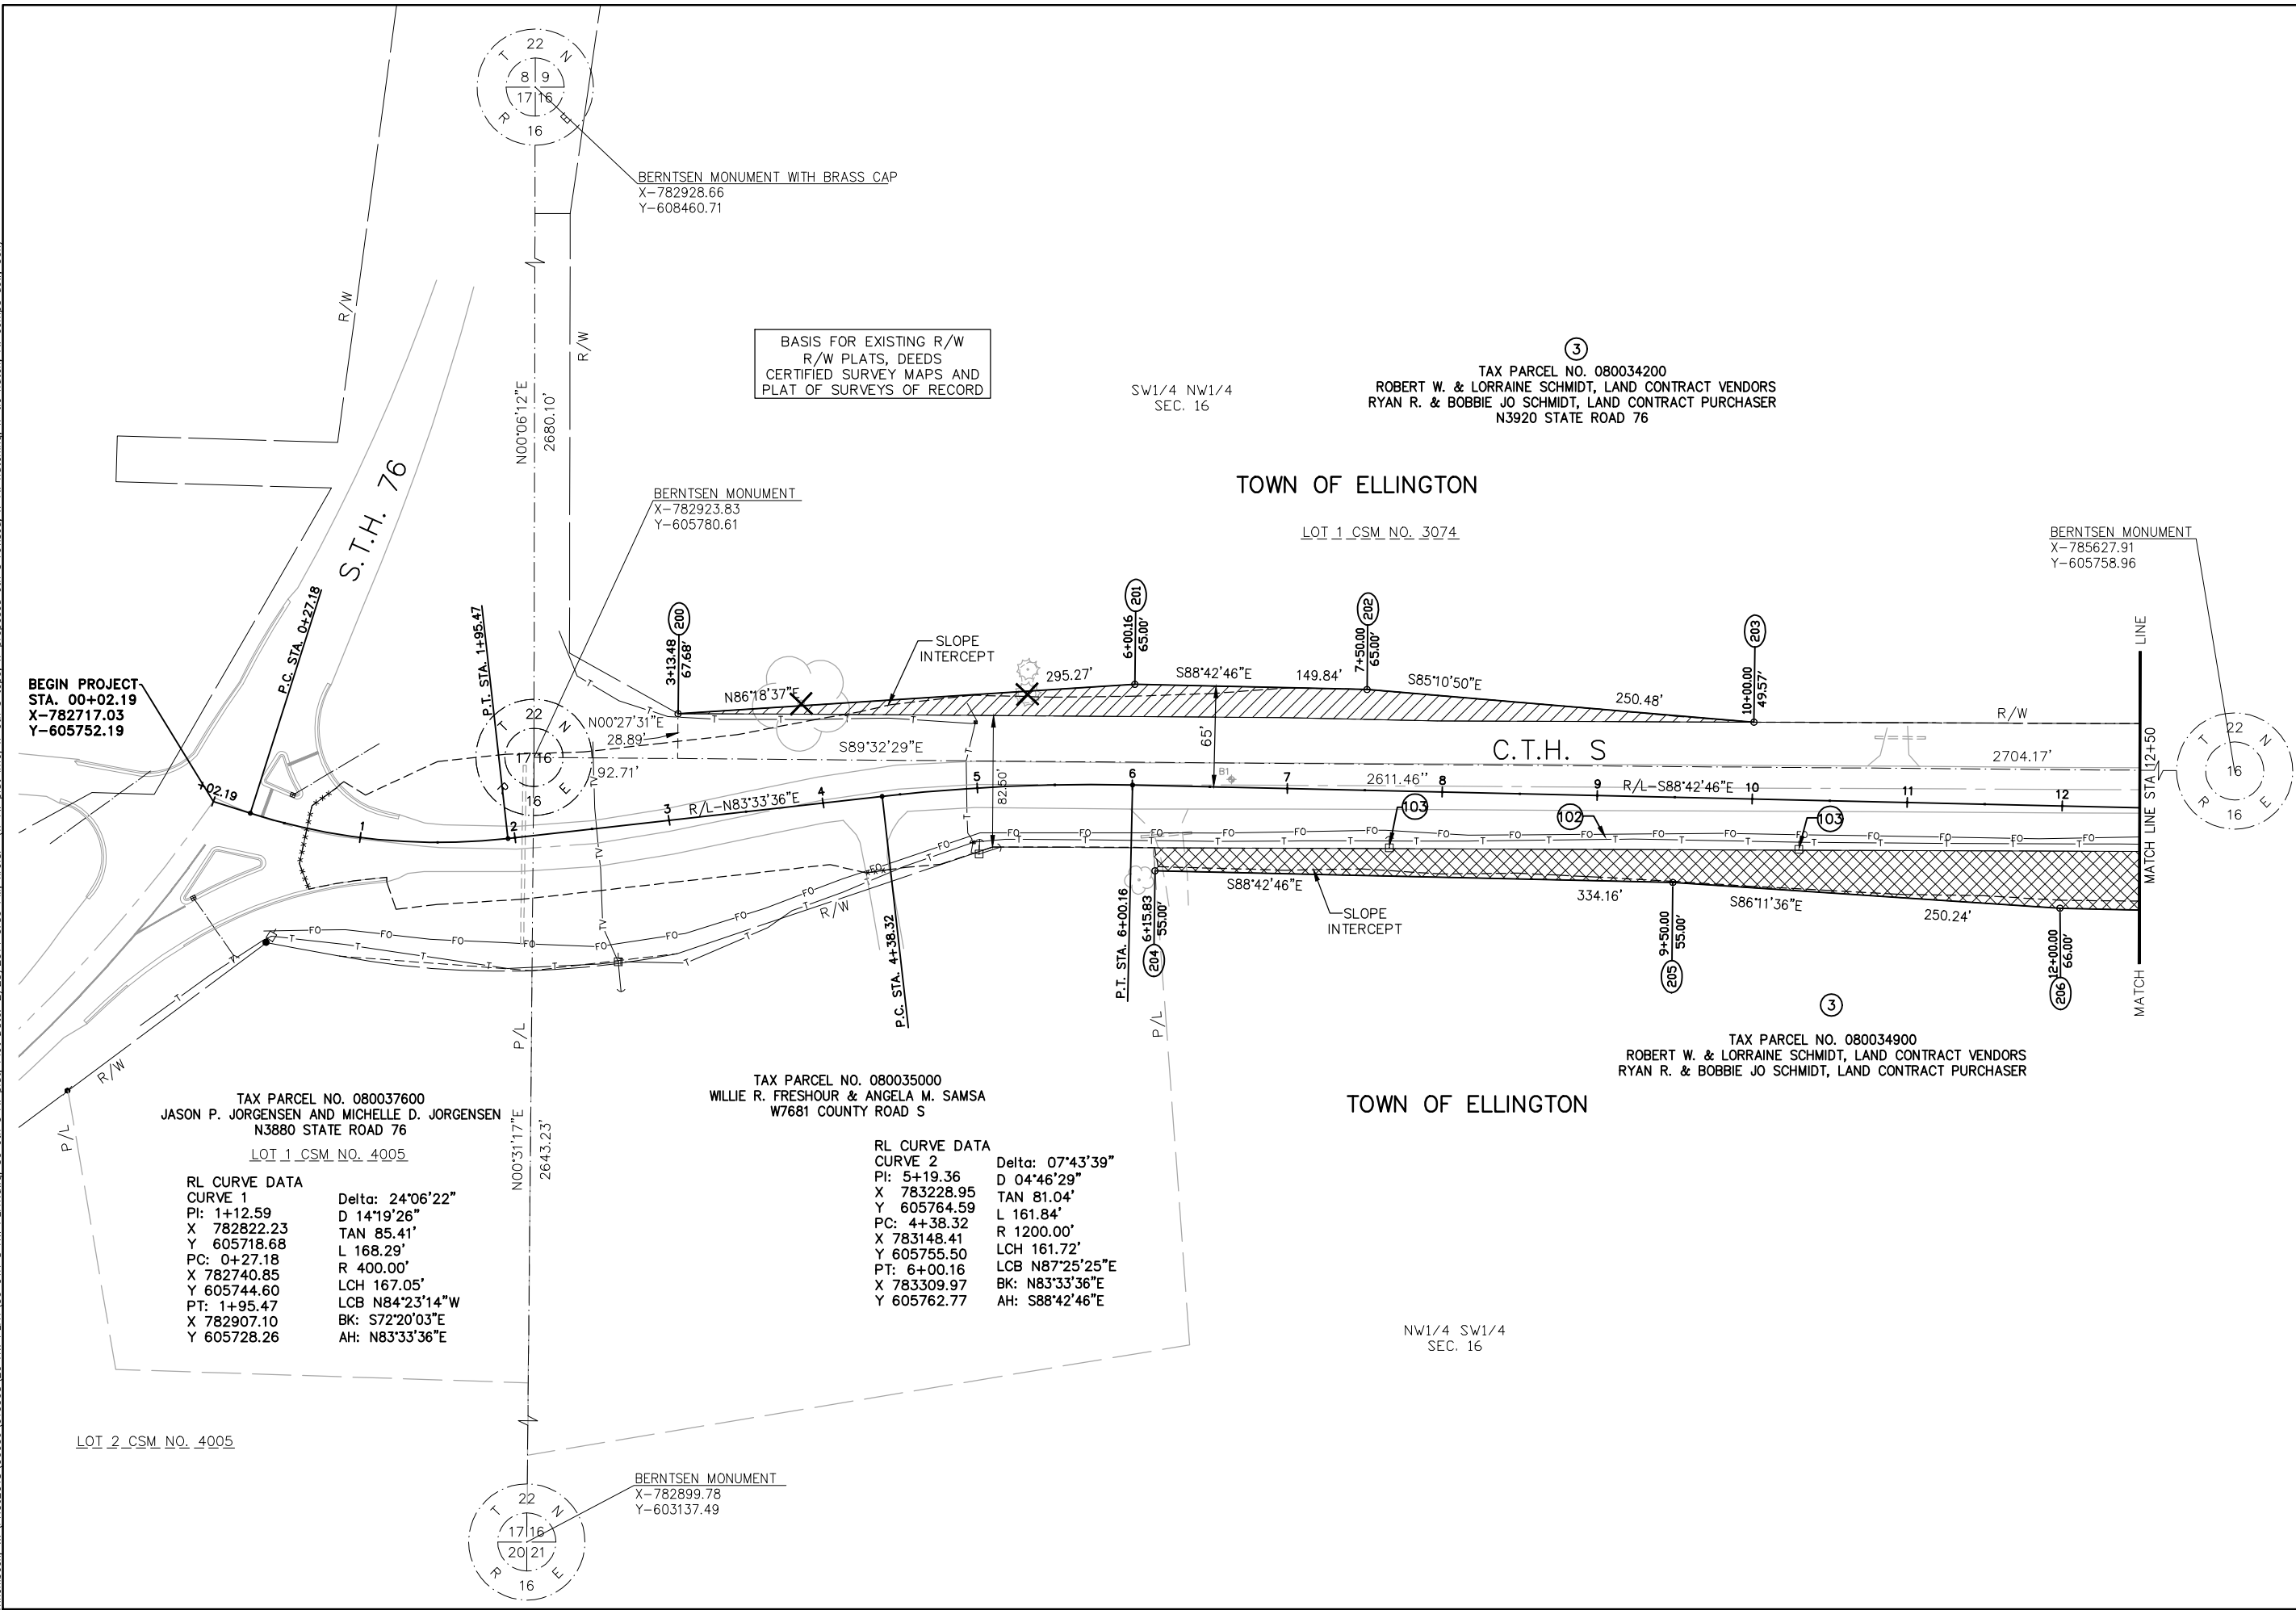

m:\projects\00006\910308\20_RW_PLAT.dwg, 31_cth_s rw plat, Plot Date: 2/25/2014 3:40 PM, xref: (x-rw plat info, x-cth s topo, x-proposed cth s revised, x-rw hatching, x-tie hatch, rw comps dew, 50k)

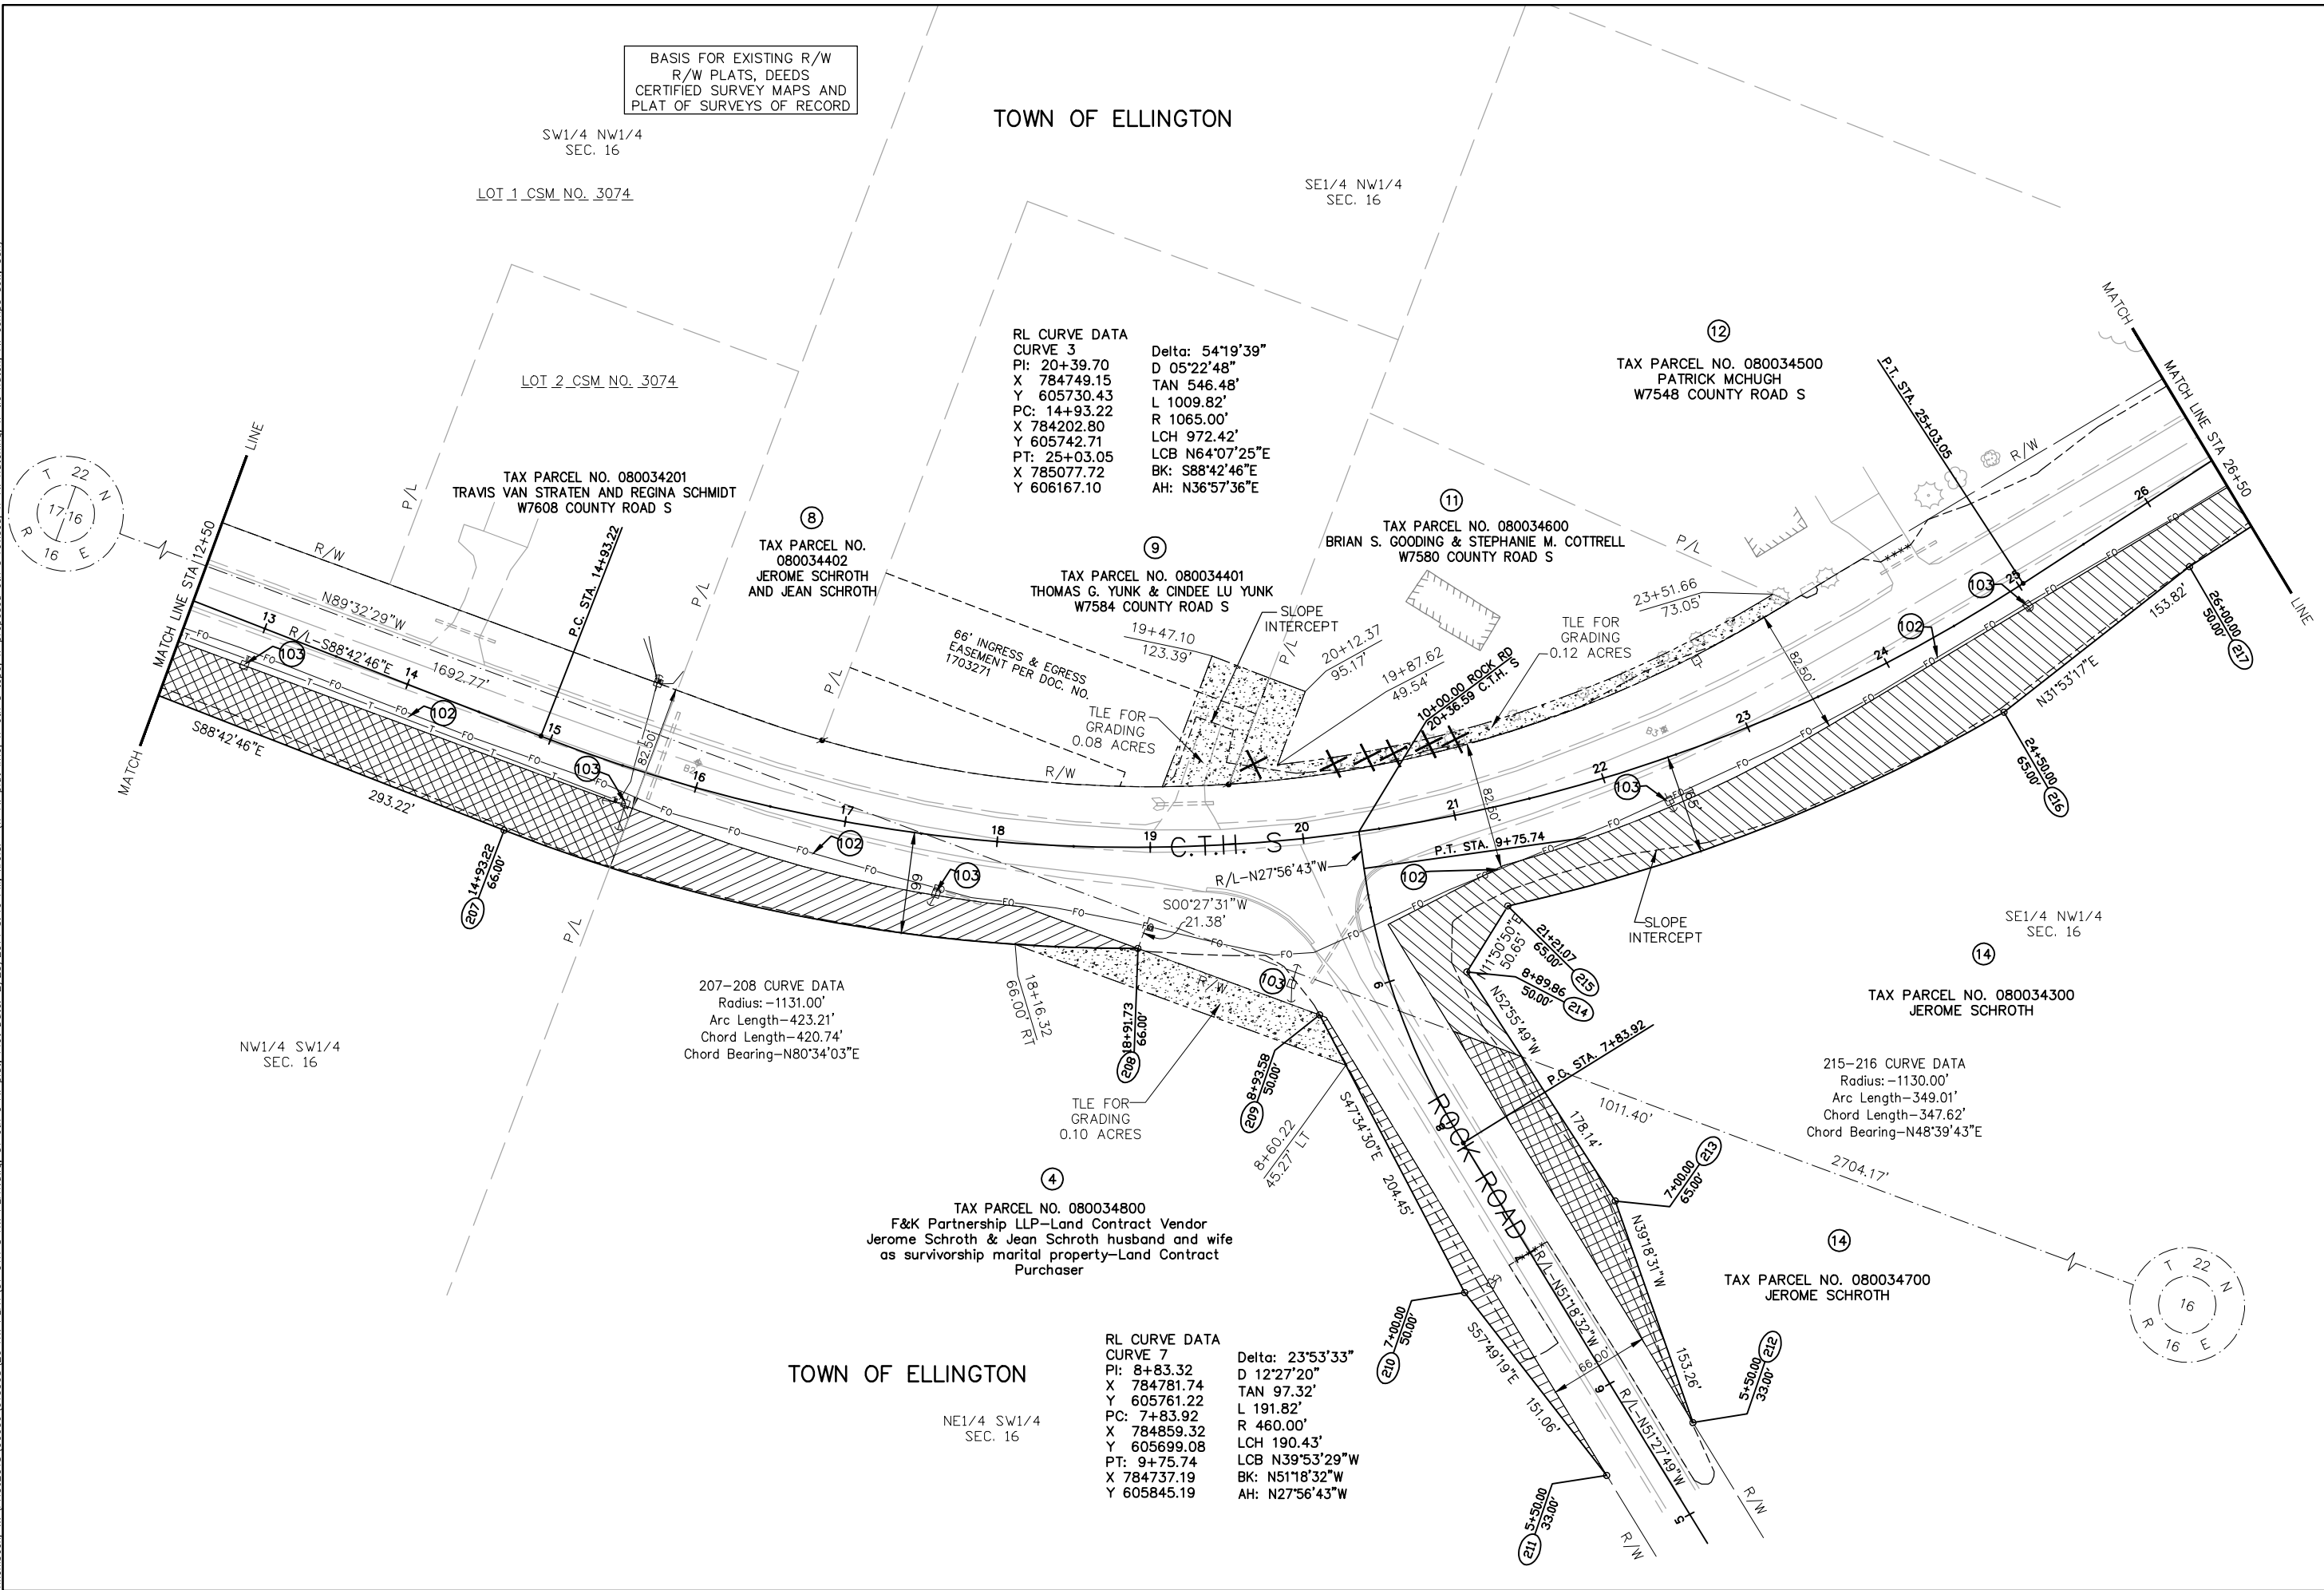

McMAHON
ENGINEERS & ARCHITECTS
1445 McMAHON DRIVE NEENAH, WI 54956
Mailing: P.O. BOX 1025 NEENAH, WI 54957-1025
Tel: (920) 751-4200 Fax: (920) 751-4284
www.mcmahon.com

McMahon provides this drawing and data, regardless of form, as instruments of service. The client and/or user of this drawing and data shall be responsible for obtaining all necessary permits and for verifying the accuracy of the data and the appropriateness of the design. McMahon and its employees shall not be held liable for any damages, including consequential damages, made to the original drawing or data without prior written consent by McMahon.

NO.	DATE	REVISION

CTH 'S' (STH 76 - KELLY ROAD)
OUTAGAMIE COUNTY, WISCONSIN
CTH S RW PLAT


DESIGNED	DRAWN
MPK	MPK

PROJECT NO.
00006 910308

DATE
FEBRUARY, 2014

SHEET NO.
31


mkohlbeck W:\PROJECTS\00006\910308\20 RW PLAT\32 CTH S RW PLAT\32 CTH S revised, x-rw hatching, x-lle hatch, rw comps.dwg, 50k

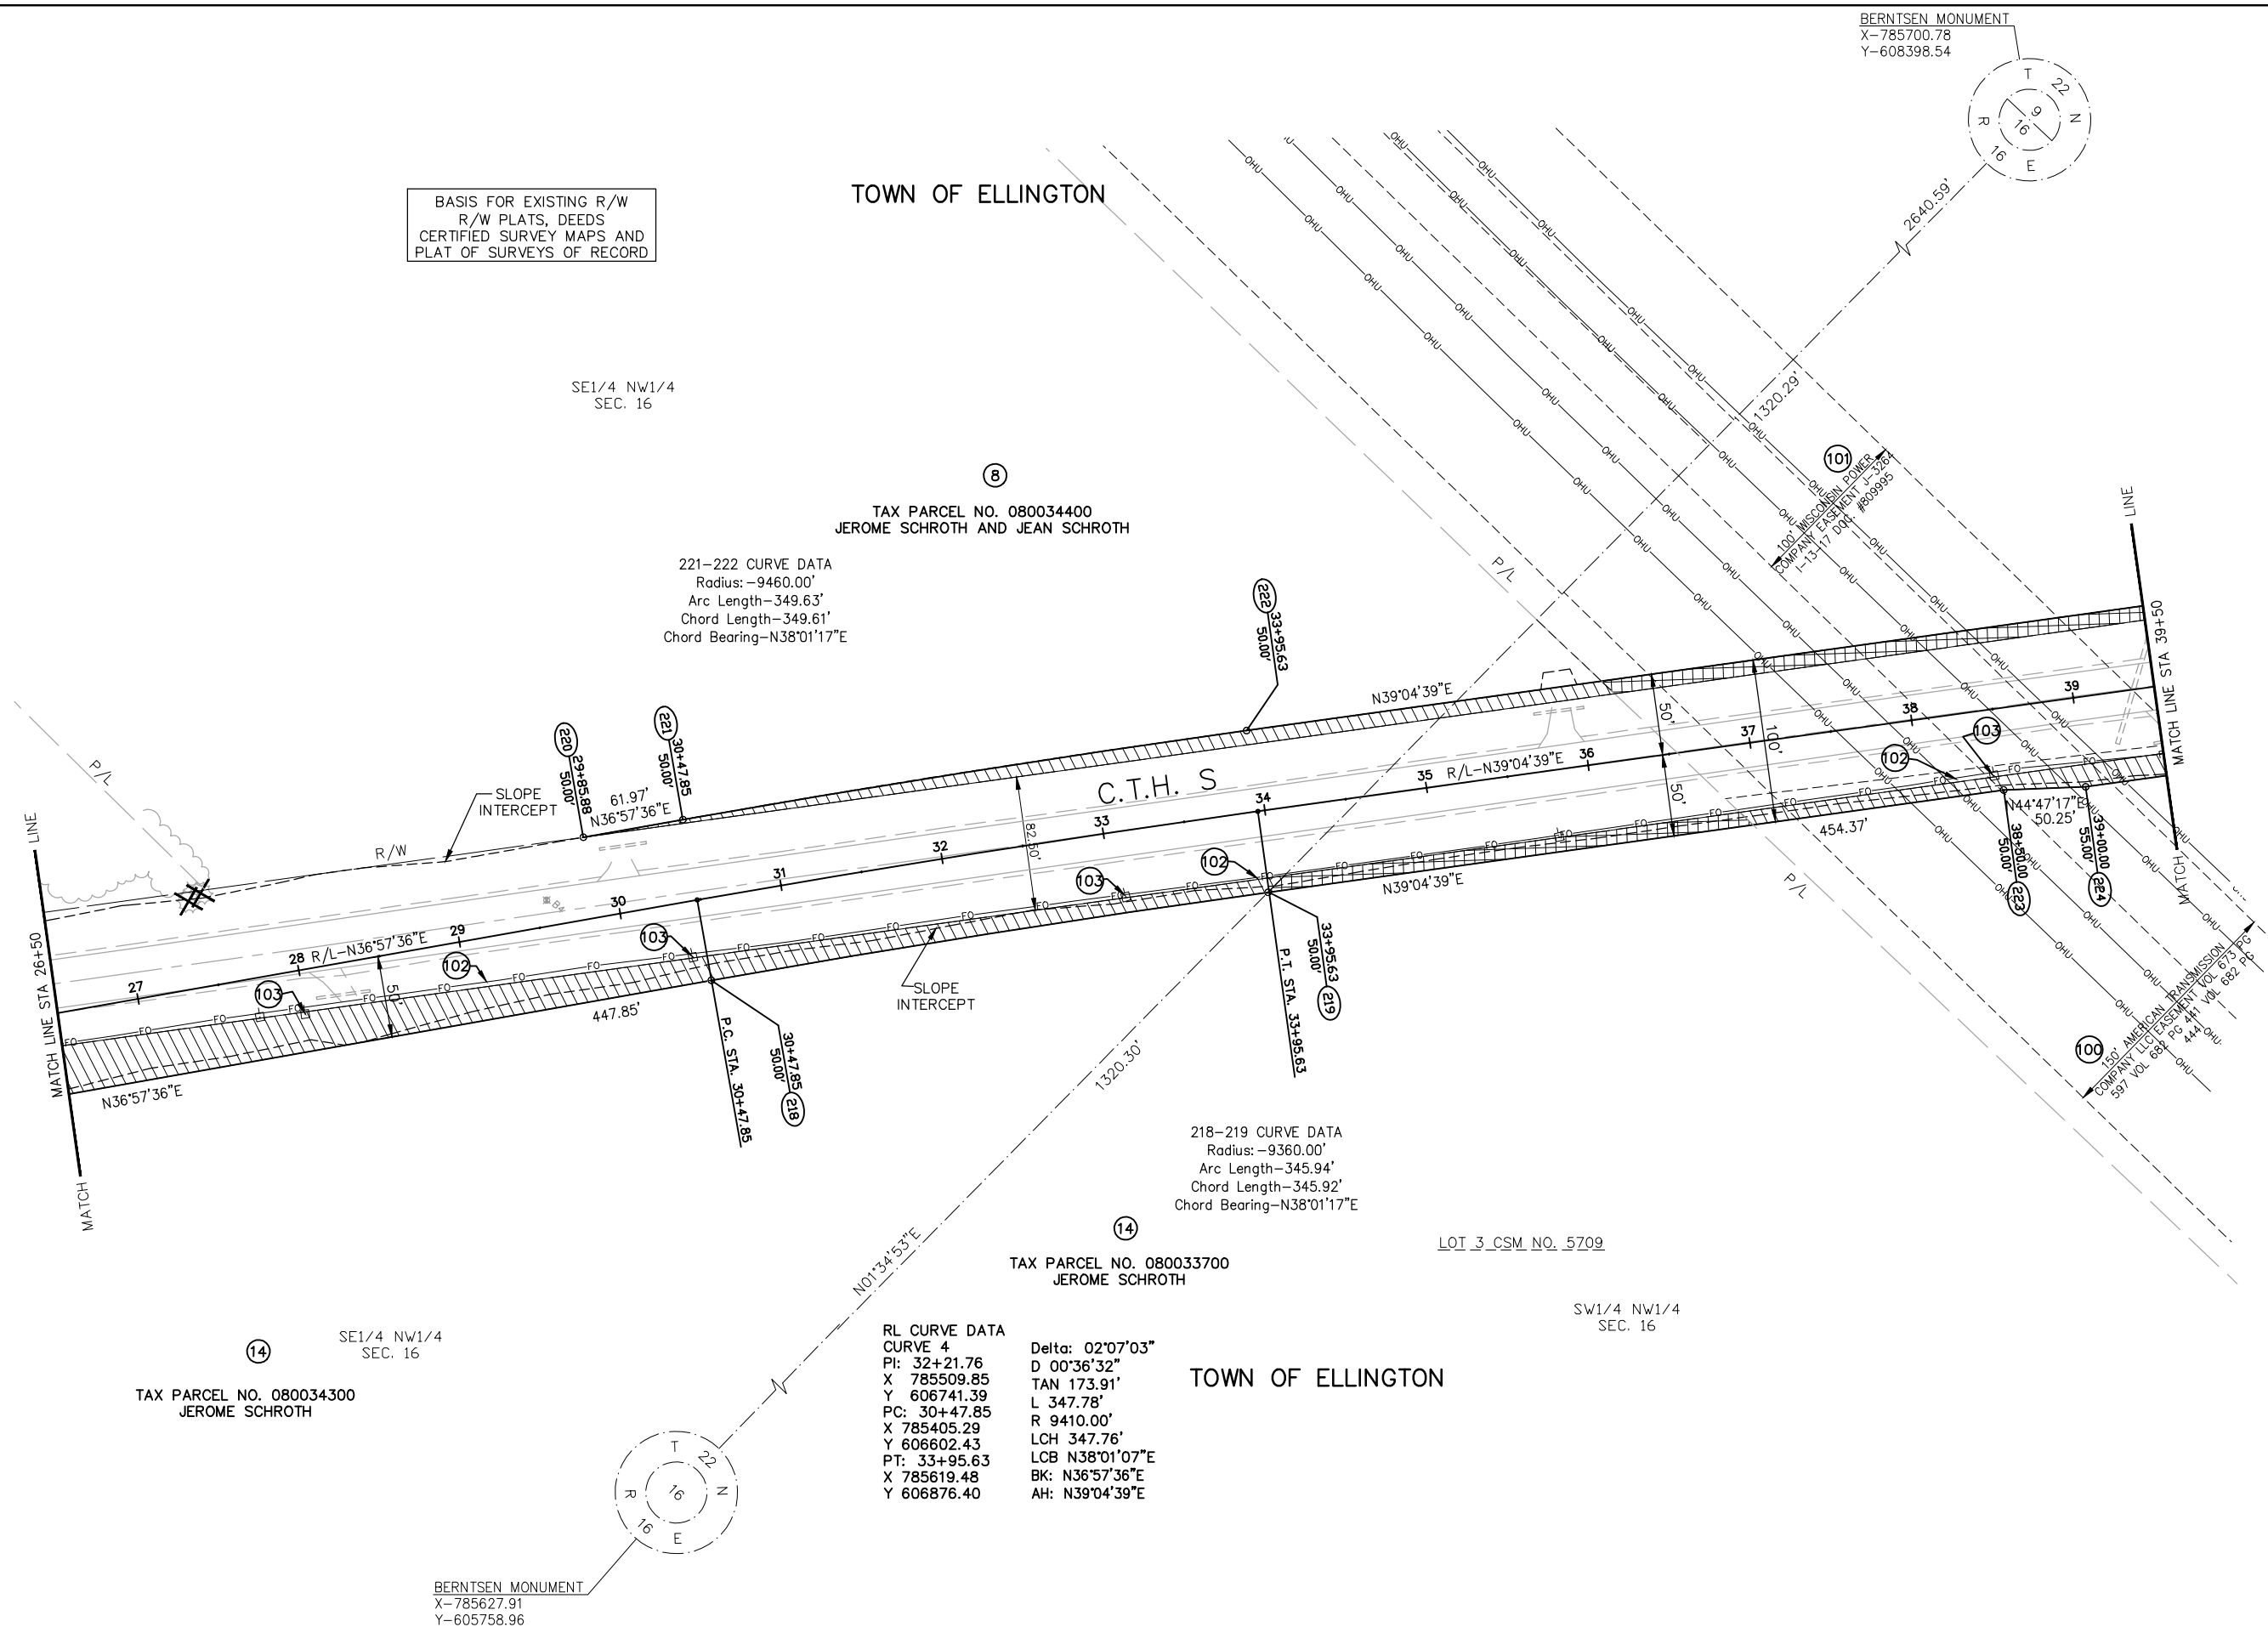

CTH 'S' (STH 76 – KELLY ROAD) OUTAGAMIE COUNTY, WISCONSIN CTH S RW PLAT		DESIGNED MPK		DRAWN MPK	
PROJECT NO. 00006 910308					
DATE FEBRUARY, 2014					
SHEET NO. 32					

m:\projects\00006\910308\20_RW_PLAT.dwg, 33.ctb s.rw.plat, Plot Date: 2/25/2014 3:40 PM, xrefs: (x-rw.plat info, x-cth.s topo, x-proposed.cth s revised, x-rw hatching, x-tie hatch, rw comps.dwg, 50k)

TOWN OF ELLINGTON

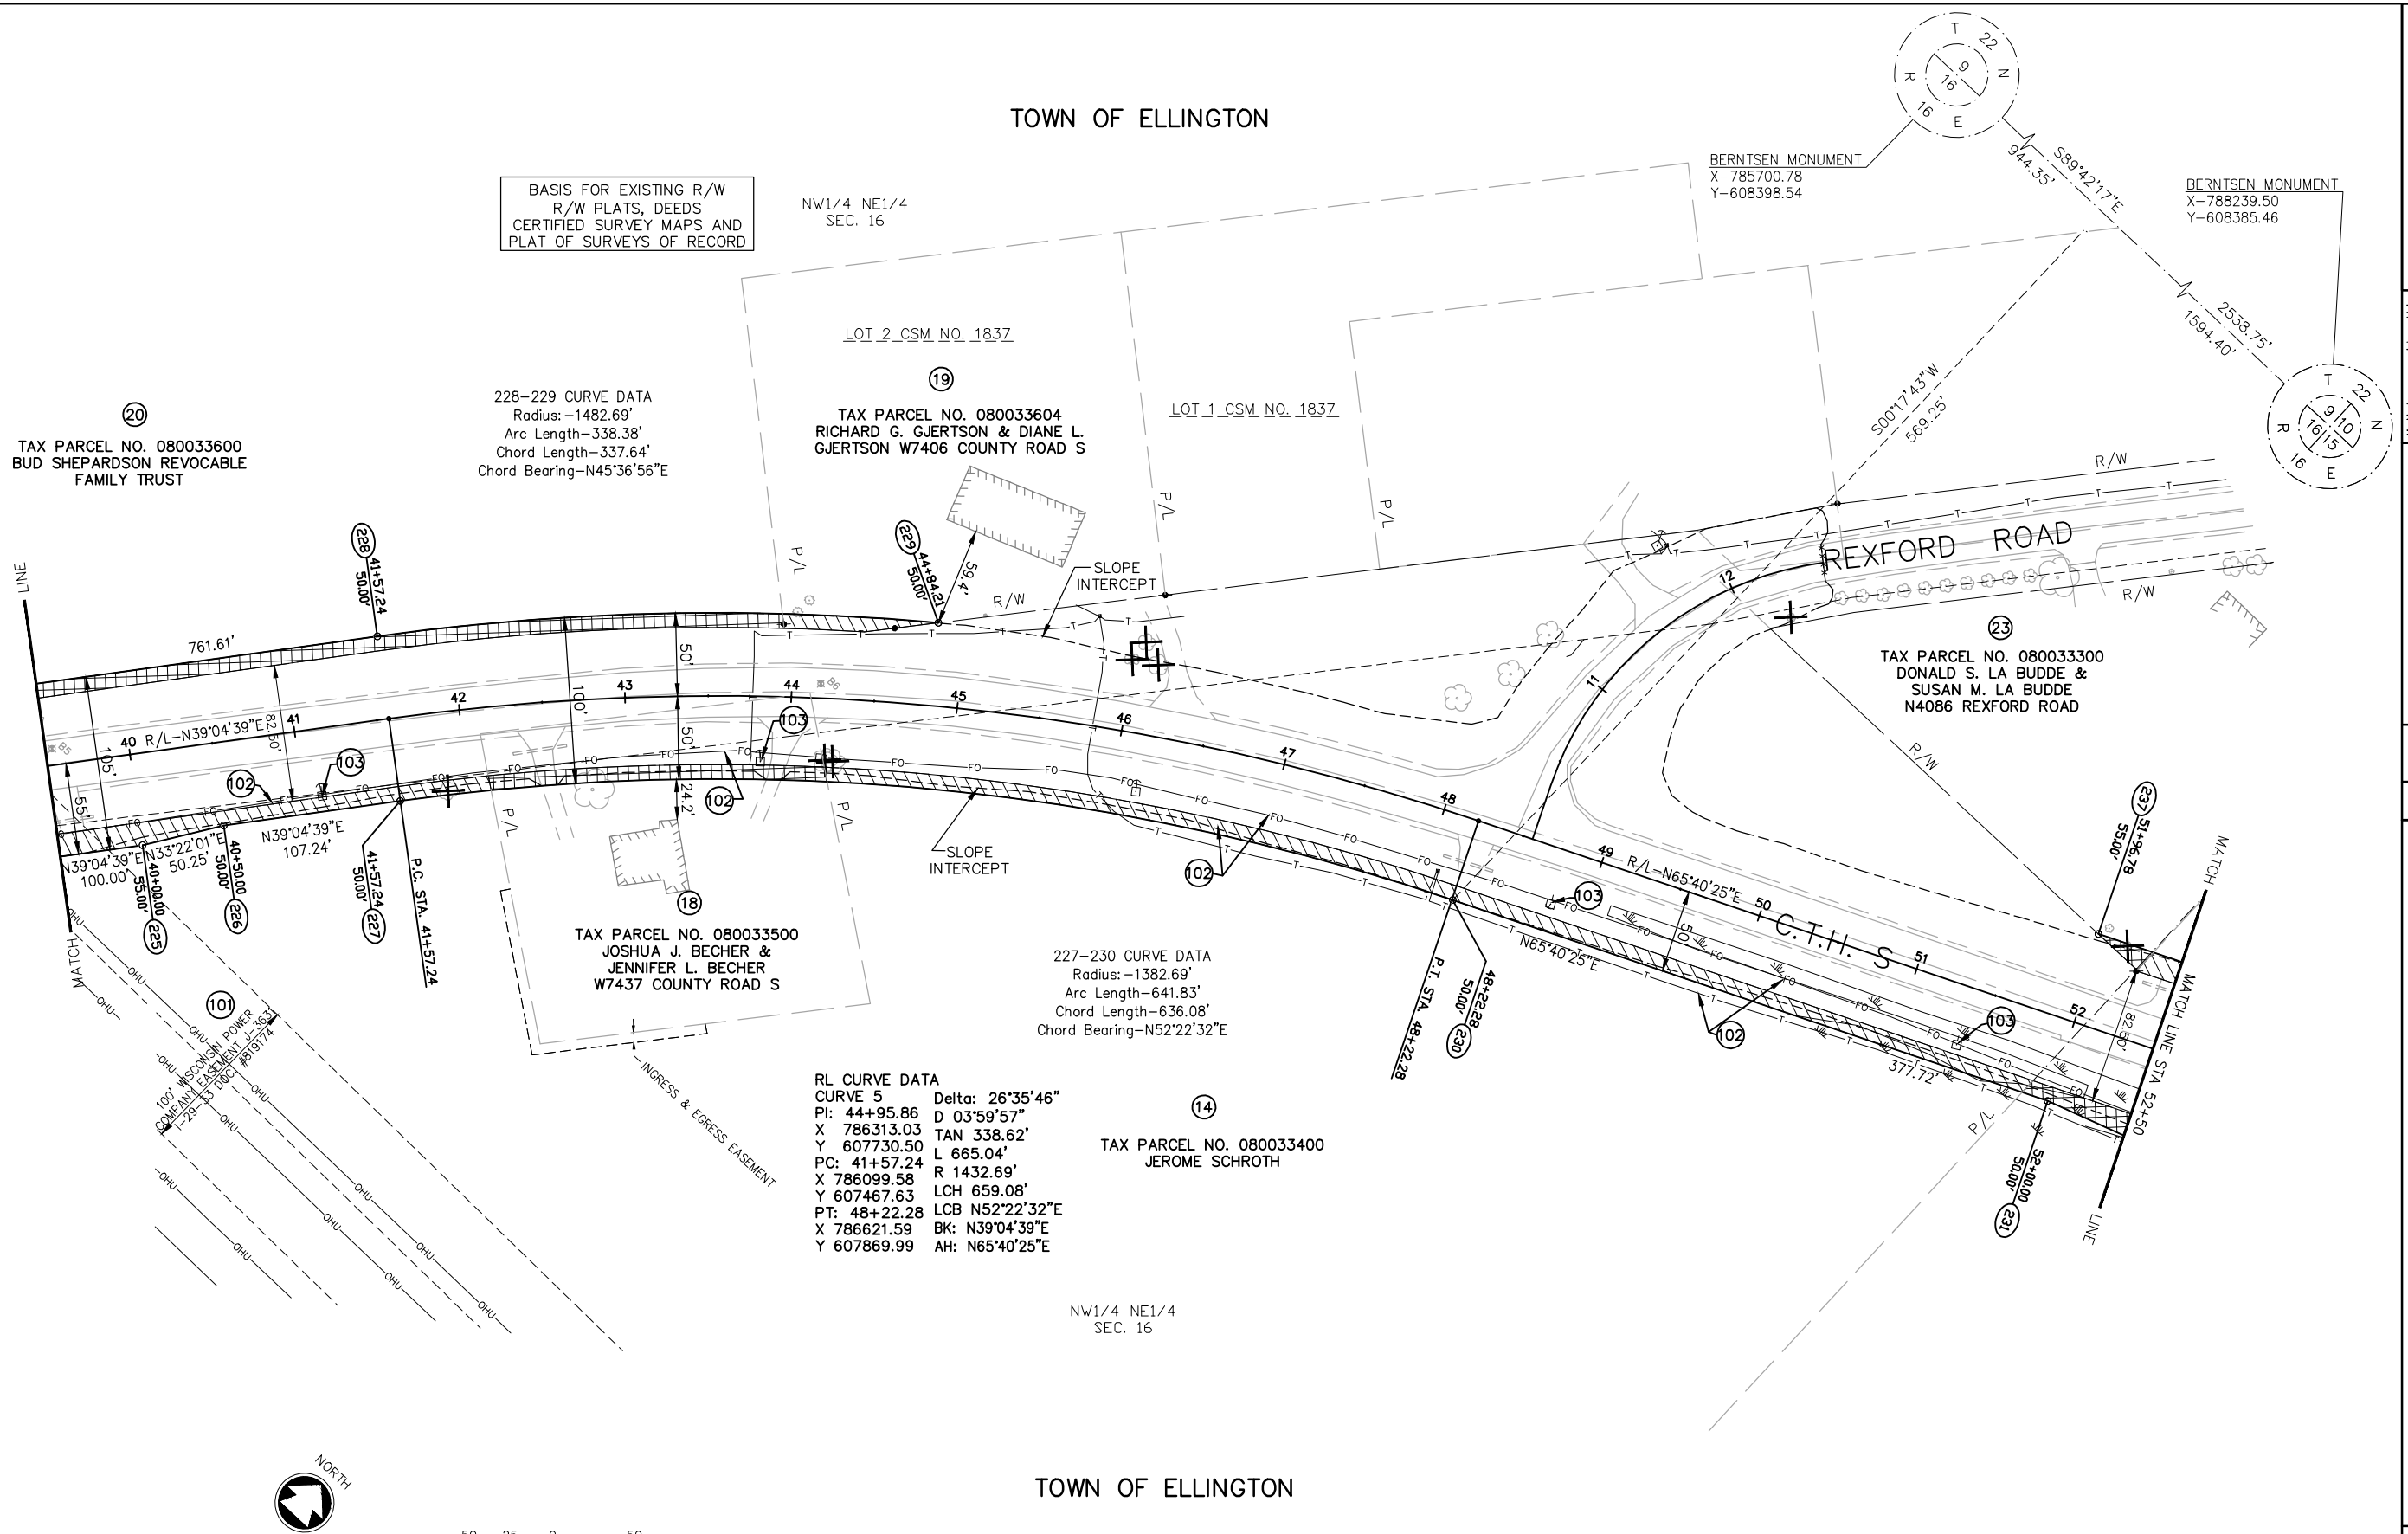


McMAHON
ENGINEERS ARCHITECTS
1445 McMAHON DRIVE NEENAH, WI 54956
Mailing: P.O. BOX 1025 NEENAH, WI 54957-1025
Tel: (920) 751-4200 Fax: (920) 751-4284
www.mcmgrp.com

McMahon provides this drawing and data, regardless of form, as instruments of service. The client and/or user of this drawing and data shall be responsible for obtaining all necessary permits, licenses, and approvals from the appropriate authorities. The client and/or user shall indemnify and hold McMahon harmless from all claims, damages, and expenses, including reasonable attorneys' fees, arising from or due to the use of this drawing or data without prior written consent by McMahon.



NO.	DATE	REVISION


CTH 'S' (STH 76 - KELLY ROAD)
OUTAGAMIE COUNTY, WISCONSIN
CTH S RW PLAT

DESIGNED MPK	DRAWN MPK
PROJECT NO. 00006 910308	
DATE FEBRUARY, 2014	
SHEET NO. 33	


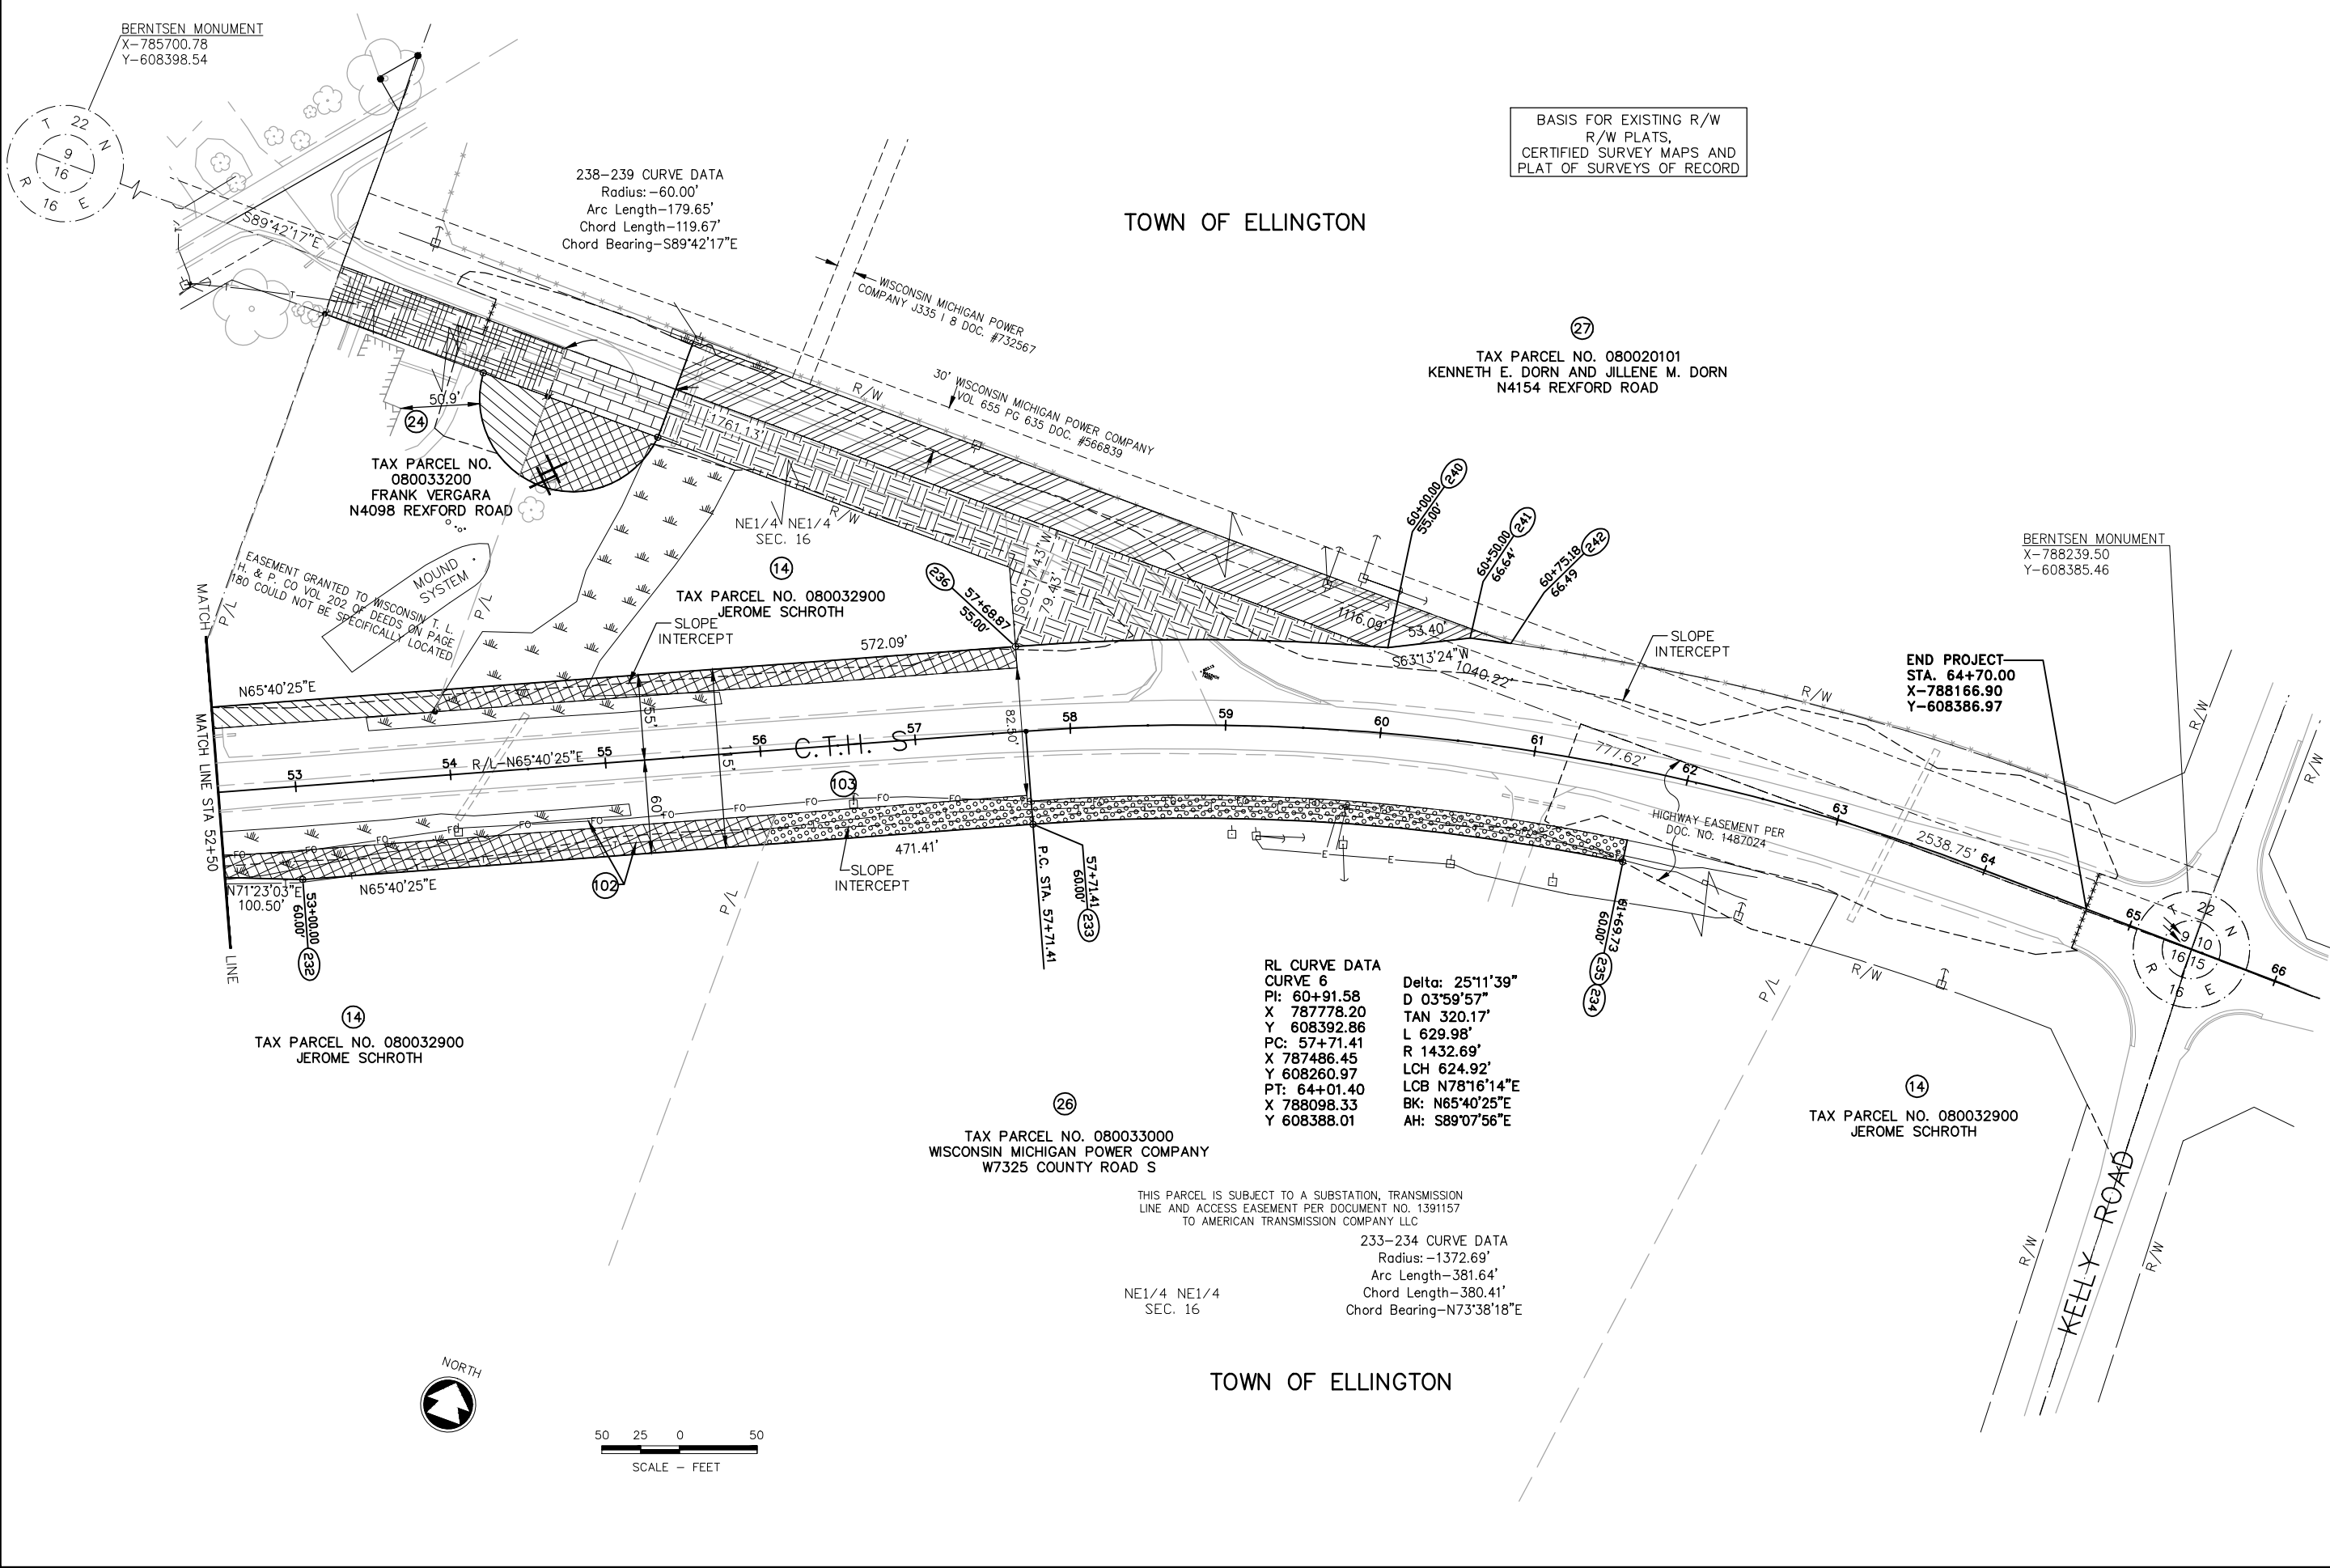


mkohlbeck, W:\PROJECTS\00006\910308\08-Design\Plan & Profile\35 PLAN & PROFILE.dwg, 35 plan & profile, Plot Date: 2/26/2014 10:39 AM, xrefs: (x-proposed cth s revised, x-proposed profile, x-cth s topo, rw comps dew, x-june 26 2013 additional topo)

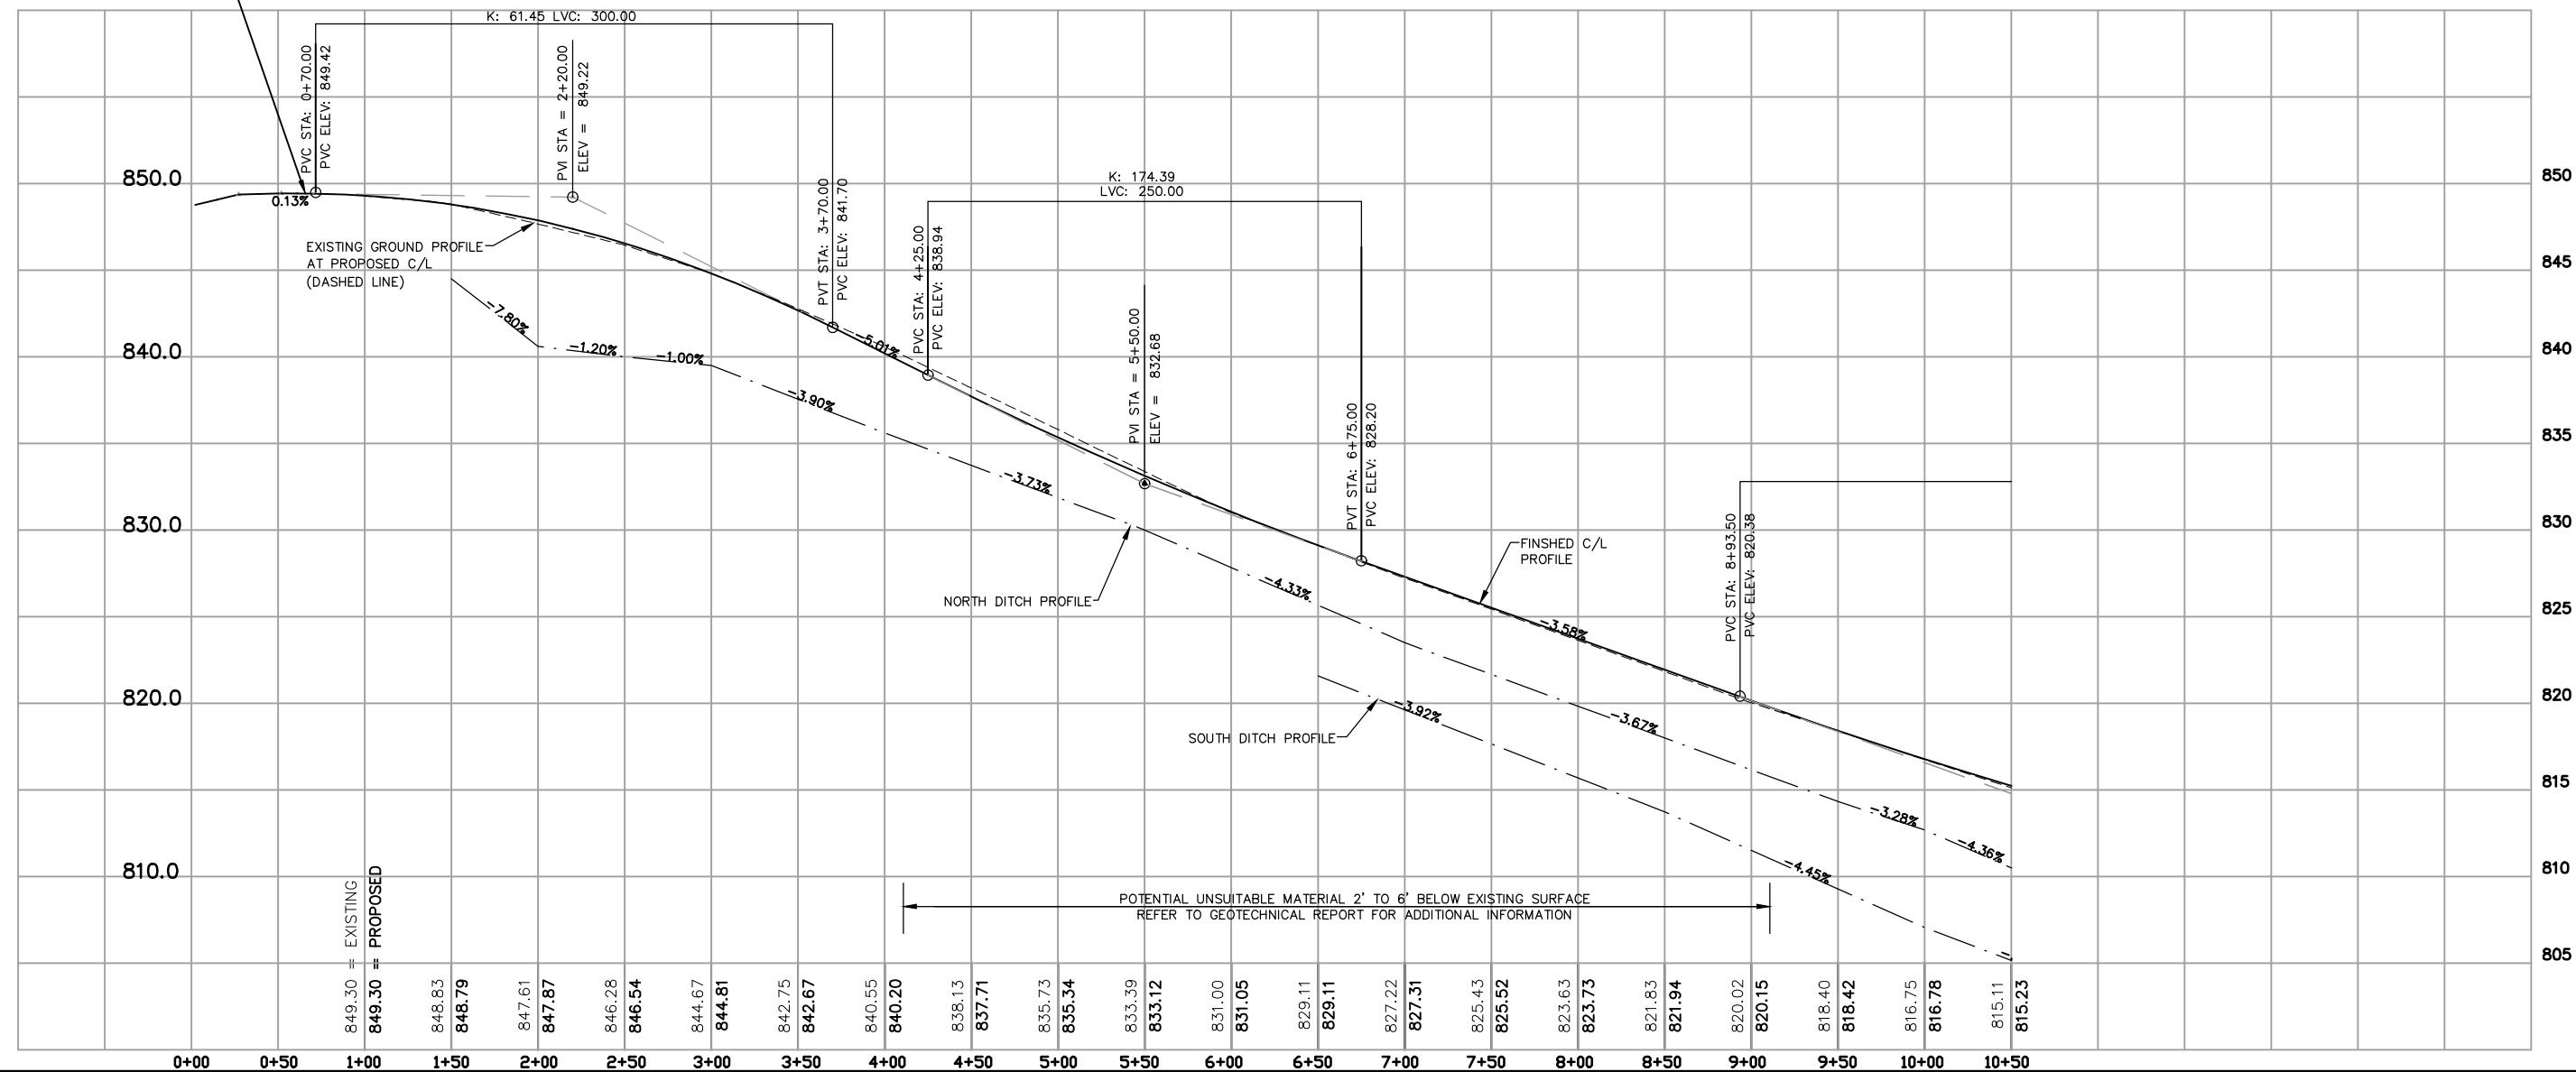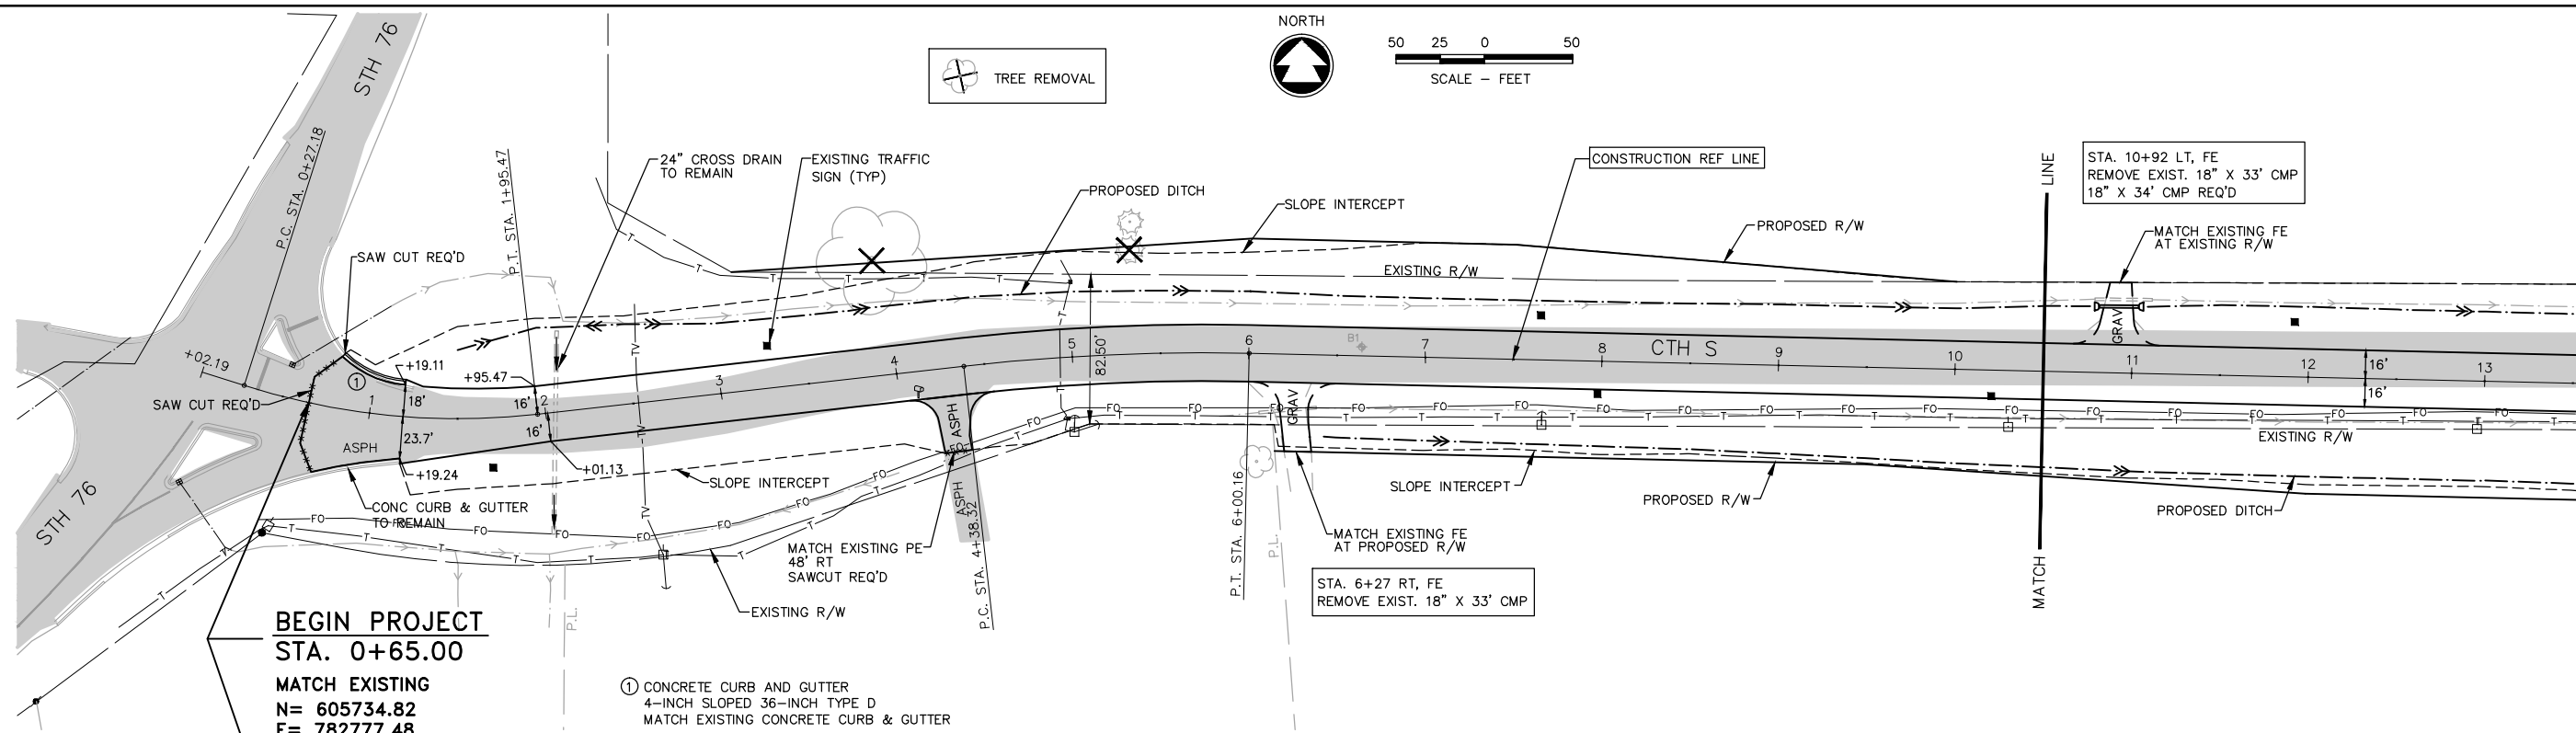[illegible]

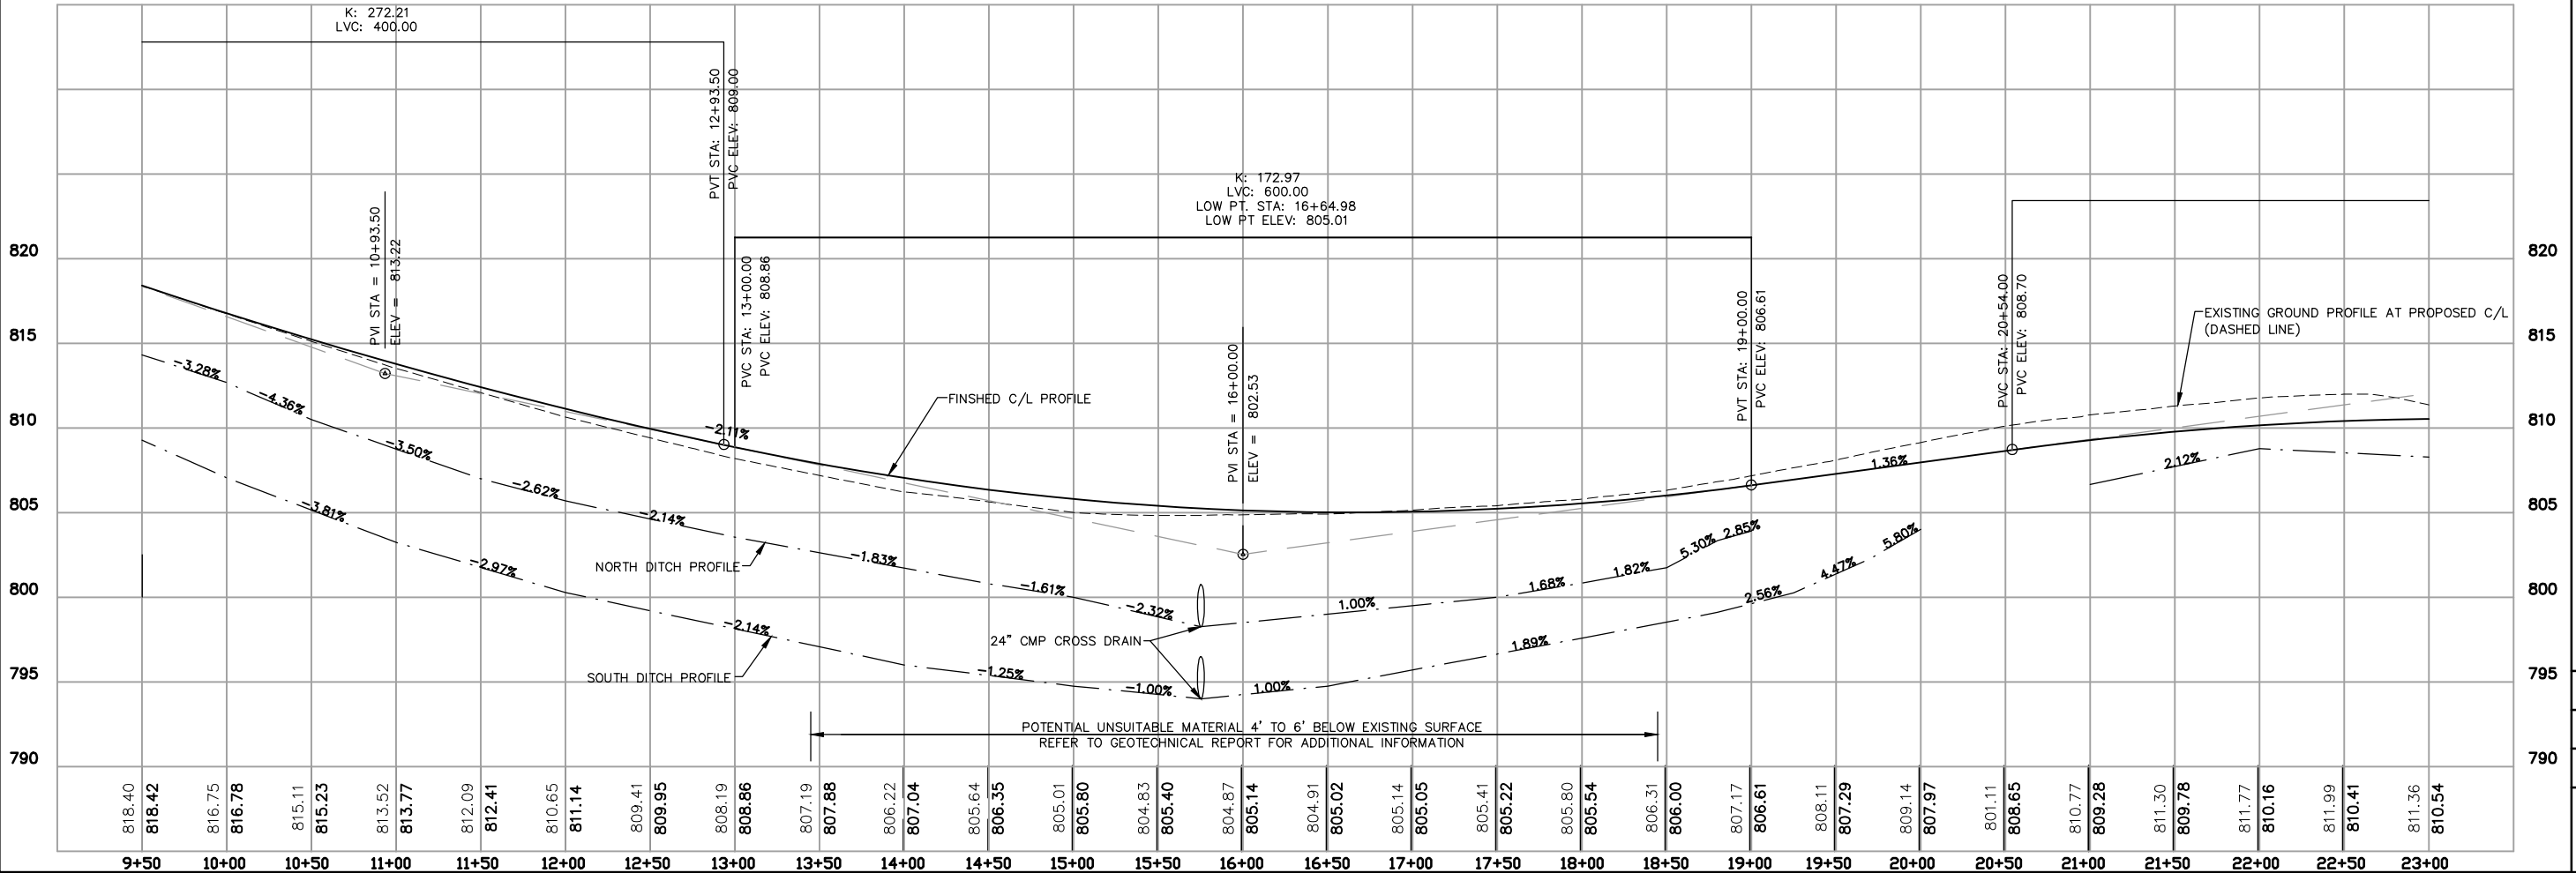

m:\hoback\w:\PROJECTS\00006\910308\08-Design\Plan & Profile\37 plan & profile.dwg, Plot Date: 2/25/2014 3:41 PM, xrefs:none

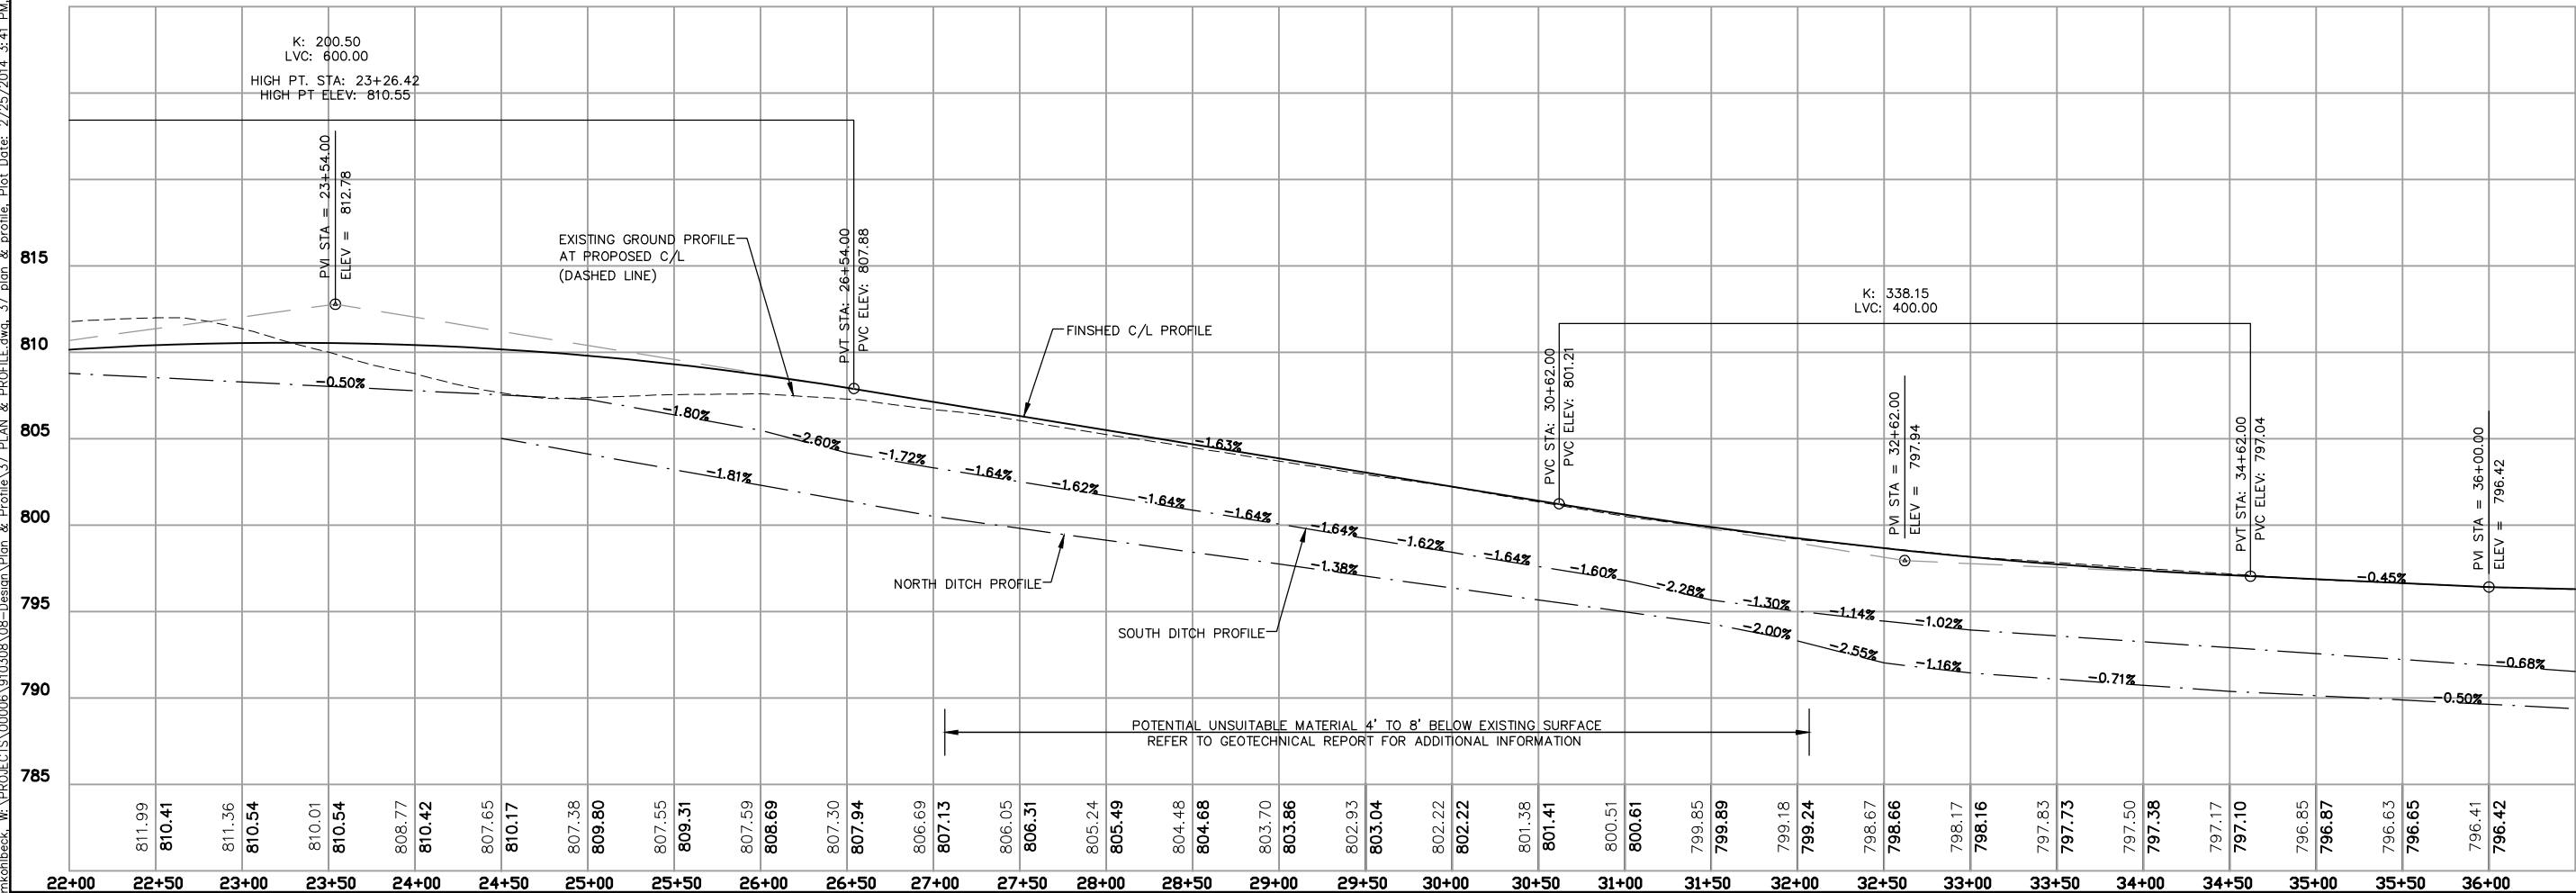
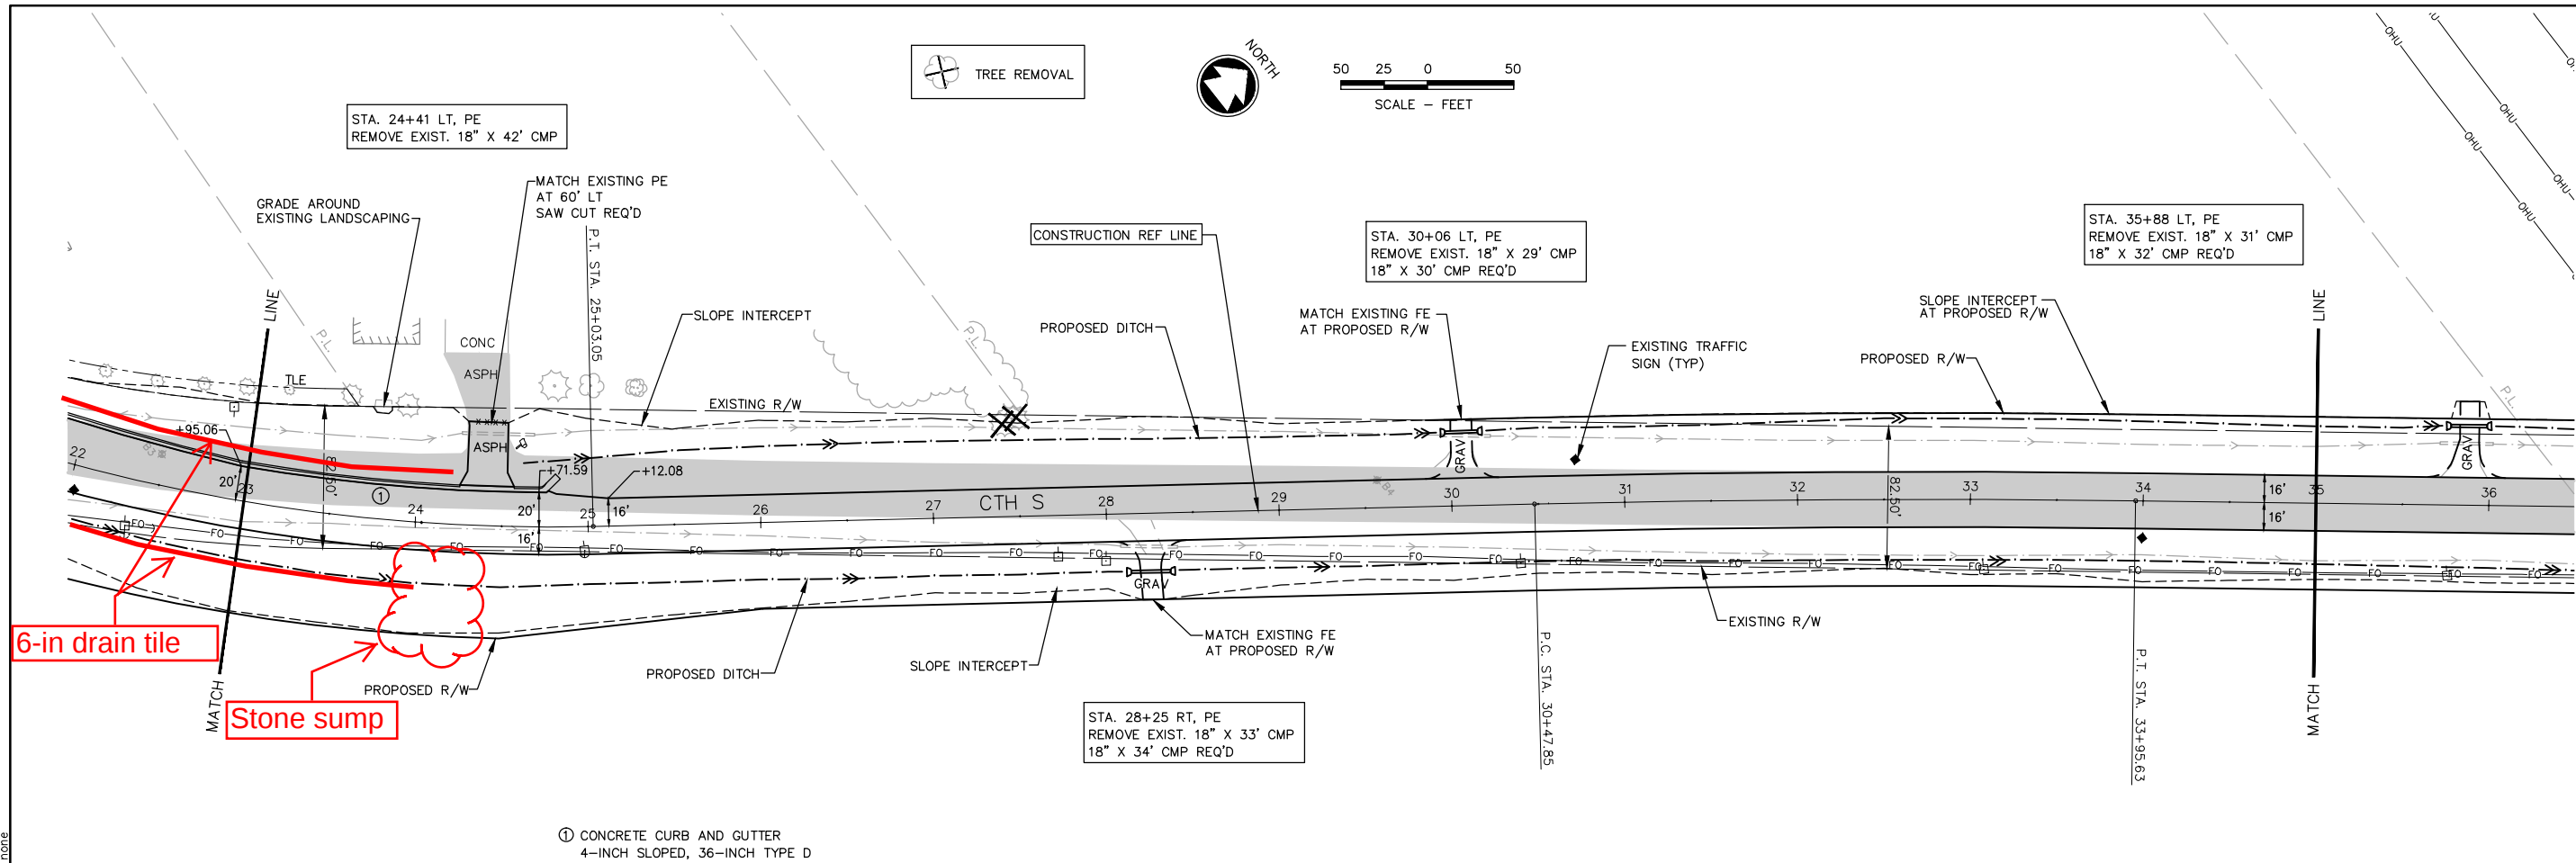


NO.	DATE	REVISION

CTH 'S' (STH 76 - KELLY ROAD)
OUTAGAMIE COUNTY, WISCONSIN
PLAN & PROFILE

DESIGNED MPK	DRAWN MPK
PROJECT NO. 00006 910308	DATE FEBRUARY, 2014
SHEET NO. 37	

mkenbeck, w:\PROJECTS\00006\910308\08-Design\Plan & Profile\38 plan & profile, Plot Date: 2/26/2014 10:42 AM, xrefis:none

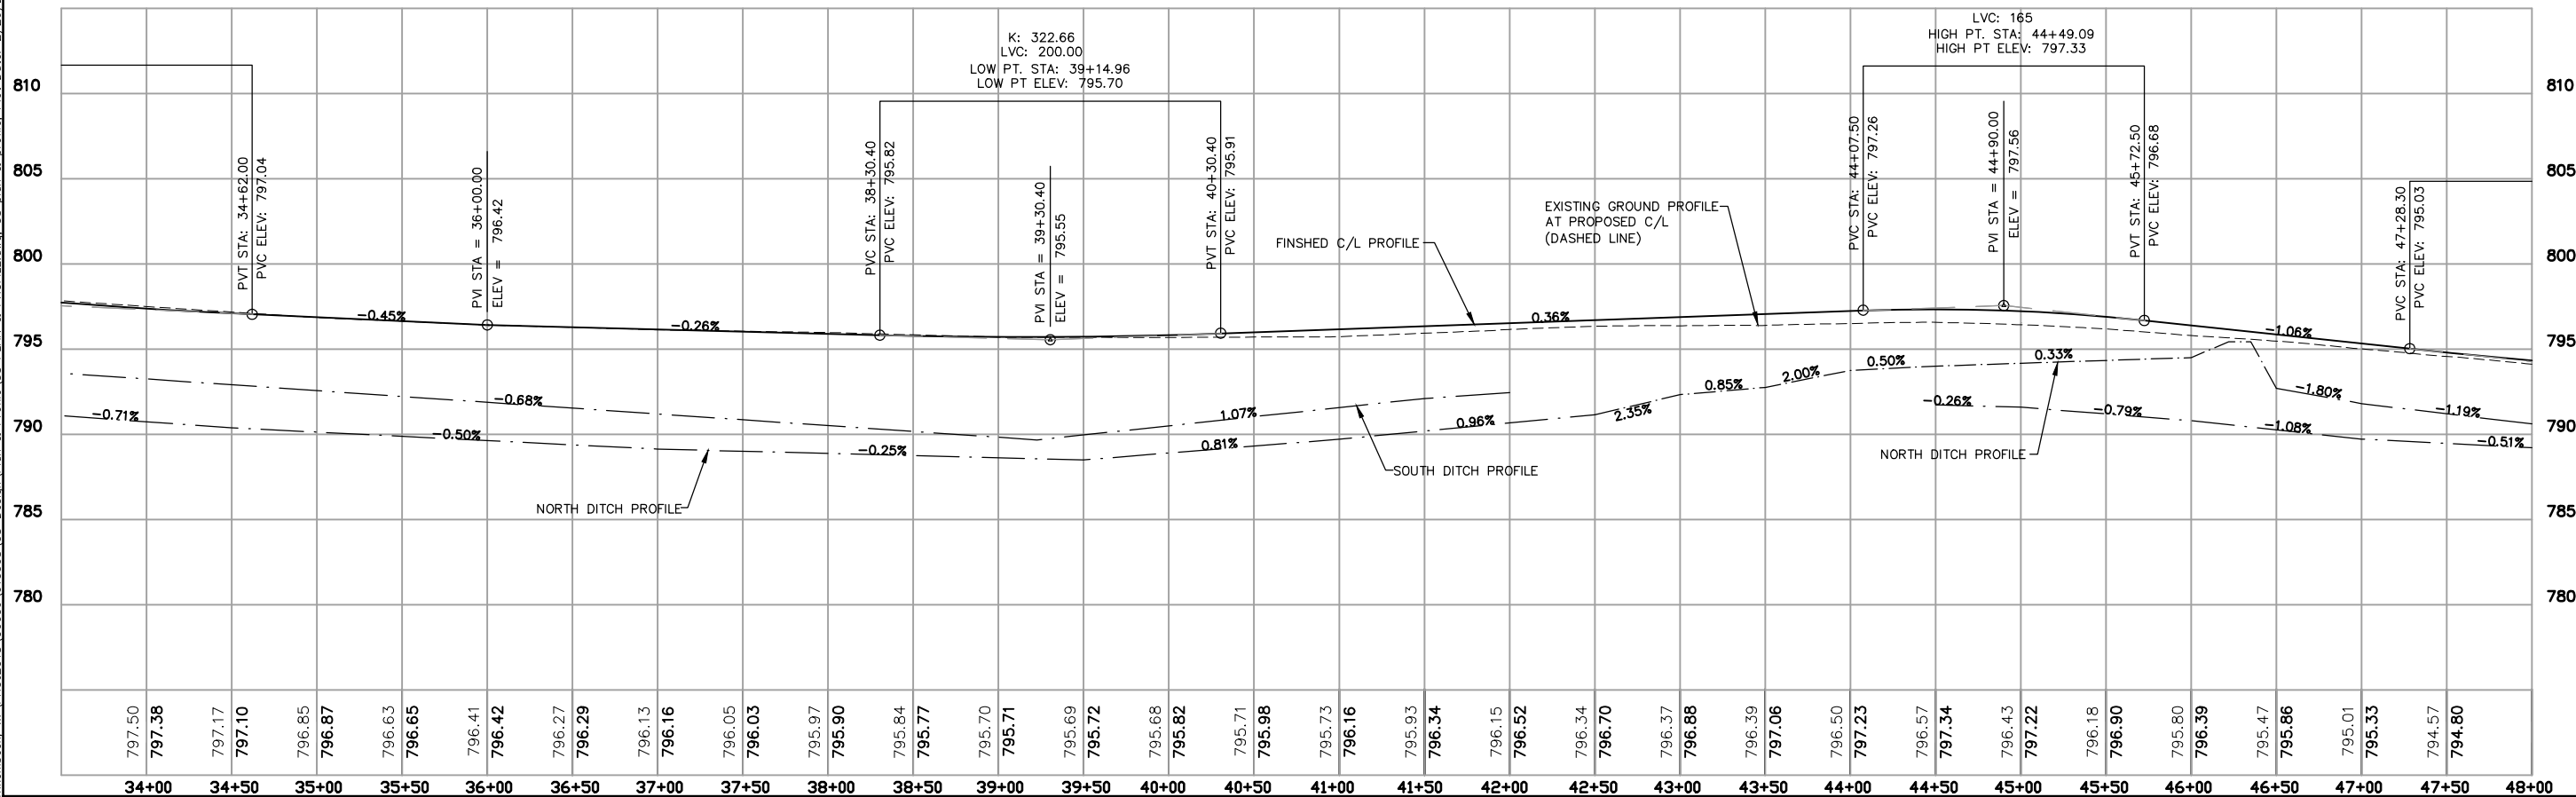
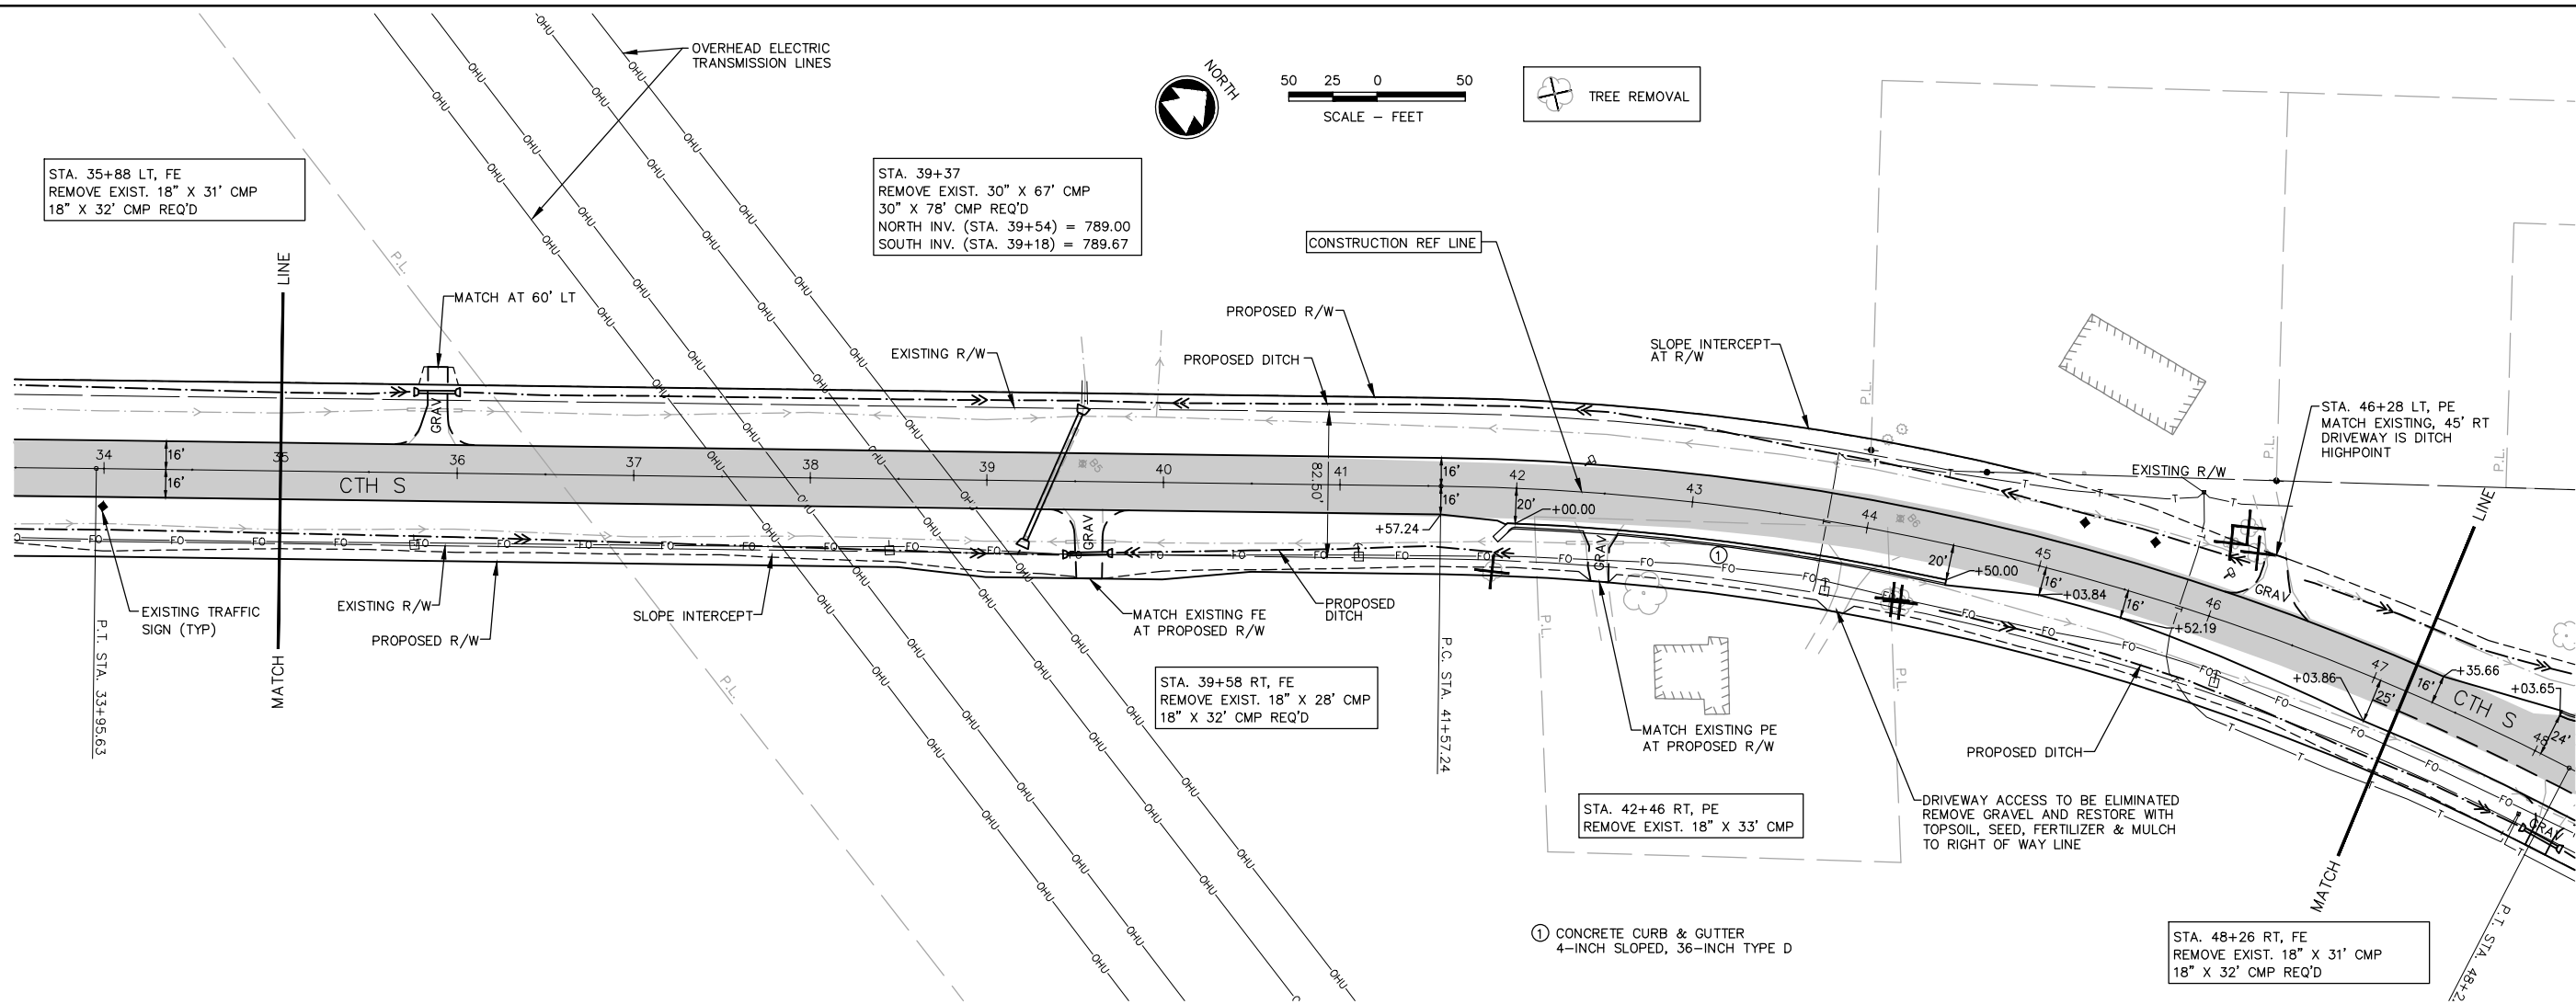


NO.	DATE	REVISION

CTH 'S' (STH 76 - KELLY ROAD)
OUTAGAMIE COUNTY, WISCONSIN
PLAN & PROFILE



DESIGNED MPK	DRAWN MPK
PROJECT NO. 00006 910308	
DATE FEBRUARY, 2014	
SHEET NO. 38	

m:\chilbeck_w:\PROJECTS\00006\910308\08-Design\Plan & Profile\39 Plan & Profile.dwg, 39 plan & profile, Plot Date: 4/12/2014 3:31 PM, xrefs: (x=proposed cth s revised, x=proposed profile, x=cth s topo, r=compd dew, x=june 26 2013 additional topo)

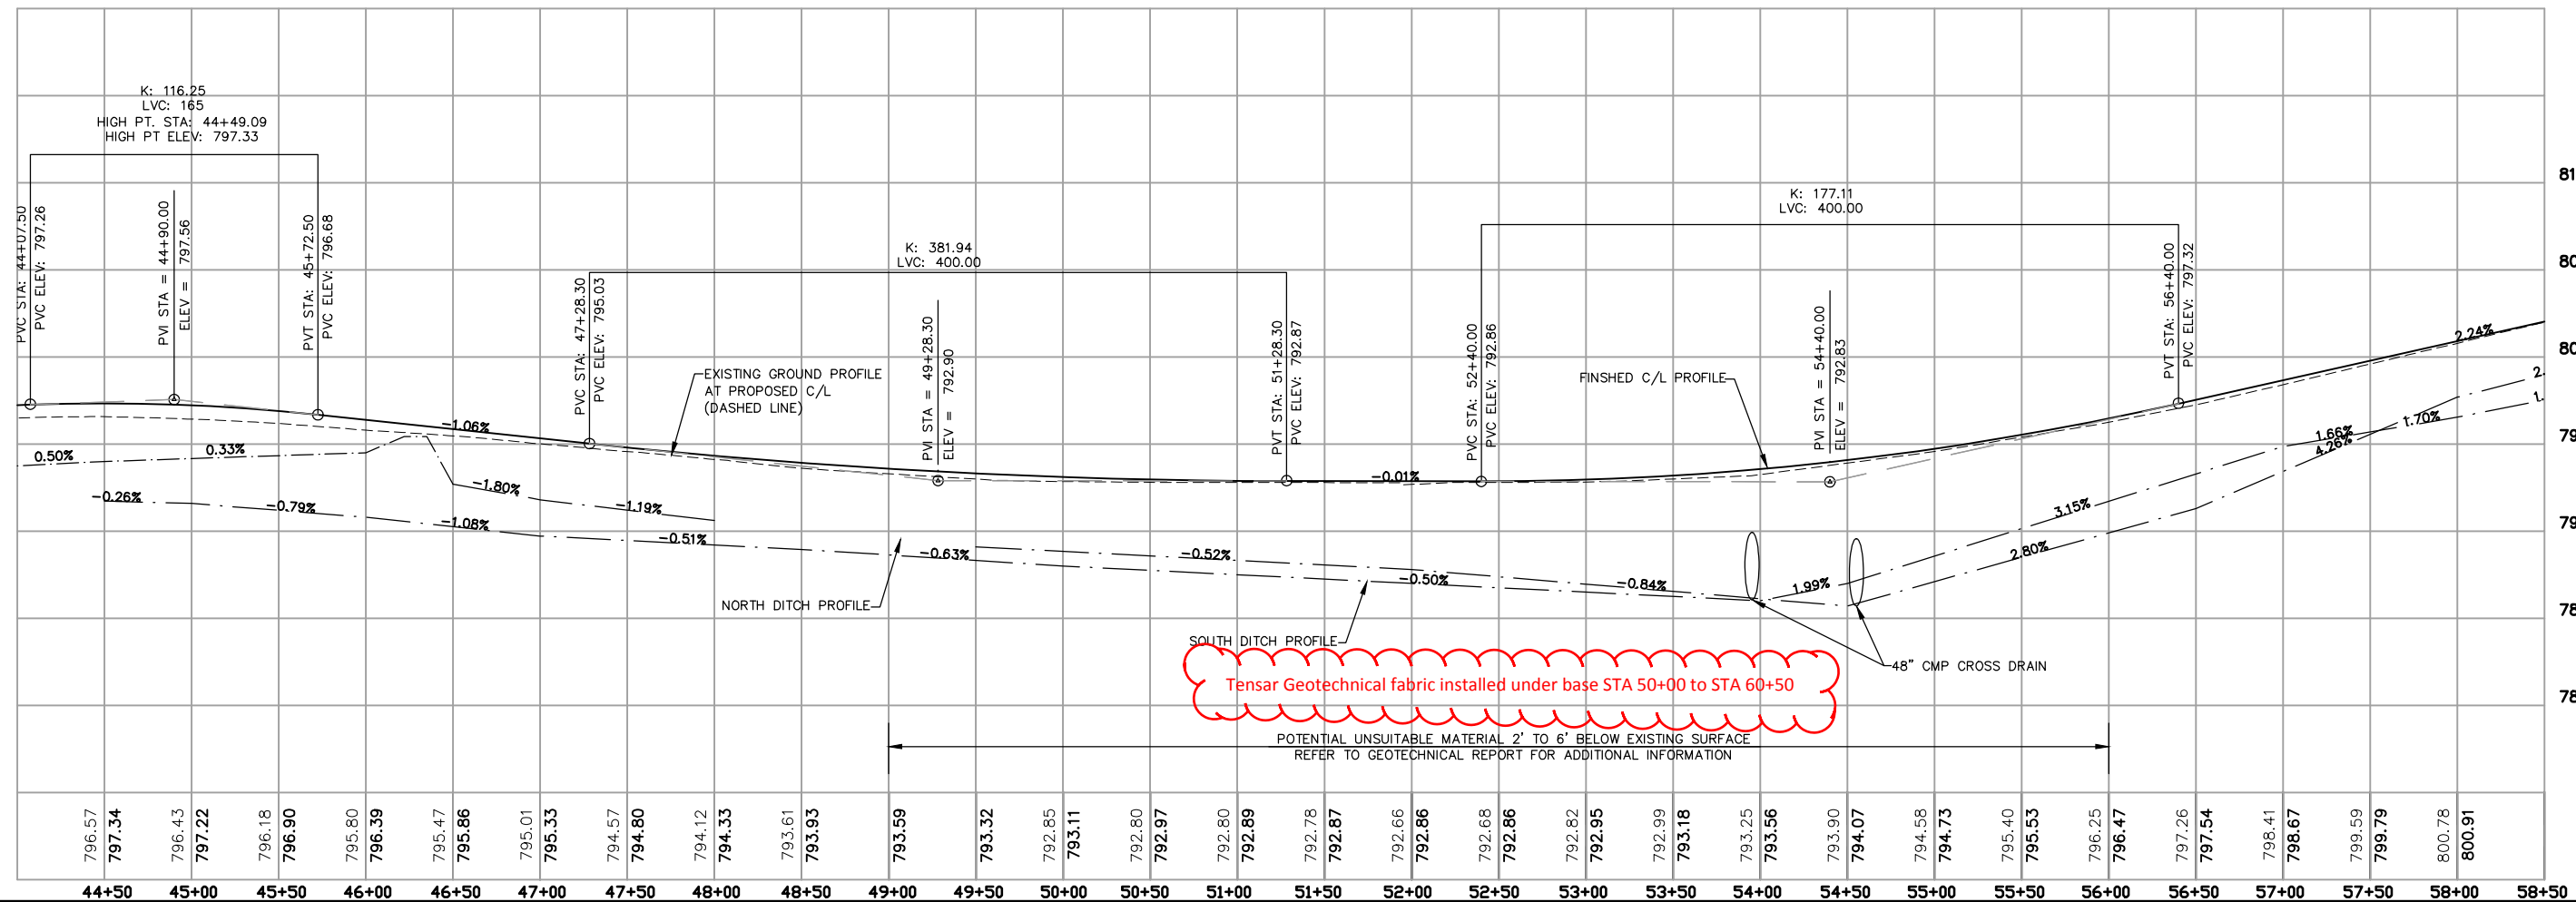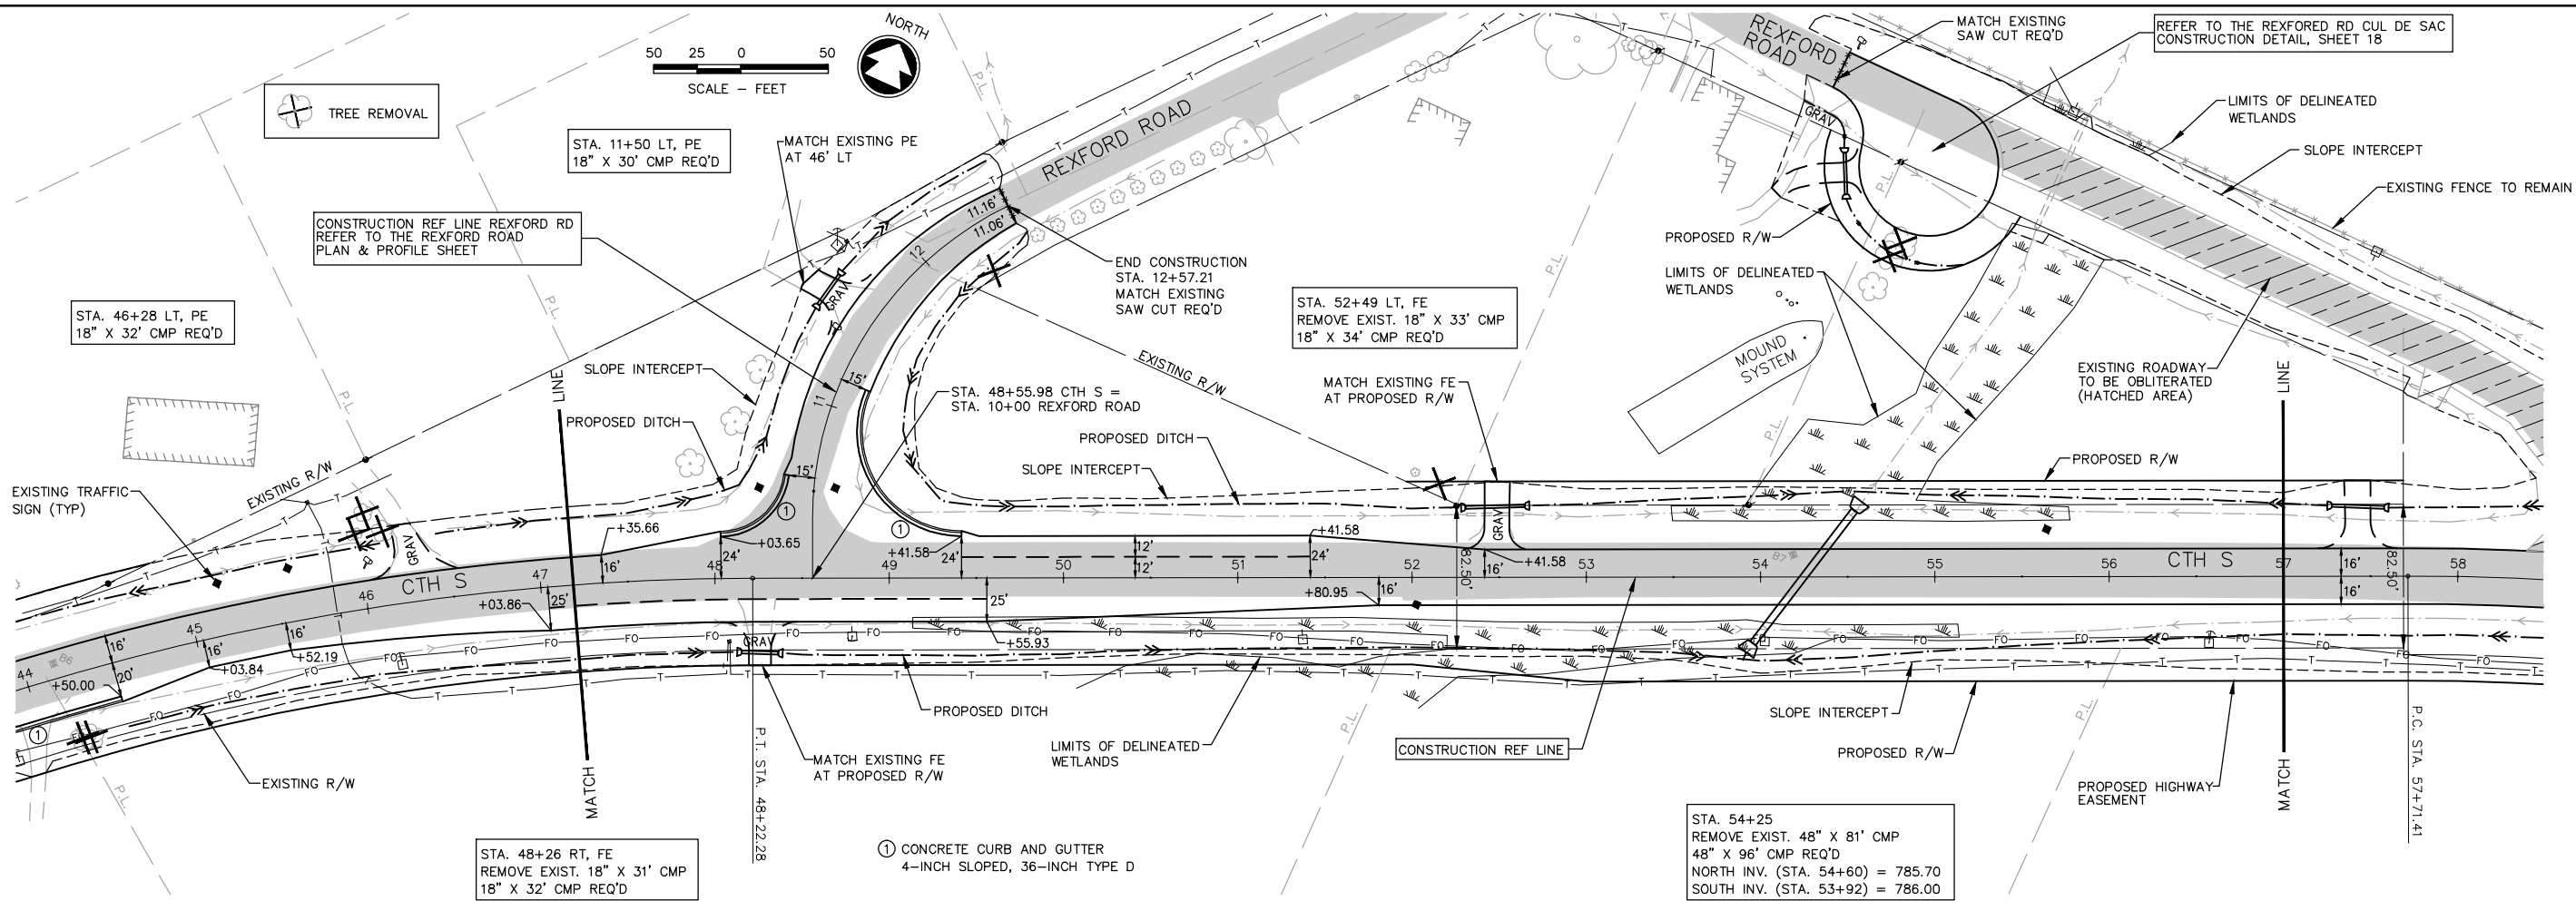


NO.	DATE	REVISION

m:\projects\00006\910308\08-Design\Plan & Profile\40 PLAN & PROFILE.dwg, 40 plan & profile, Plot Date: 4/12/2014 2:57 PM, xrefs: (x-proposed cth s revised, x-proposed profile, x-cth s topo, rw comps dew, x-lne 26 2013 additional topo)

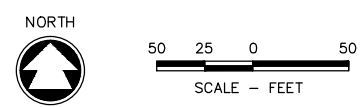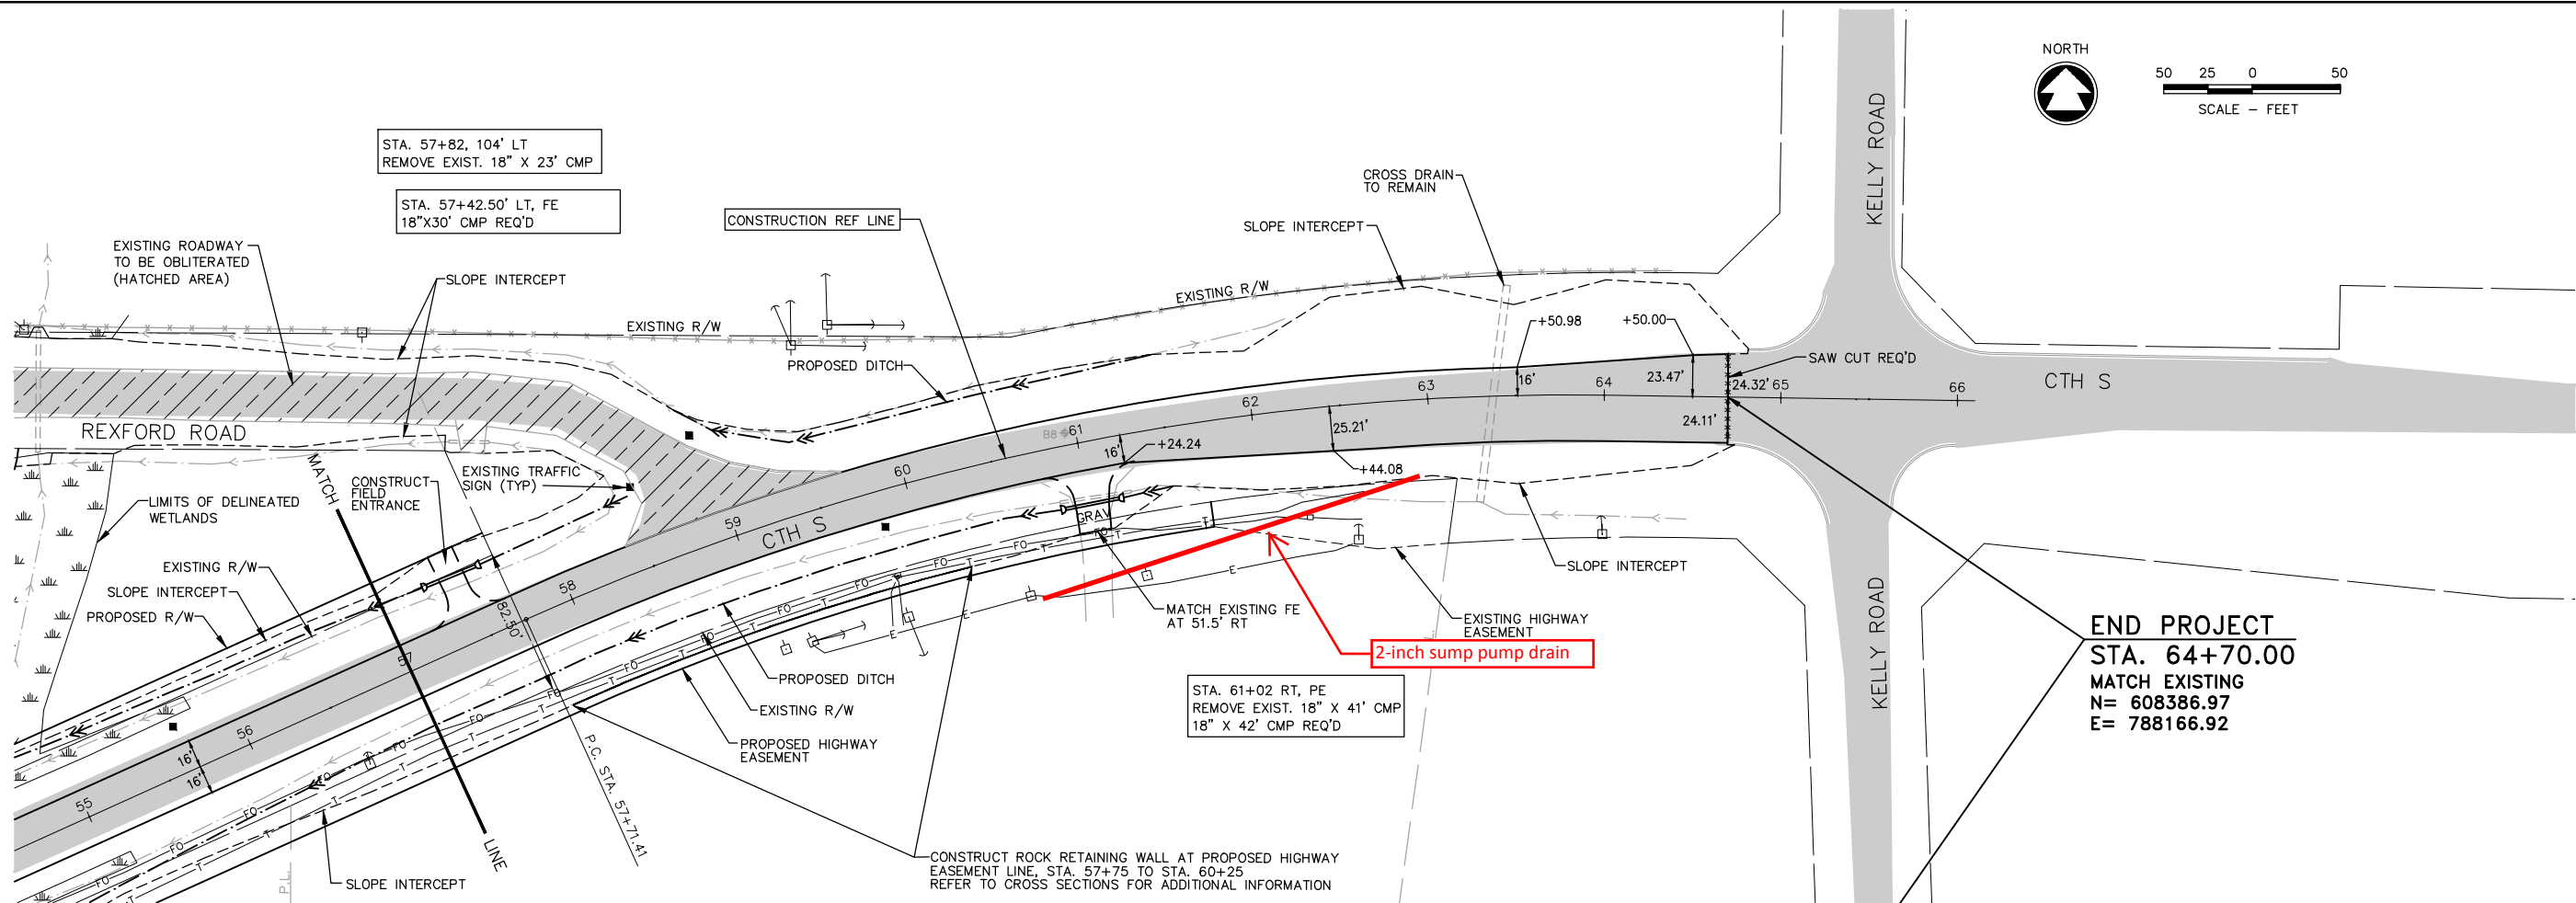

END PROJECT
STA. 64+70.00
MATCH EXISTING
N= 608386.97
E= 788166.92

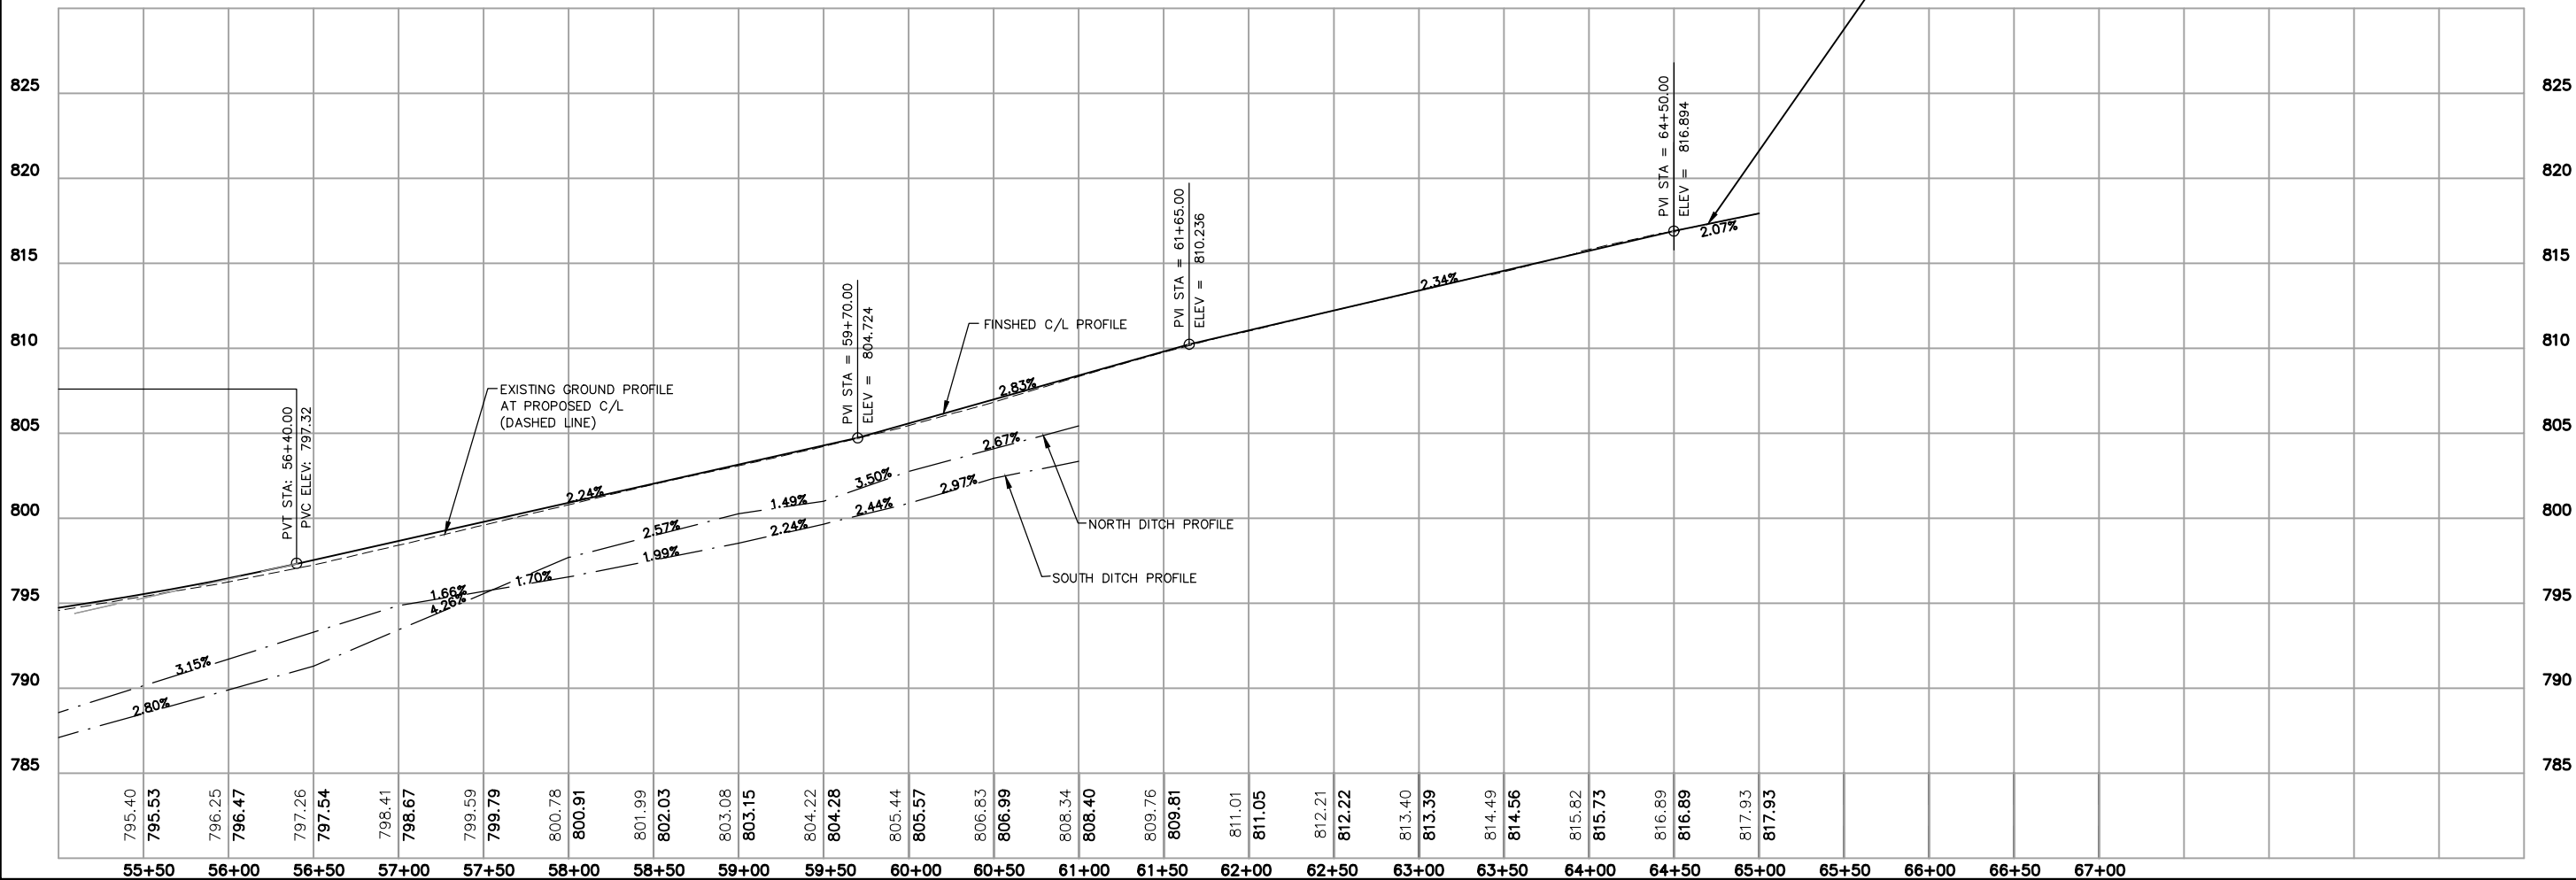

McMAHON
ENGINEERS ARCHITECTS
1445 McMAHON DRIVE NEENAH, WI 54956
Mailing: P.O. BOX 1025 NEENAH, WI 54957-0025
Tel: (920) 751-4200 Fax: (920) 751-4284
www.mcngroup.com

McMahon provides this drawing and data, regardless of form, as instruments of service. The client and/or user of this drawing shall be responsible for obtaining all necessary permits and for verifying the accuracy of the data and the appropriateness of the design. McMahon, its employees, and its agents shall not be liable for any damages, including consequential damages, arising out of the use of this drawing or data without prior written consent by McMahon.

NO.	DATE	REVISION


CTH 'S' (STH 76 - KELLY ROAD)
OUTAGAMIE COUNTY, WISCONSIN
PLAN & PROFILE

DESIGNED	DRAWN
MPK	MPK

PROJECT NO.
00006 910308

DATE
FEBRUARY, 2014

SHEET NO.
40

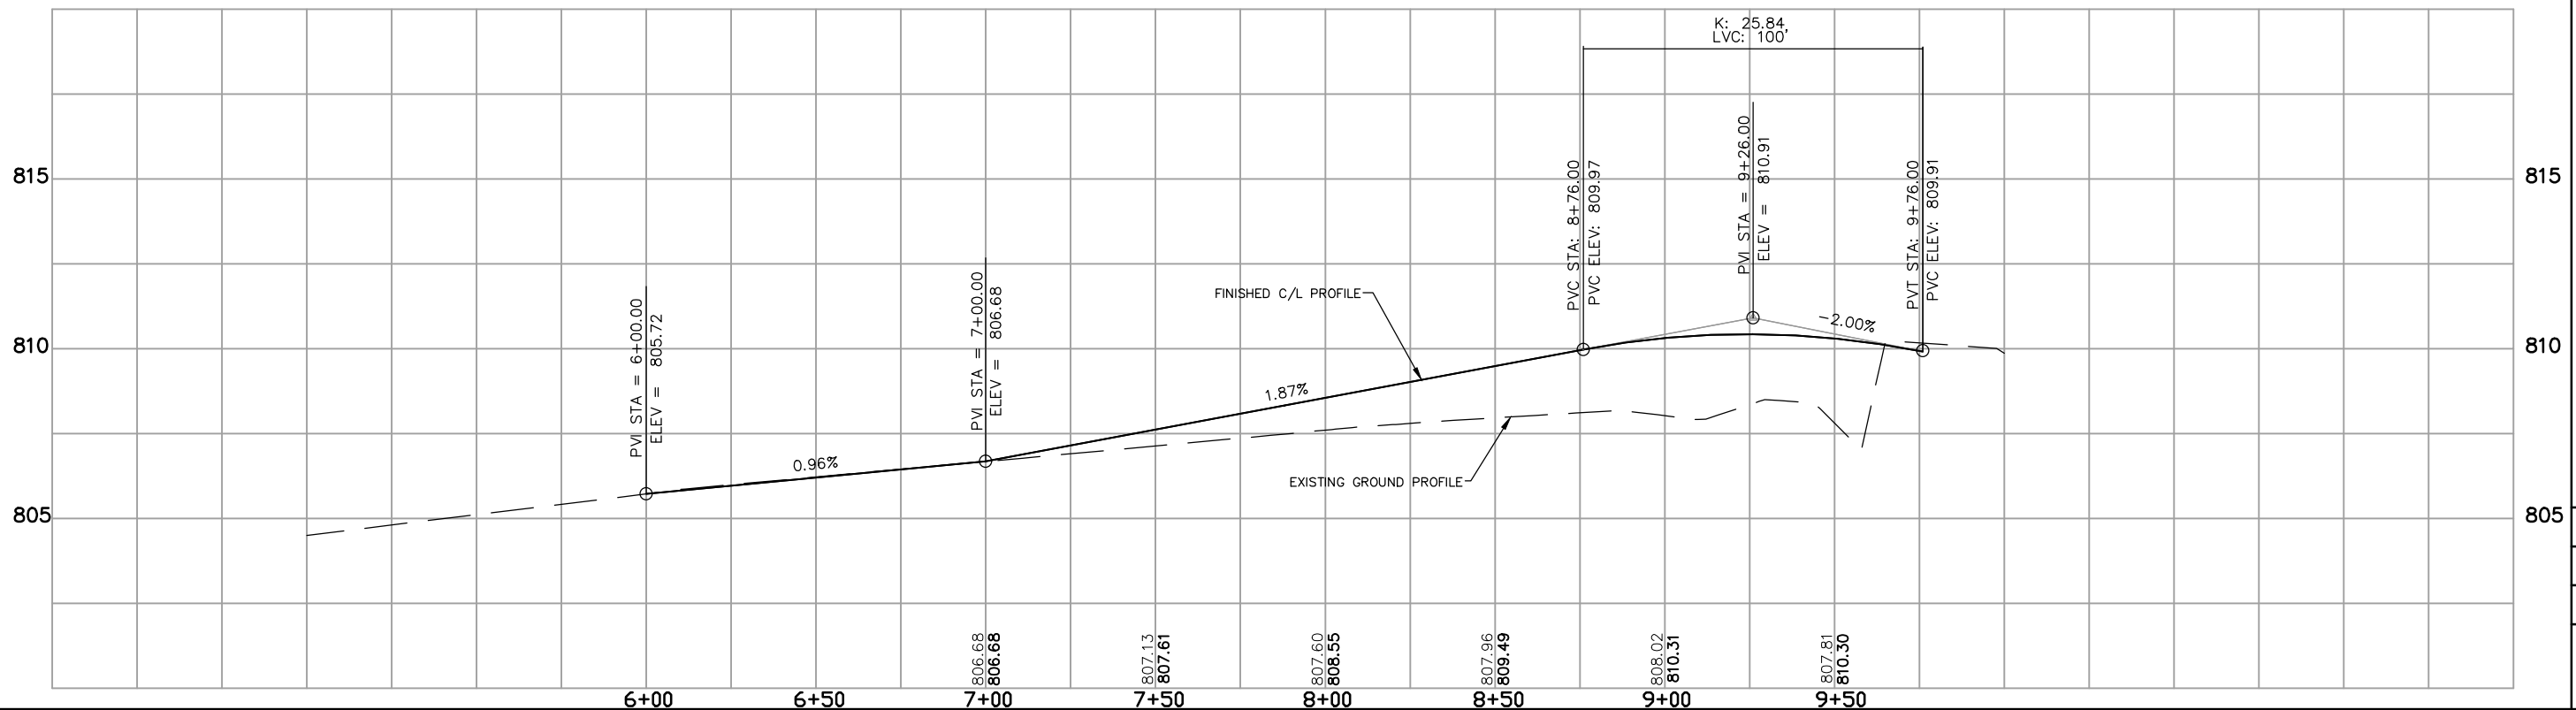[illegible]



McMahon provides this drawing and data, regardless of form, as instruments of service. All rights including copyrights are retained by McMahon. The client and/or recipient agrees to the fullest extent permitted by law to indemnify and hold McMahon harmless for any reuse of or changes made to the original drawing or data without prior written consent by McMahon.

[illegible]

STH 'S' (STH 76 - KELLY ROAD) OUTAGAMIE COUNTY, WISCONSIN PLAN & PROFILE

DESIGNED MPK	DRAWN MPK
PROJECT NO. 00006 910308	
DATE FEBRUARY, 2014	
SHEET NO. 41	

w:\projects\00006\910308\08-Design\Plan & Profile\42 PLAN & PROFILE.dwg, 42 plan & profile, Plot Date: 2/25/2014 3:41 PM, xrefs:none

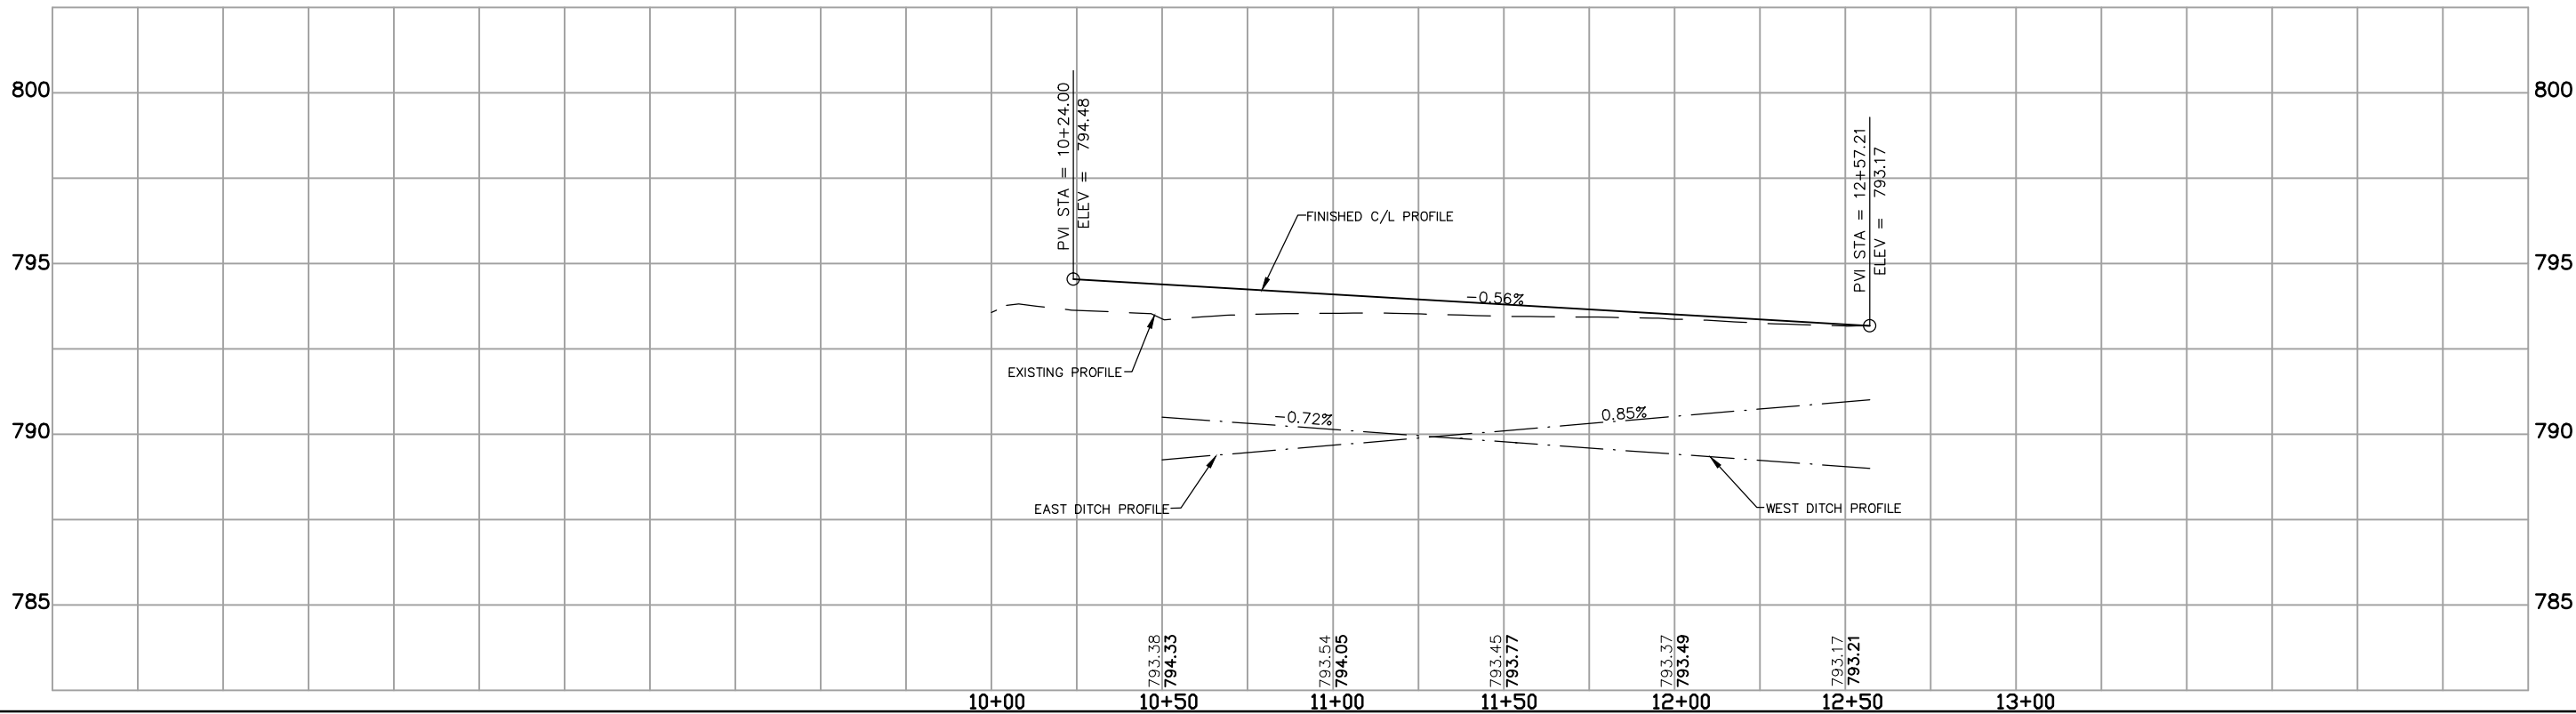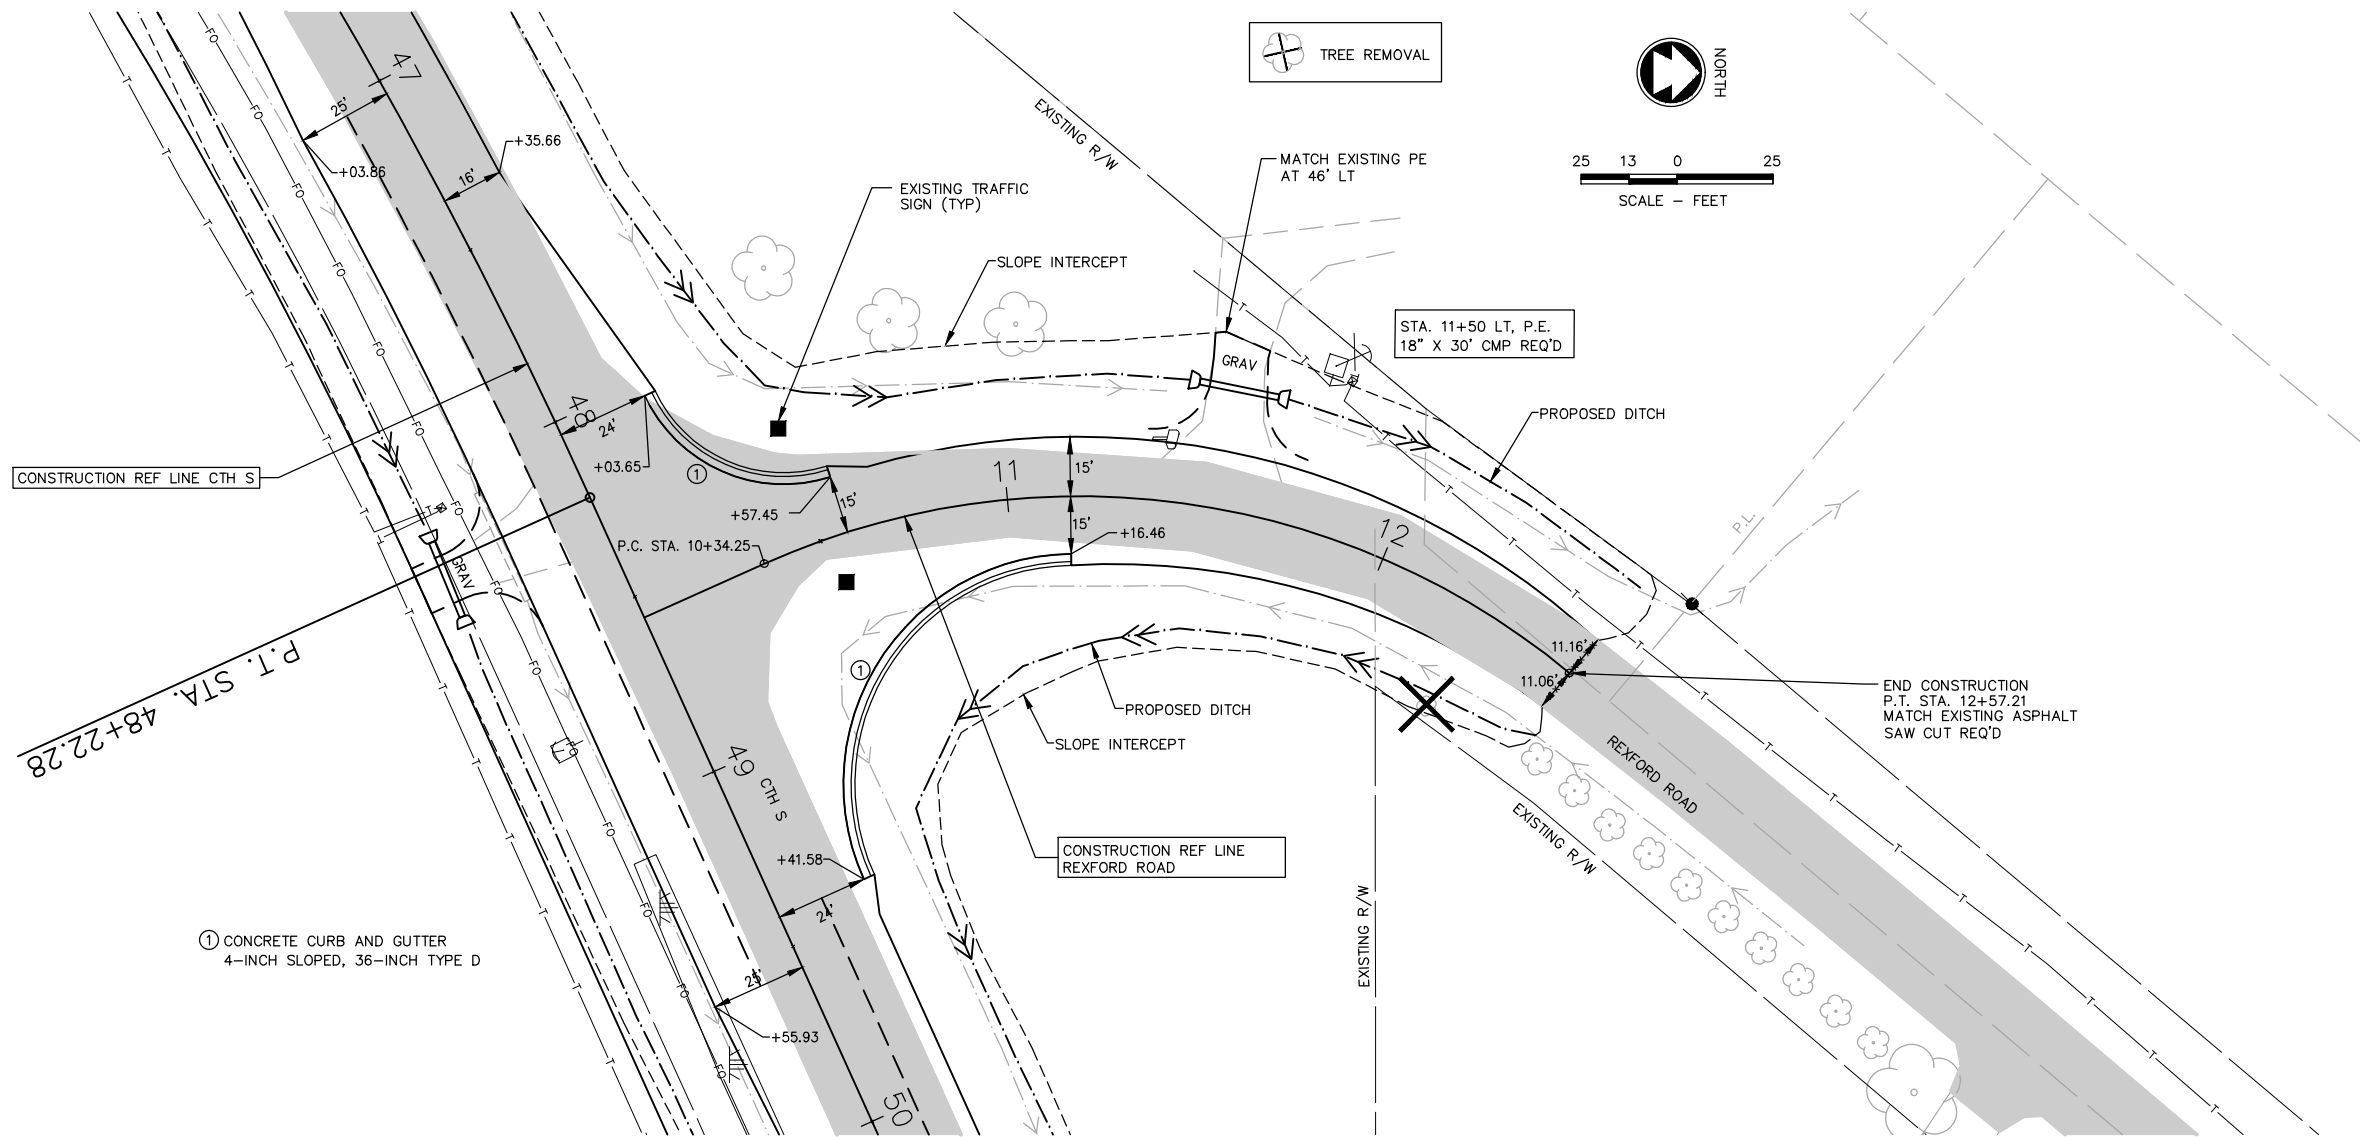

McMAHON

ENGINEERS ARCHITECTS

1445 McMAHON DRIVE NEENAH, WI 54956
Mailing: 1000 W. Wisconsin Ave., Neenah, WI 54956
Tel: (920) 751-1200 NEENAH, WI 54956
www.mcmahon.com

McMAHON ENGINEERS ARCHITECTS, INC.
The client and/or
recipient agrees to the fullest
extent possible to hold
McMAHON ENGINEERS ARCHITECTS, INC.
harmless from any reuse of or
drawing or data without prior
written consent by McMahon.

NO.	DATE	REVISION

CTH 'S' (STH 76 - KELLY ROAD)
OUTAGAMIE COUNTY, WISCONSIN
PLAN & PROFILE

DESIGNED MPK	DRAWN MPK
PROJECT NO. 00006 910308	
DATE FEBRUARY, 2014	
SHEET NO. 42	

CTH 'S' EARTHWORK DATA TABLES

Total Volume Table						
Station	Fill Area	Cut Area	Fill Volume	Cut Volume	Cumulative Fill Vol	Cumulative Cut Vol
0+50.00	0.00	0.00	0.00	0.00	0.00	0.00
1+00.00	0.17	116.76	0.18	107.49	0.18	107.49
1+50.00	0.00	154.53	0.18	246.77	0.36	354.25
2+00.00	16.73	86.64	18.75	220.28	19.11	574.53
2+50.00	5.06	90.86	26.23	164.35	45.34	738.89
3+00.00	0.86	99.89	7.12	176.61	52.46	915.50
3+50.00	0.20	111.67	1.27	195.89	53.73	1111.39
4+00.00	8.85	95.09	10.89	191.44	64.62	1302.83
4+30.00	6.12	116.14	10.81	117.35	75.43	1420.18
4+50.00	8.49	121.13	7.03	87.88	82.46	1508.06
5+00.00	18.53	124.84	32.55	229.13	115.01	1737.19
5+50.00	15.30	127.03	40.39	235.79	155.40	1972.98
6+00.00	16.80	120.18	38.14	231.79	193.54	2204.77
6+20.00	0.84	157.74	8.49	102.93	202.03	2307.70
6+50.00	20.73	170.14	15.58	182.16	217.61	2489.86
7+00.00	20.18	216.21	49.24	357.74	266.85	2847.60
7+50.00	35.63	182.31	67.17	369.01	334.02	3216.61
8+00.00	29.36	171.15	78.23	327.29	412.25	3543.89
8+50.00	45.04	132.72	89.56	281.37	501.81	3825.26
9+00.00	61.62	112.52	128.39	227.08	630.20	4052.34

Total Volume Table						
Station	Fill Area	Cut Area	Fill Volume	Cut Volume	Cumulative Fill Vol	Cumulative Cut Vol
18+50.00	20.23	101.08	125.90	194.89	7166.29	7474.14
18+80.00	8.49	167.08	21.02	150.79	7187.31	7624.92
19+00.00	11.85	221.20	9.52	146.96	7196.84	7771.89
19+32.00	0.00	282.98	8.87	305.84	7205.70	8077.72
19+50.00	8.32	278.45	3.60	187.14	7209.30	8264.87
19+69.69	10.48	219.55	8.62	186.64	7217.92	8451.51
20+00.00	7.44	131.51	12.65	200.45	7230.57	8651.95
20+50.00	3.18	145.56	12.38	256.64	7242.95	8908.59
20+90.21	0.87	152.59	3.80	221.77	7246.75	9130.37
21+00.00	4.51	212.89	1.27	66.26	7248.02	9196.63
21+50.00	5.70	200.79	12.10	386.41	7260.12	9583.04
22+00.00	17.48	227.45	26.96	399.25	7287.08	9982.29
22+50.00	43.53	304.81	70.60	499.11	7357.68	10481.39
23+00.00	43.31	309.66	100.24	579.39	7457.92	11060.79
23+50.00	51.86	310.25	109.62	585.51	7567.54	11646.30
24+00.00	37.91	338.95	103.29	613.90	7670.83	12260.20
24+42.50	5.01	289.90	42.19	505.52	7713.02	12765.72
24+50.00	5.29	279.91	1.86	79.13	7714.88	12844.86
25+00.00	17.73	276.49	27.08	521.79	7741.95	13366.65
25+50.00	11.17	218.09	34.78	457.94	7776.73	13824.59

Total Volume Table						
Station	Fill Area	Cut Area	Fill Volume	Cut Volume	Cumulative Fill Vol	Cumulative Cut Vol
35+50.00	38.11	76.42	88.78	144.45	9056.42	17780.14
35+86.00	11.95	94.62	43.38	114.03	9099.80	17894.17
36+00.00	34.89	78.66	15.79	44.93	9115.59	17939.09
36+50.00	43.13	77.19	93.92	144.30	9209.51	18083.40
37+00.00	47.06	75.13	108.56	141.04	9318.07	18224.43
37+50.00	44.57	78.88	110.30	142.60	9428.37	18367.04
38+00.00	39.09	84.54	100.70	151.31	9529.07	18518.35
38+50.00	41.59	85.33	97.11	157.29	9626.18	18675.64
39+00.00	43.36	97.73	102.25	169.50	9728.43	18845.14
39+50.00	46.65	119.14	108.35	200.81	9836.79	19045.95
39+57.00	46.59	123.18	15.71	31.41	9852.50	19077.36
40+00.00	33.22	92.51	82.62	171.76	9935.12	19249.12
40+50.00	38.40	76.81	86.20	156.78	10021.32	19405.90
41+00.00	50.30	61.79	106.76	128.33	10128.08	19534.23
41+50.00	52.67	62.65	123.95	115.22	10252.03	19649.45
42+00.00	63.54	74.56	141.69	126.49	10393.72	19775.95
42+50.00	39.89	71.87	126.35	135.00	10520.07	19910.95
43+00.00	37.42	61.52	94.22	123.64	10614.29	20034.59
43+50.00	20.84	69.87	70.64	122.31	10684.94	20156.90
44+00.00	13.59	76.99	41.84	136.71	10726.78	20293.61

Total Volume Table						
Station	Fill Area	Cut Area	Fill Volume	Cut Volume	Cumulative Fill Vol	Cumulative Cut Vol
9+50.00	77.62	103.53	167.60	200.05	797.80	4252.39
10+00.00	86.56	92.69	197.62	181.69	995.42	4434.07
10+50.00	103.34	97.01	228.59	175.64	1224.01	4609.72
10+93.00	111.58	129.46	222.49	180.34	1446.49	4790.05
11+00.00	113.08	133.85	37.86	34.13	1484.35	4824.19
11+50.00	146.72	83.10	312.72	200.88	1797.07	5025.07
12+00.00	128.87	82.06	331.73	152.93	2128.80	5177.99
12+50.00	134.63	80.99	317.18	150.97	2445.98	5328.97
13+00.00	140.04	75.99	330.62	145.35	2776.60	5474.32
13+50.00	143.67	80.07	341.49	144.51	3118.09	5618.83
14+00.00	173.37	80.73	381.62	148.90	3499.71	5767.72
14+25.00	196.81	120.78	222.79	93.29	3722.50	5861.01
14+50.00	221.13	82.54	251.54	94.13	3974.04	5955.14
15+00.00	242.03	98.08	557.51	167.24	4531.55	6122.38
15+50.00	265.20	115.26	626.49	193.74	5158.05	6316.12
16+00.00	221.79	103.08	601.35	198.71	5759.40	6514.83
16+50.00	154.08	99.77	464.57	185.48	6223.97	6700.31
17+00.00	107.22	105.07	323.22	188.73	6547.19	6889.04
17+50.00	104.62	103.53	262.51	193.18	6809.69	7082.22
18+00.00	81.01	108.63	230.70	197.02	7040.39	7279.24

Total Volume Table						
Station	Fill Area	Cut Area	Fill Volume	Cut Volume	Cumulative Fill Vol	Cumulative Cut Vol
26+00.00	12.33	178.57	28.28	367.28	7805.02	14191.87
26+50.00	15.09	153.98	33.00	307.92	7838.02	14499.79
27+00.00	15.09	143.60	36.32	275.54	7874.34	14775.32
27+50.00	15.25	128.98	36.52	252.39	7910.86	15027.71
28+00.00	12.27	131.98	33.13	241.63	7943.99	15269.34
28+20.00	0.00	162.67	5.91	109.13	7949.89	15378.47
28+50.00	25.92	112.58	18.72	152.92	7968.62	15531.38
29+00.00	10.19	123.74	43.48	218.82	8012.09	15750.20
29+50.00	10.94	108.79	25.44	215.31	8037.54	15965.51
30+00.00	10.44	117.00	25.74	209.07	8063.27	16174.58
30+50.00	22.00	77.92	39.04	180.48	8102.32	16355.07
31+00.00	26.57	77.68	58.46	144.07	8160.78	16499.14
31+50.00	31.13	79.26	69.45	145.31	8230.23	16644.44
32+00.00	40.53	71.01	86.26	139.14	8316.49	16783.58
32+50.00	46.81	70.43	105.13	130.97	8421.62	16914.55
33+00.00	45.02	73.50	110.54	133.27	8532.16	17047.82
33+50.00	49.01	75.90	113.18	138.33	8645.34	17186.15
34+00.00	50.69	82.98	120.00	147.11	8765.34	17333.25
34+50.00	40.86	82.03	110.20	152.78	8875.54	17486.04
35+00.00	35.65	79.59	92.10	149.65	8967.64	17635.69

Total Volume Table						
Station	Fill Area	Cut Area	Fill Volume	Cut Volume	Cumulative Fill Vol	Cumulative Cut Vol
44+50.00	29.71	85.20	51.94	150.29	10778.72	20443.90
45+00.00	10.10	74.48	47.46	147.39	10826.18	20591.29
45+50.00	11.70	62.71	26.04	126.58	10852.22	20717.87
46+00.00	12.53	66.82	29.04	119.41	10881.26	20837.27
46+32.00	8.49	87.32	16.03	91.26	10897.29	20928.53
46+50.00	11.31	68.97	8.58	52.09	10905.87	20980.62
47+00.00	12.73	69.86	28.54	128.43	10934.41	21109.05
47+50.00	15.15	75.81	33.45	134.34	10967.86	21243.39
48+00.00	30.67	84.26	55.68	147.53	11023.54	21390.92
48+25.00	0.00	93.02	18.46	82.07	11042.00	21472.99
48+50.00	14.17	70.53	8.53	75.72	11050.53	21548.71
49+00.00	25.99	53.04	48.34	114.42	11098.87	21663.13
49+50.00	38.92	69.70	78.13	113.65	11177.00	21776.78
50+00.00	40.85	80.22	96.02	138.82	11273.02	21915.60
50+50.00	39.34	84.64	96.52	152.65	11369.54	22068.25
51+00.00	39.74	86.19	95.18	158.17	11464.72	22226.42
51+50.00	42.95	84.25	99.54	157.81	11564.26	22384.23
52+00.00	42.90	100.90	103.34	171.44	11667.60	22555.67
52+50.00	42.44	142.69	102.72	225.55	11770.32	22781.22
53+00.00	50.40	85.62	111.75	211.40	11882.07	22992.62

CTH 'S' EARTHWORK DATA TABLES CONTINUED

Total Volume Table						
Station	Fill Area	Cut Area	Fill Volume	Cut Volume	Cumulative Fill Vol	Cumulative Cut Vol
53+50.00	62.22	80.05	135.56	153.40	12017.63	23146.02
54+00.00	91.34	85.36	184.84	153.16	12202.46	23299.18
54+50.00	110.21	75.24	242.60	148.70	12445.06	23447.88
55+00.00	55.11	81.53	198.99	145.15	12644.06	23593.03
55+50.00	43.07	90.22	118.18	159.03	12762.24	23752.06
56+00.00	25.82	98.47	82.92	174.72	12845.16	23926.78
56+50.00	25.36	108.04	61.60	191.21	12906.77	24117.99
57+00.00	26.66	99.13	62.62	191.82	12969.39	24309.82
57+50.00	18.09	150.55	53.87	231.19	13023.25	24541.01
58+00.00	18.52	183.43	44.46	306.73	13067.72	24847.74
58+50.00	0.57	192.98	23.41	343.42	13091.13	25191.15
59+00.00	0.75	242.74	1.56	399.02	13092.68	25590.17
59+50.00	3.77	166.42	5.50	373.98	13098.18	25964.15
60+00.00	3.00	157.89	8.29	295.26	13106.47	26259.41
60+50.00	3.55	118.58	7.98	252.68	13114.46	26512.10
61+00.00	3.33	152.90	8.38	248.83	13122.84	26760.93
61+50.00	4.76	84.54	9.93	218.08	13132.77	26979.01
62+00.00	4.66	99.23	11.56	169.50	13144.33	27148.51
62+50.00	27.03	114.46	39.22	196.66	13183.55	27345.17
63+00.00	11.52	112.39	47.81	208.65	13231.36	27553.82



Total Volume Table						
Station	Fill Area	Cut Area	Fill Volume	Cut Volume	Cumulative Fill Vol	Cumulative Cut Vol
63+50.00	5.54	113.94	21.12	208.20	13252.47	27762.02
64+00.00	12.69	113.69	22.57	209.72	13275.05	27971.74
64+50.00	31.31	107.59	52.96	204.89	13328.01	28176.63
65+00.00	0.00	0.00	37.68	99.62	13365.69	28276.26




ROCK ROAD EARTHWORK DATA TABLES




Total Volume Table						
Station	Fill Area	Cut Area	Fill Volume	Cut Volume	Cumulative Fill Vol	Cumulative Cut Vol
6+00.34	0.00	11.17	0.00	0.00	0.00	0.00
6+50.00	0.01	58.15	0.01	63.75	0.01	63.75
7+00.00	0.00	168.96	0.01	210.29	0.02	274.04
7+50.00	9.21	140.19	11.09	286.25	11.10	560.29
8+00.00	21.84	90.72	38.04	209.50	49.15	769.79
8+50.00	15.54	51.95	46.69	123.98	95.84	893.77
9+00.00	21.39	91.98	45.18	131.67	141.02	1025.44
9+26.22	19.59	140.22	26.30	115.63	167.32	1141.07
9+50.00	24.28	274.36	25.17	186.20	192.49	1327.27



REXFORD ROAD EARTHWORK DATA TABLES


Total Volume Table						
Station	Fill Area	Cut Area	Fill Volume	Cut Volume	Cumulative Fill Vol	Cumulative Cut Vol
10+24.00	0.00	0.00	0.00	0.00	0.00	0.00
10+50.00	141.32	25.30	78.26	12.74	78.26	12.74
10+57.45	123.46	24.73	38.88	7.33	117.14	20.07
10+75.00	60.78	35.96	65.08	20.15	182.22	40.22
11+00.00	41.66	39.72	53.31	34.55	235.53	74.77
11+16.46	37.30	41.40	28.09	24.20	263.62	98.98
11+25.00	22.21	42.83	11.37	13.19	274.99	112.17
11+50.00	12.20	87.89	19.34	63.95	294.33	176.12
11+75.00	12.26	43.15	13.78	64.36	308.11	240.48
12+00.00	11.23	44.63	14.12	41.11	322.24	281.59
12+25.00	10.80	42.76	13.95	40.60	336.19	322.19
12+50.00	6.24	41.81	11.24	38.86	347.43	361.05
12+57.21	2.52	44.08	1.69	11.44	349.12	372.49


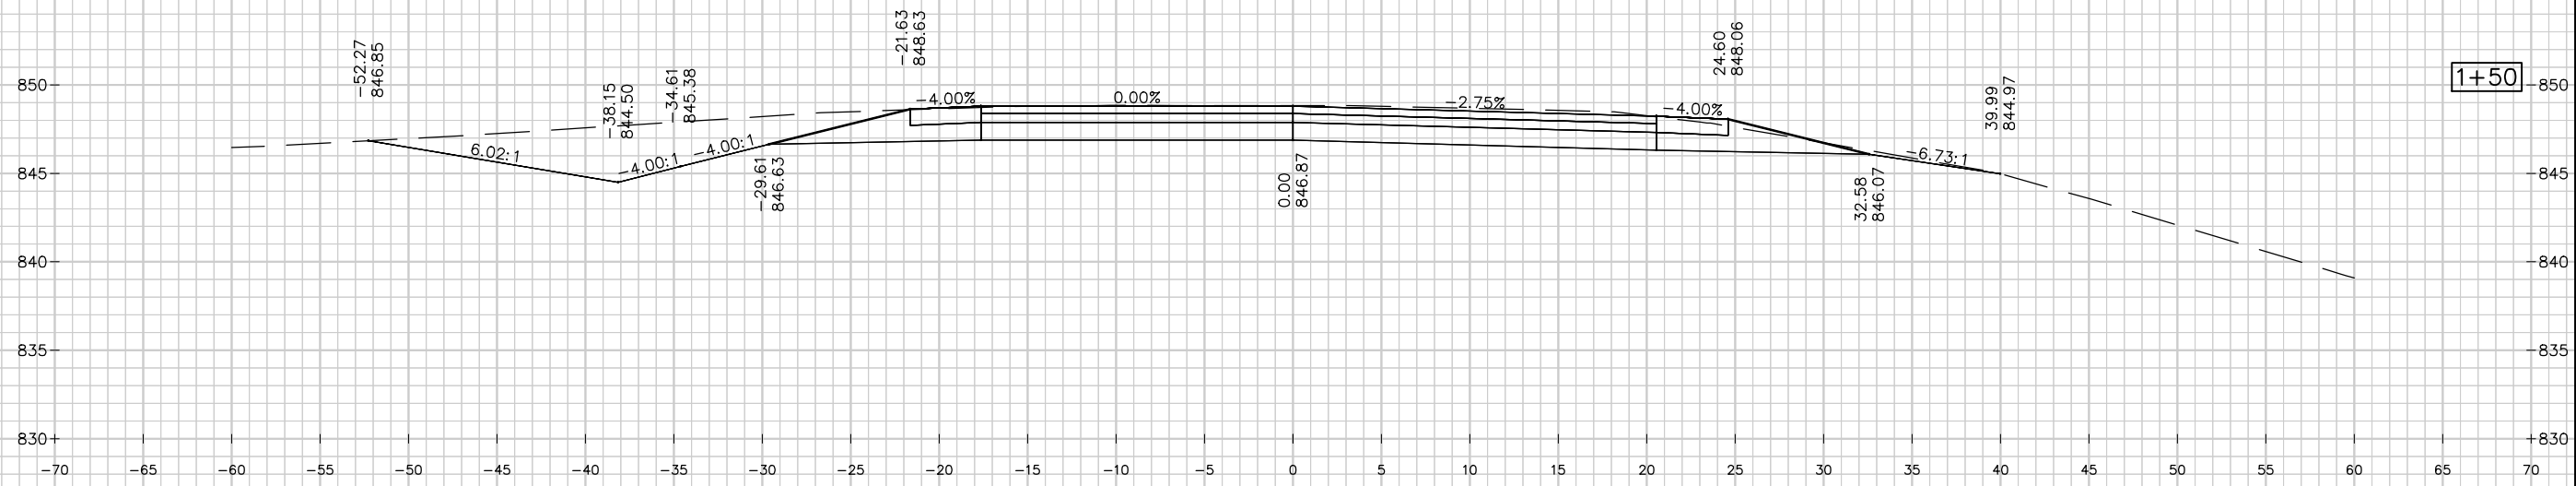
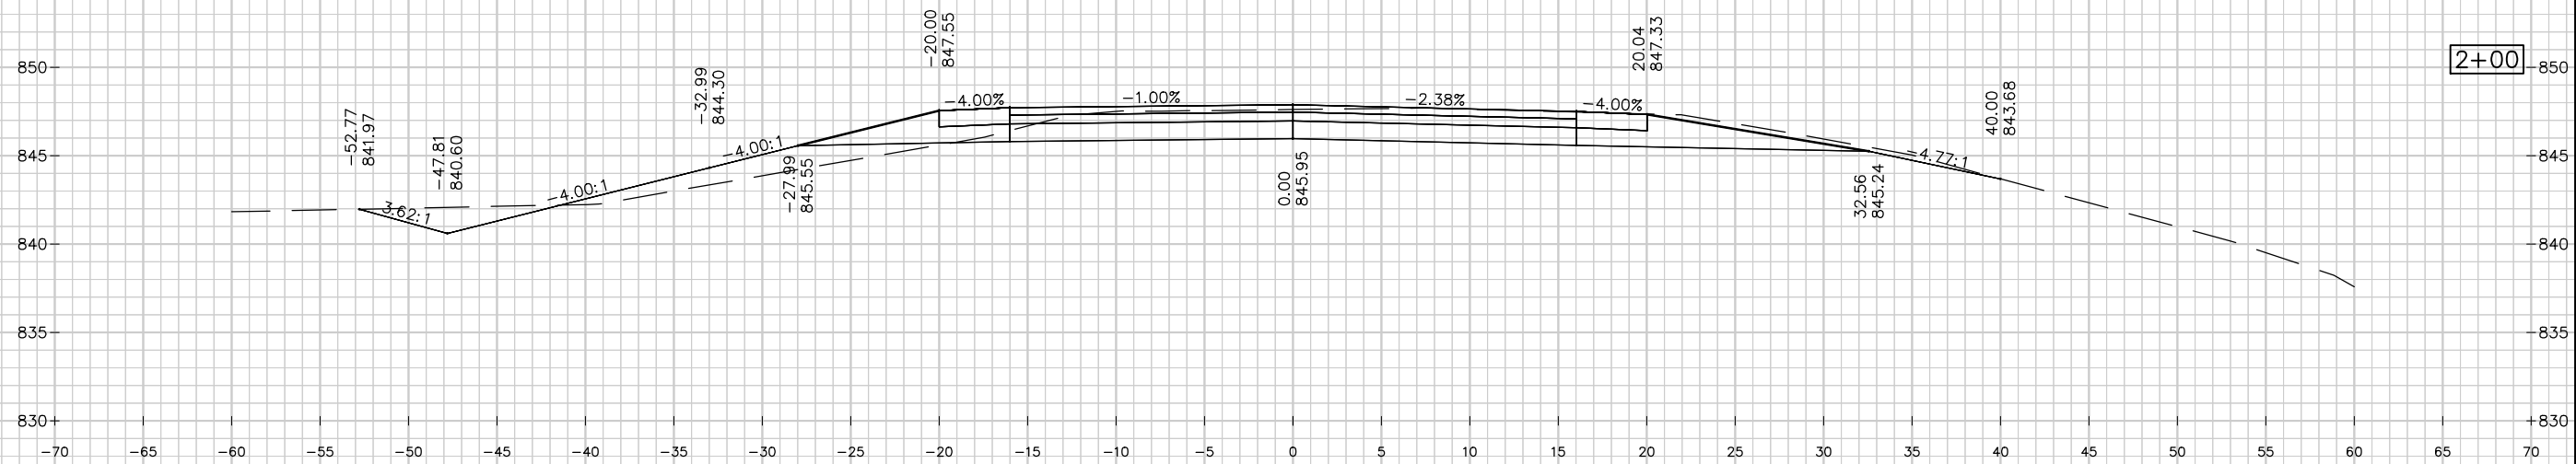


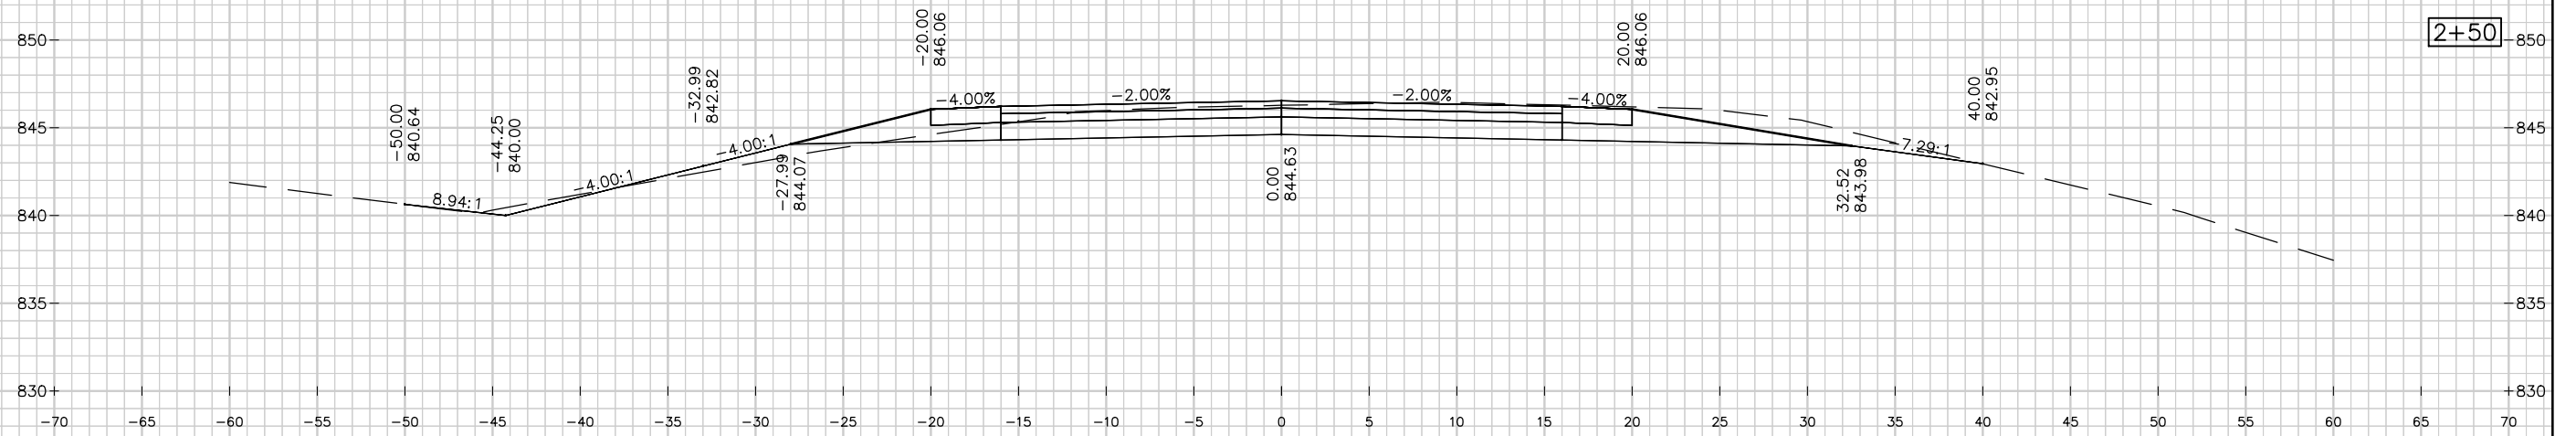
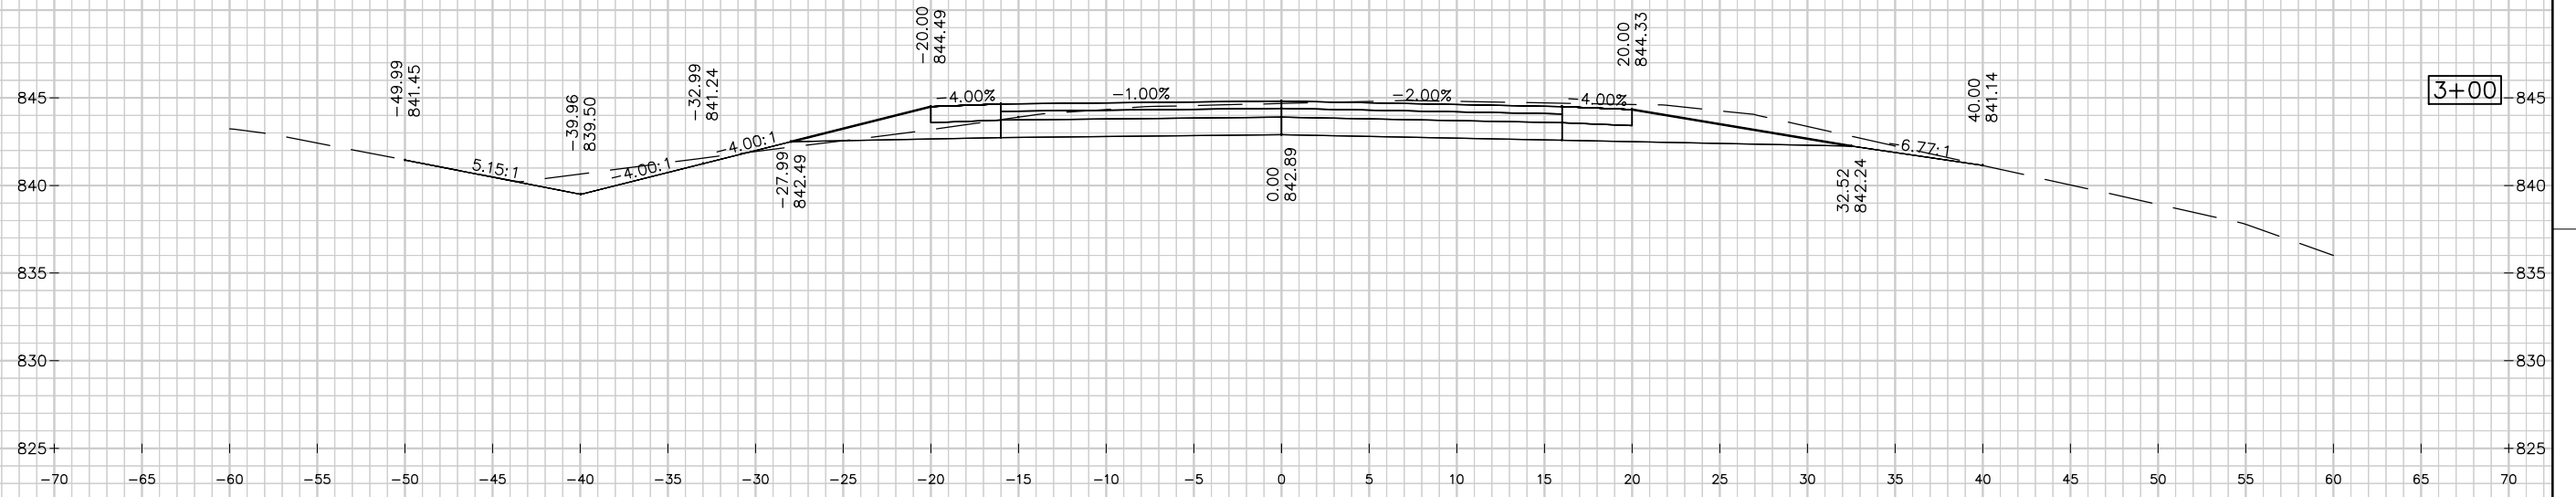
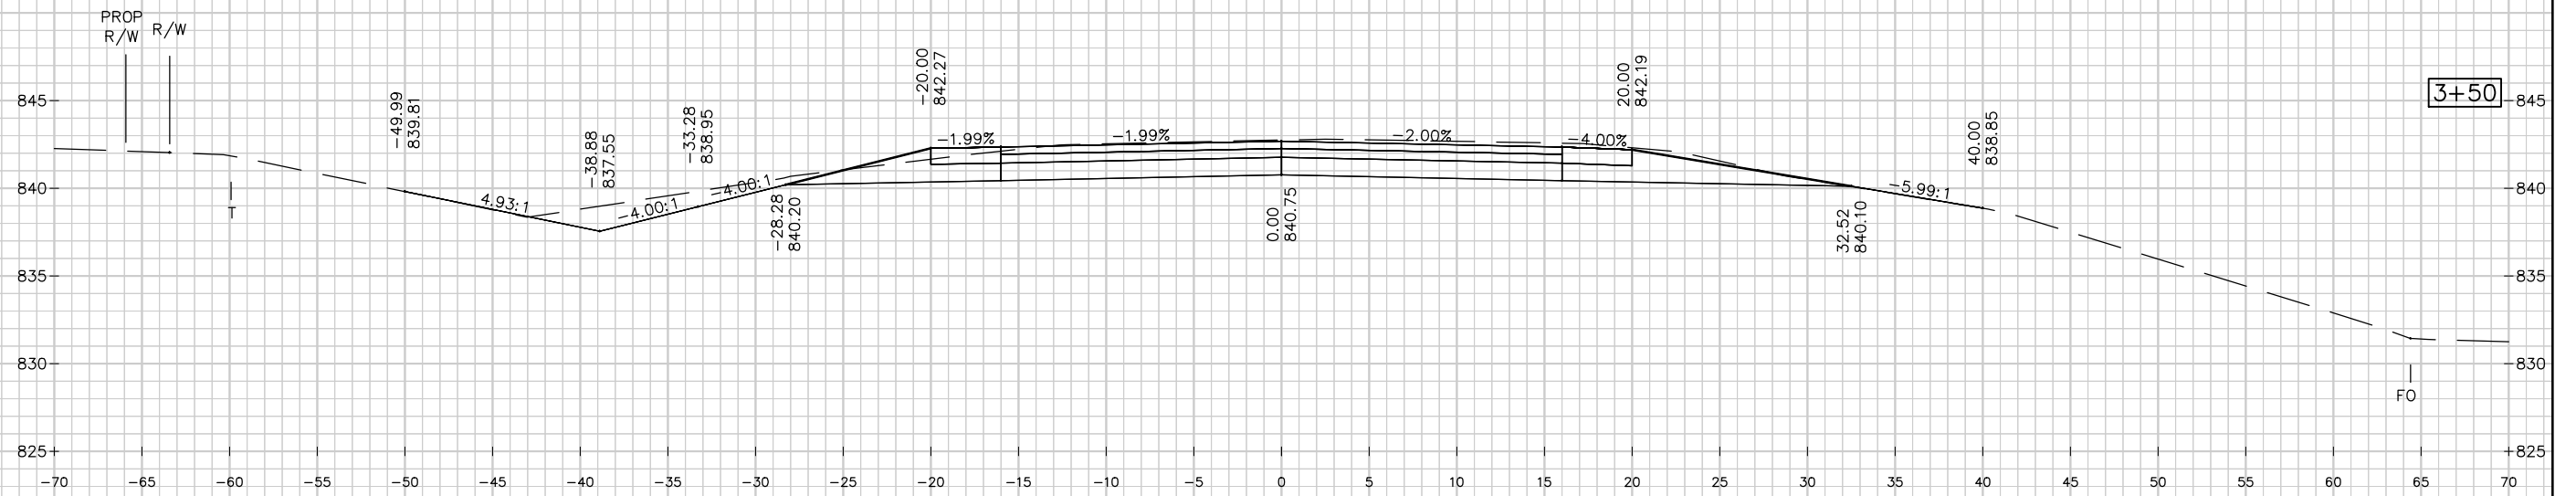


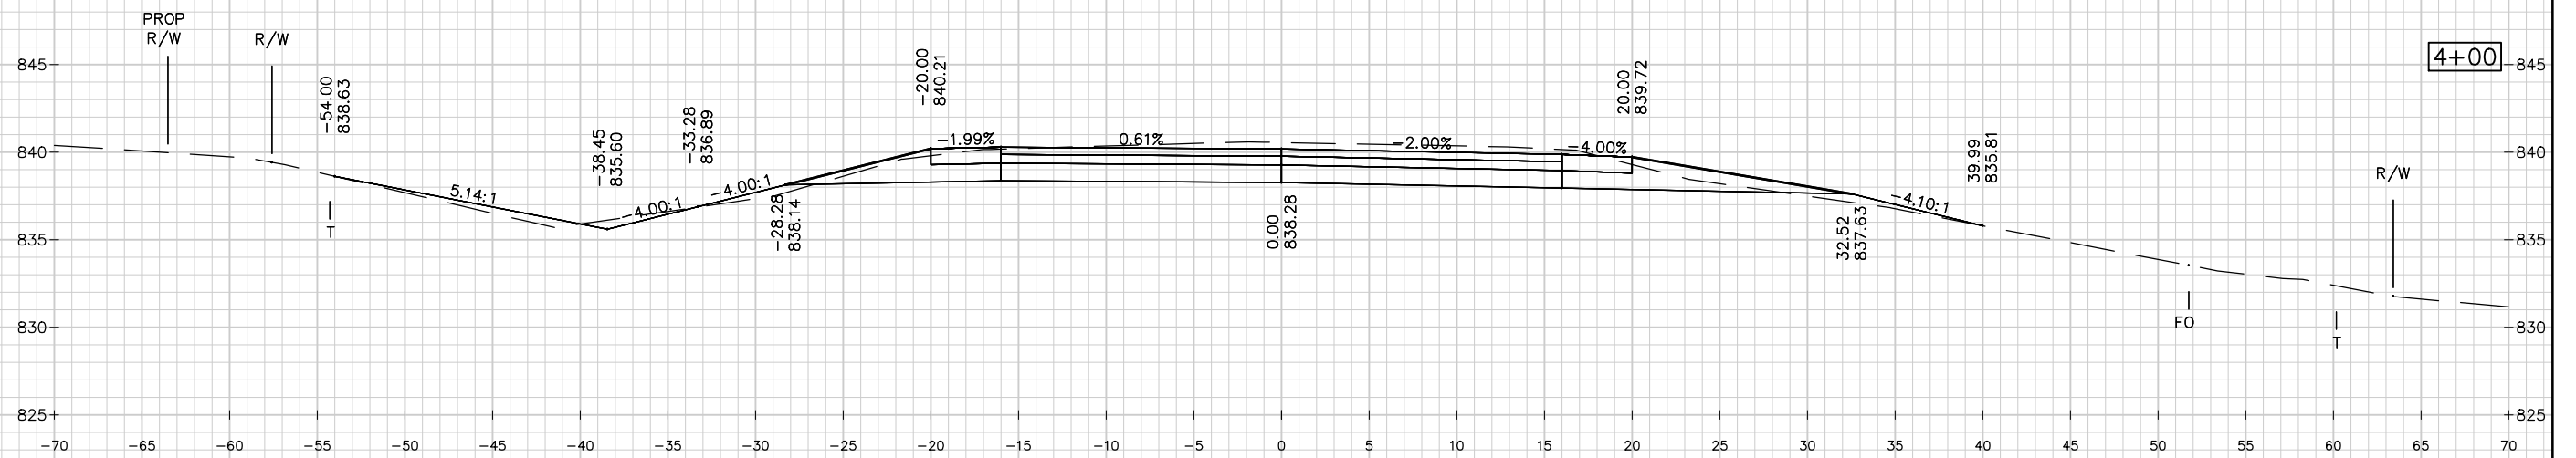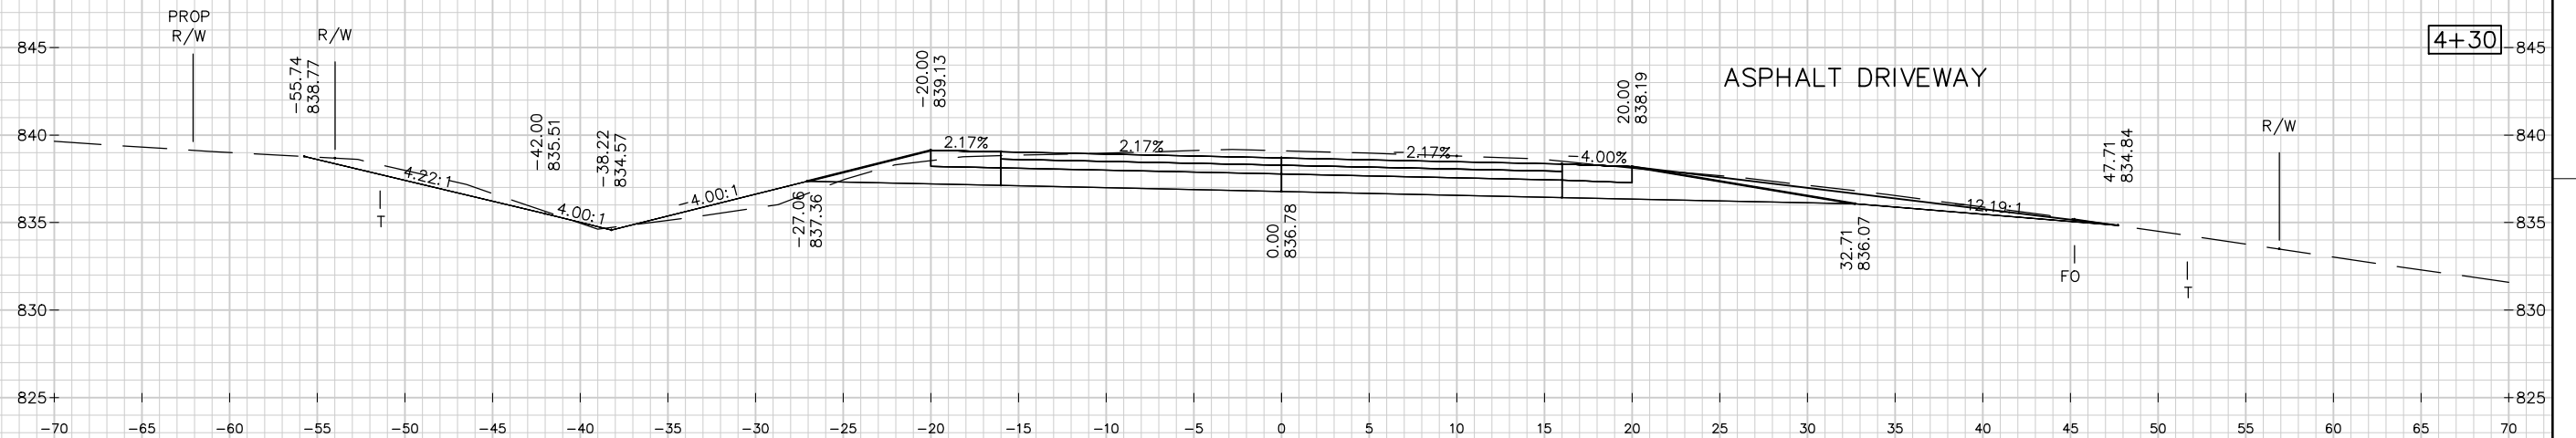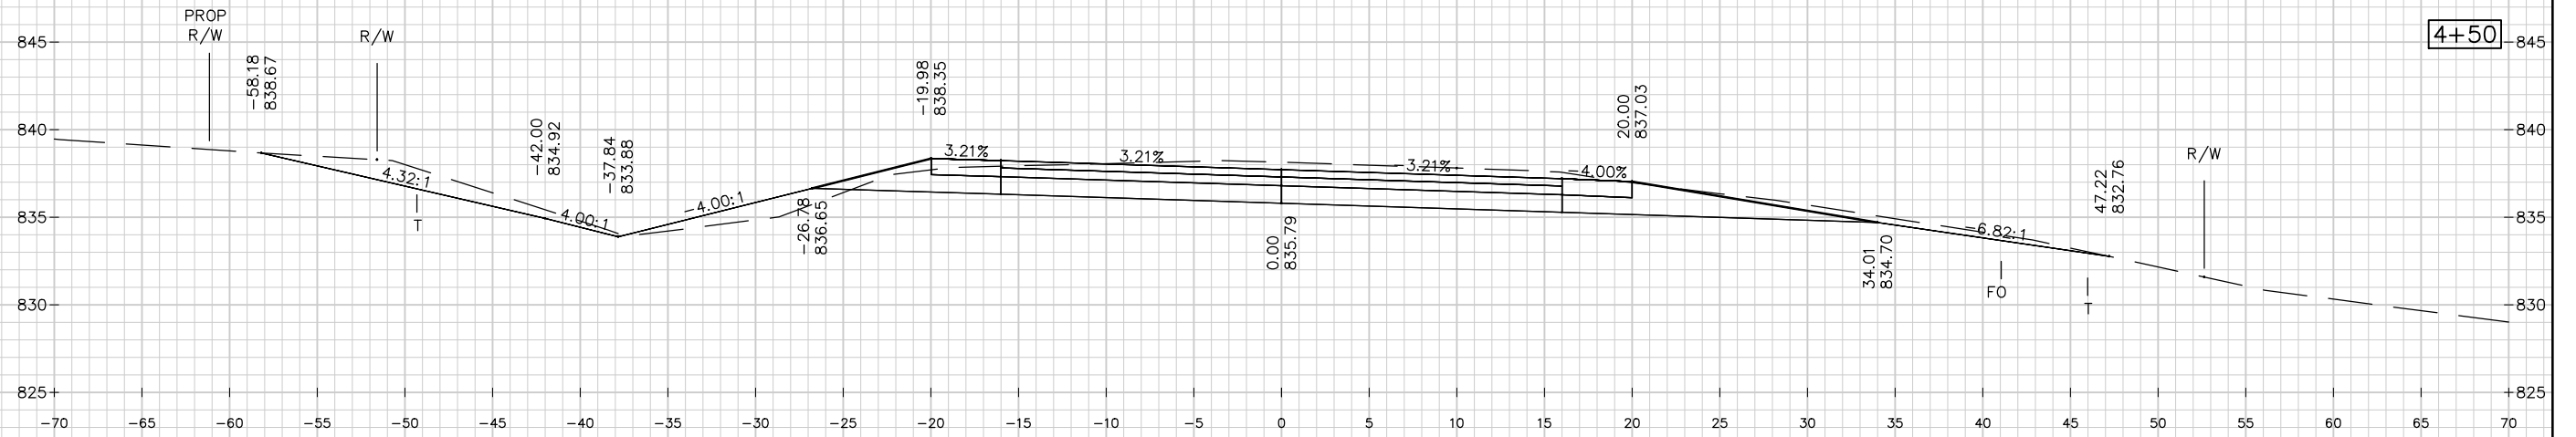


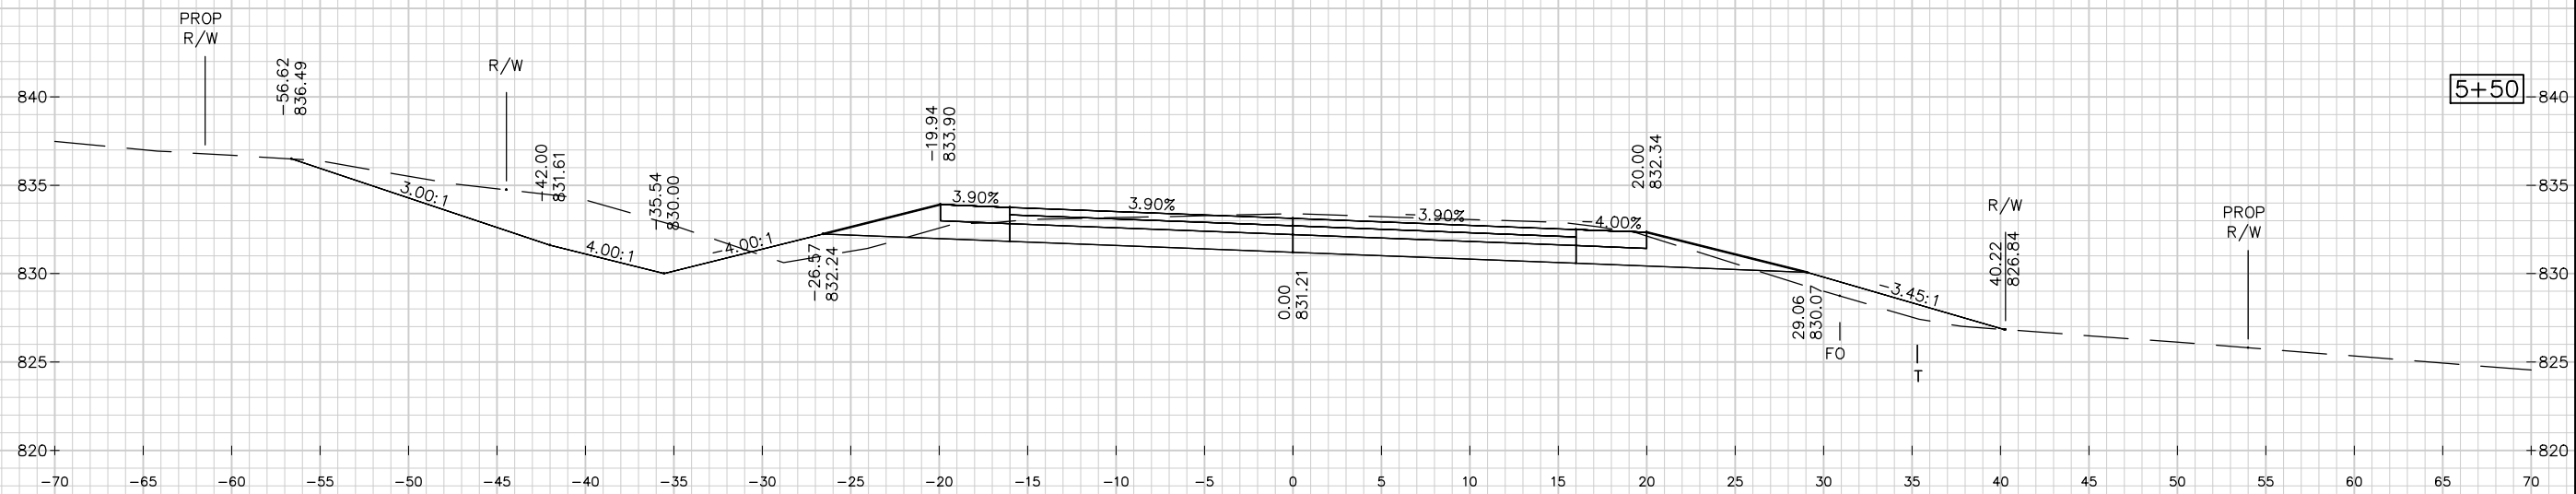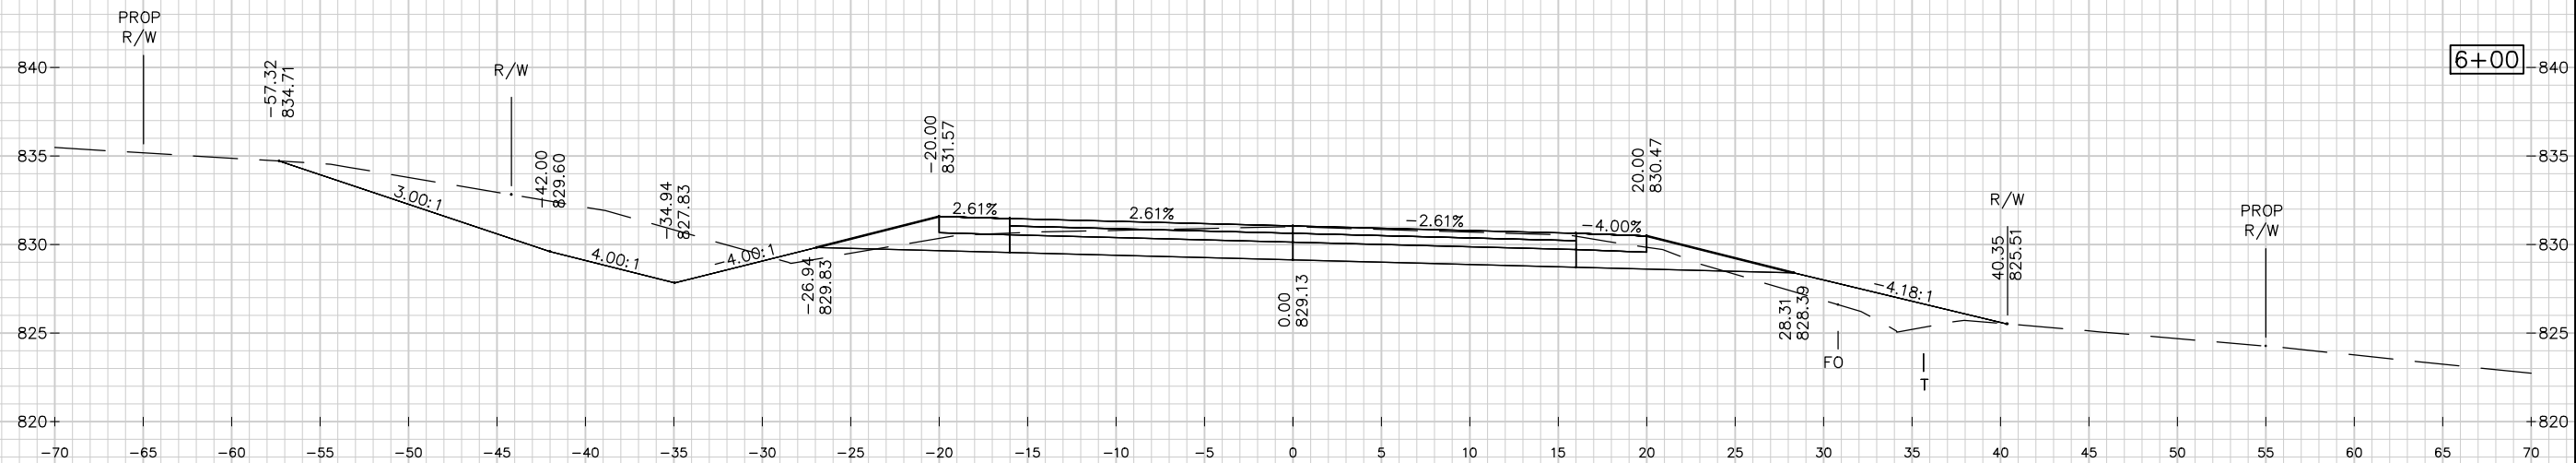



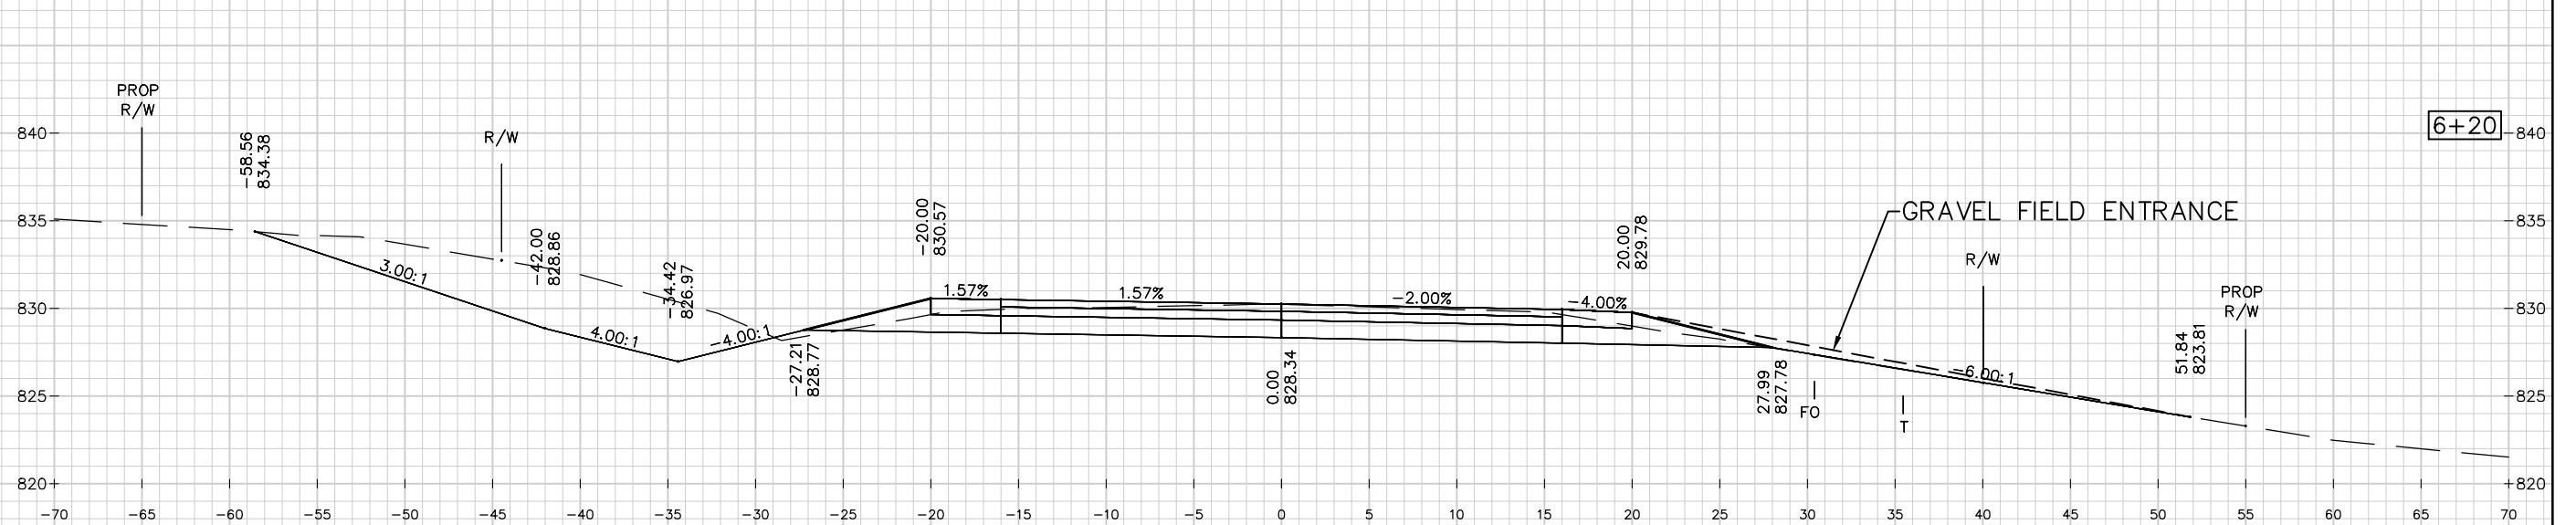


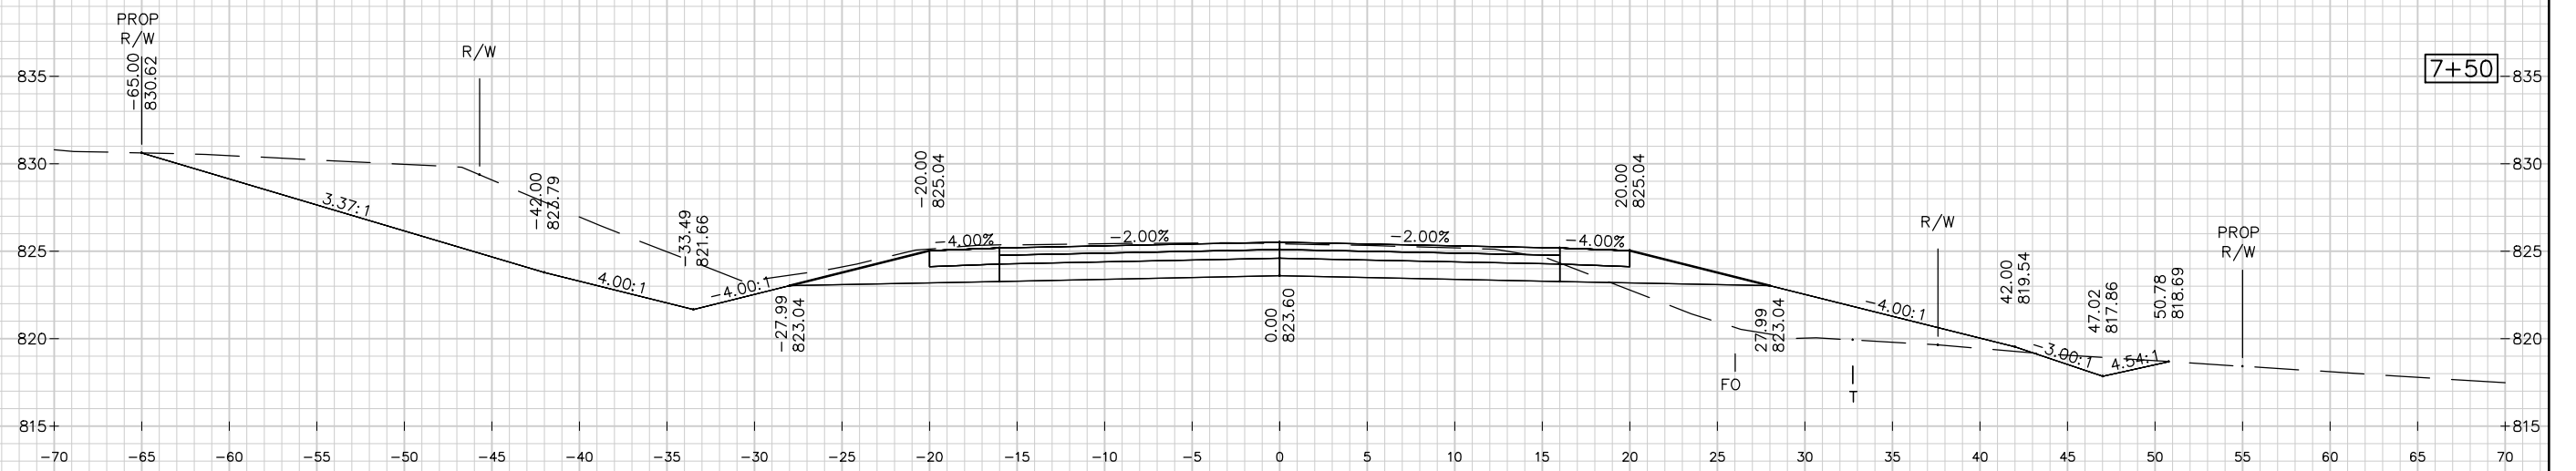
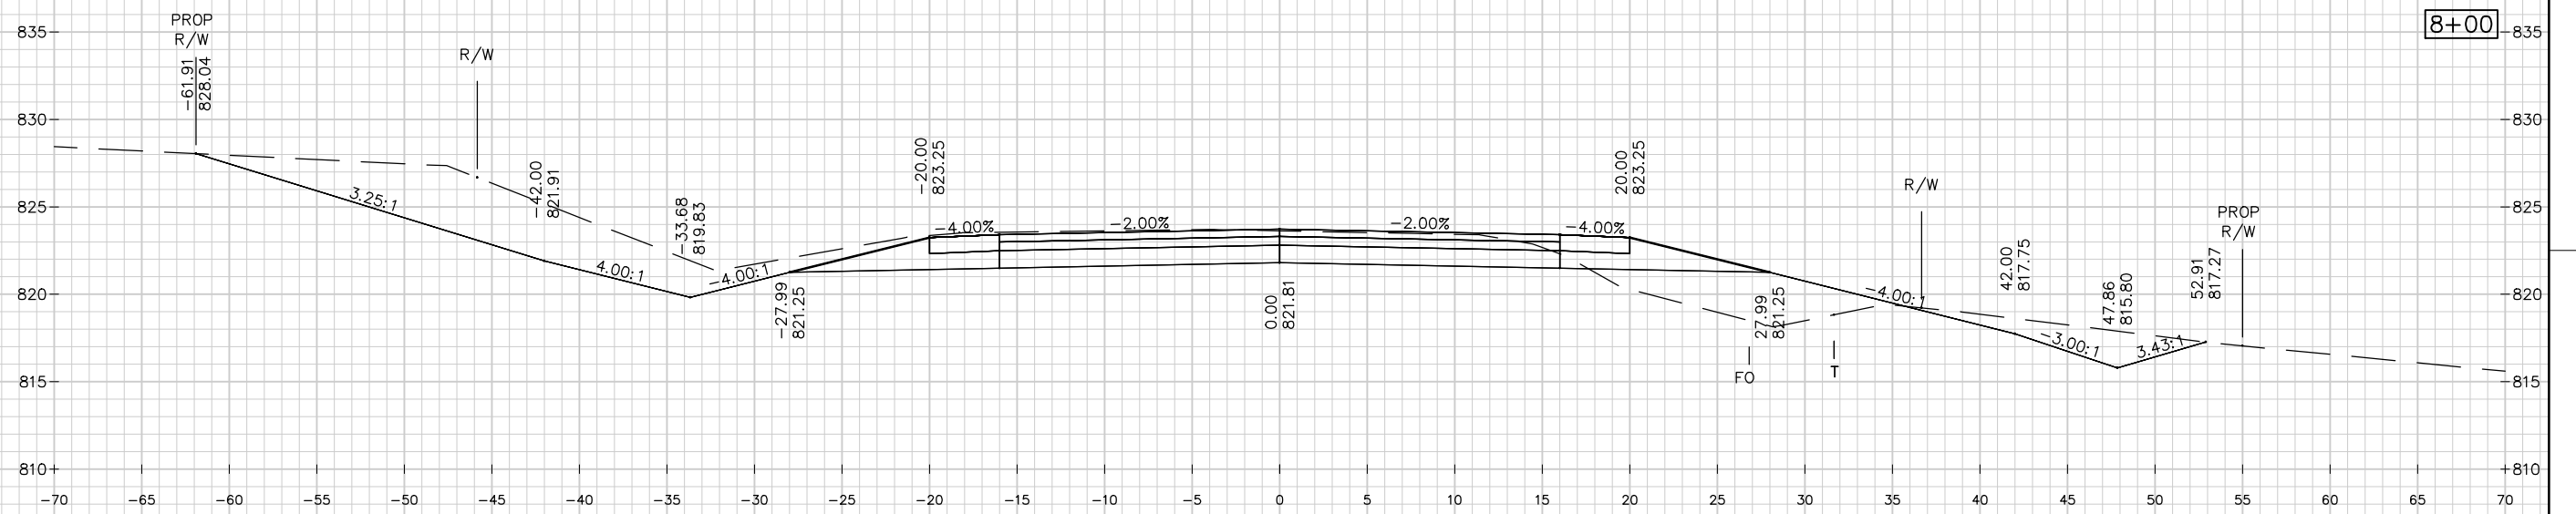
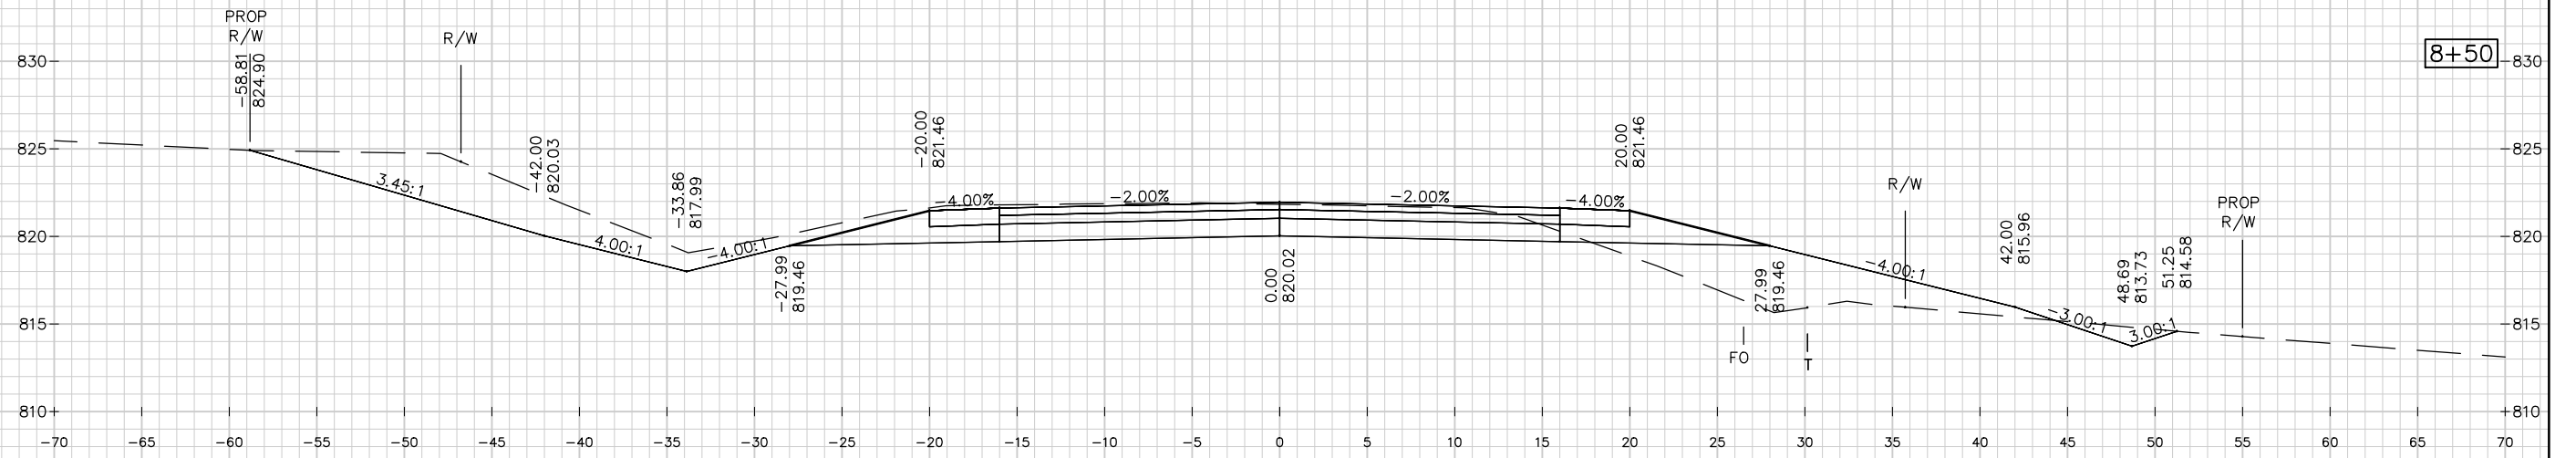


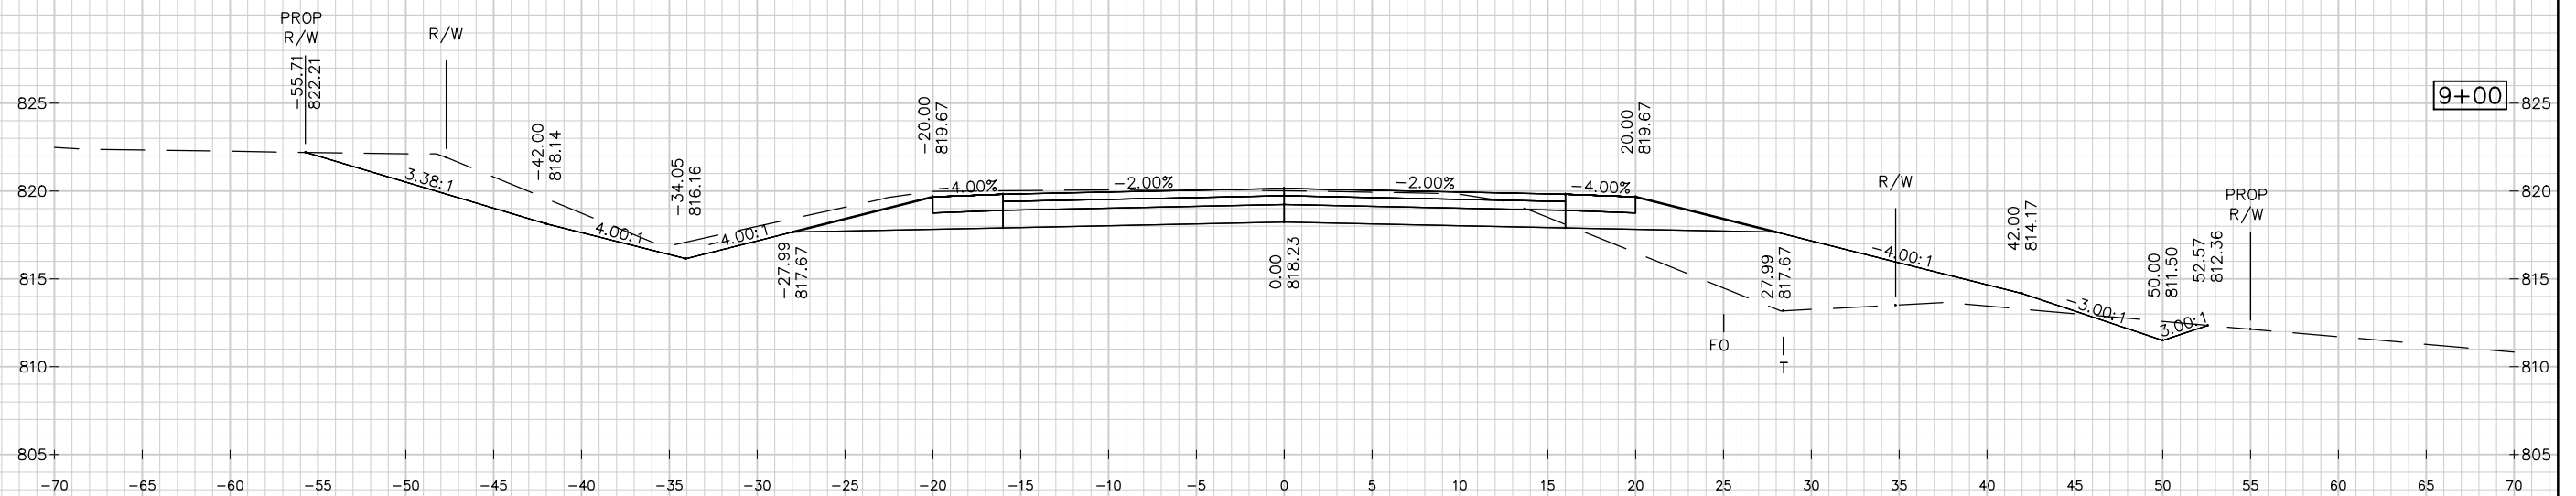
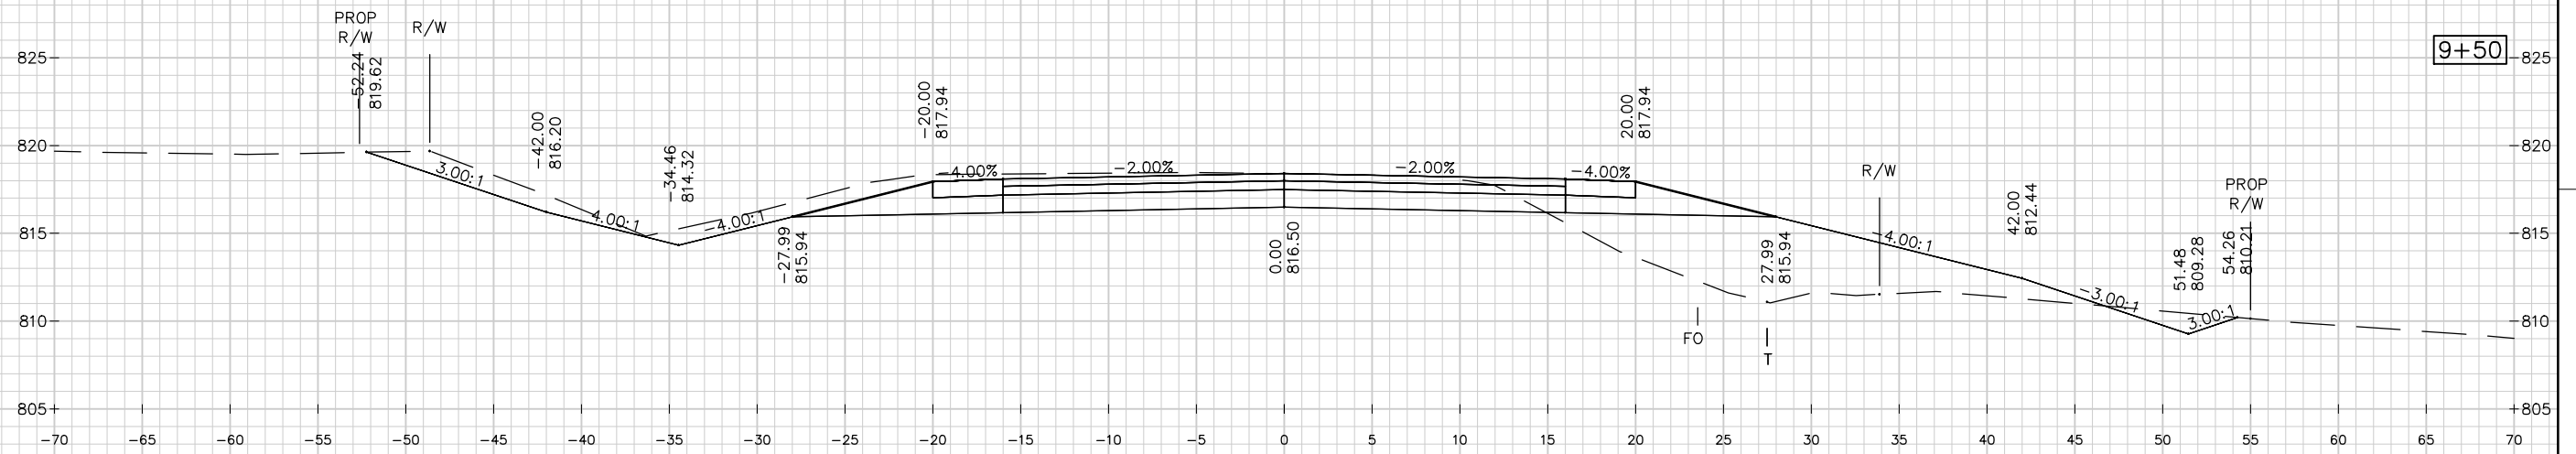
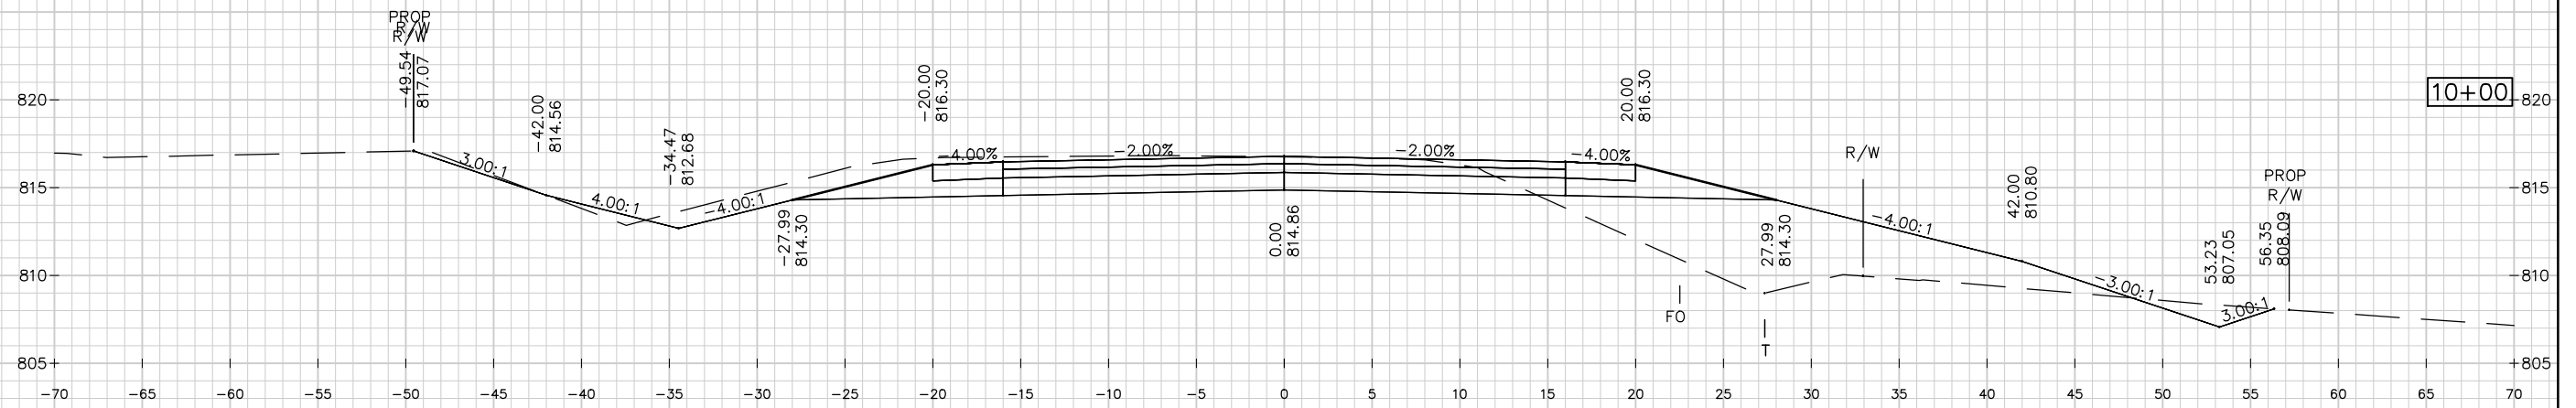


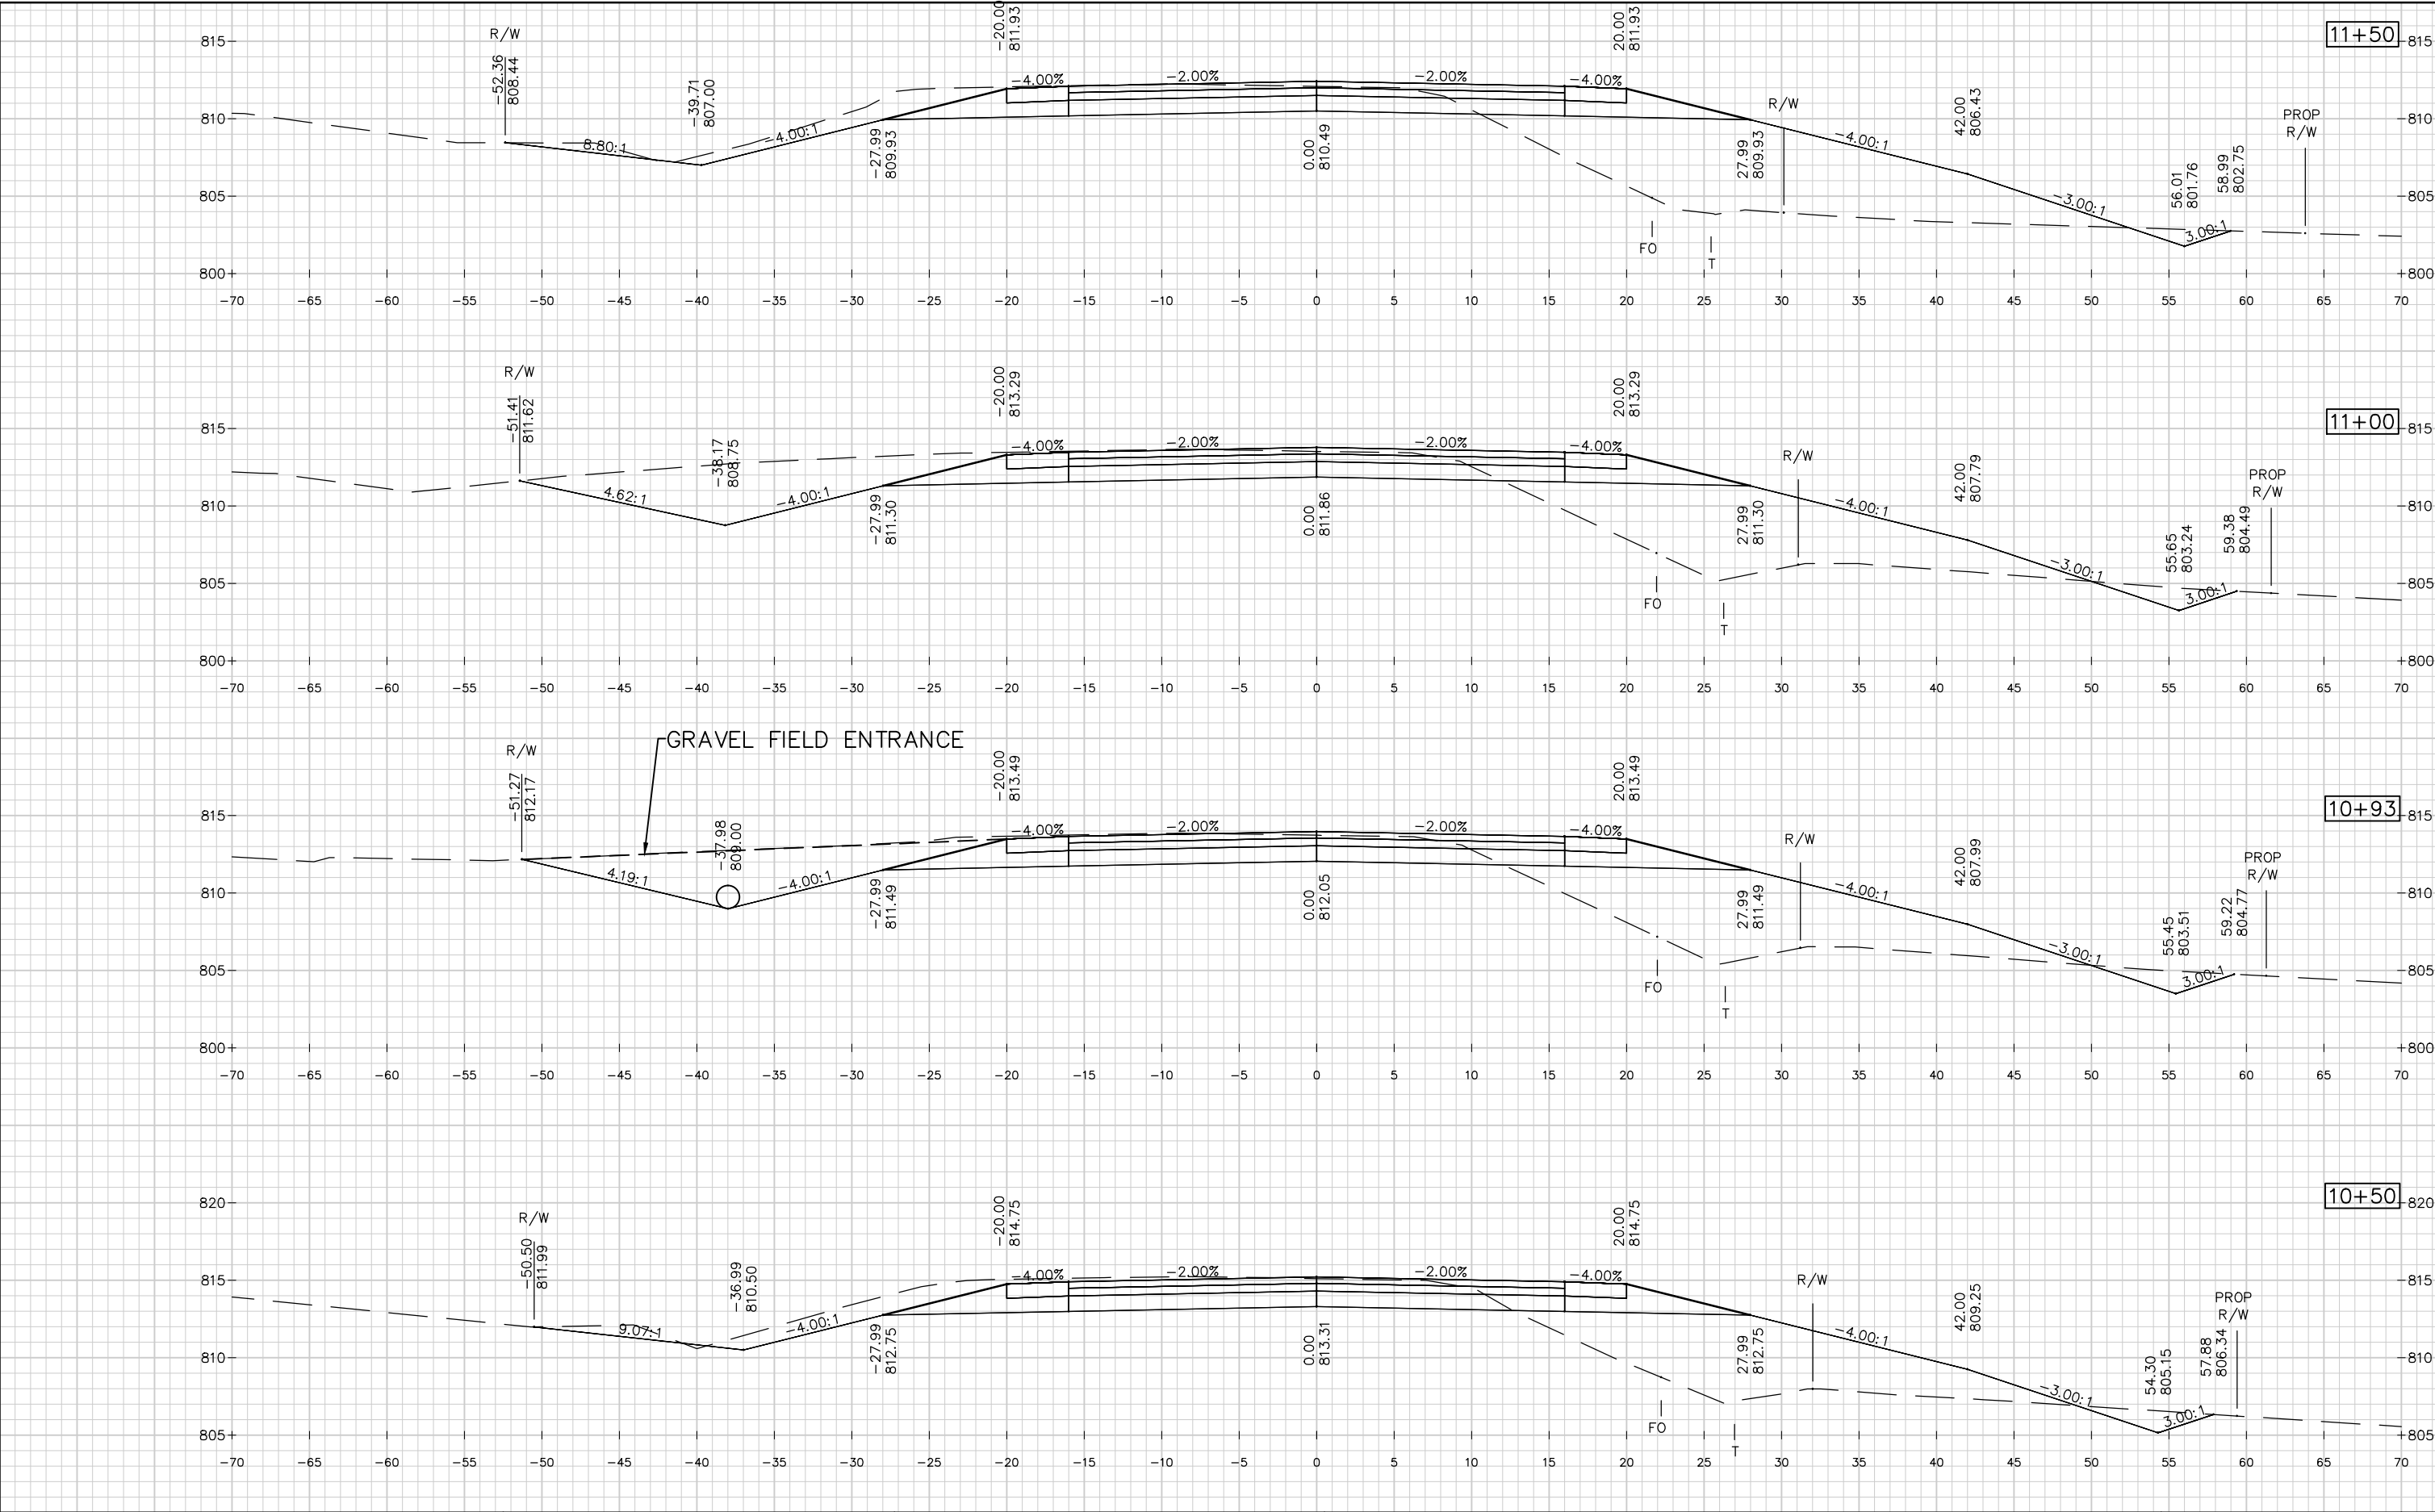


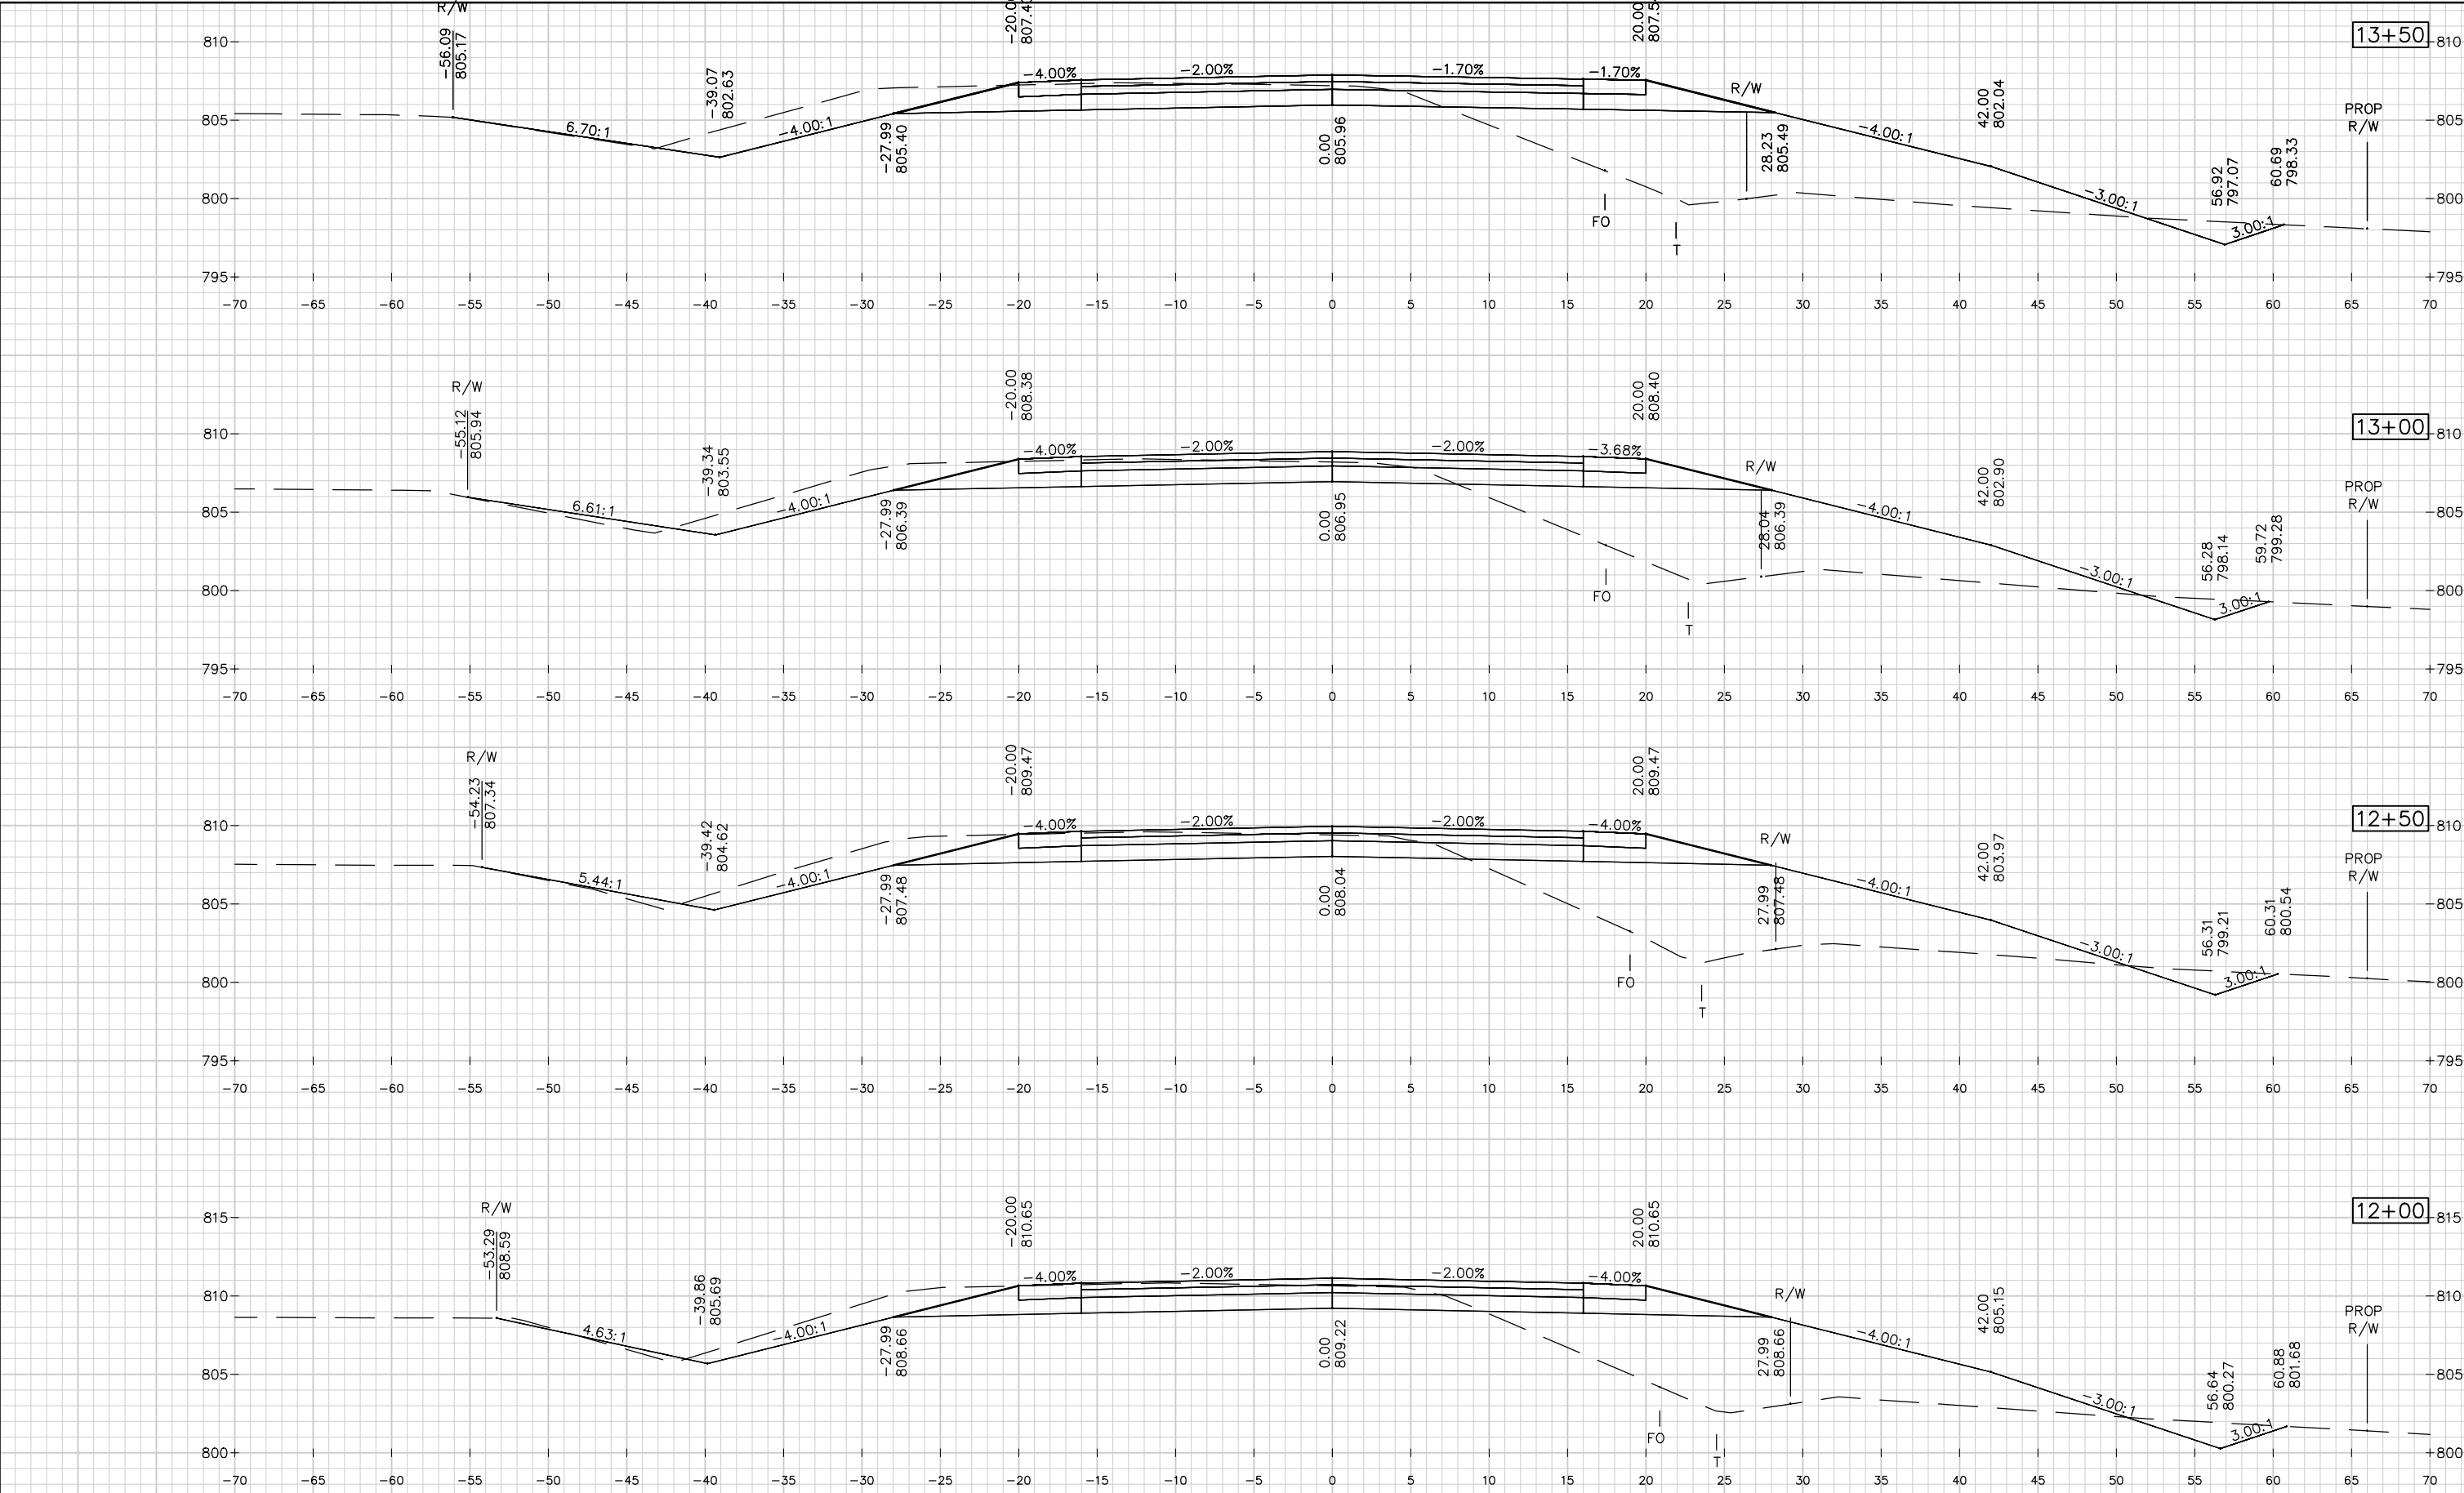


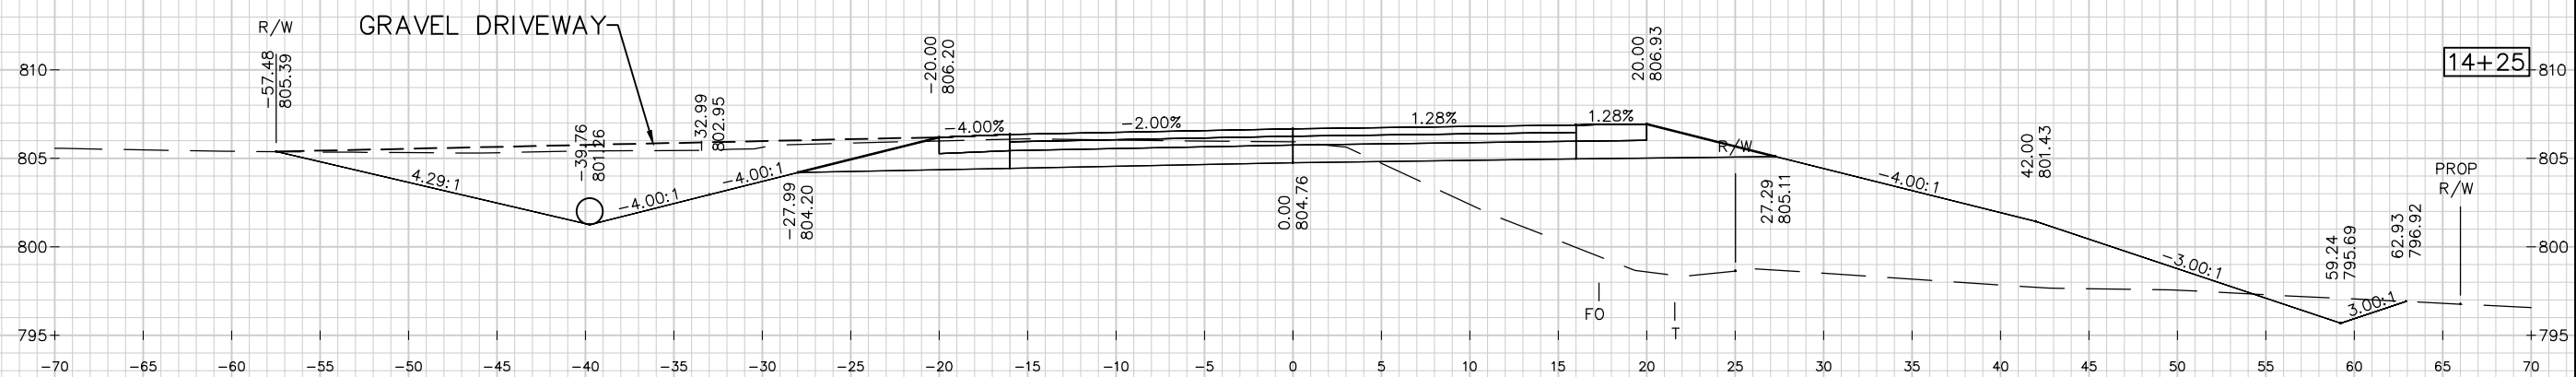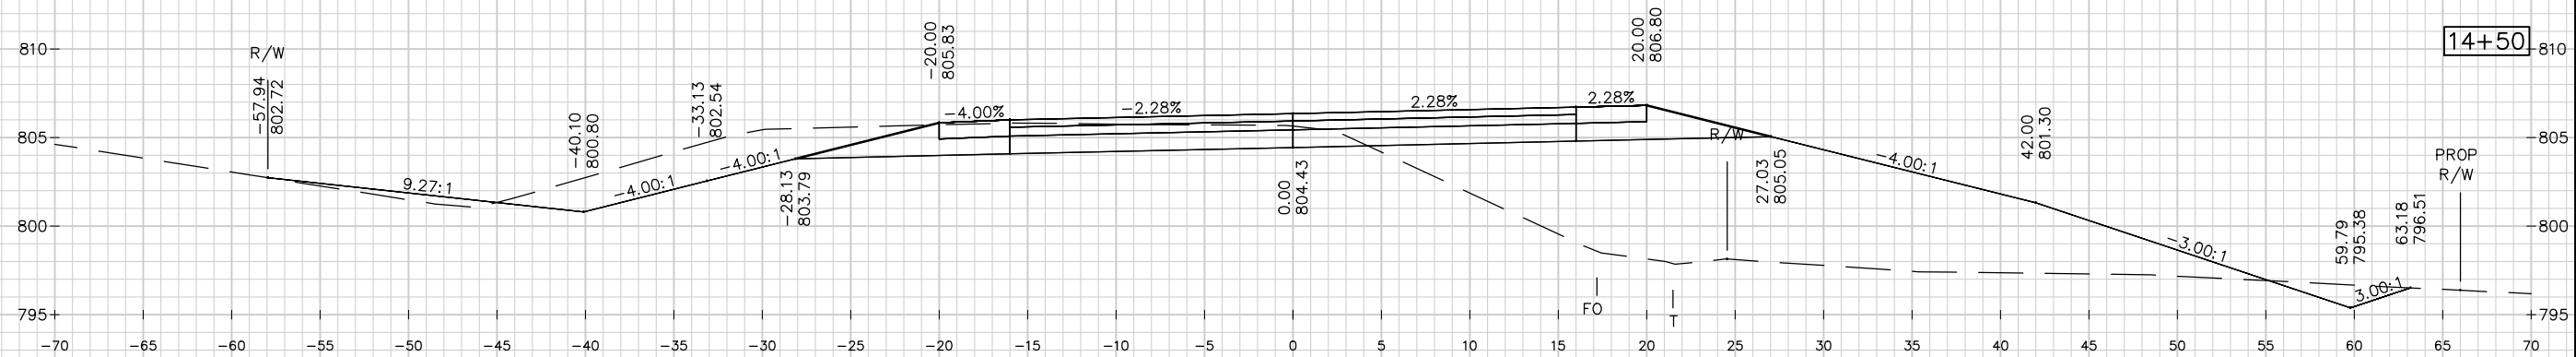


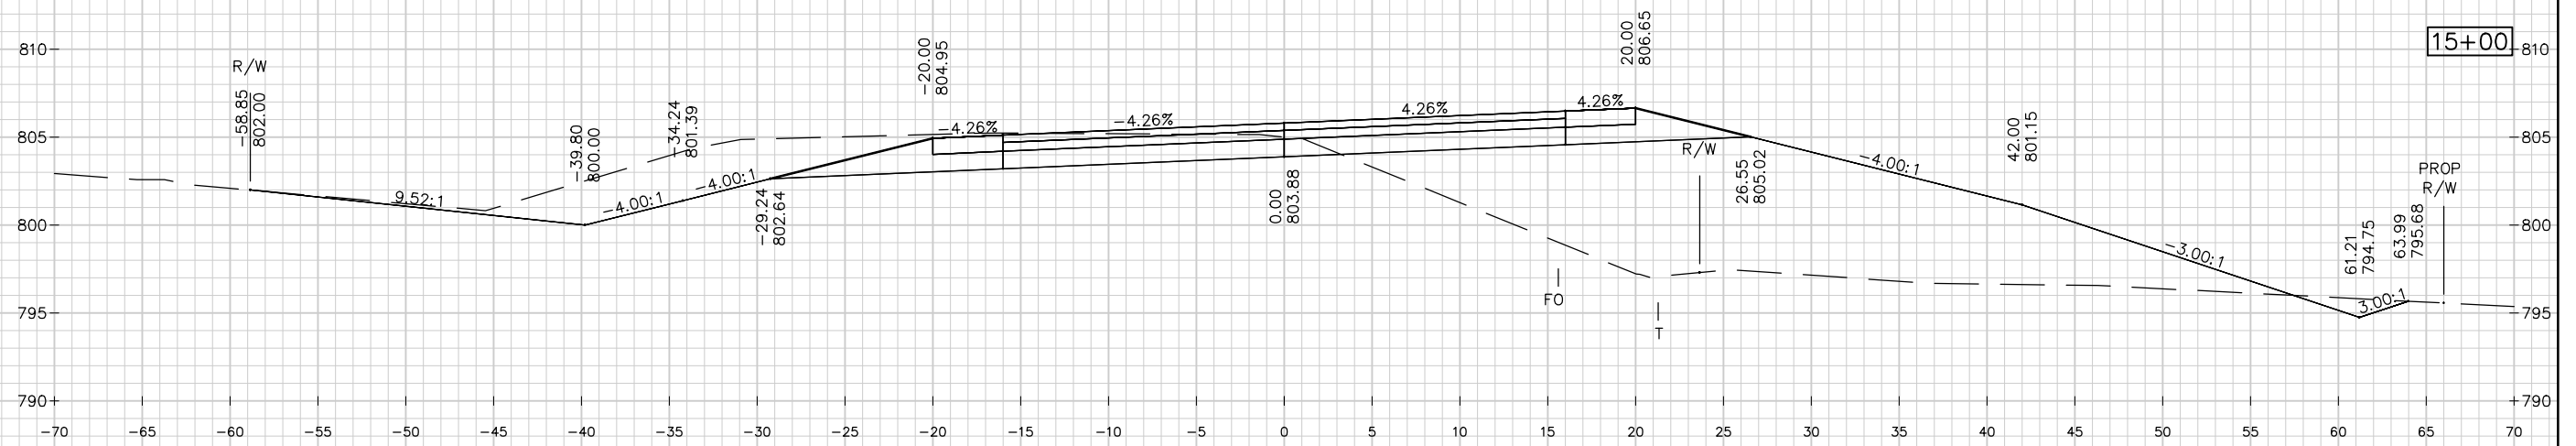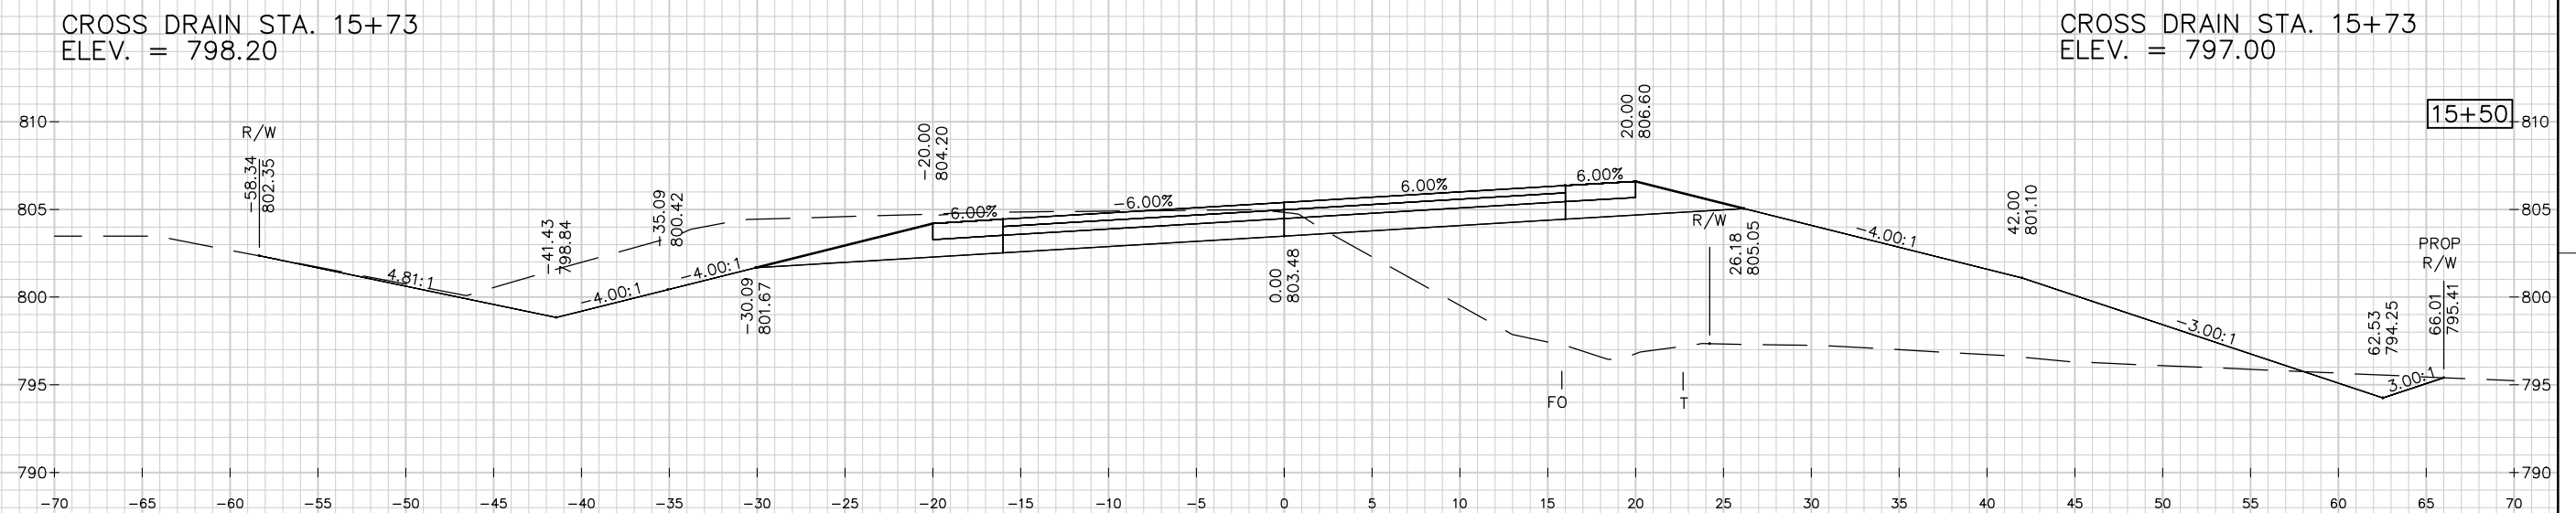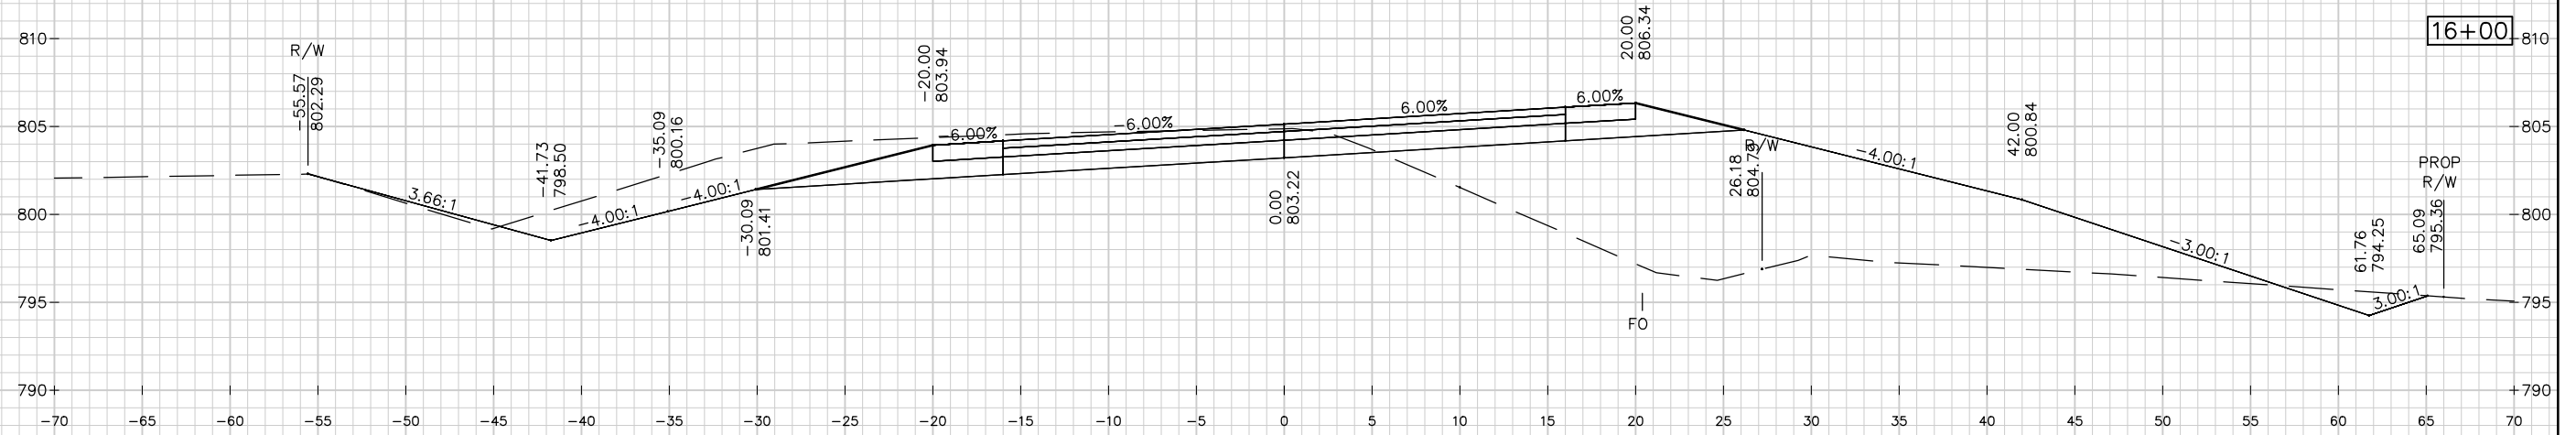



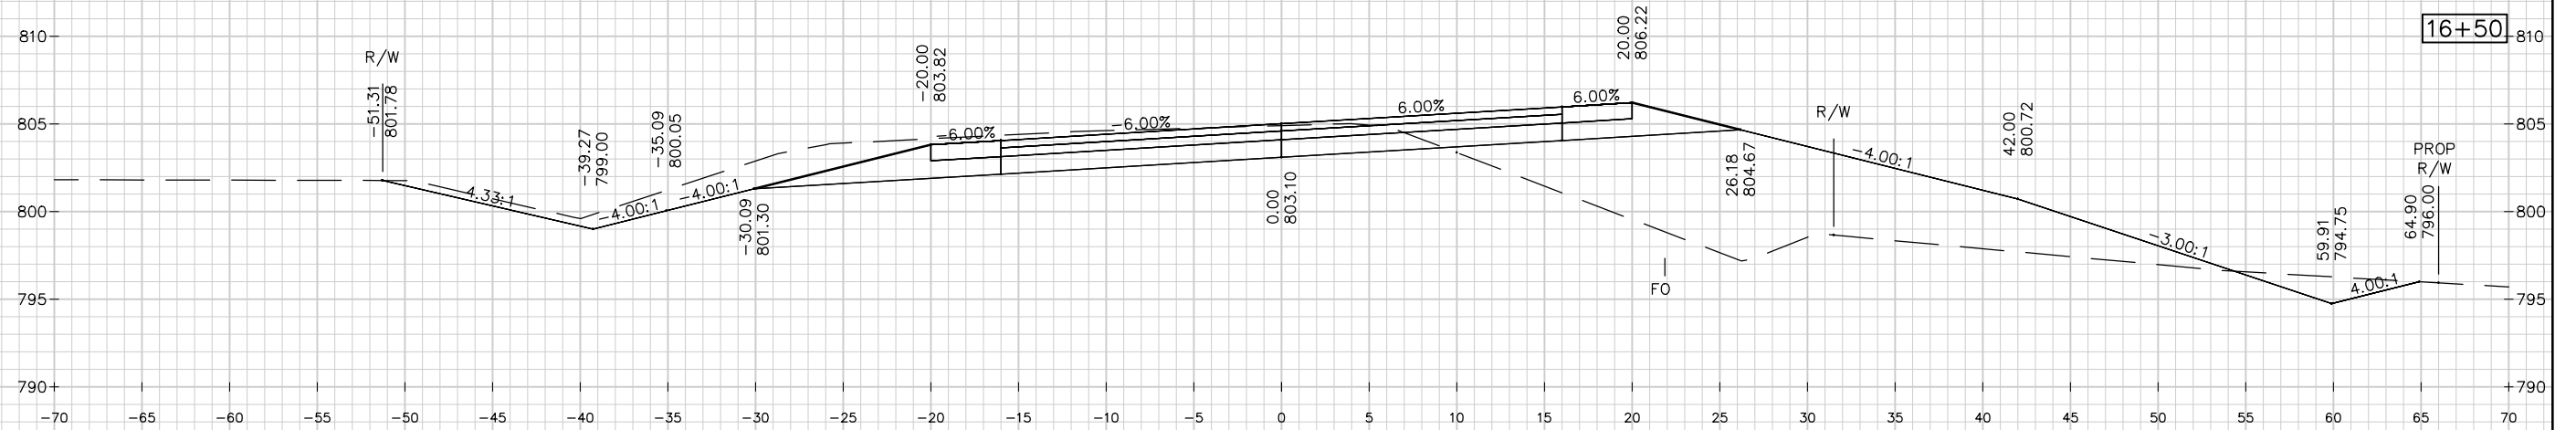
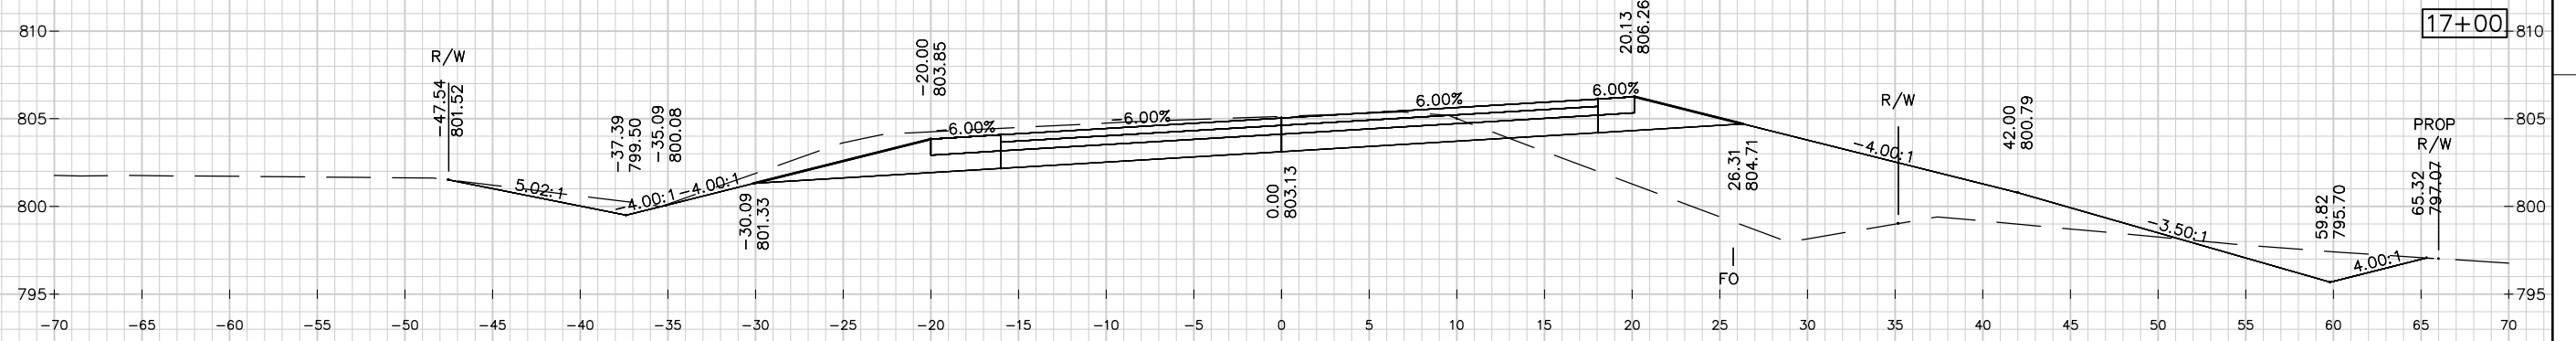
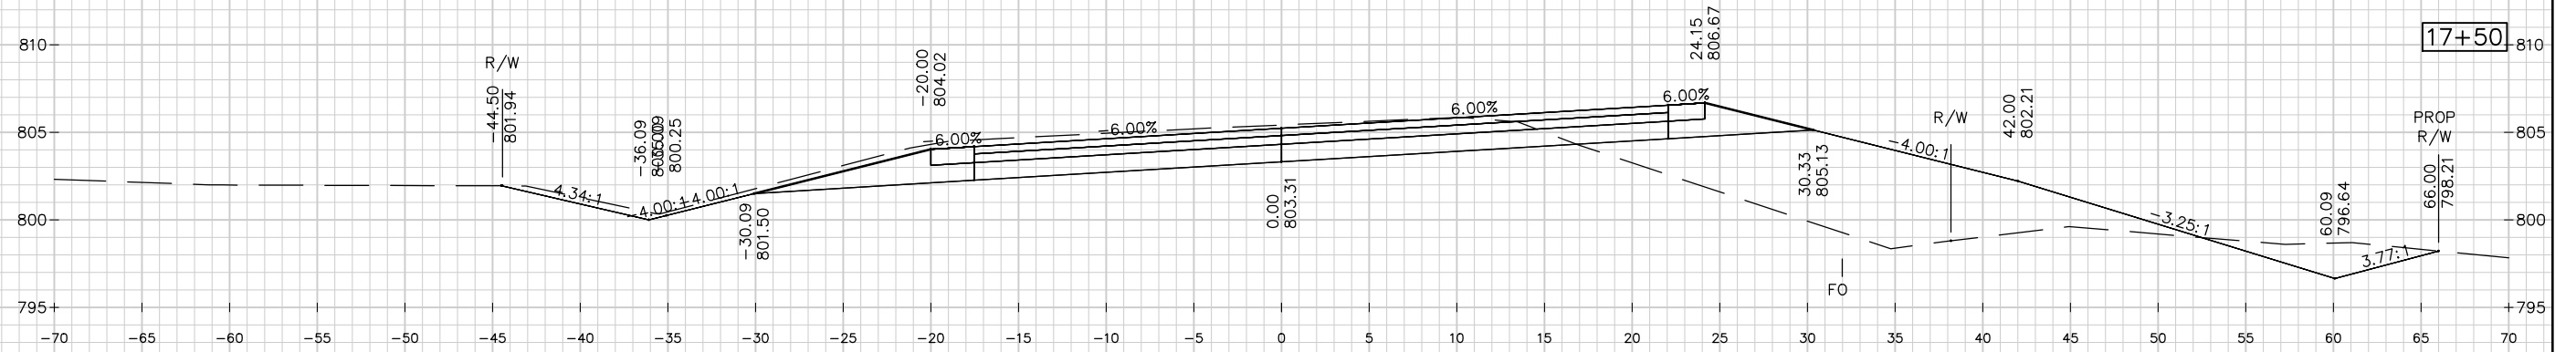


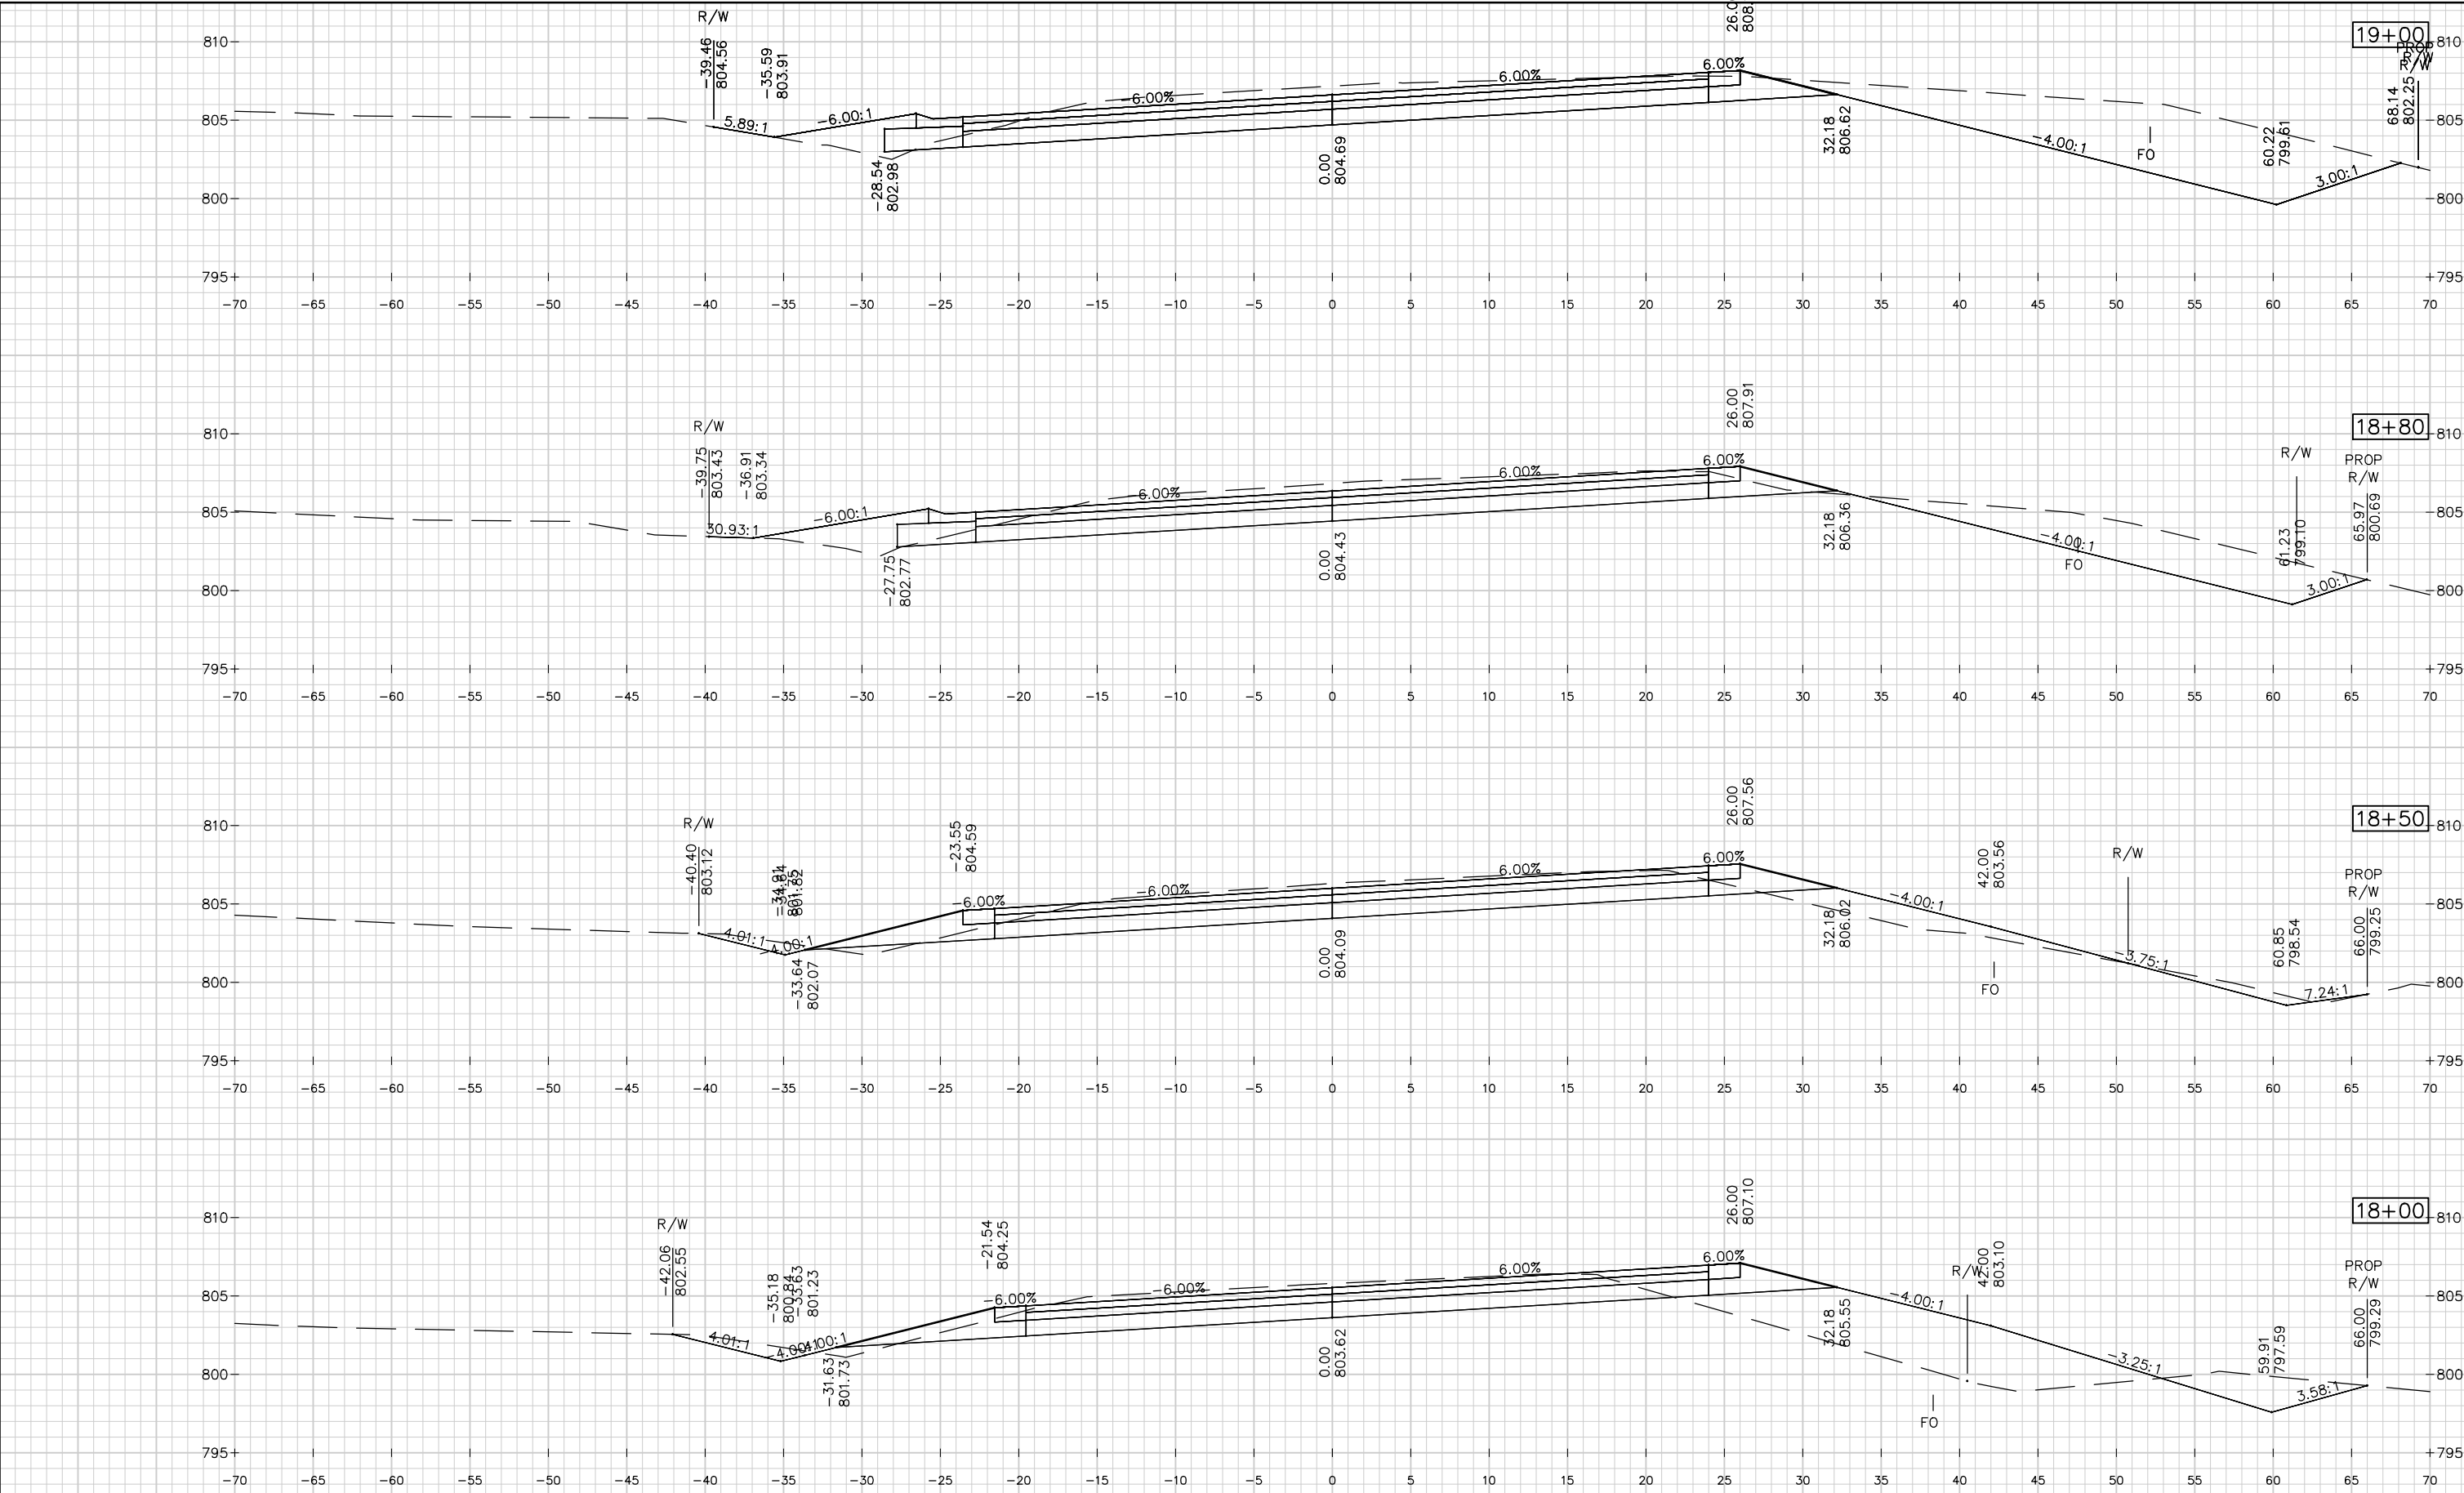




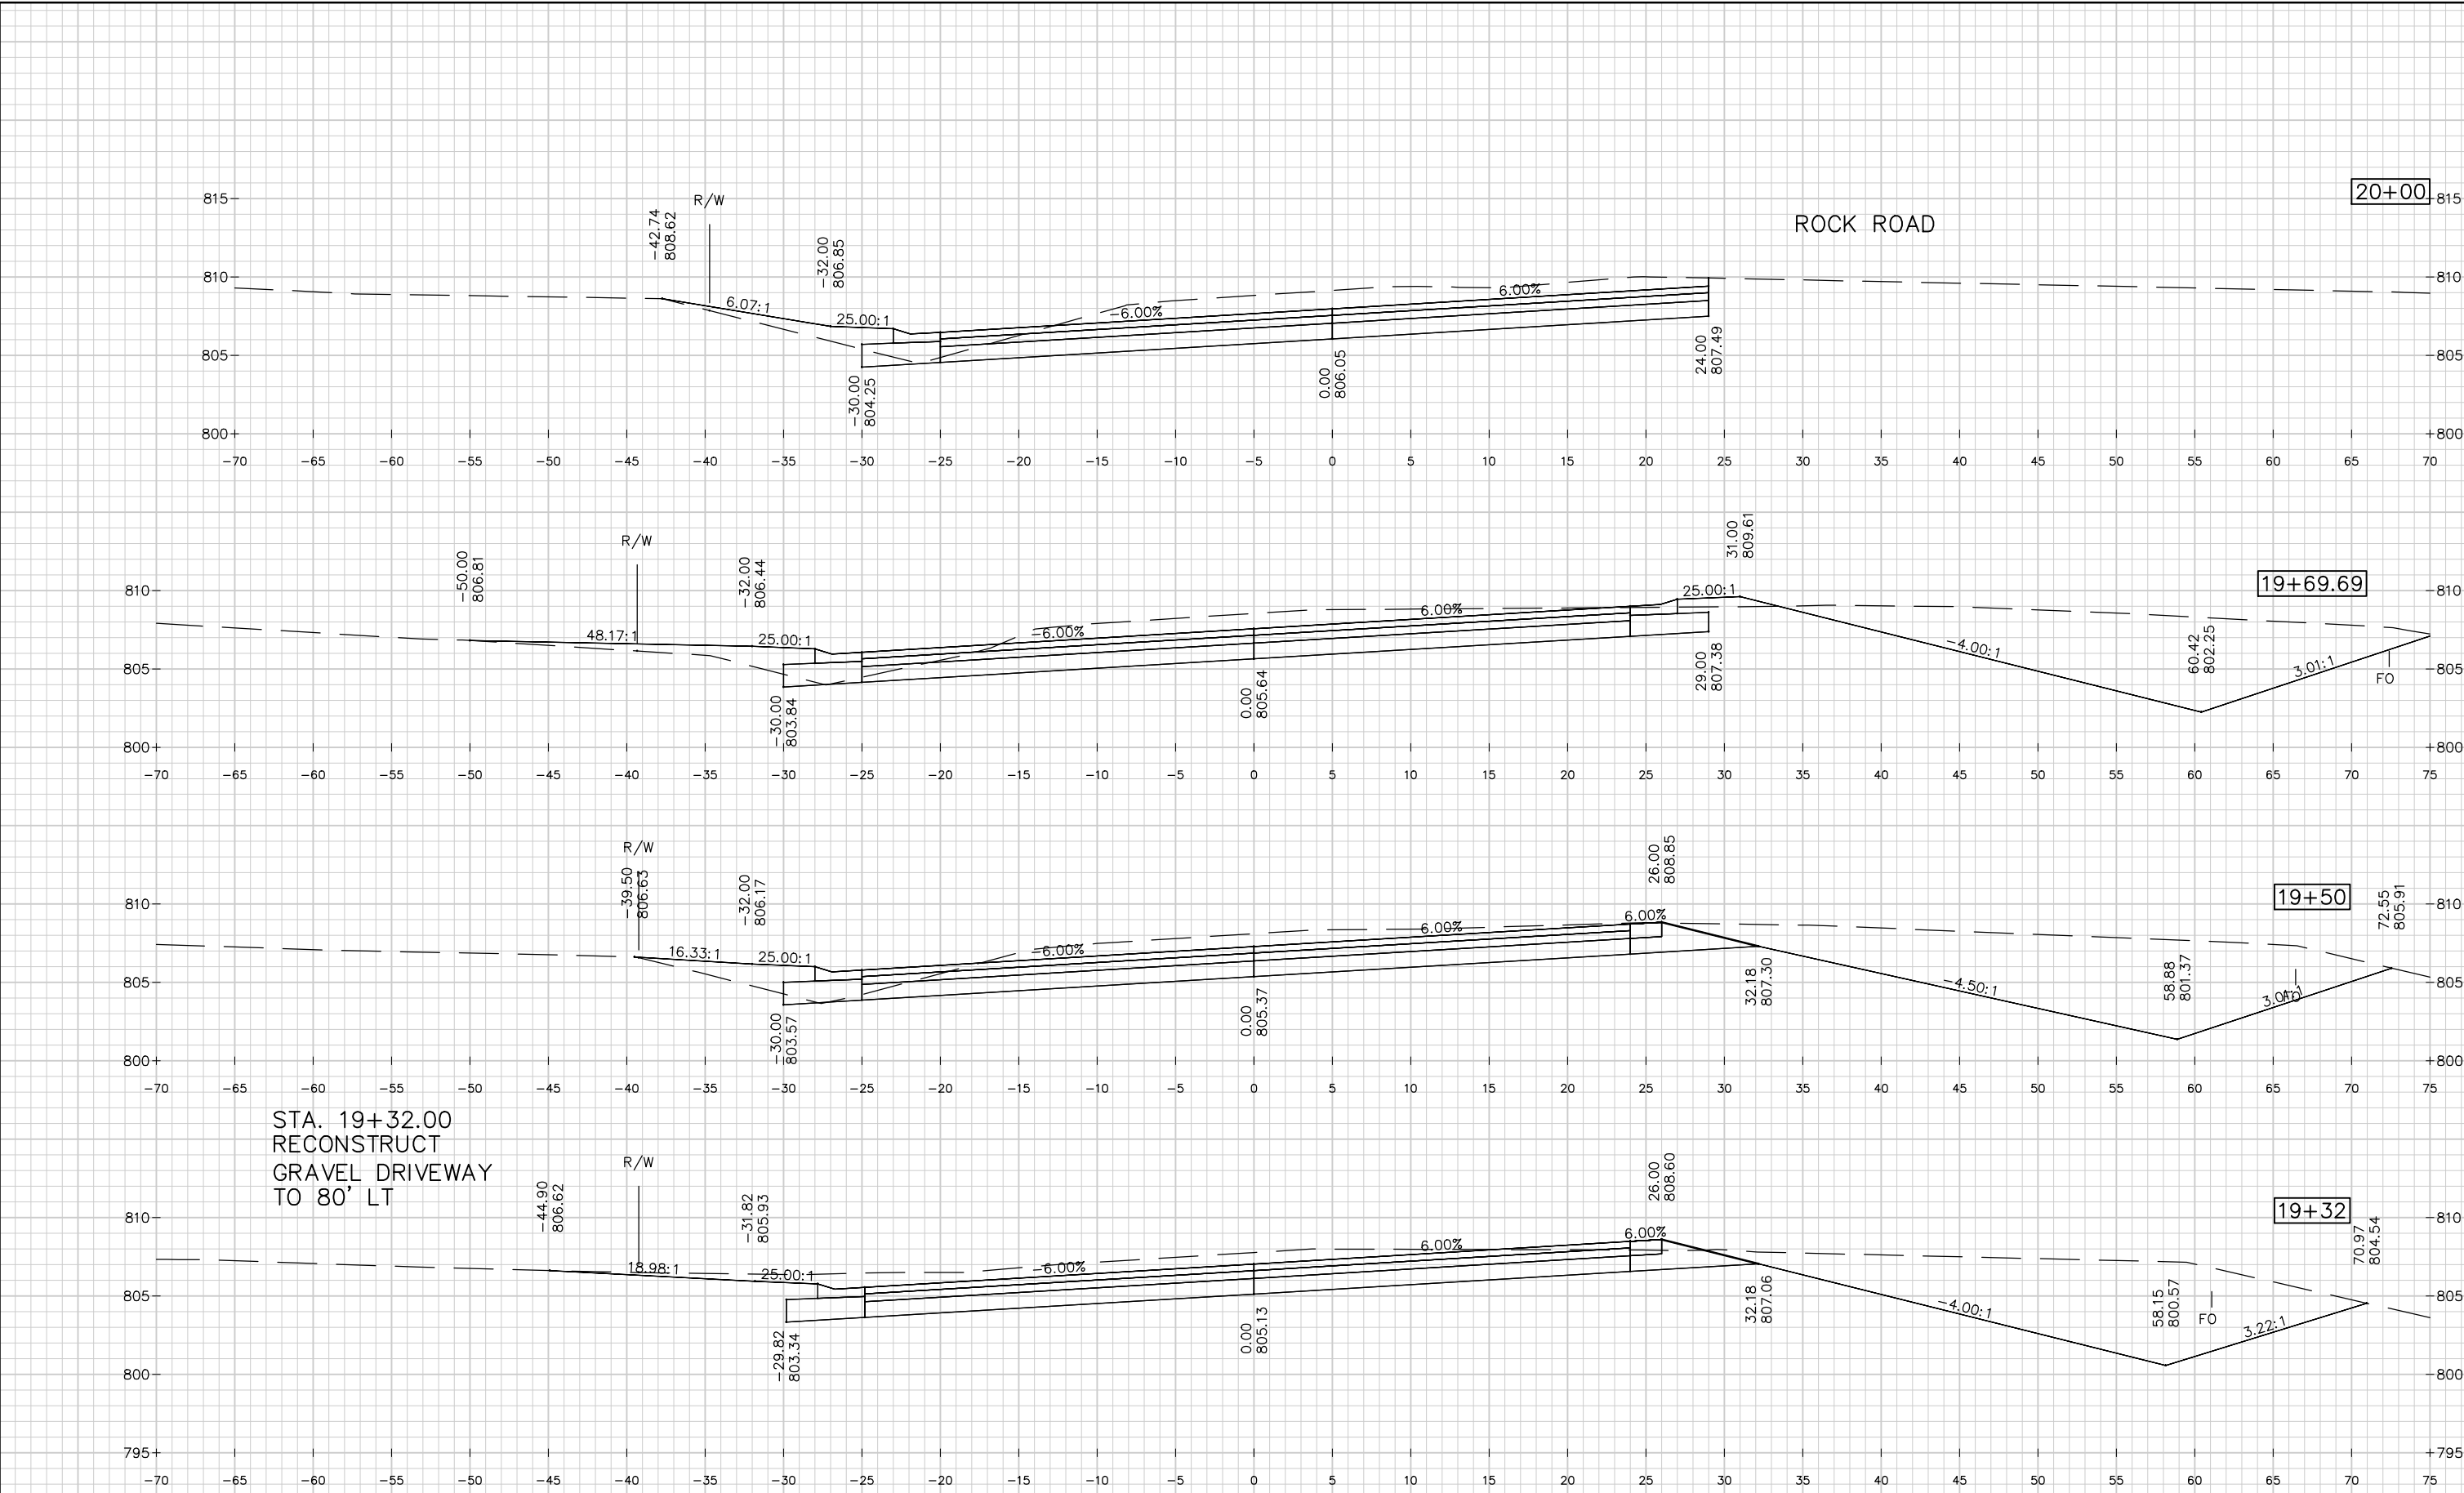


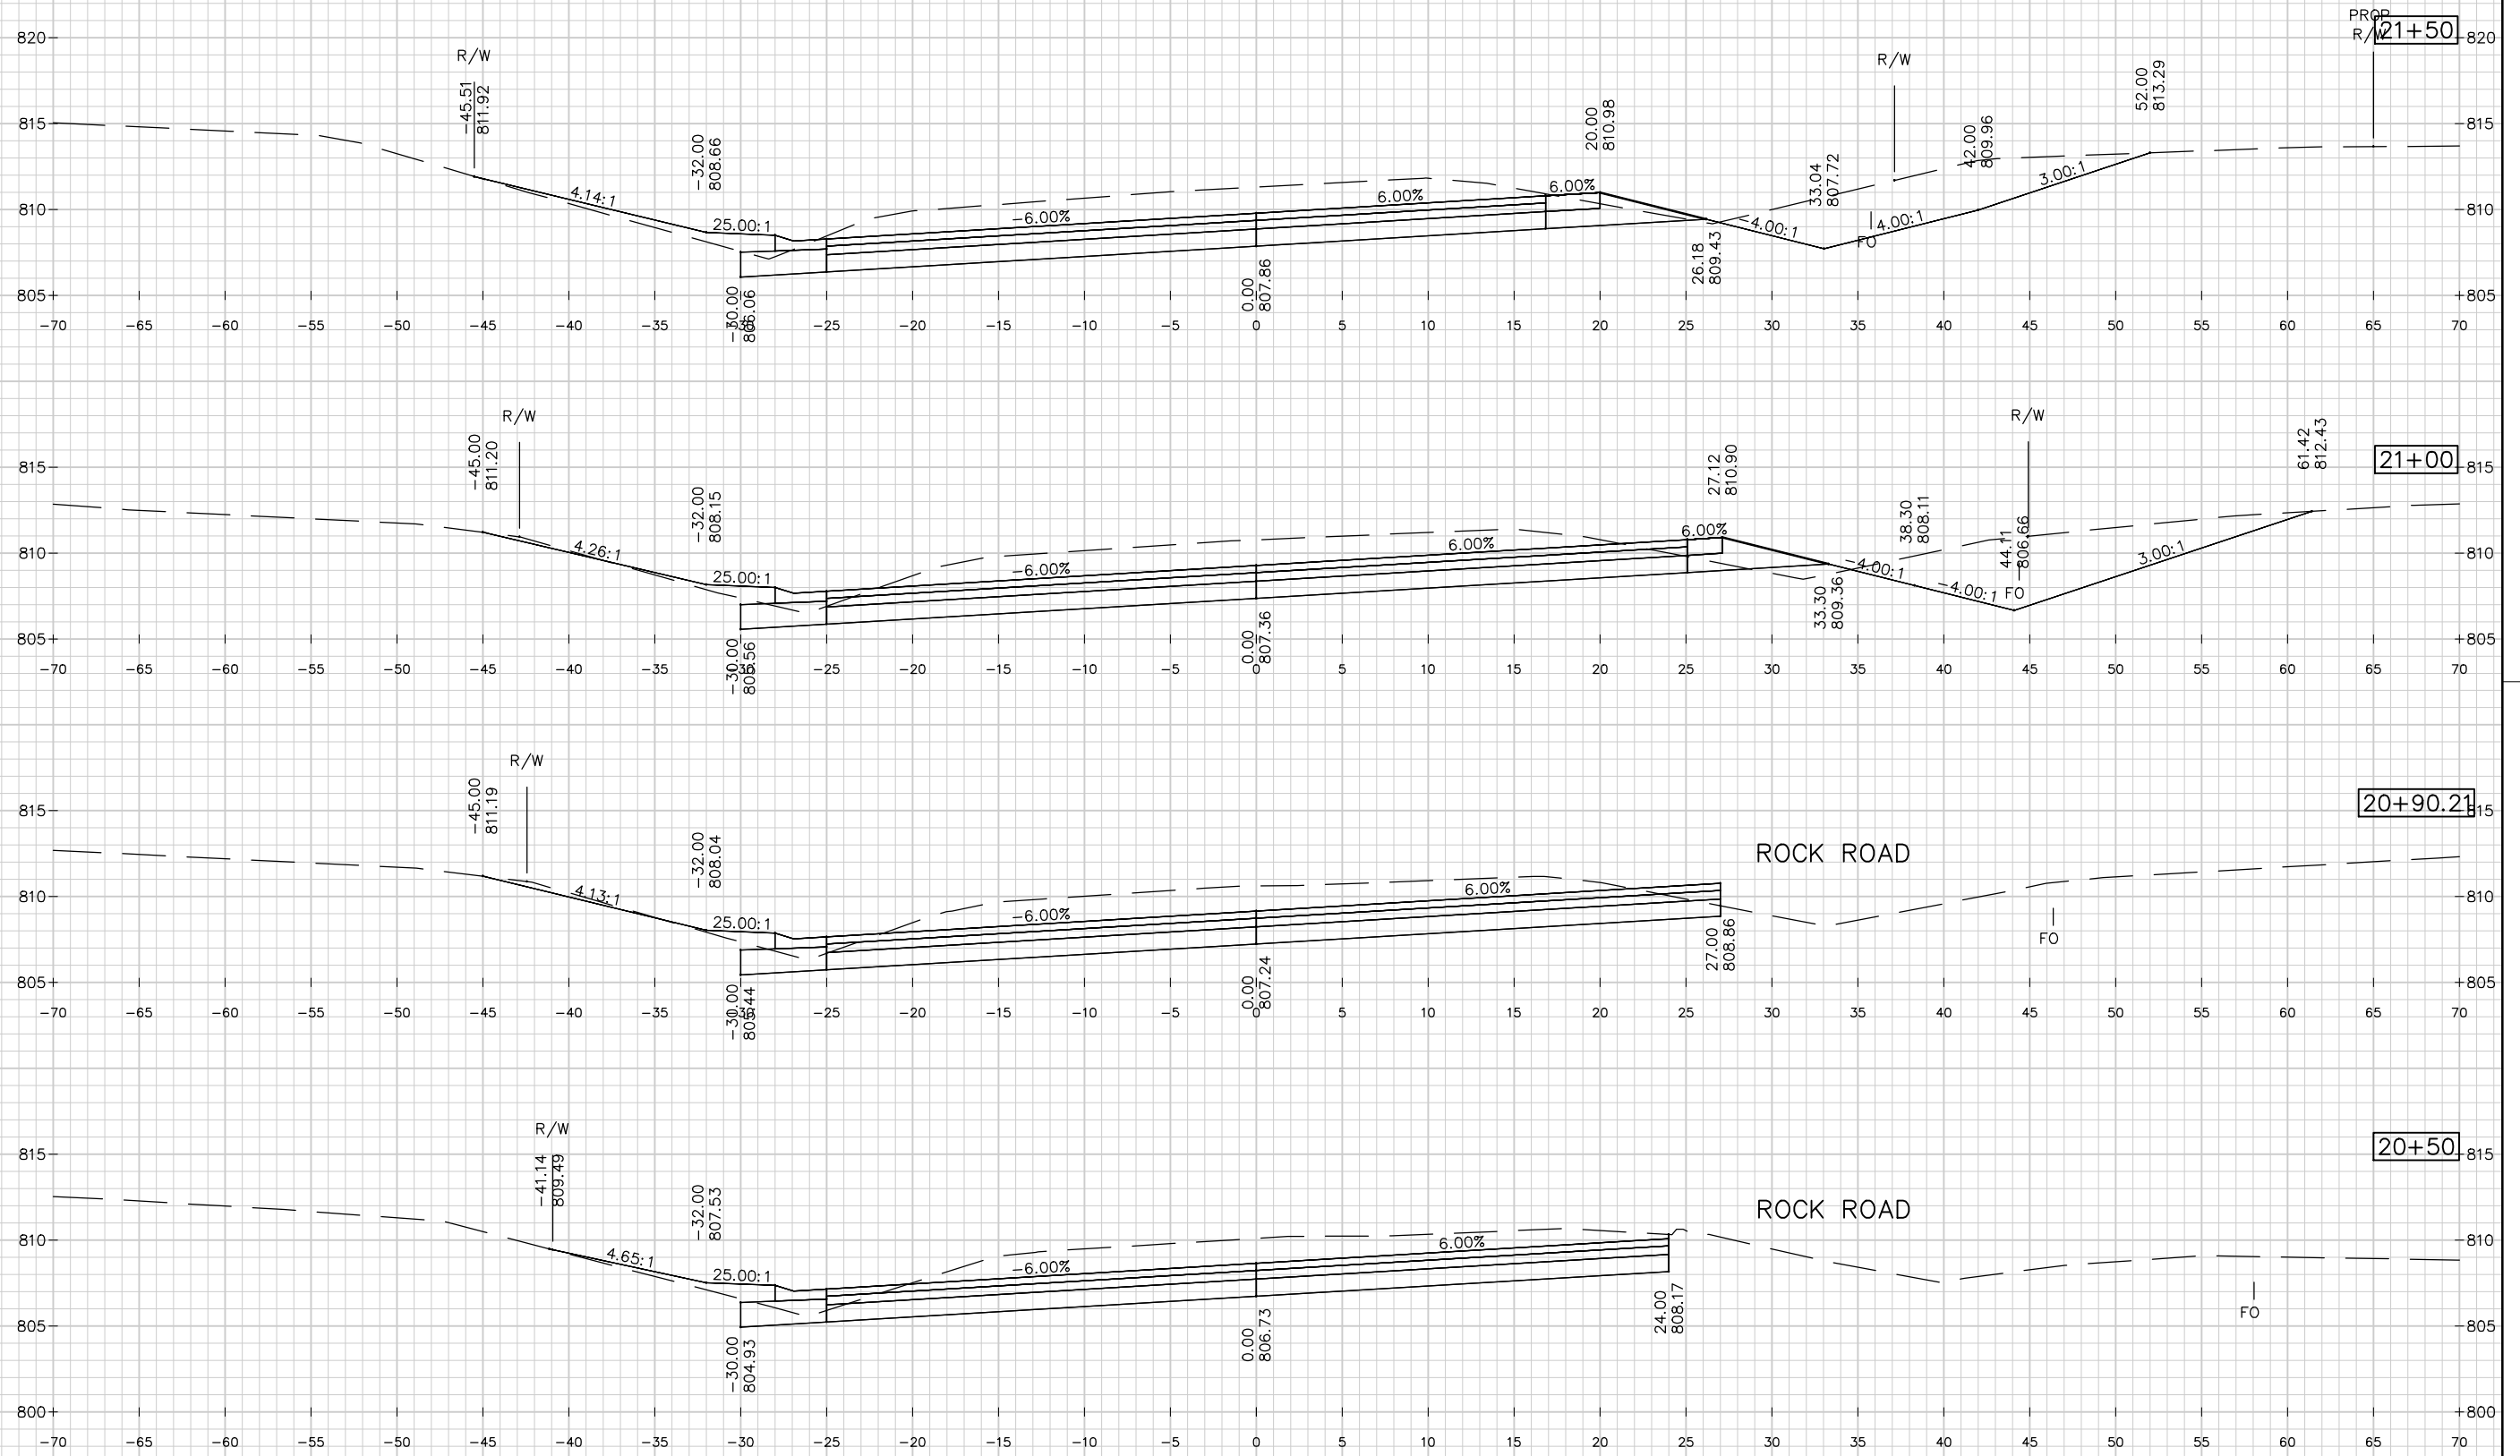


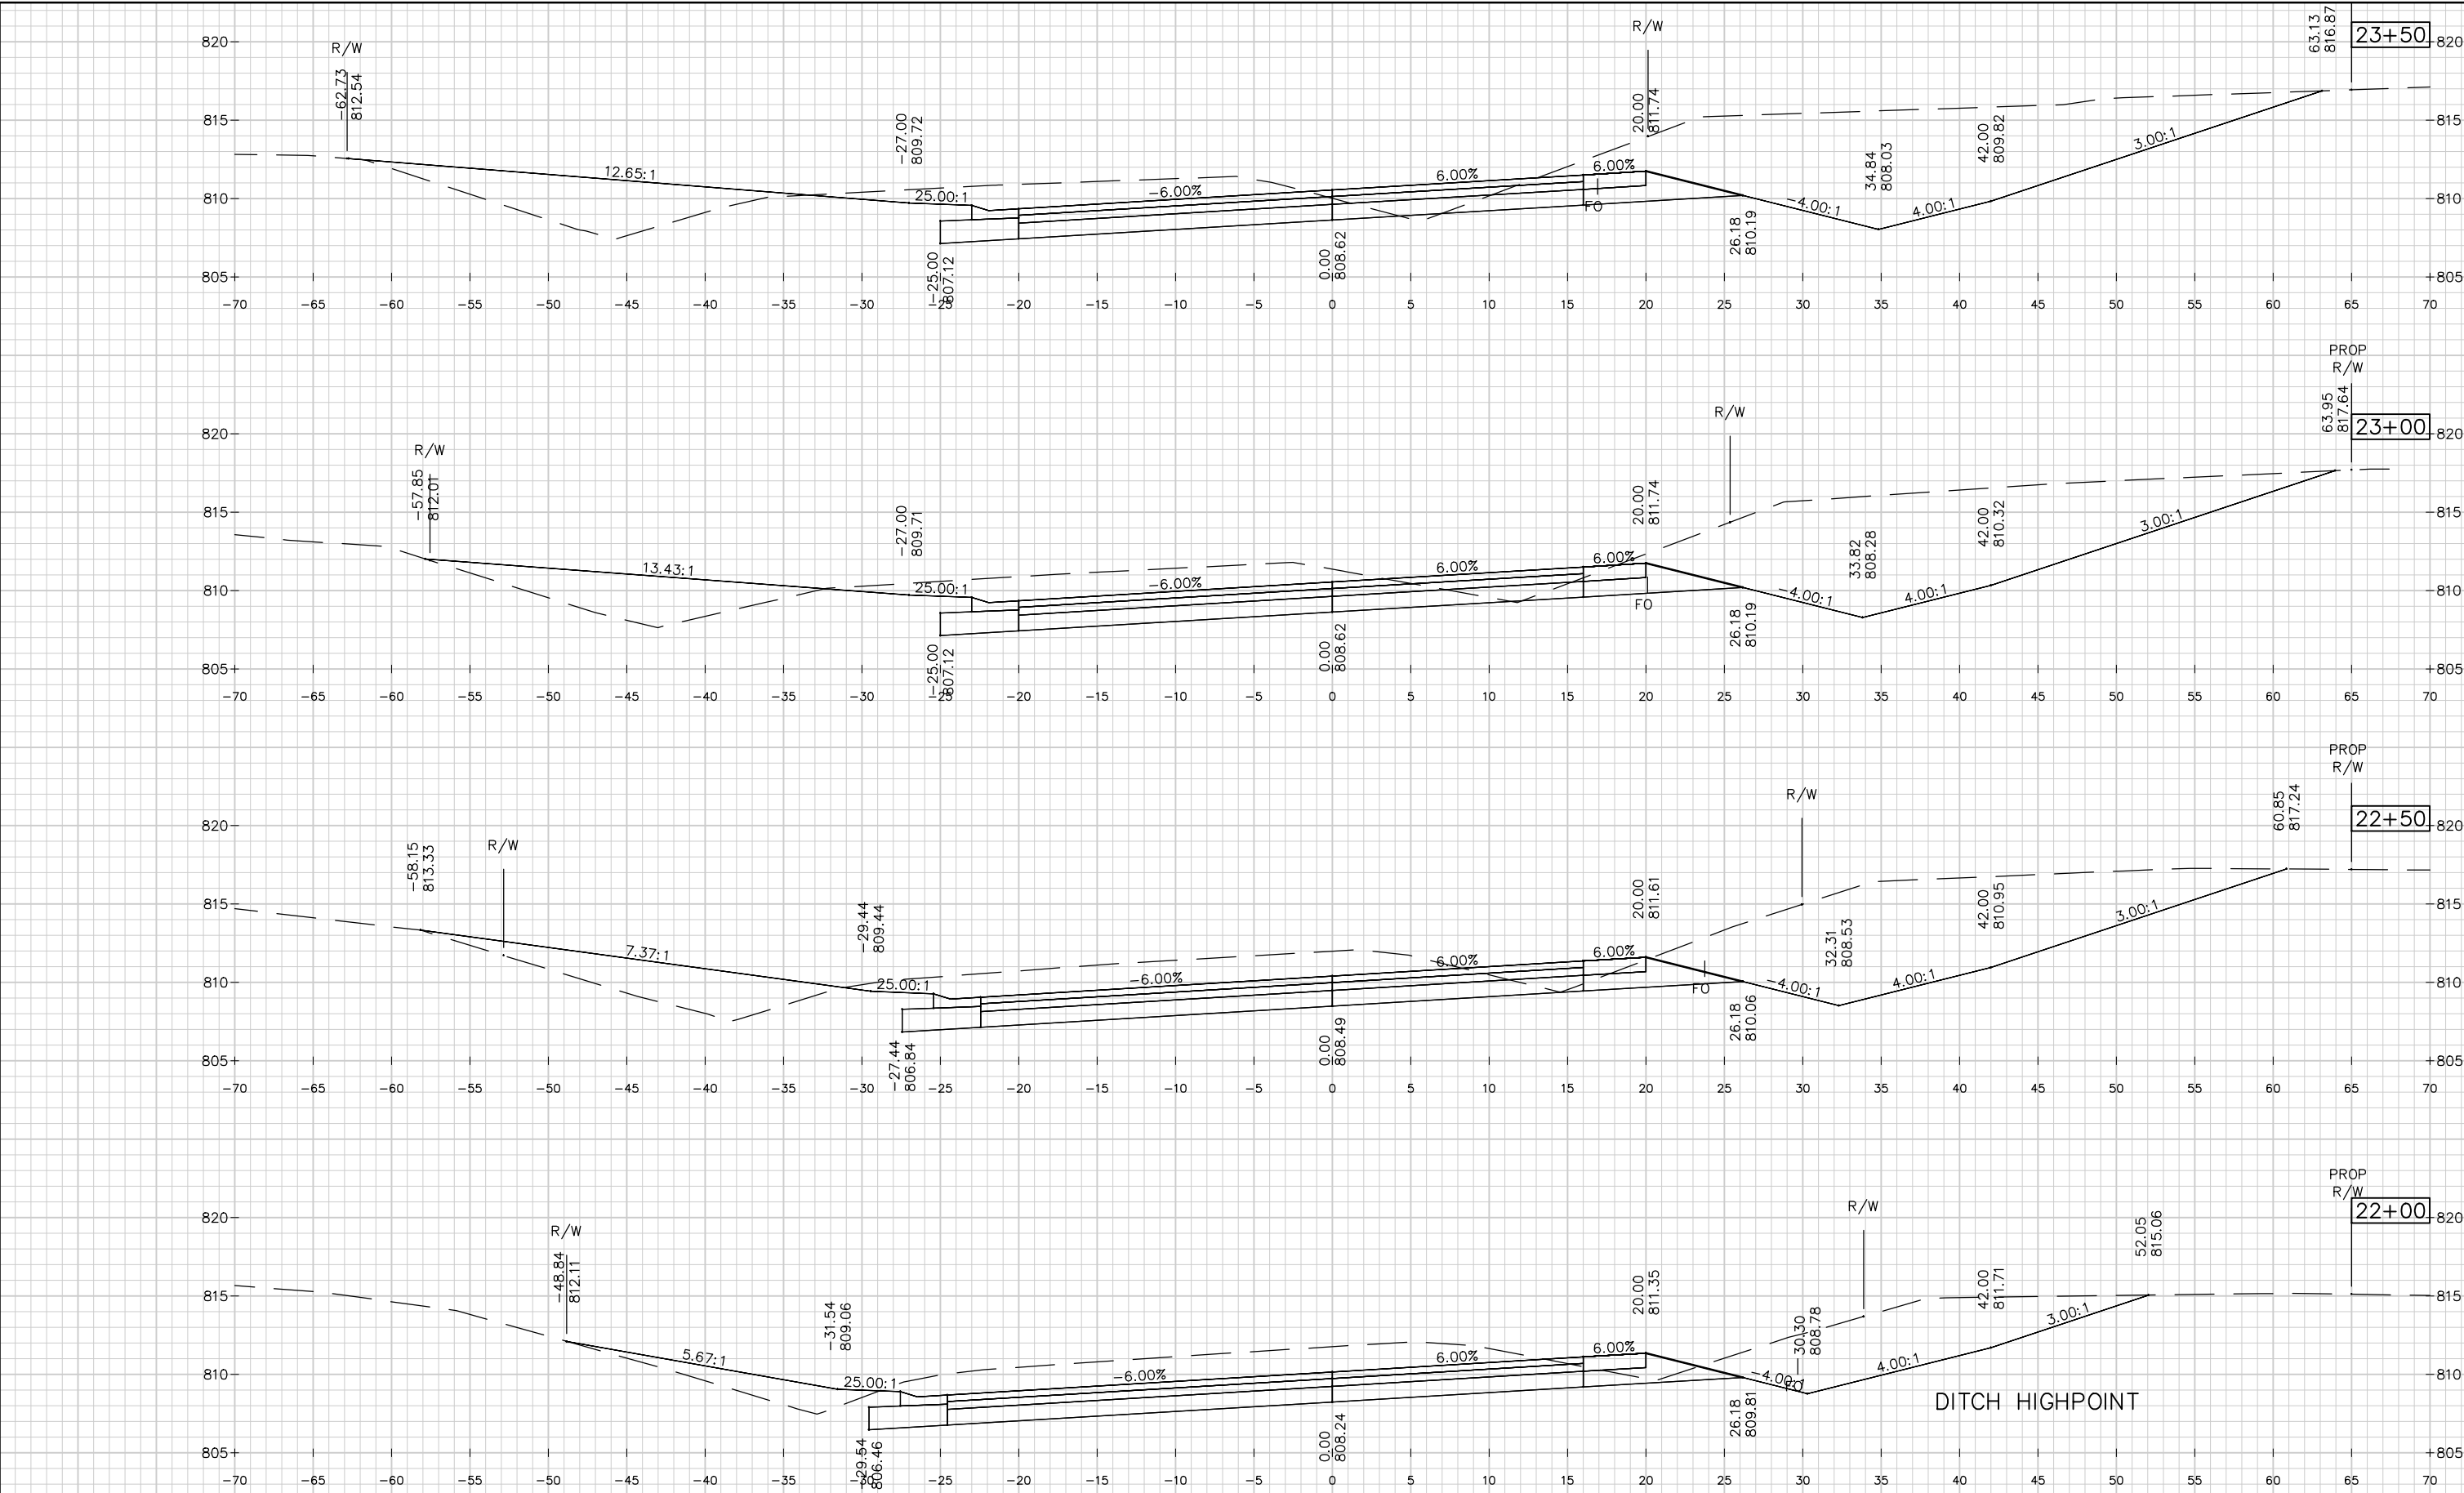


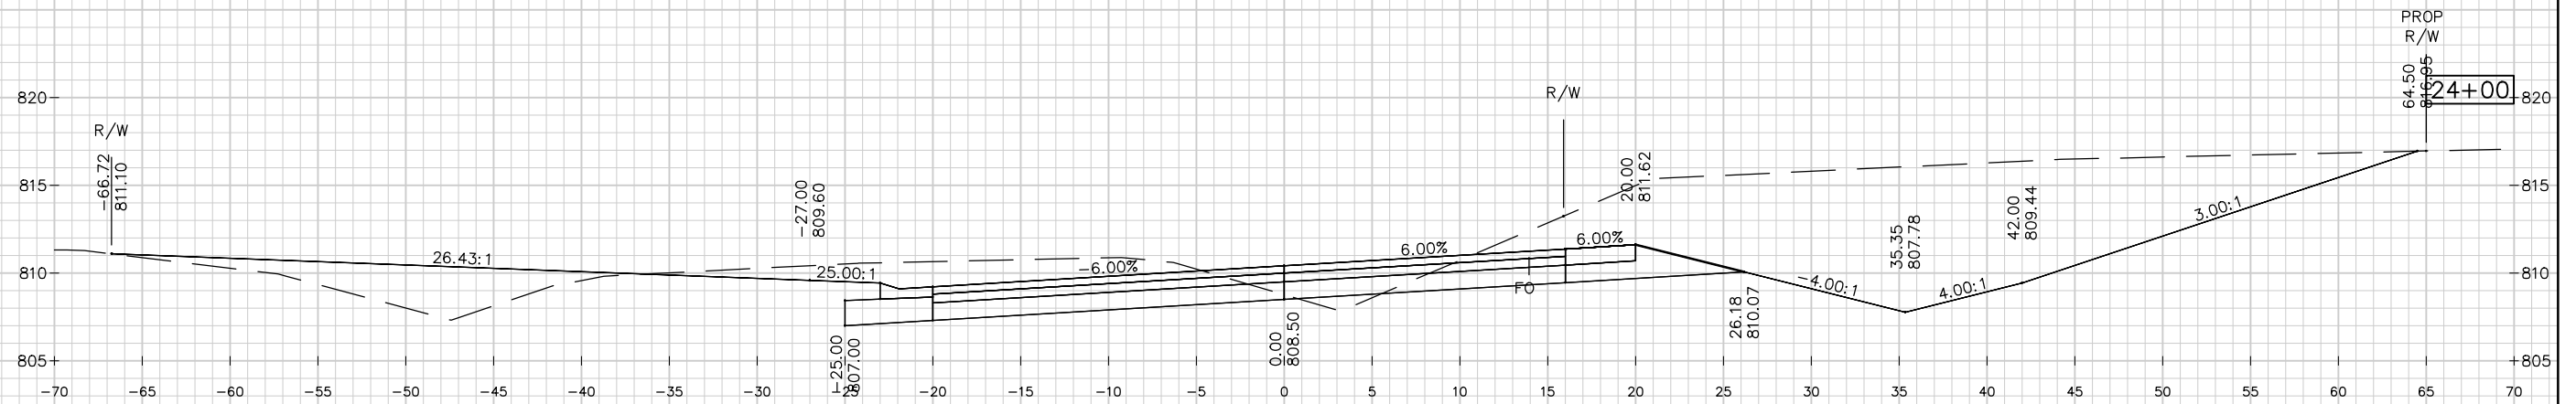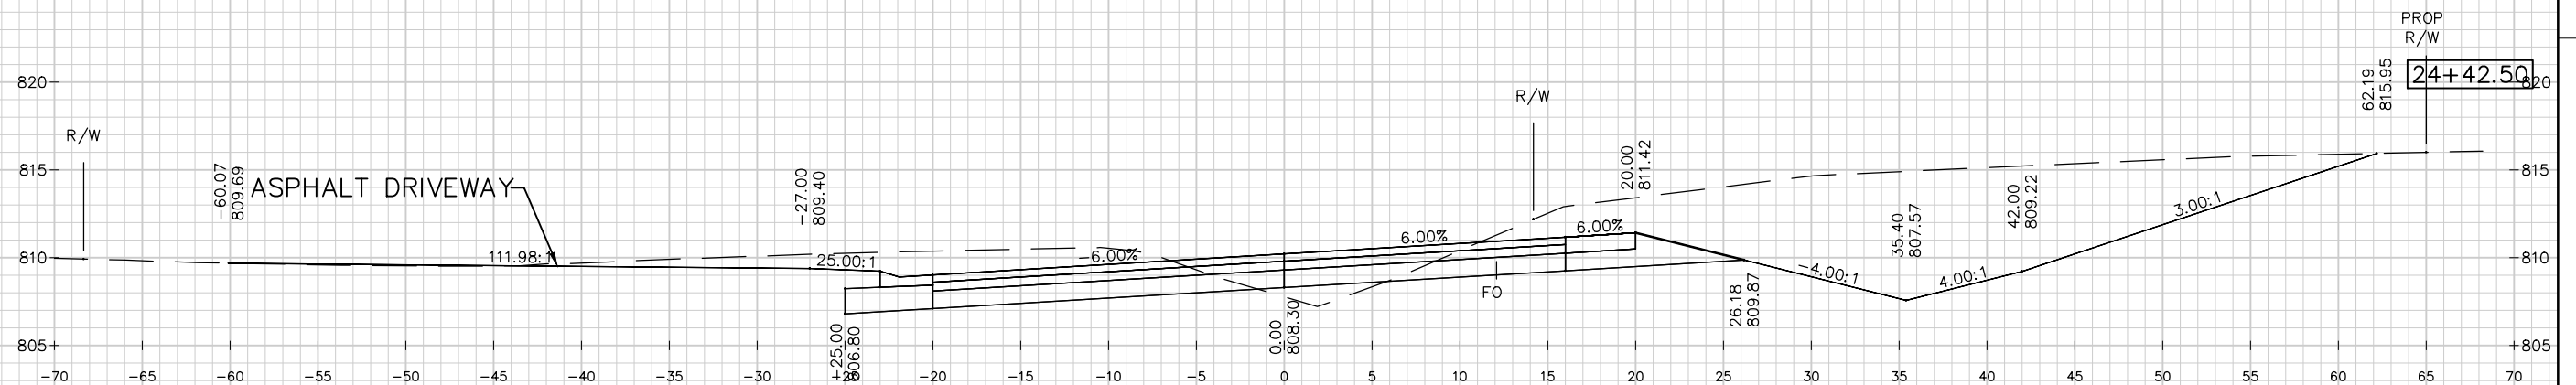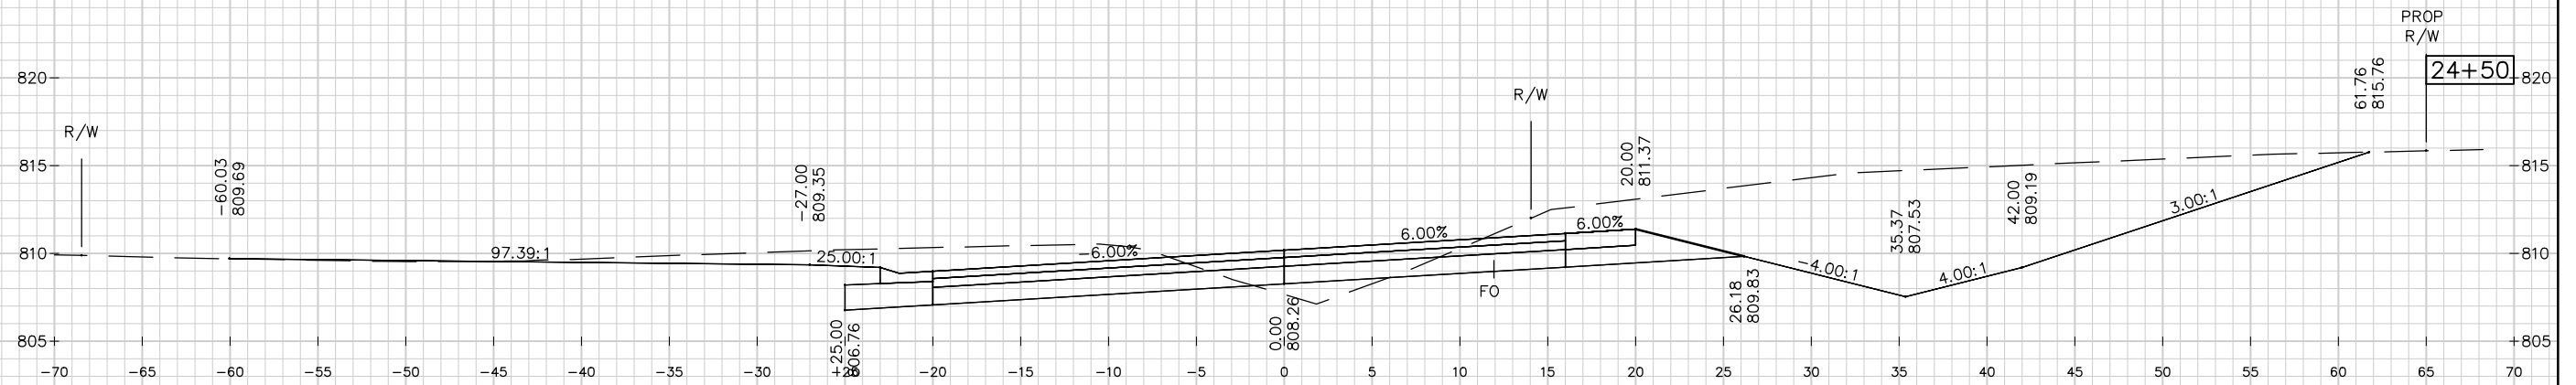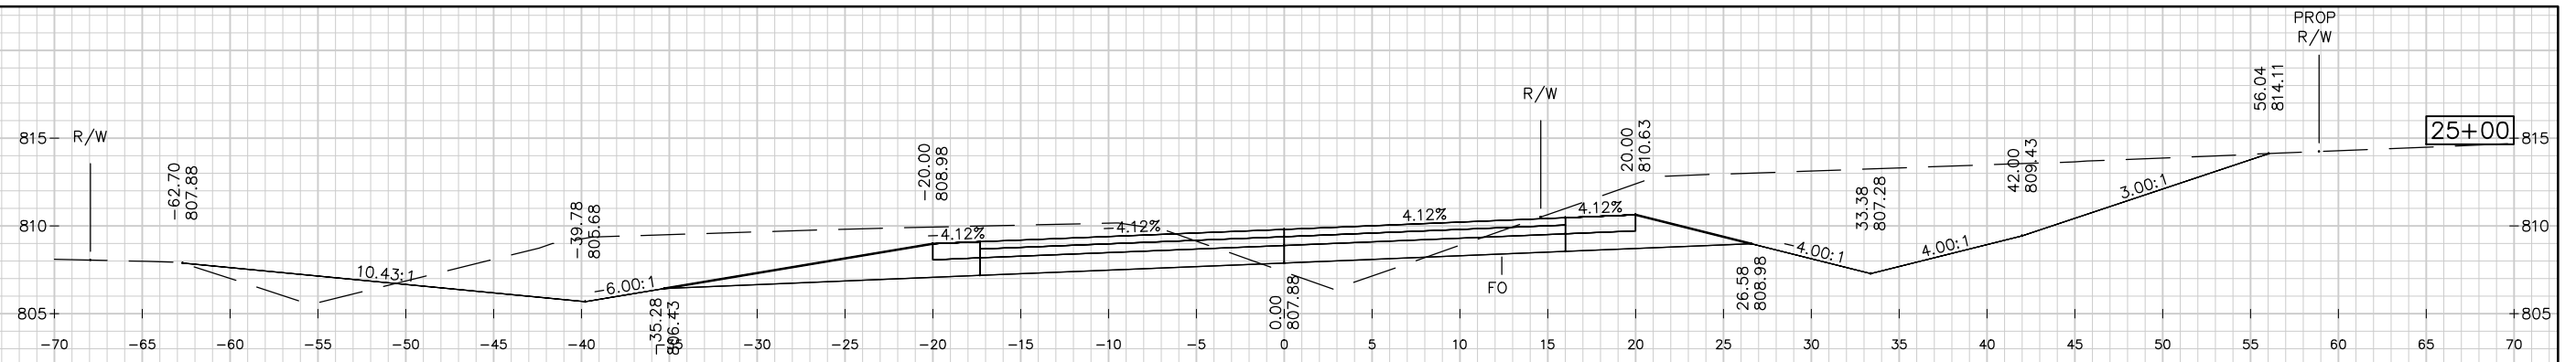


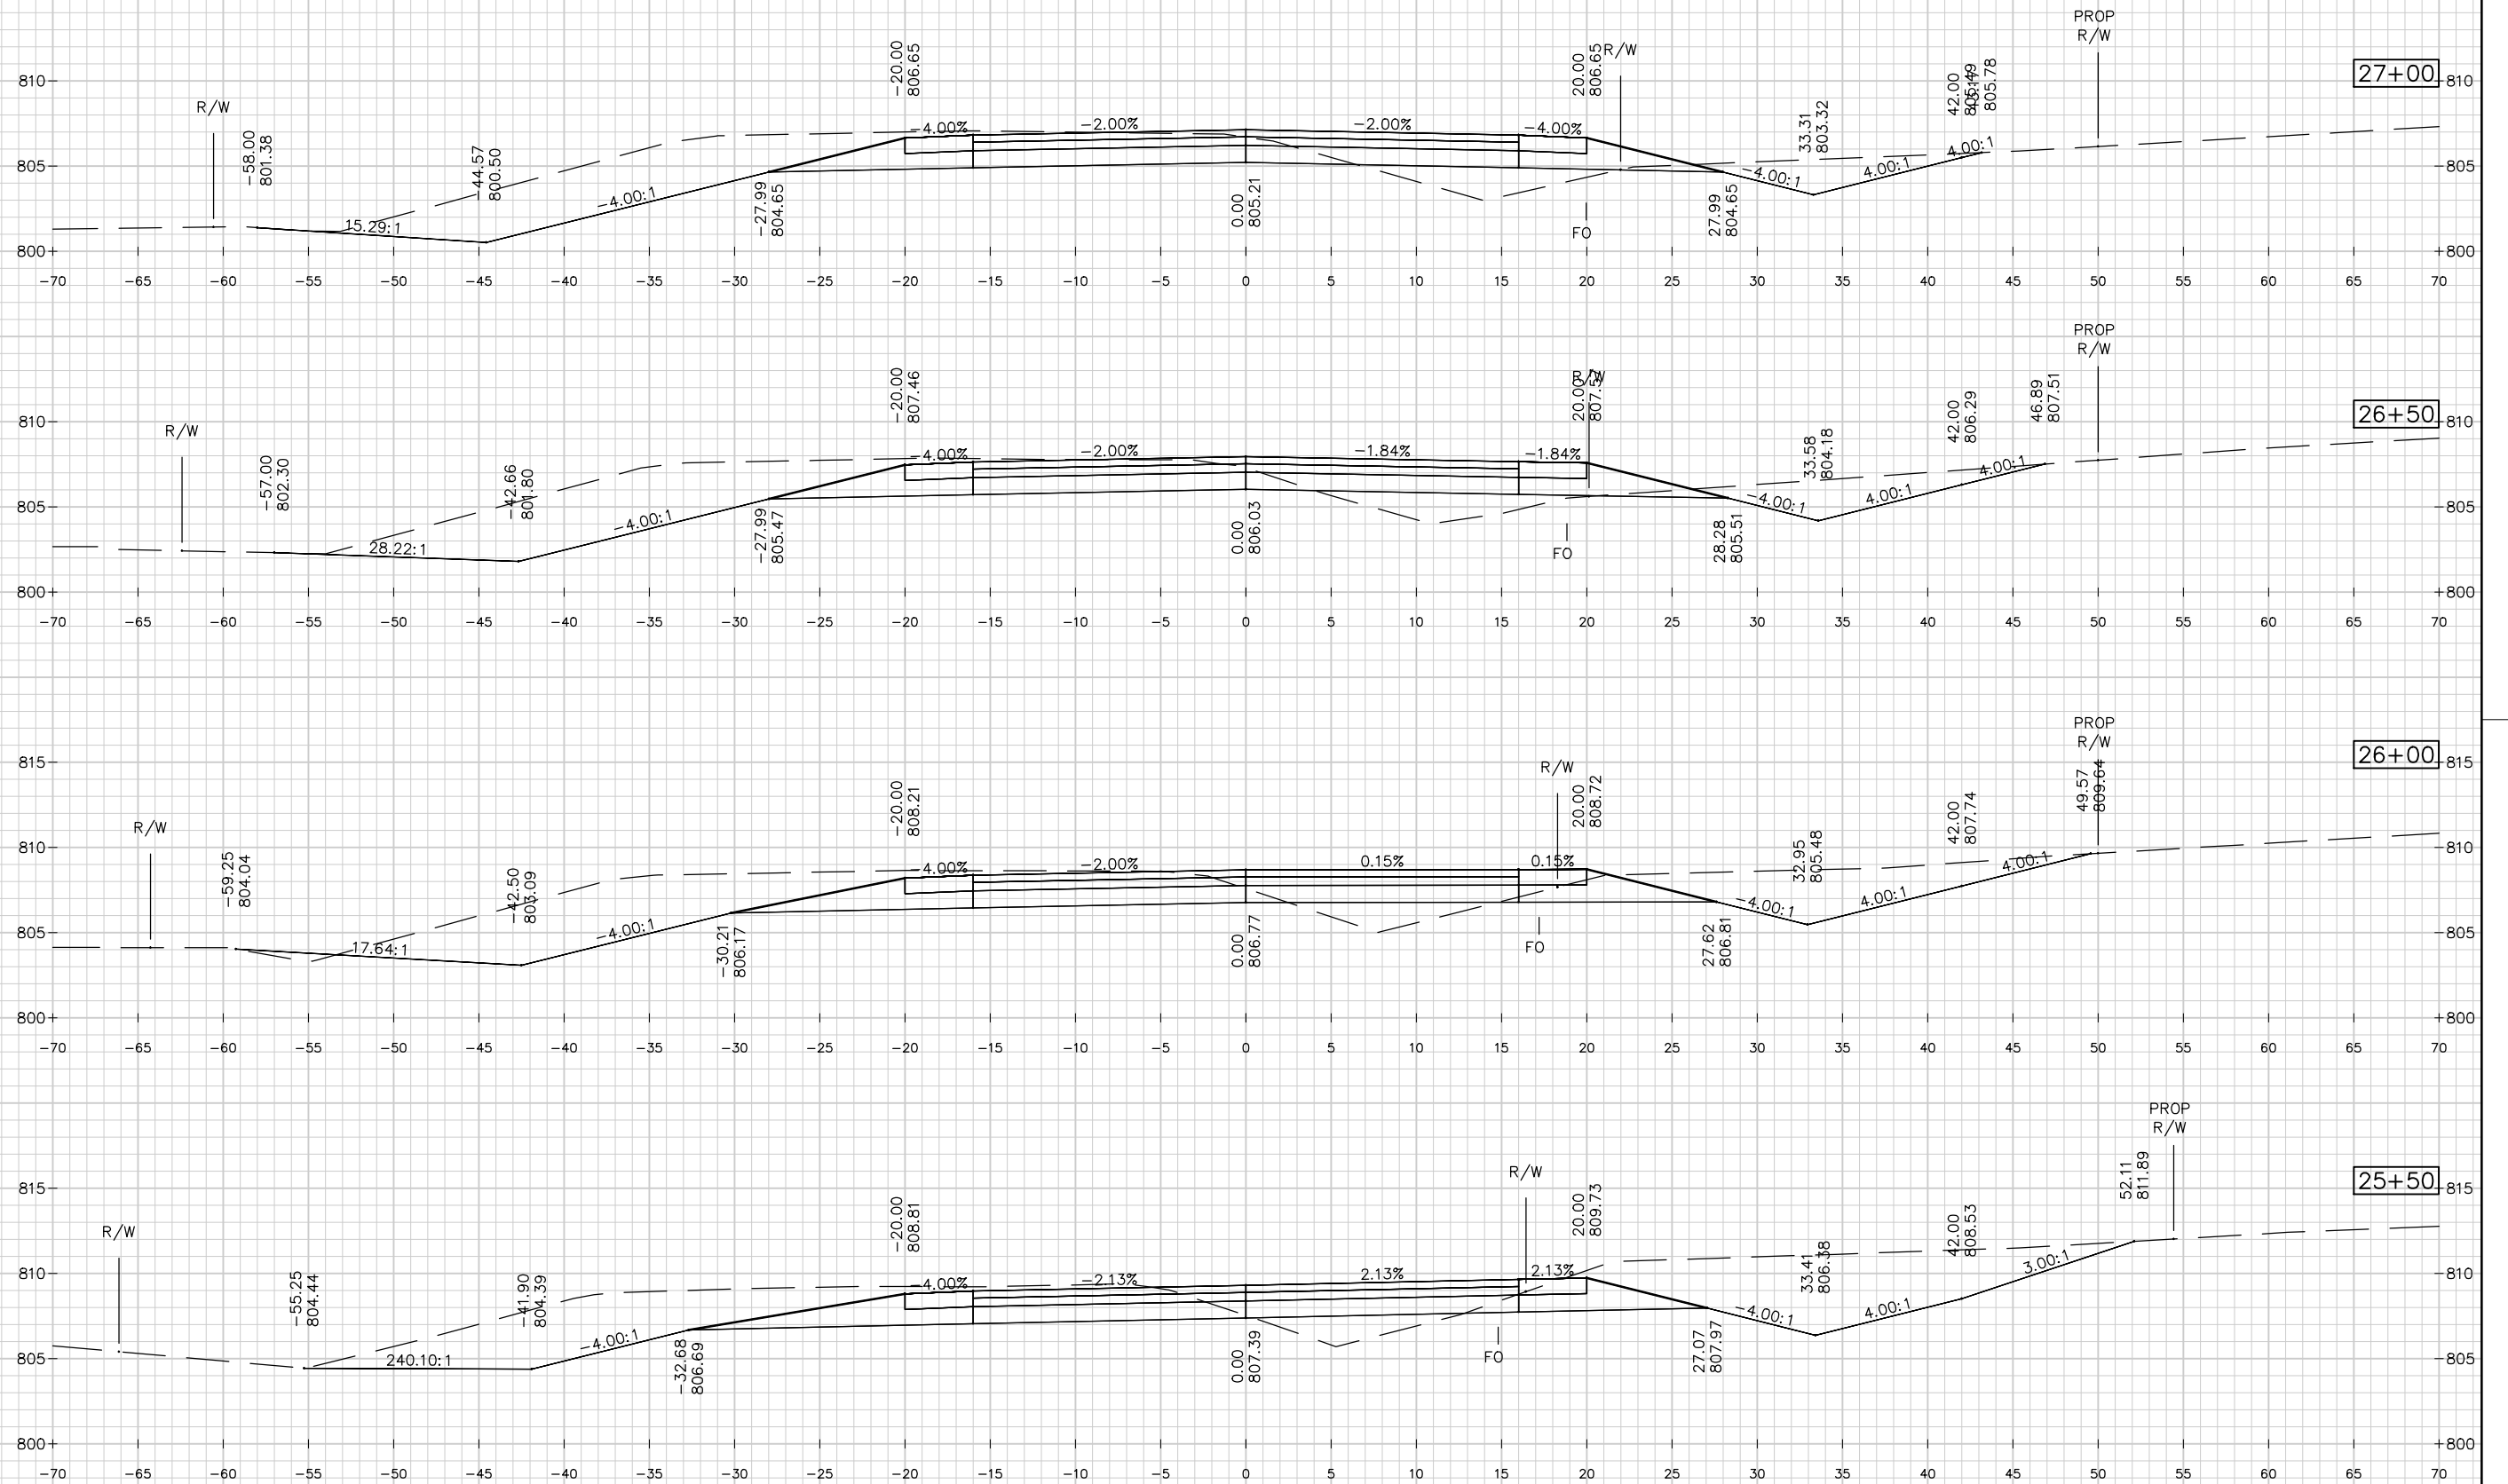

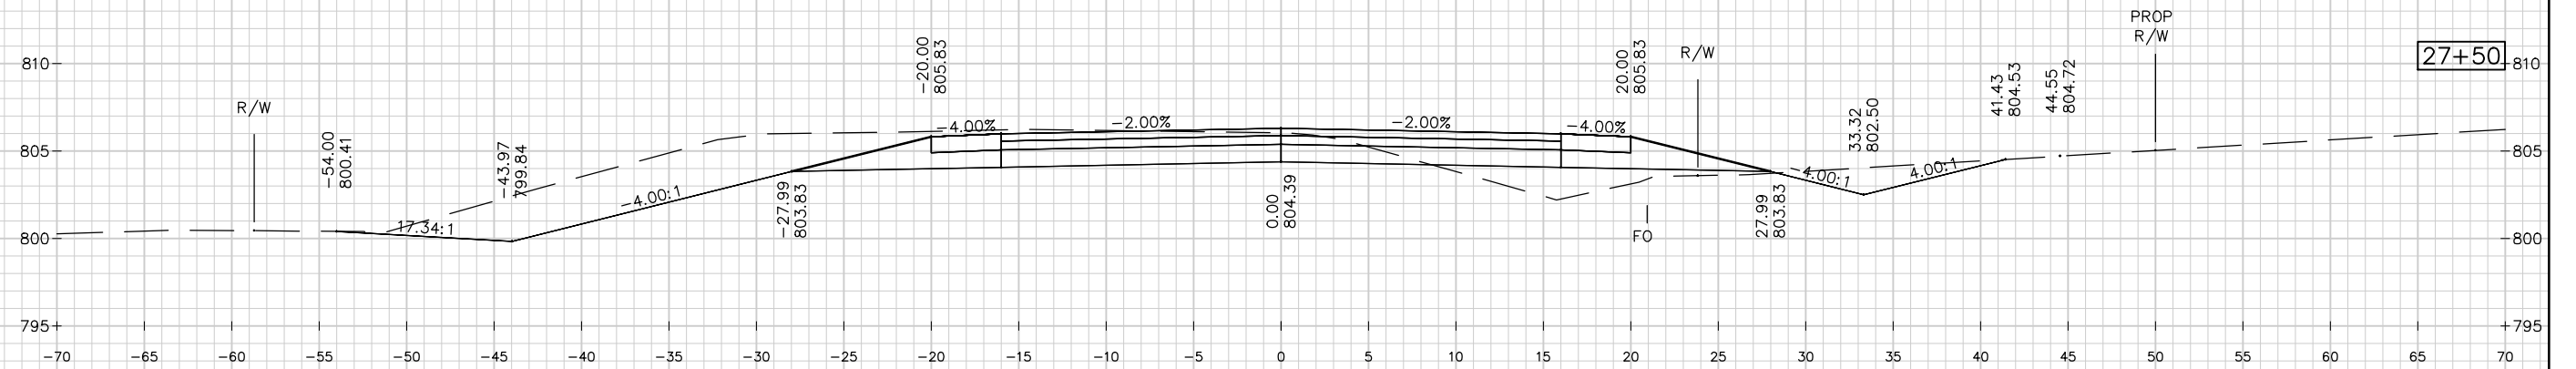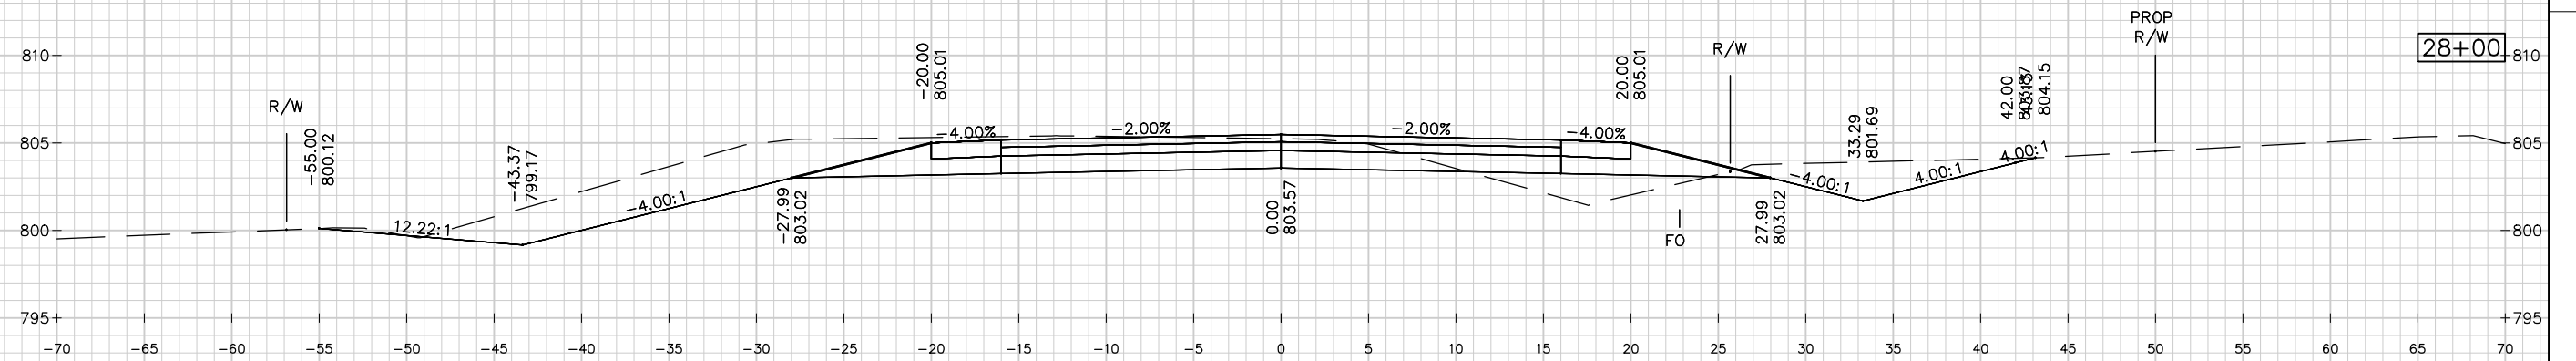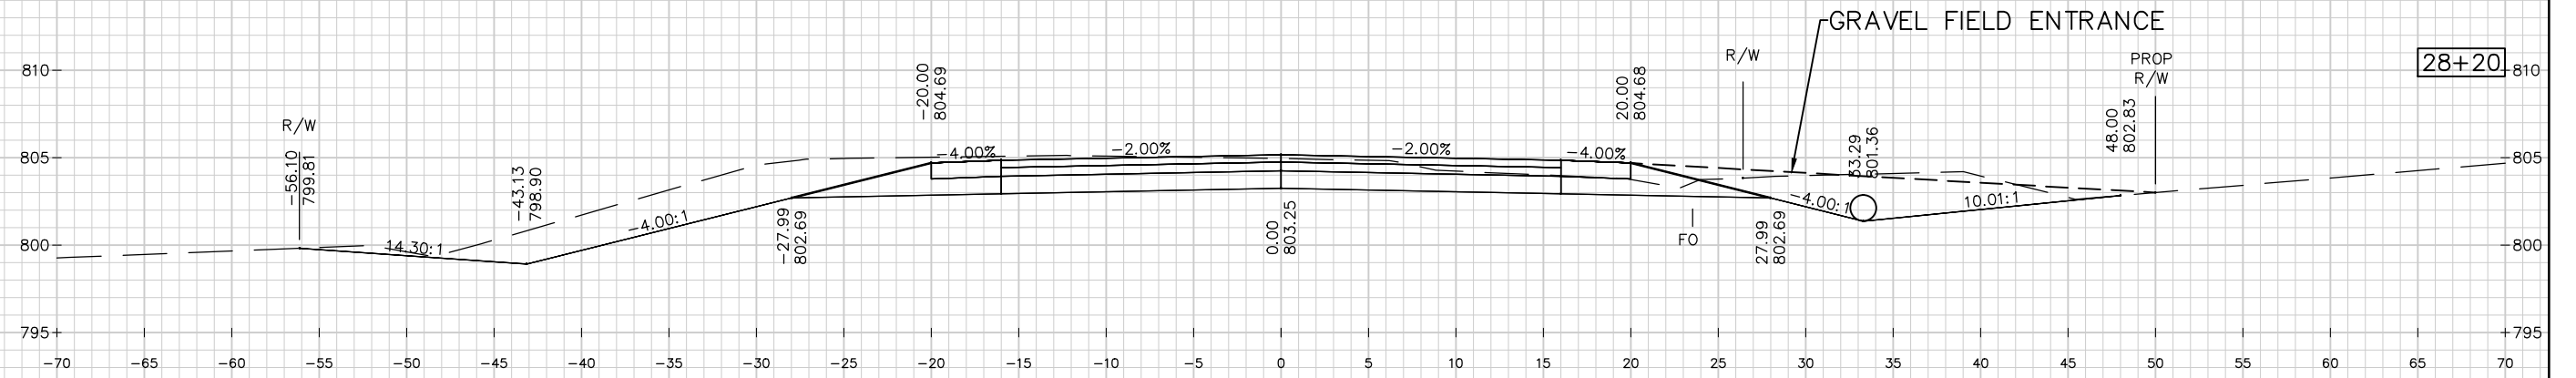

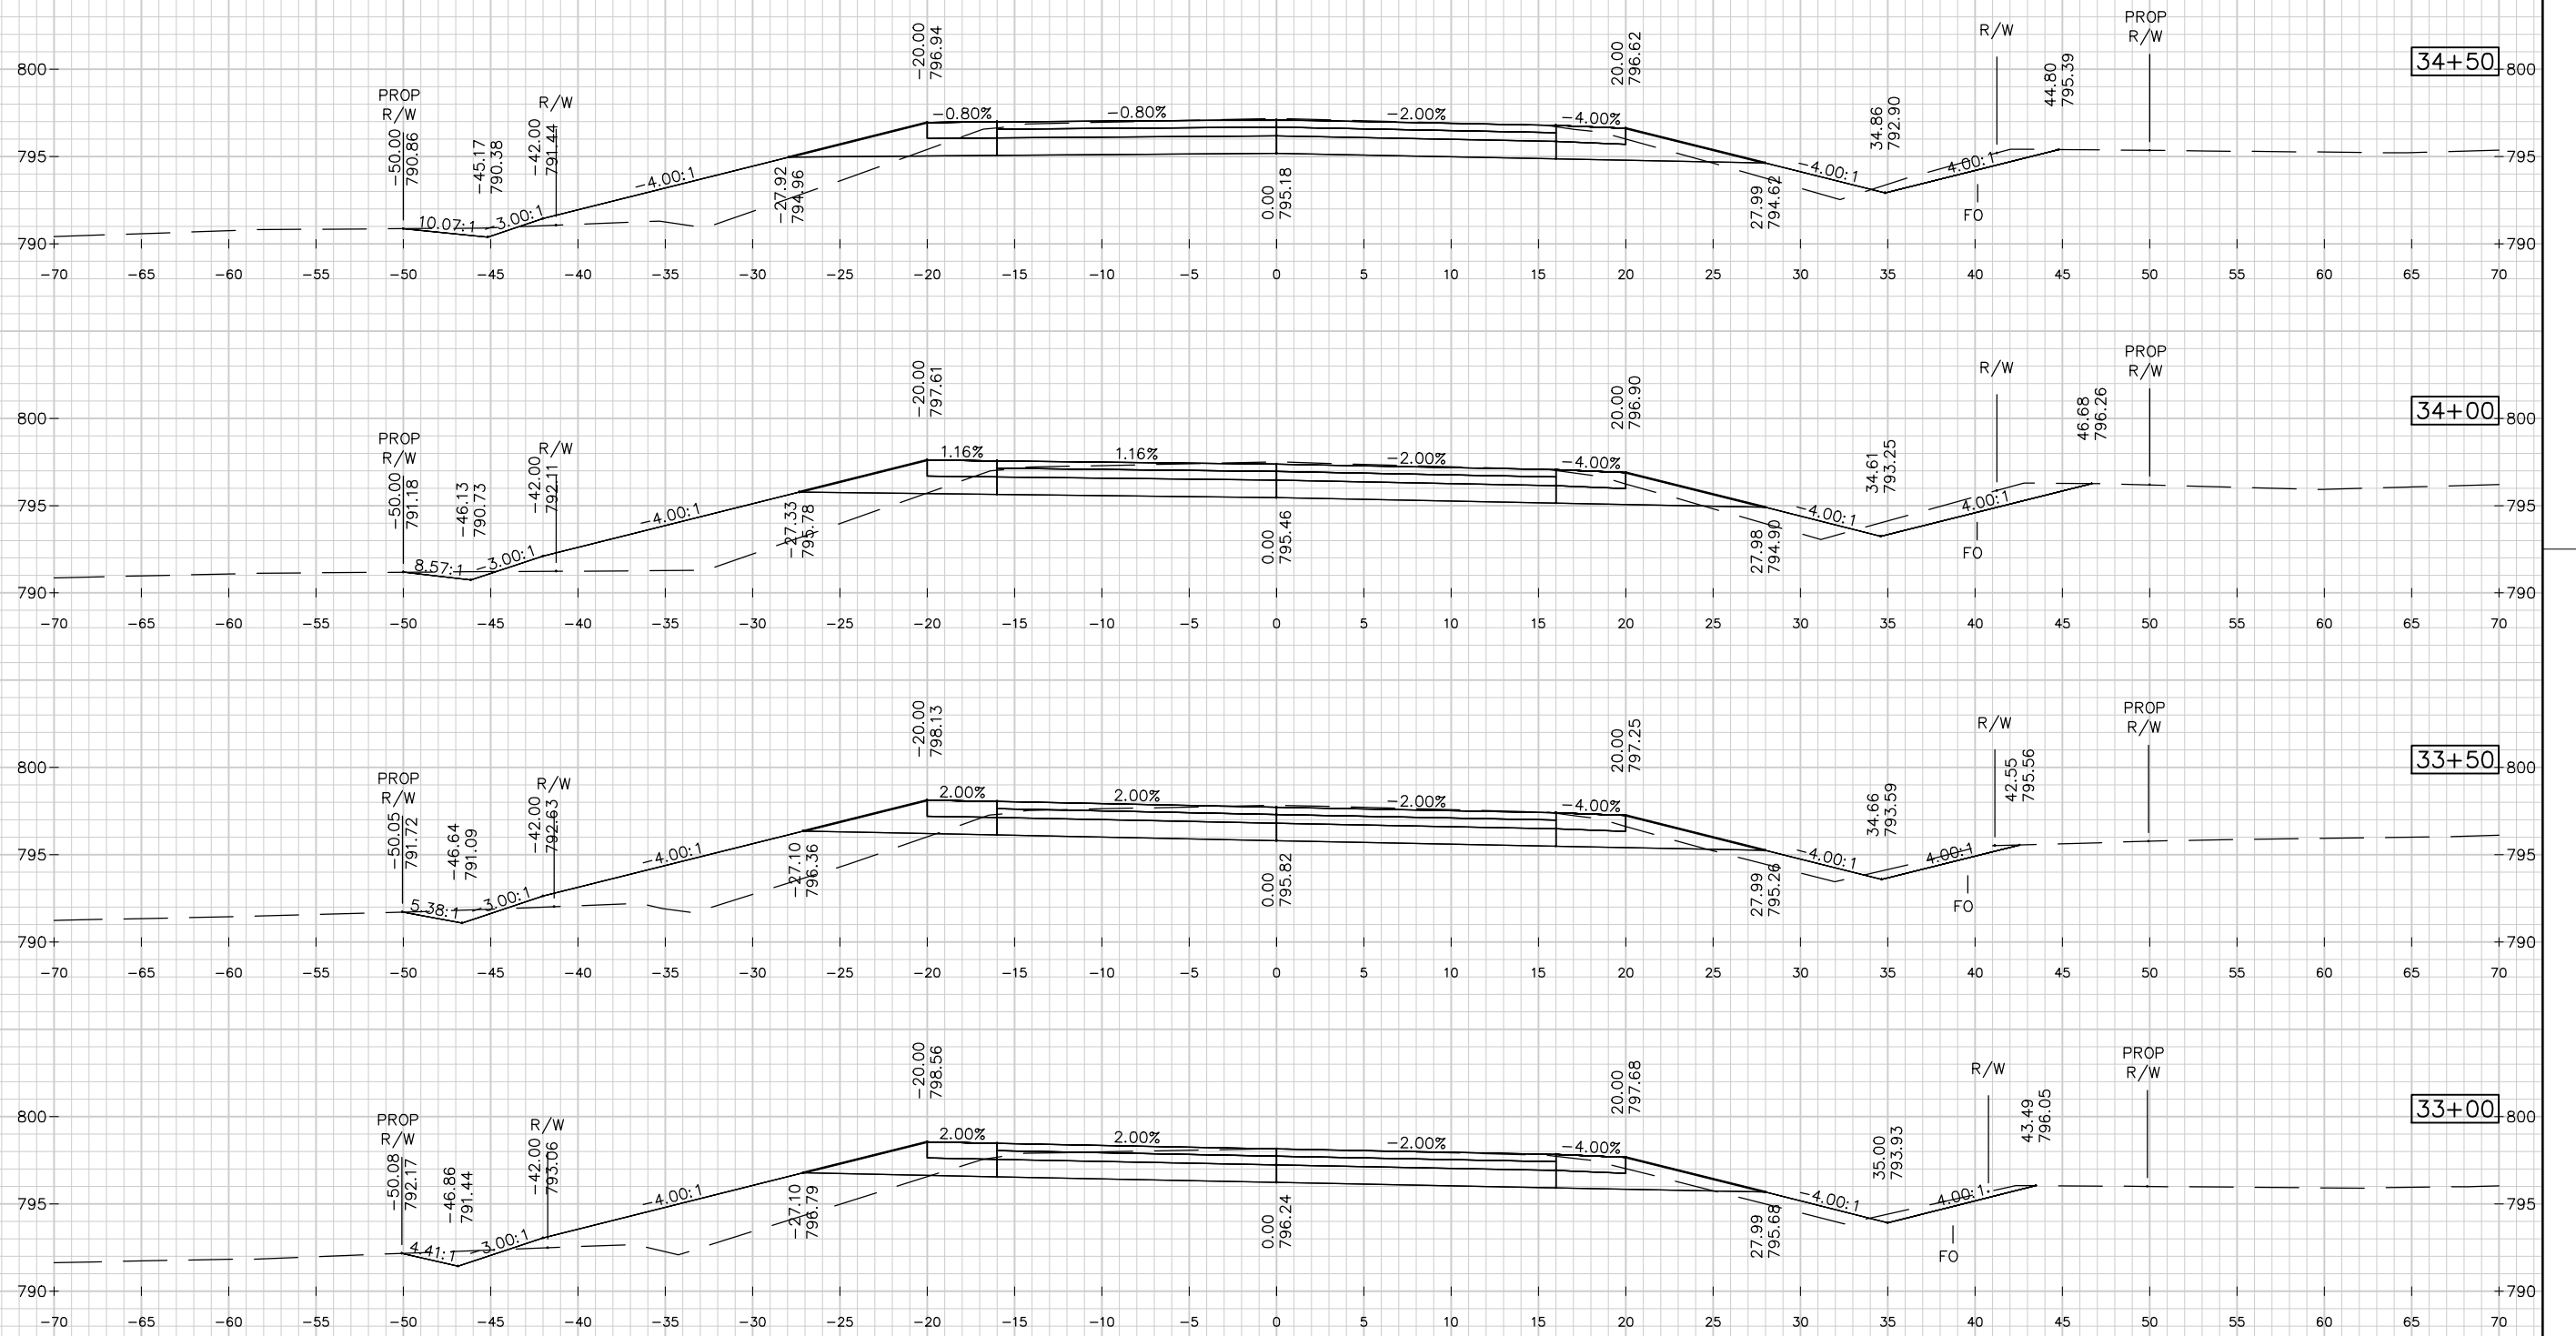

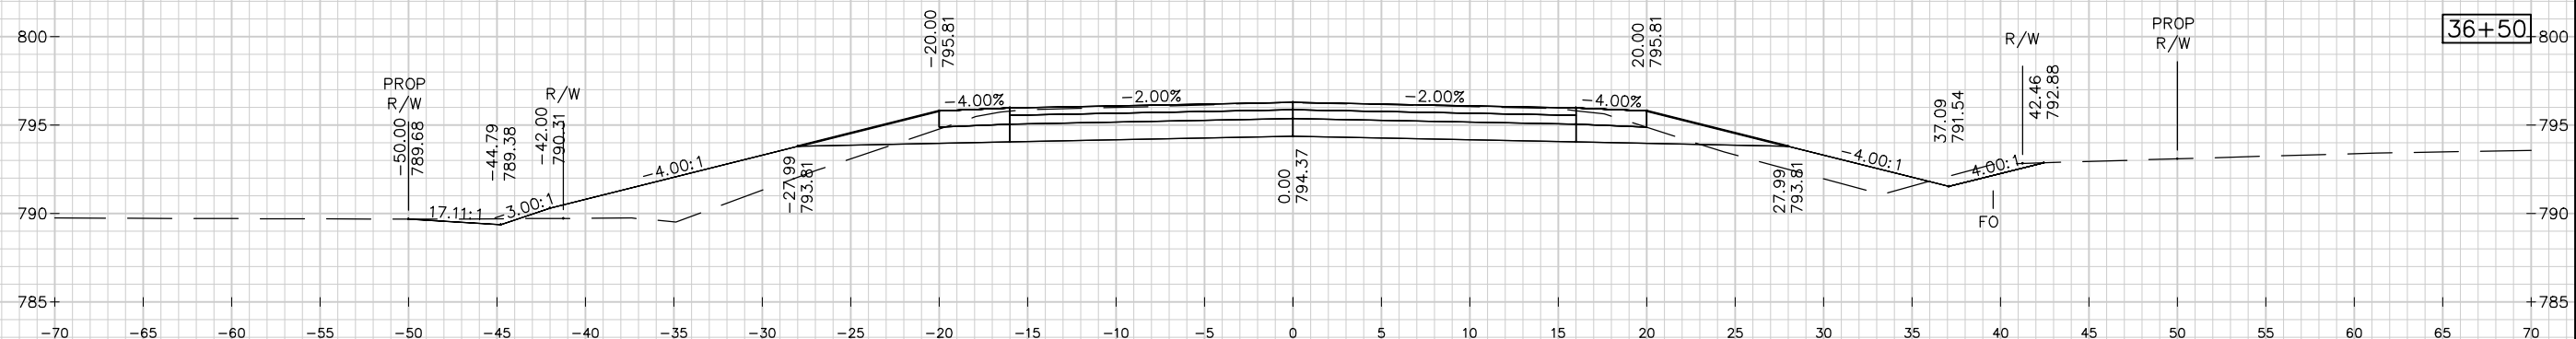

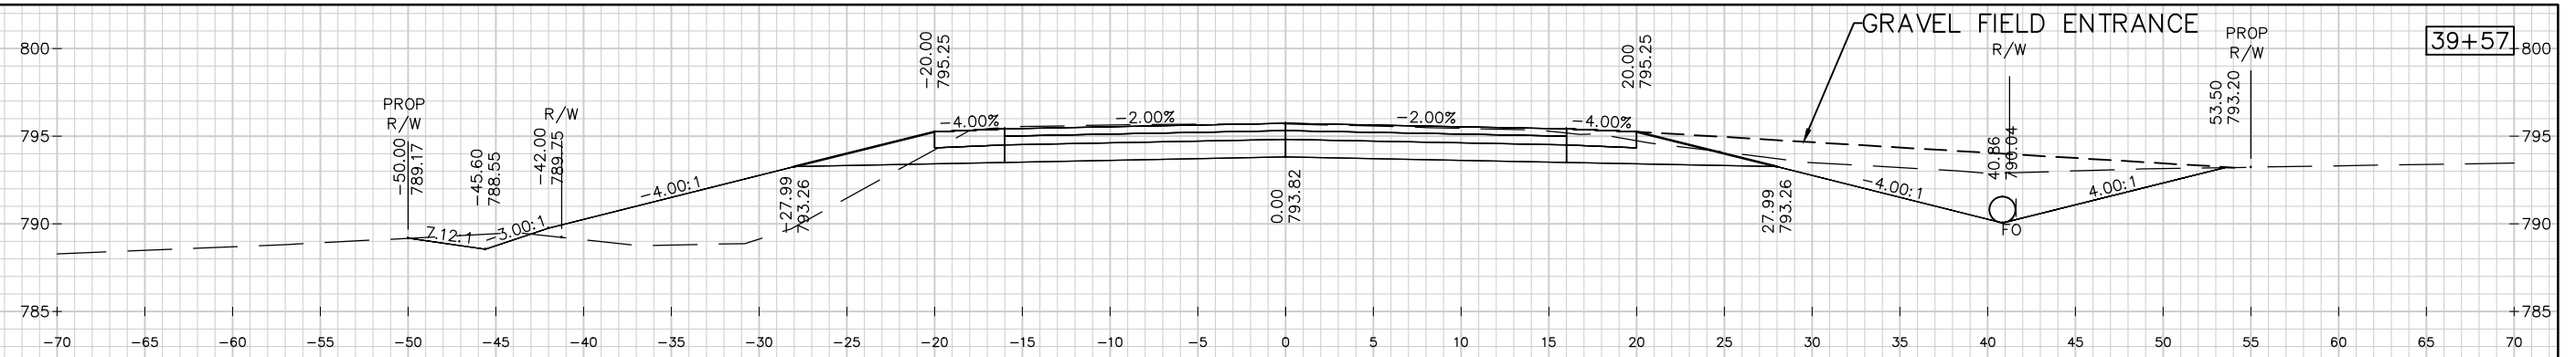



CROSS DRAIN STA. 39+54
ELEV = 789.00




CROSS DRAIN STA. 39+18
ELEV = 789.67





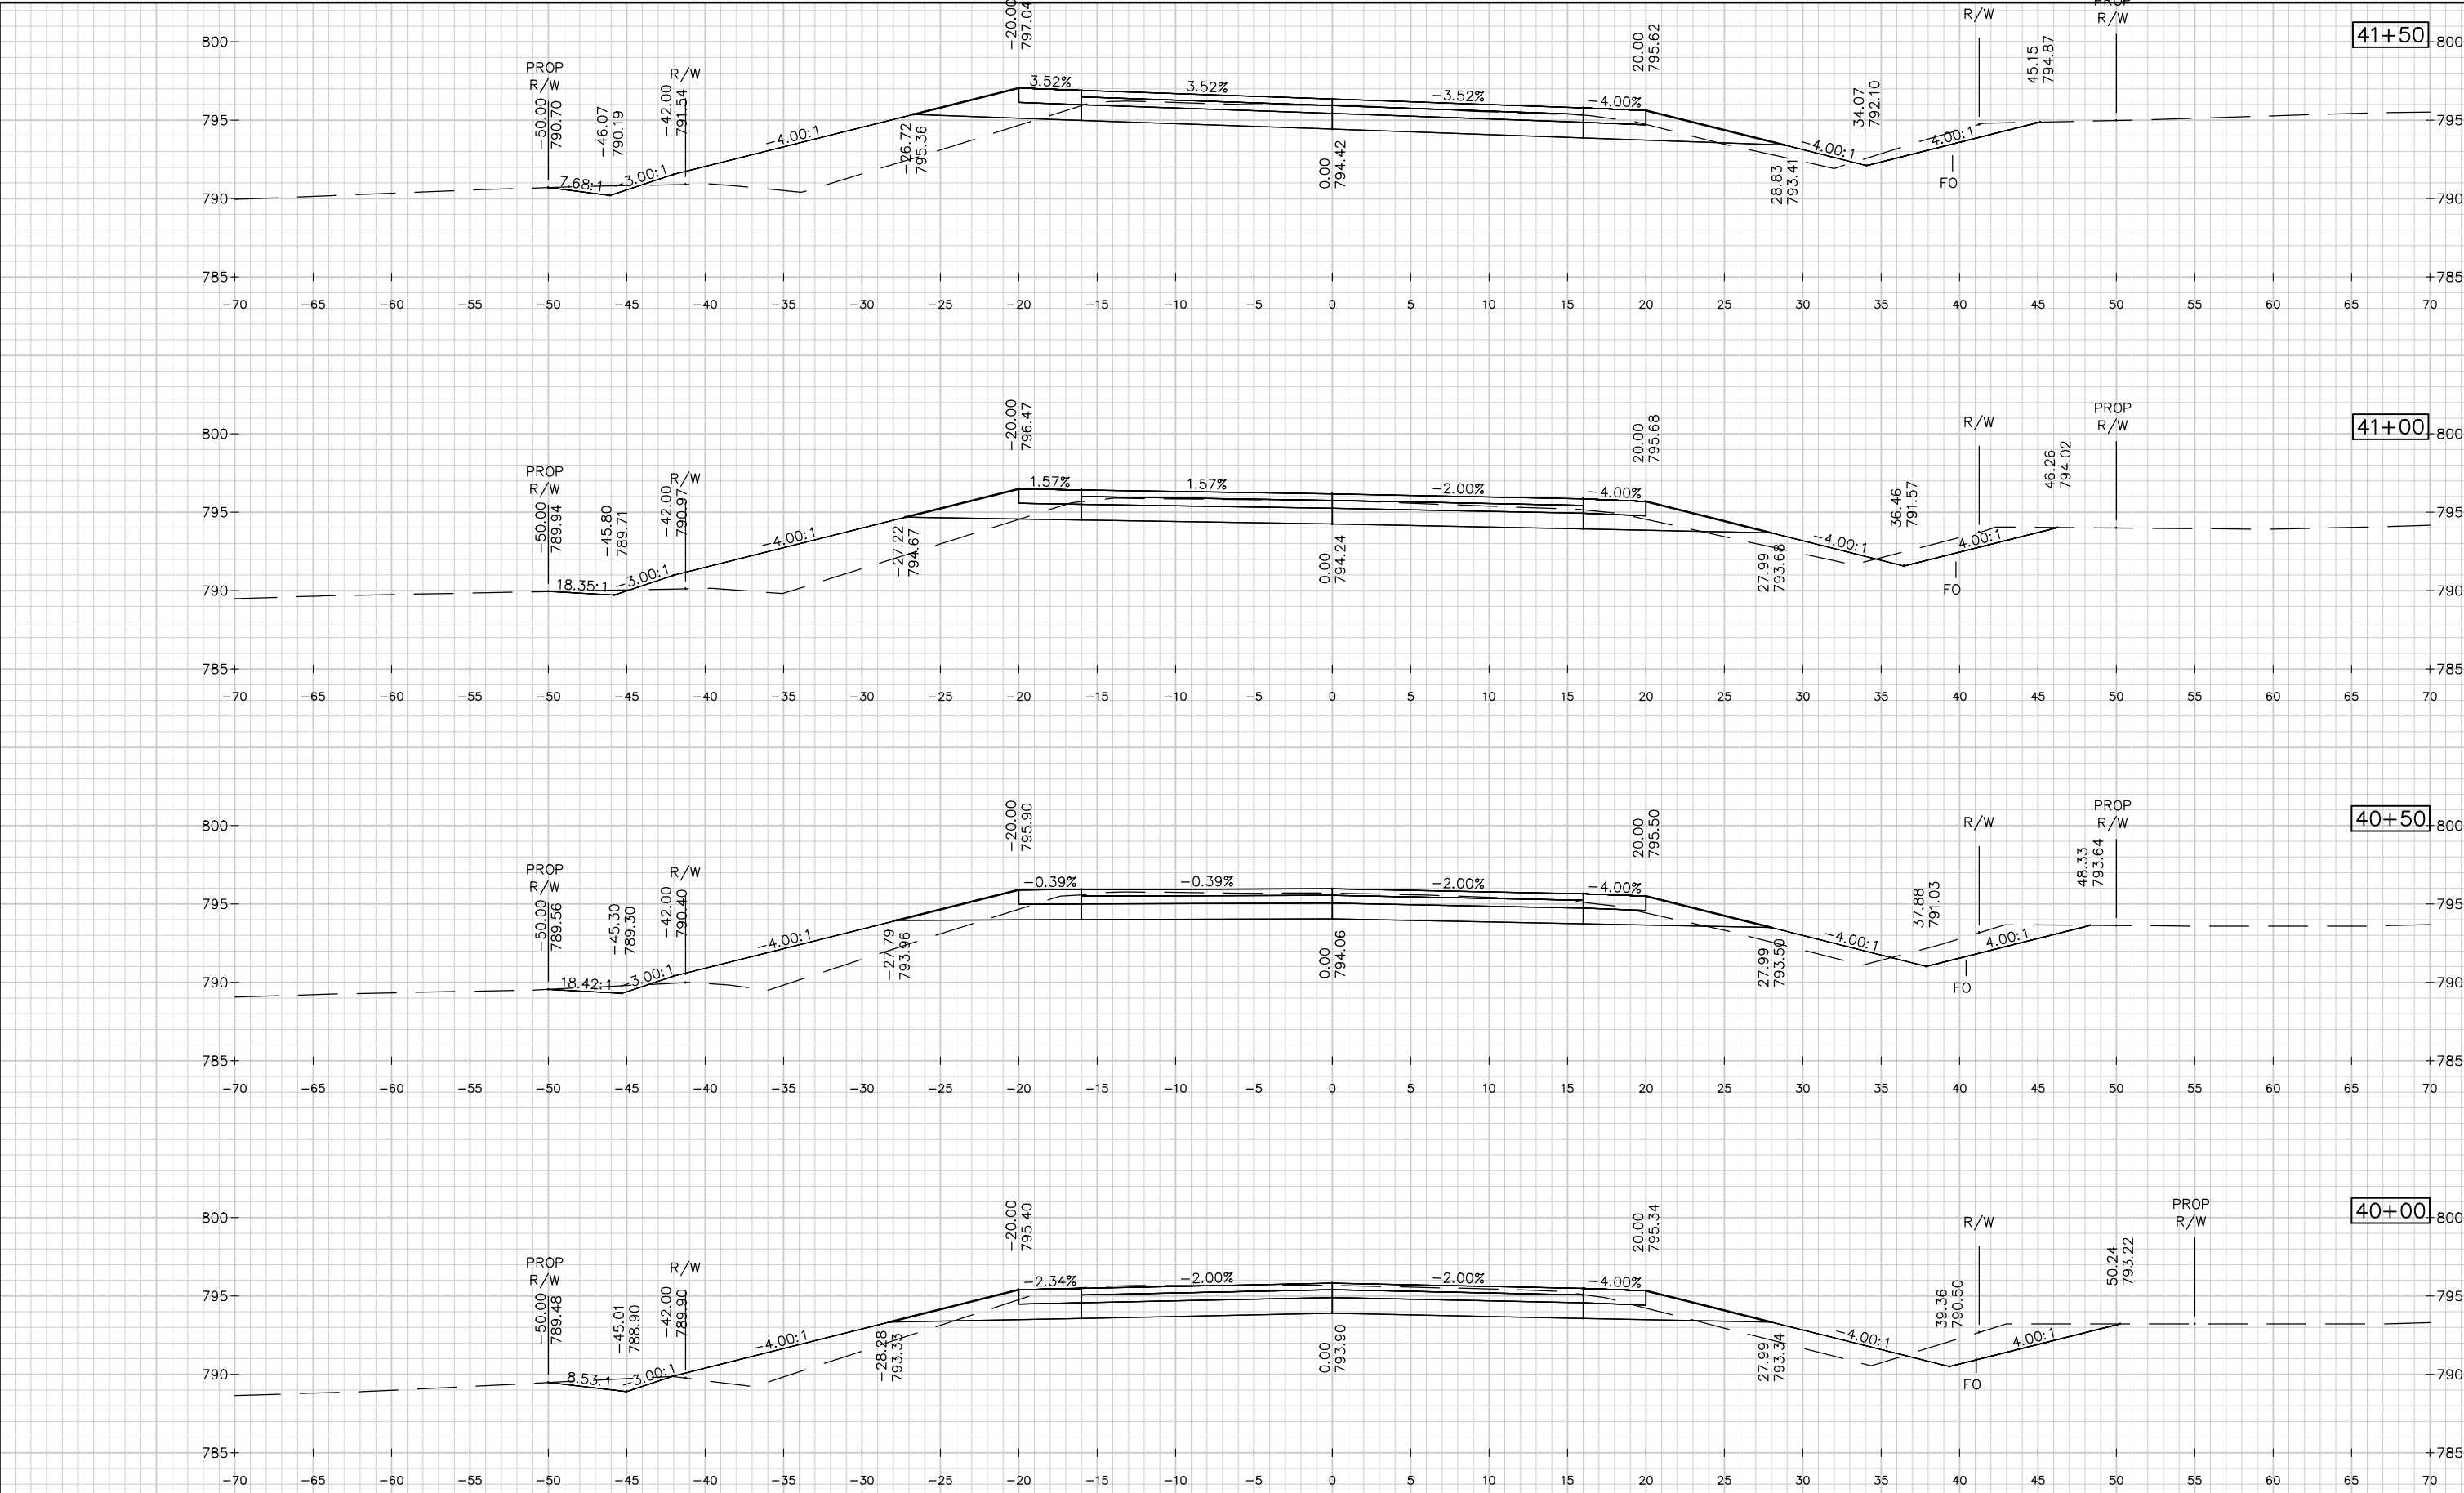


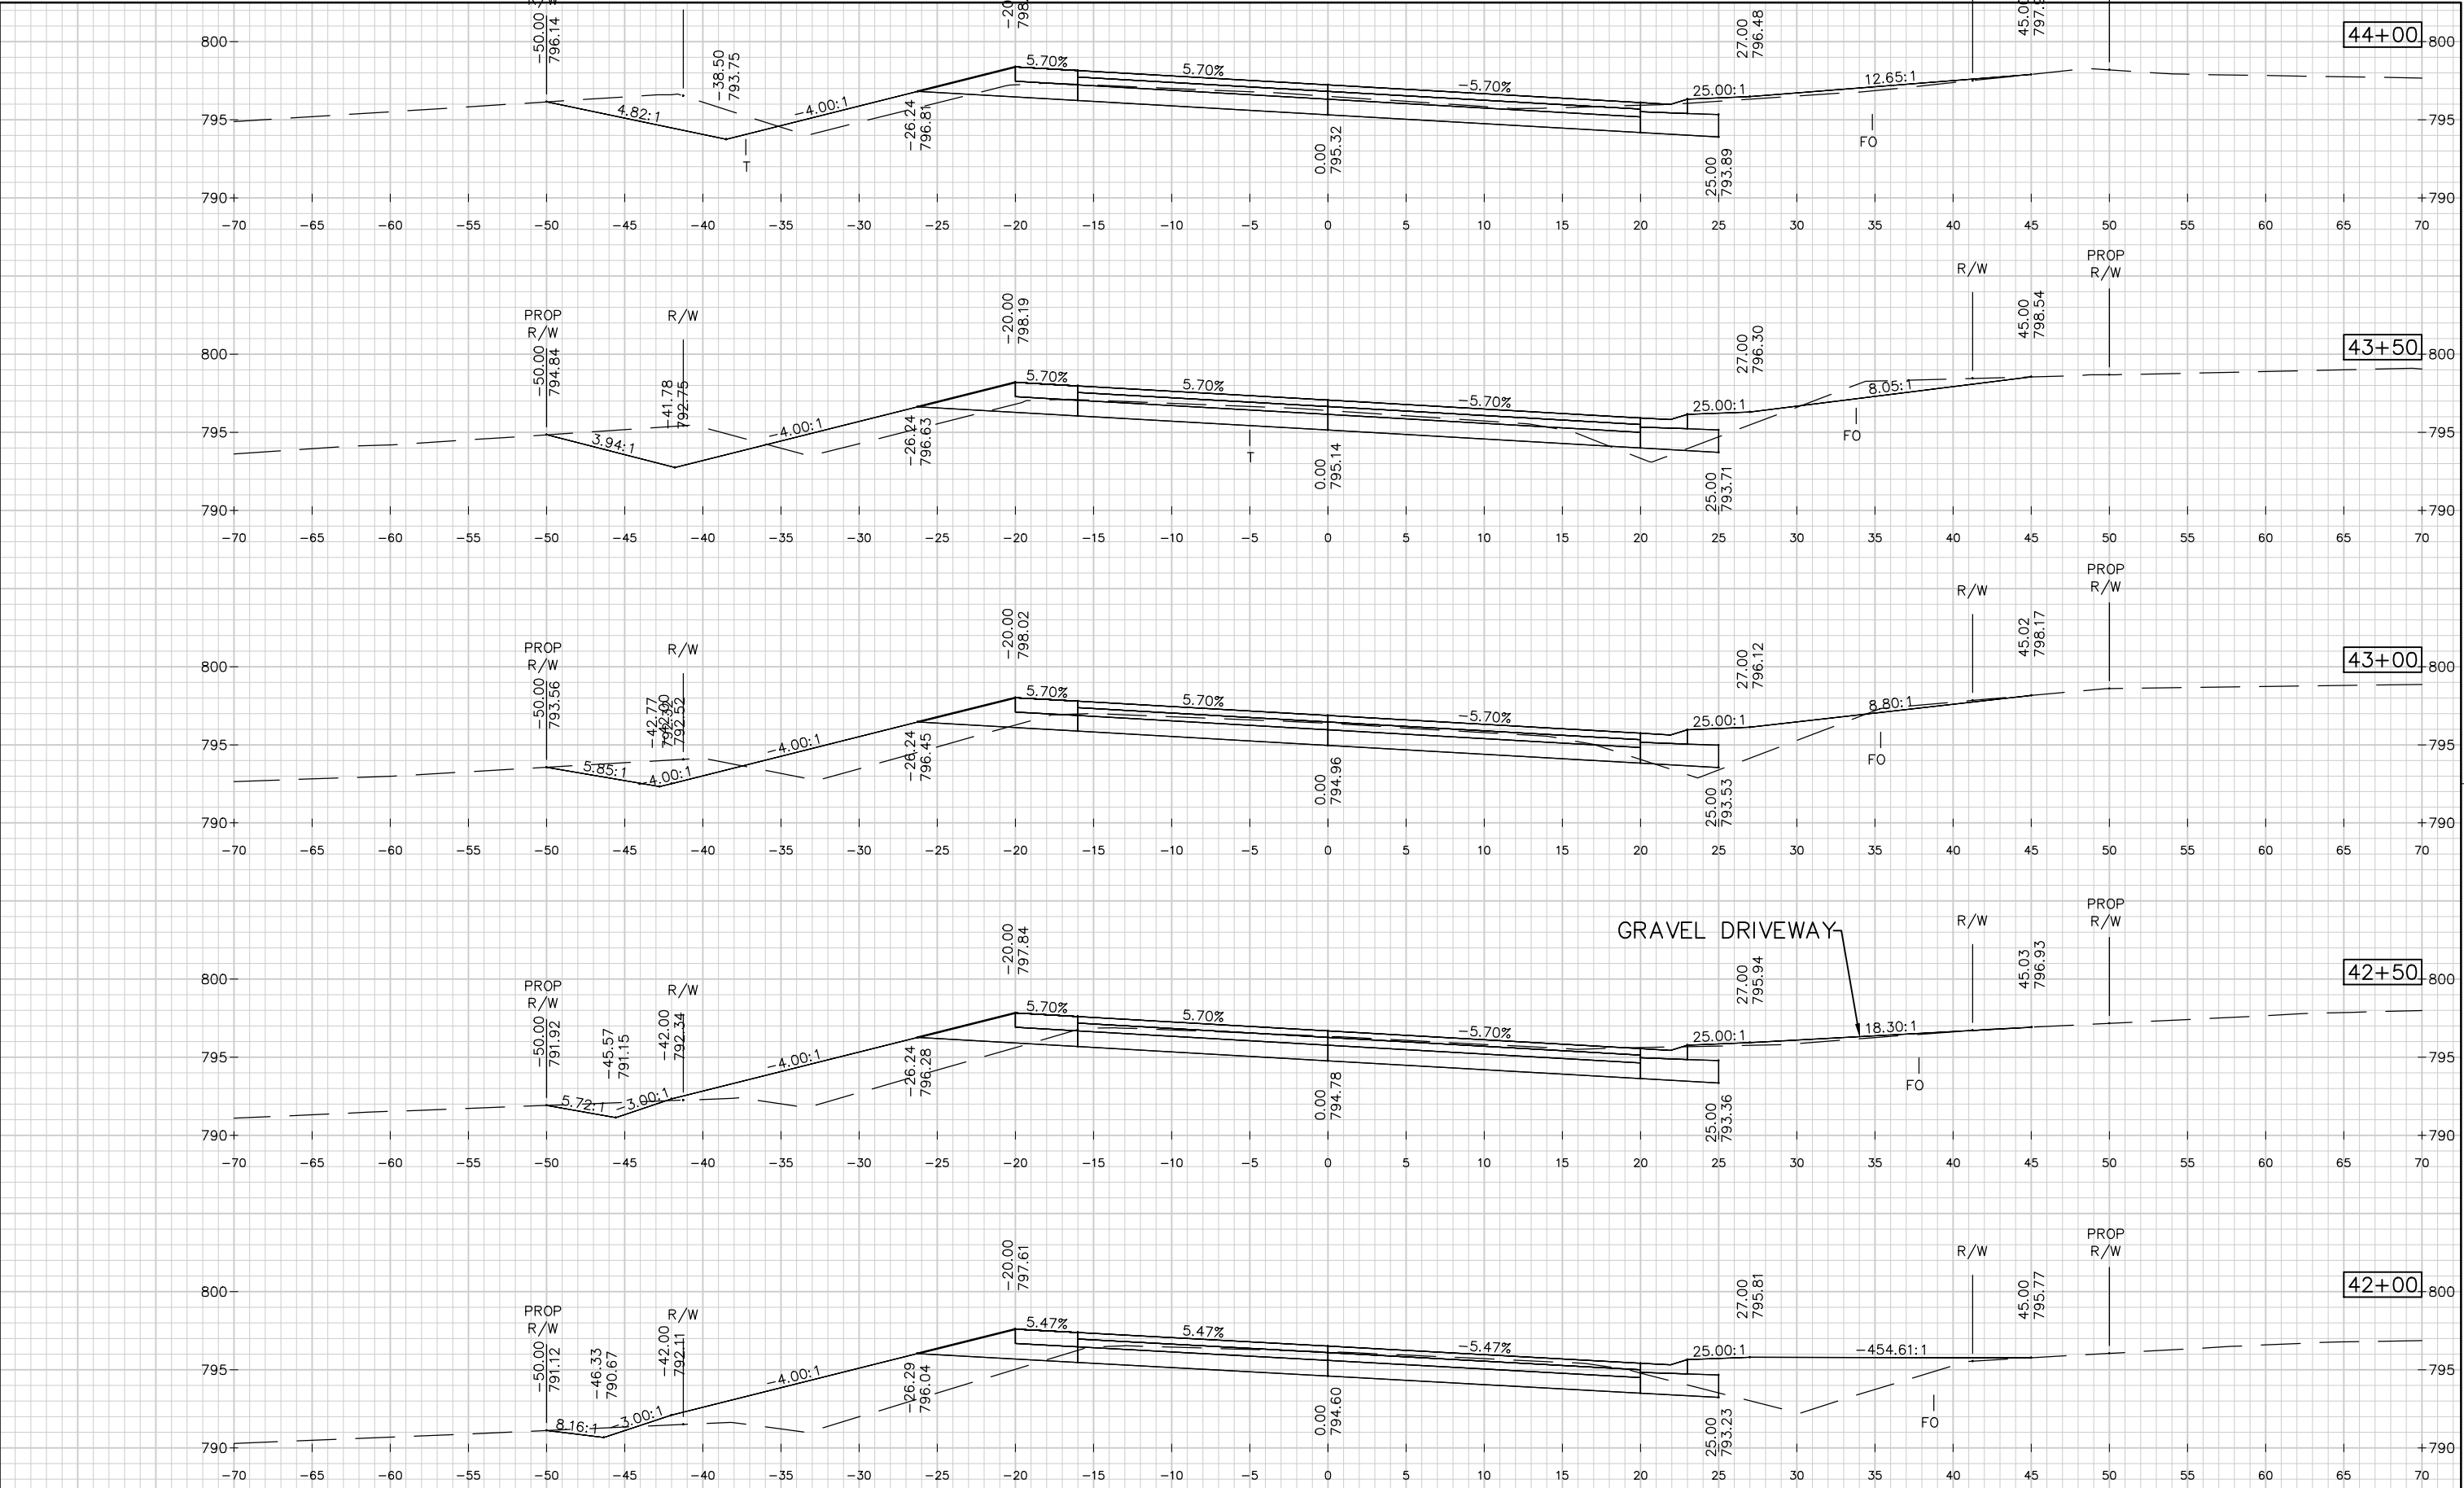



PROJECT NO:	HWY: CTH S	COUNTY: OUTAGAMIE	CROSS SECTIONS	SHEET: 71	E
-------------	------------	-------------------	----------------	-----------	----------


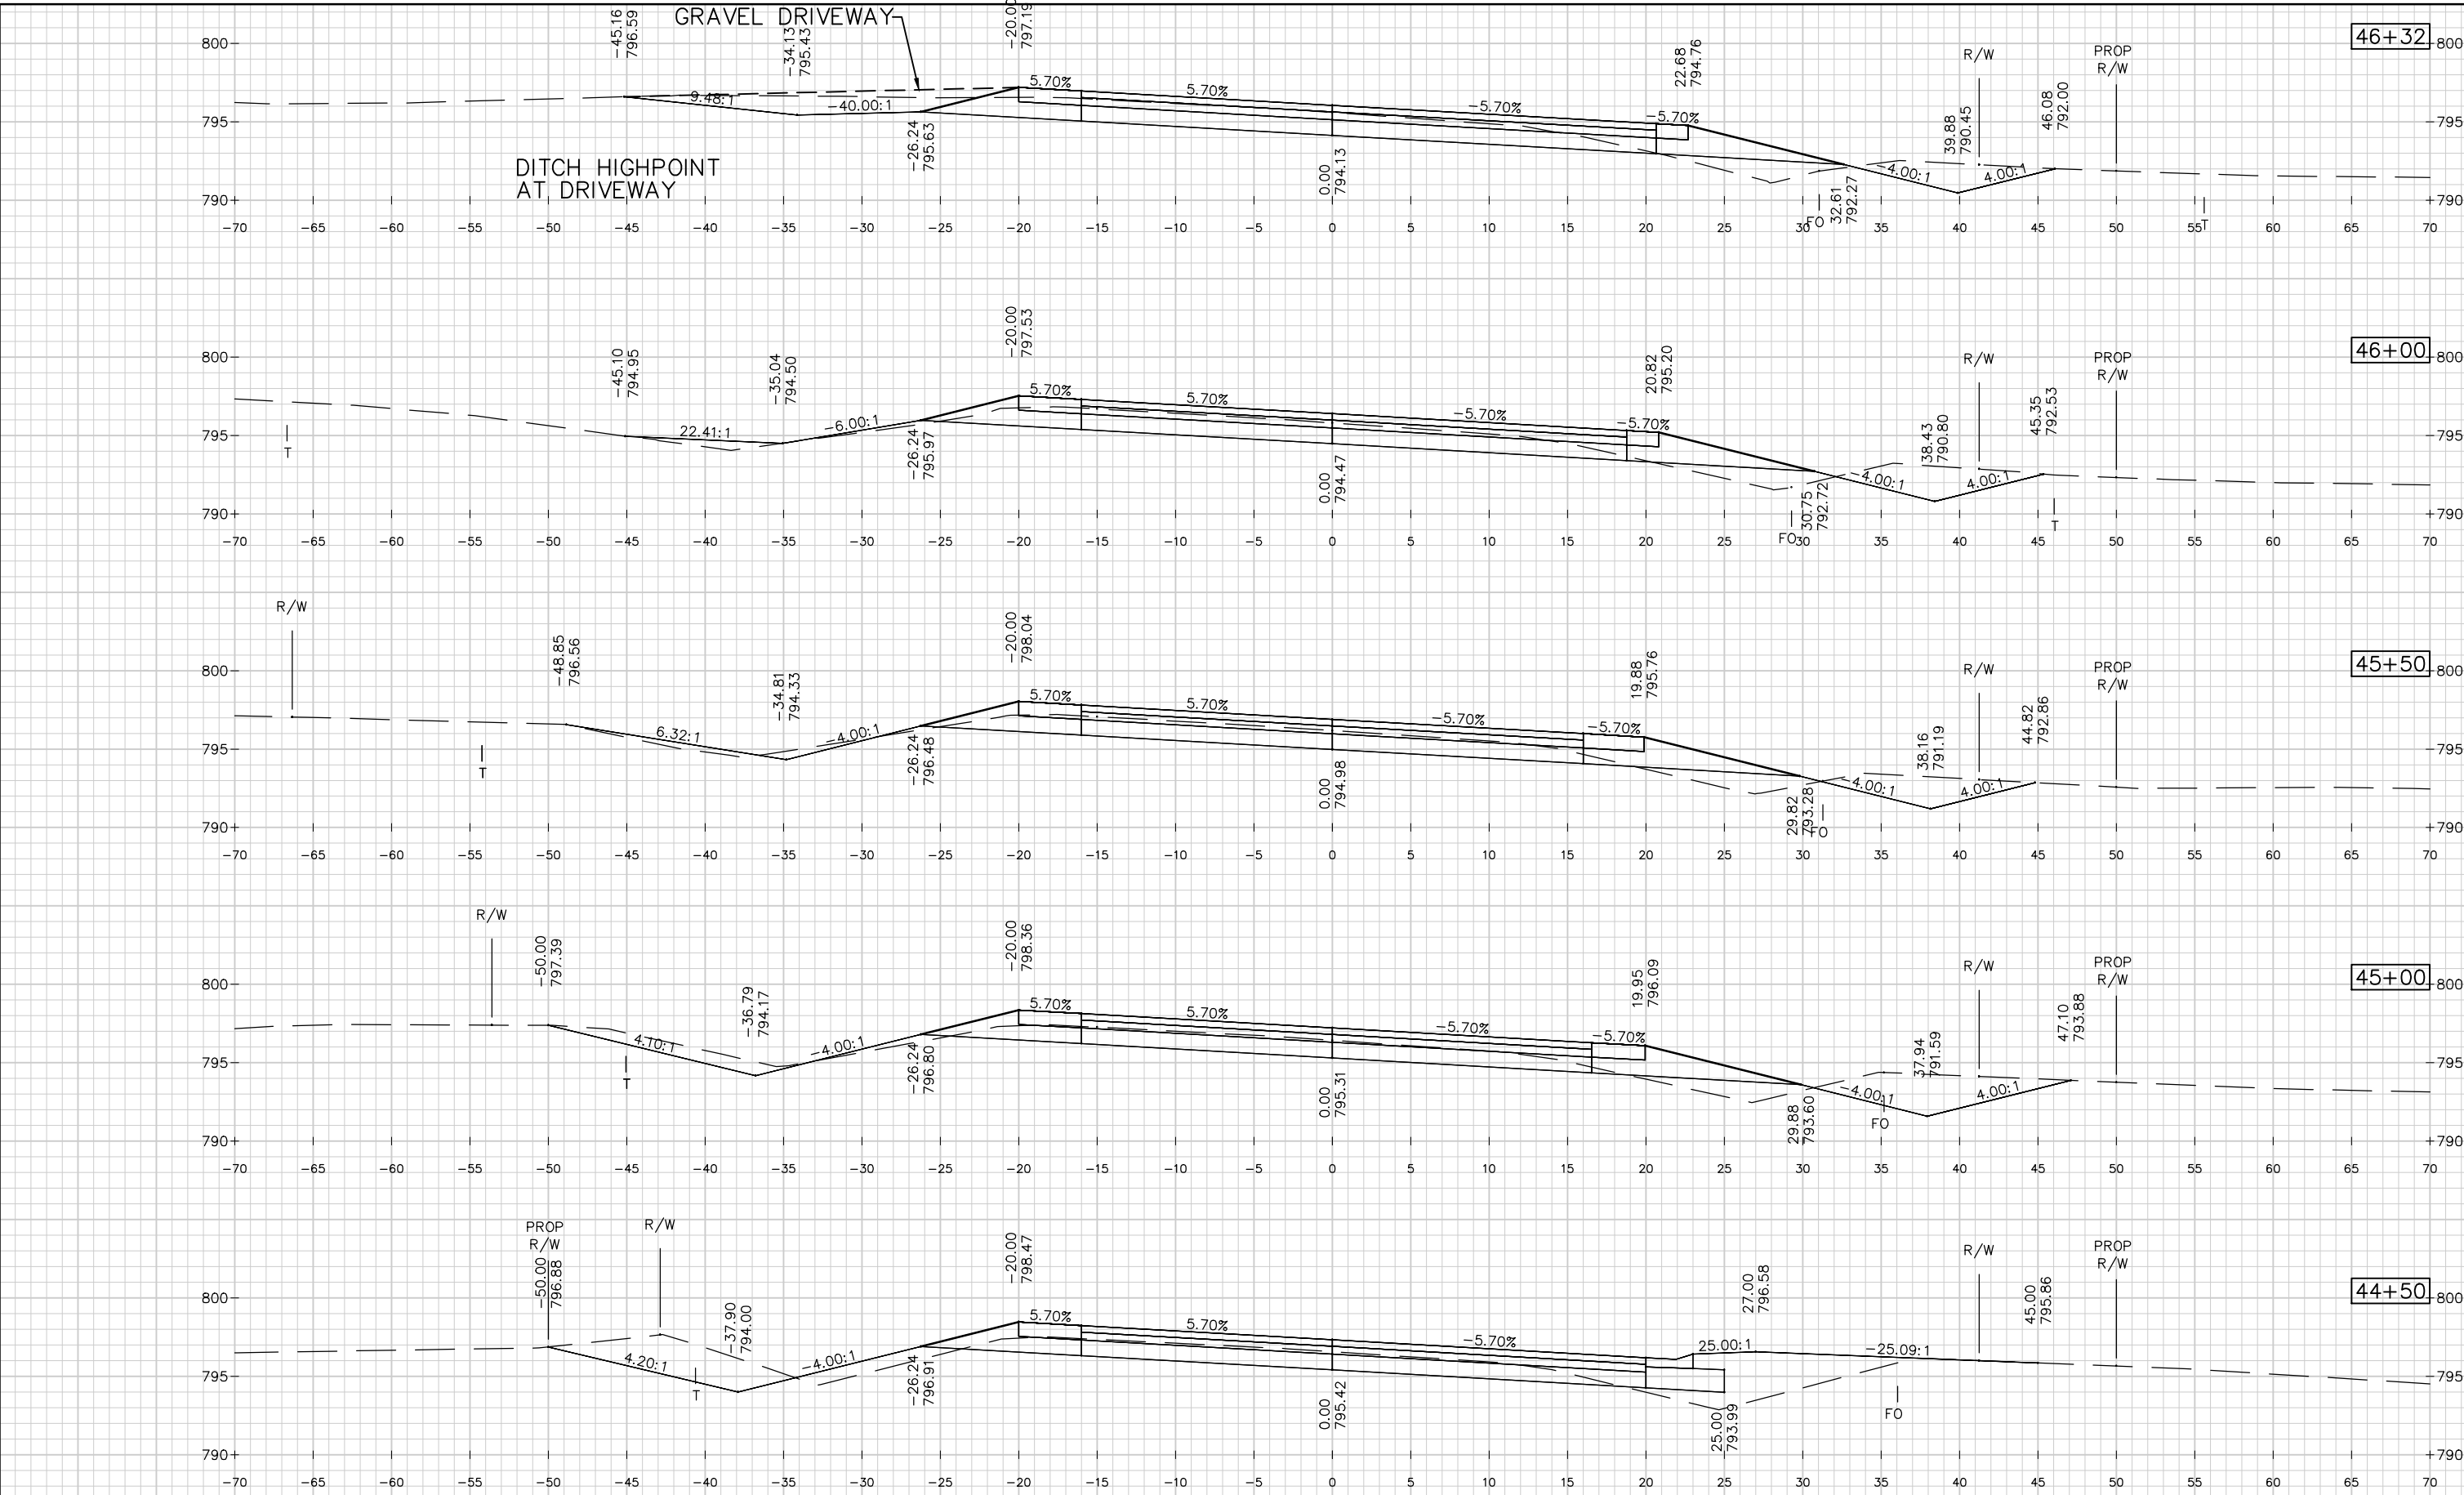


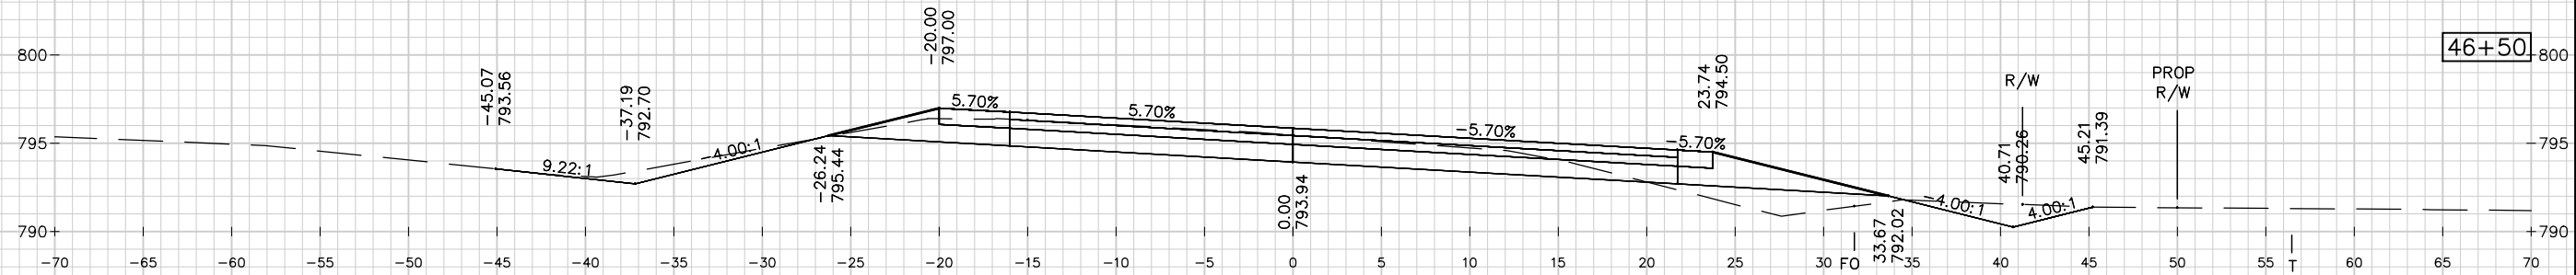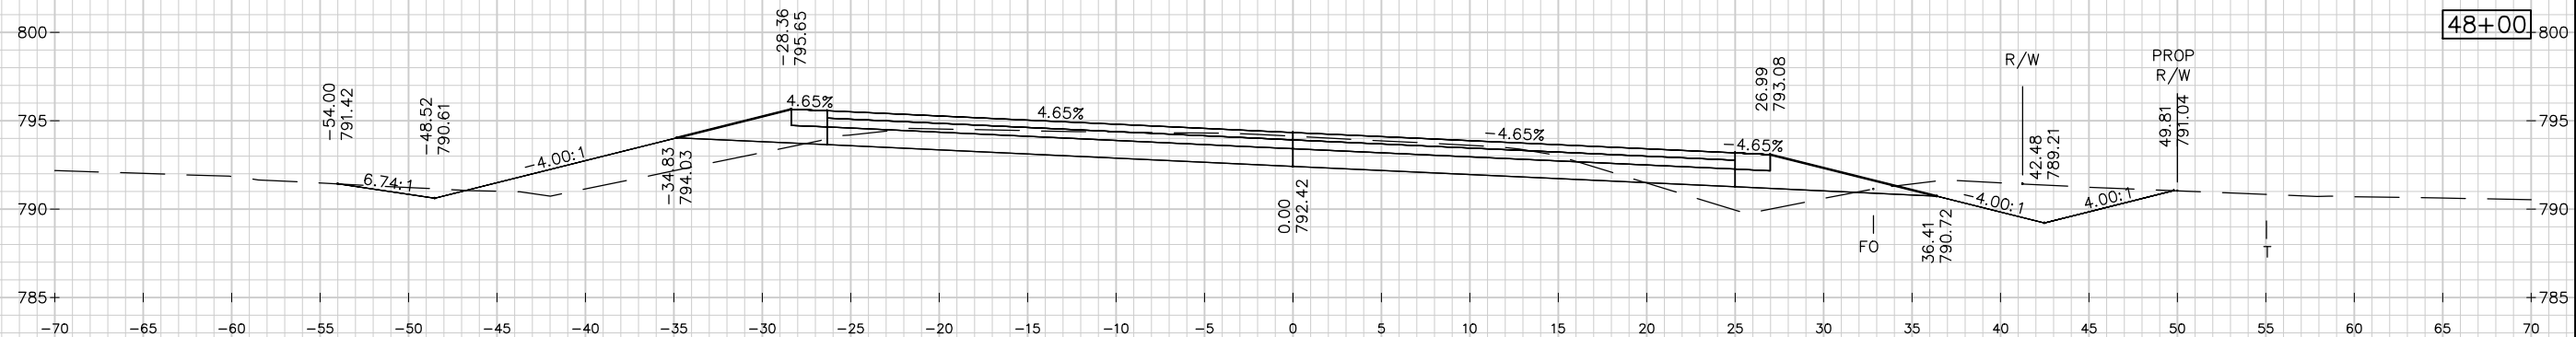



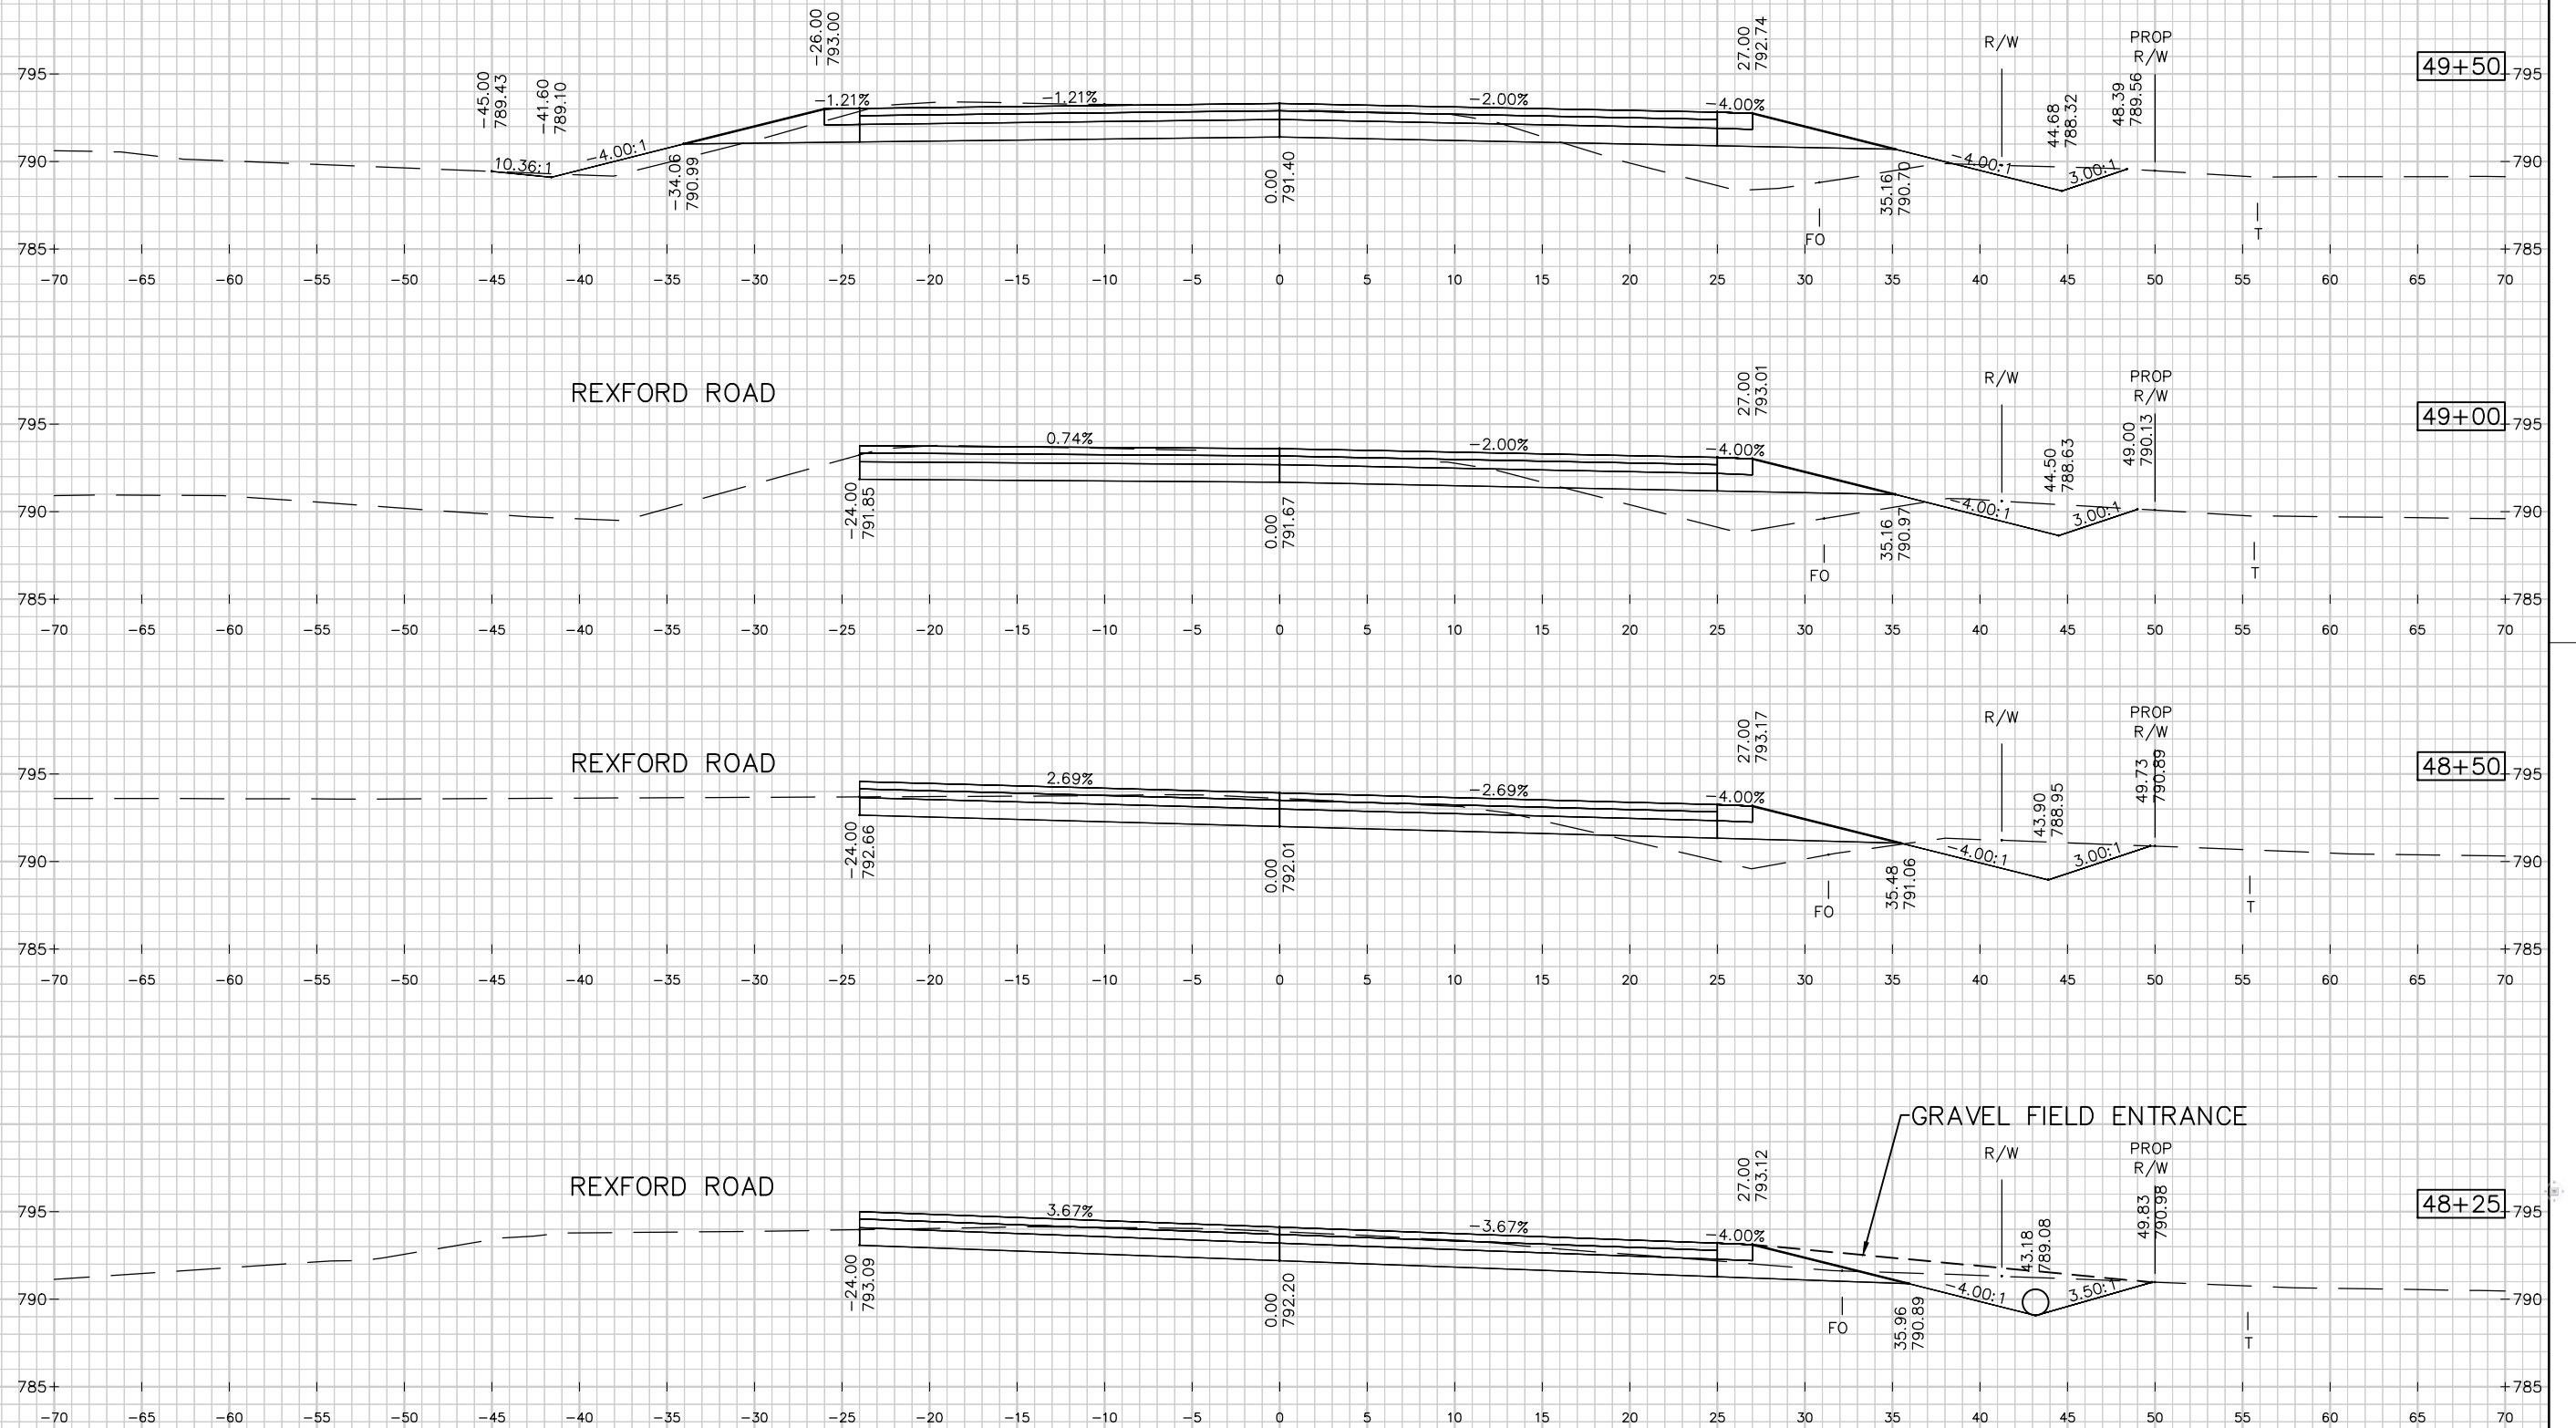


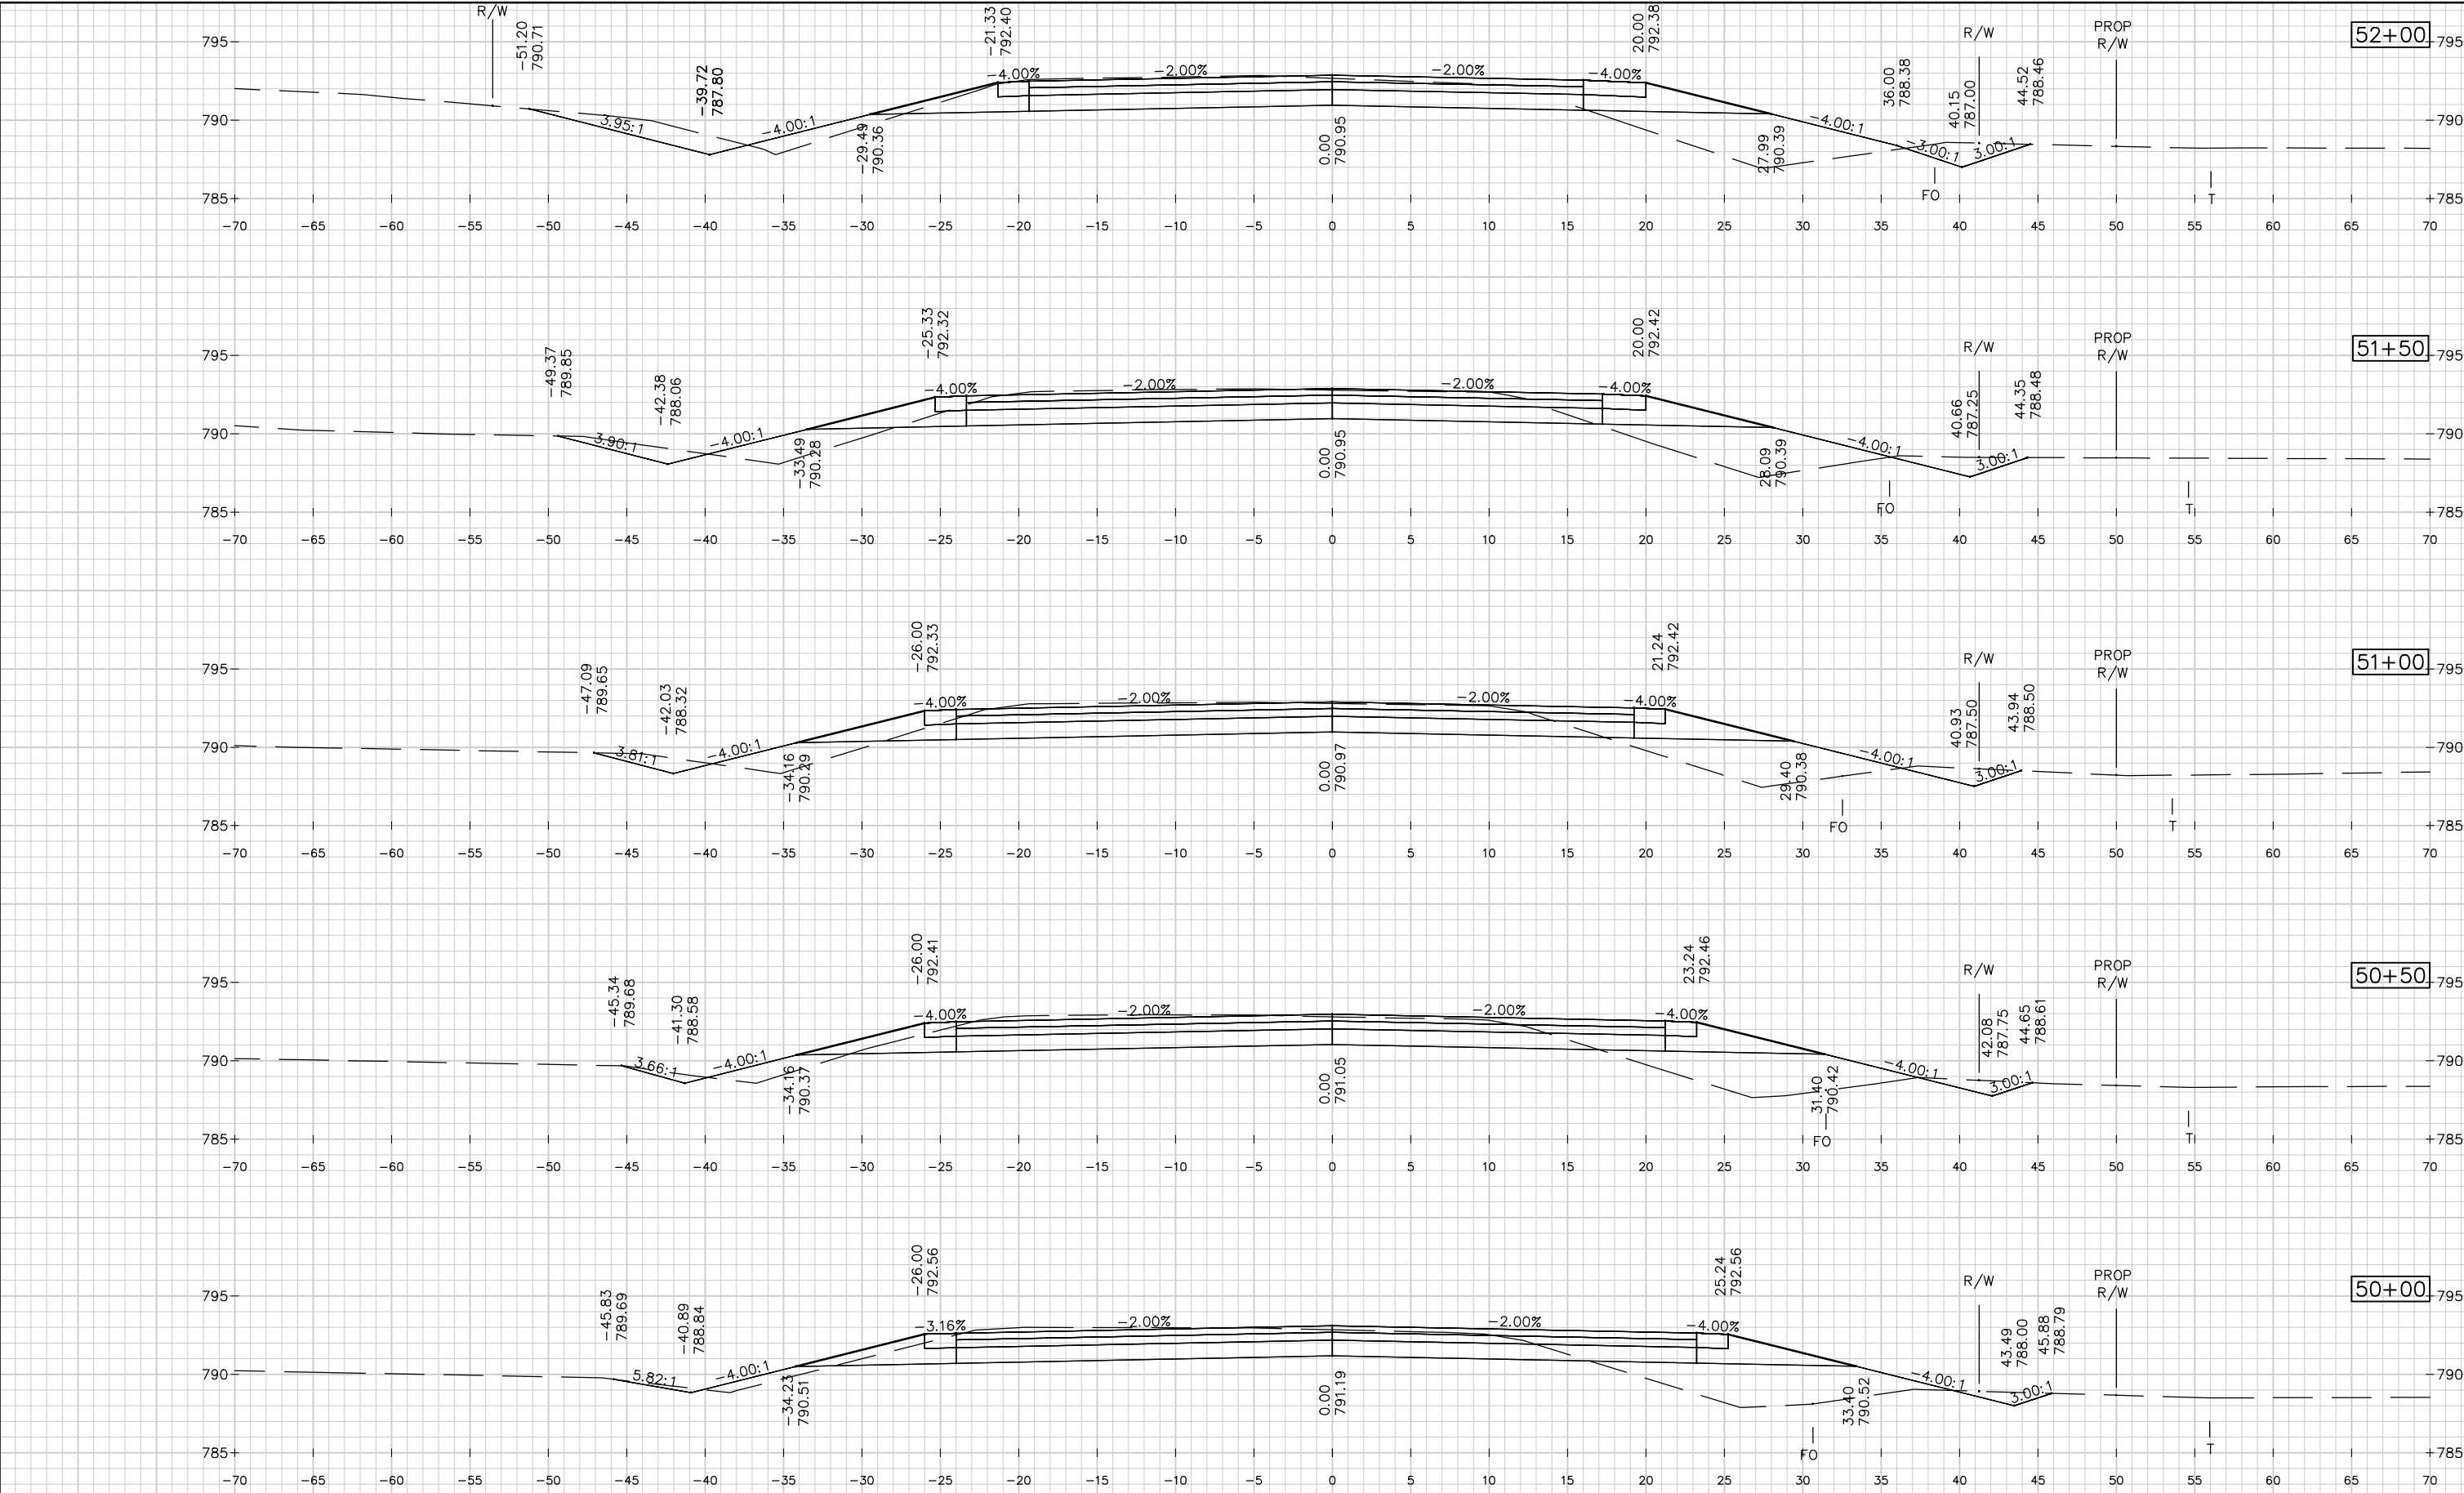



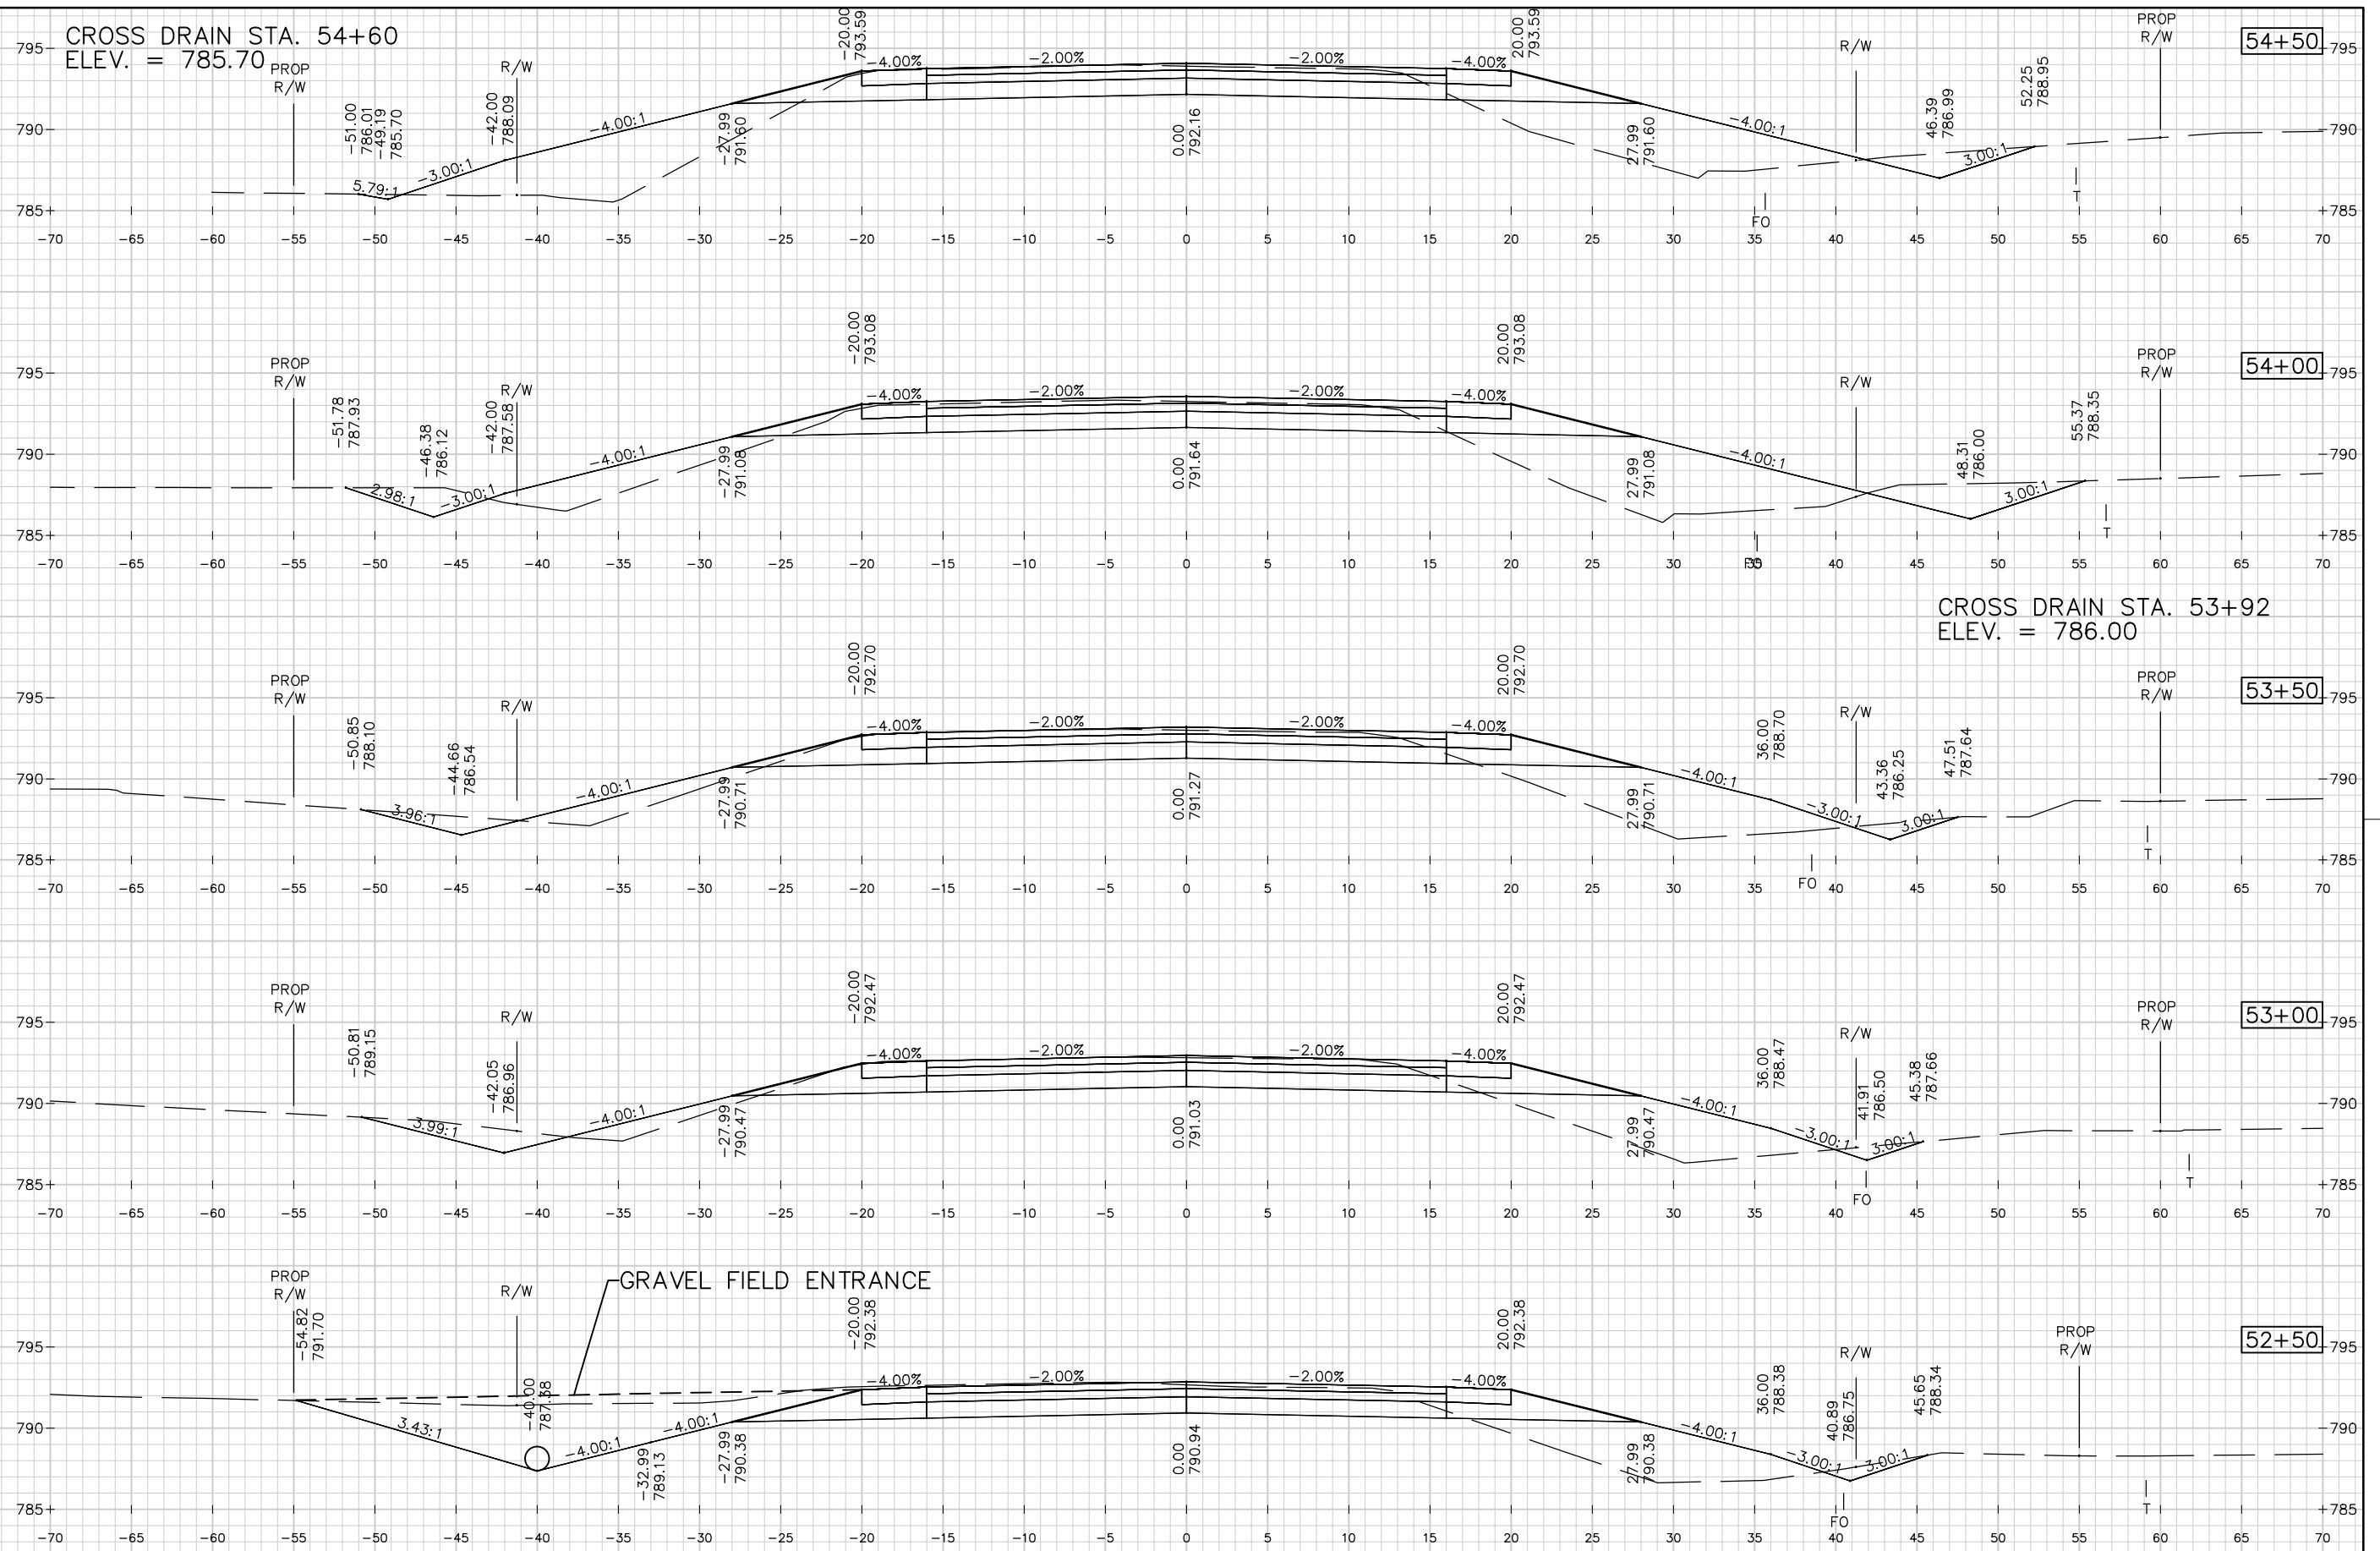


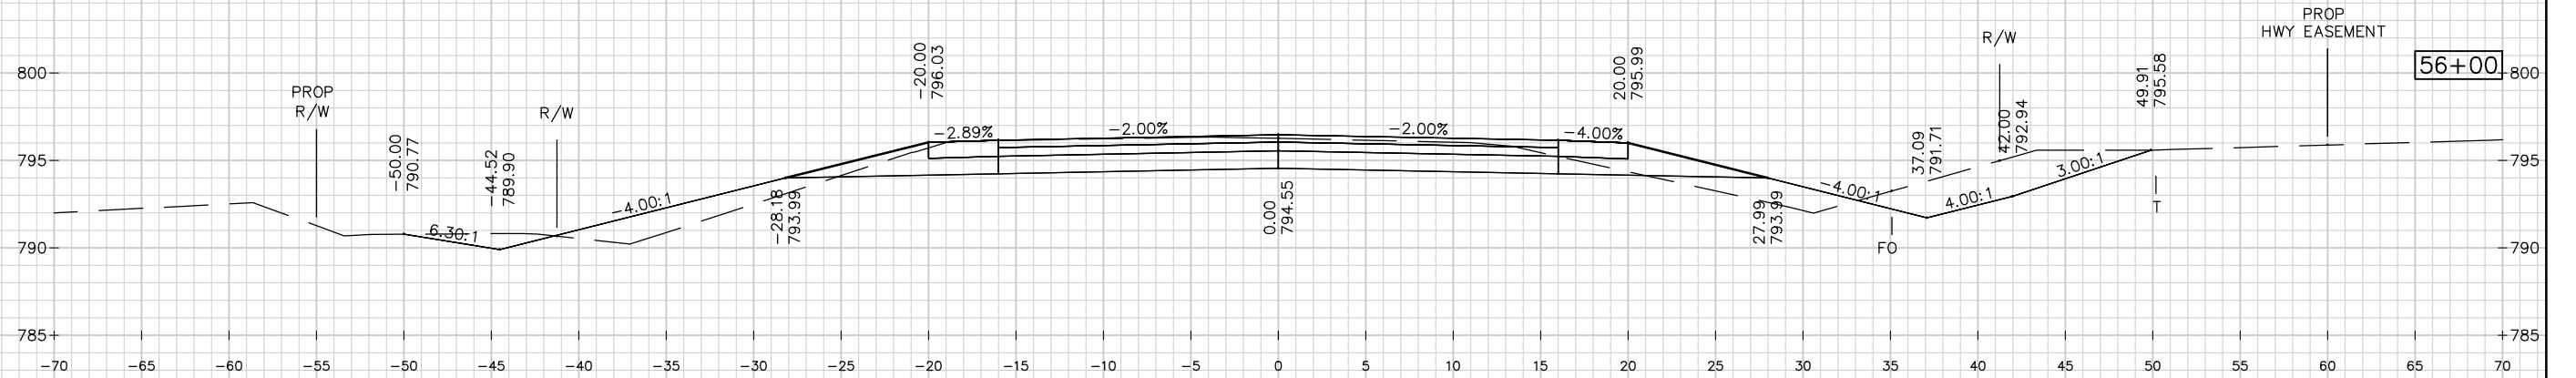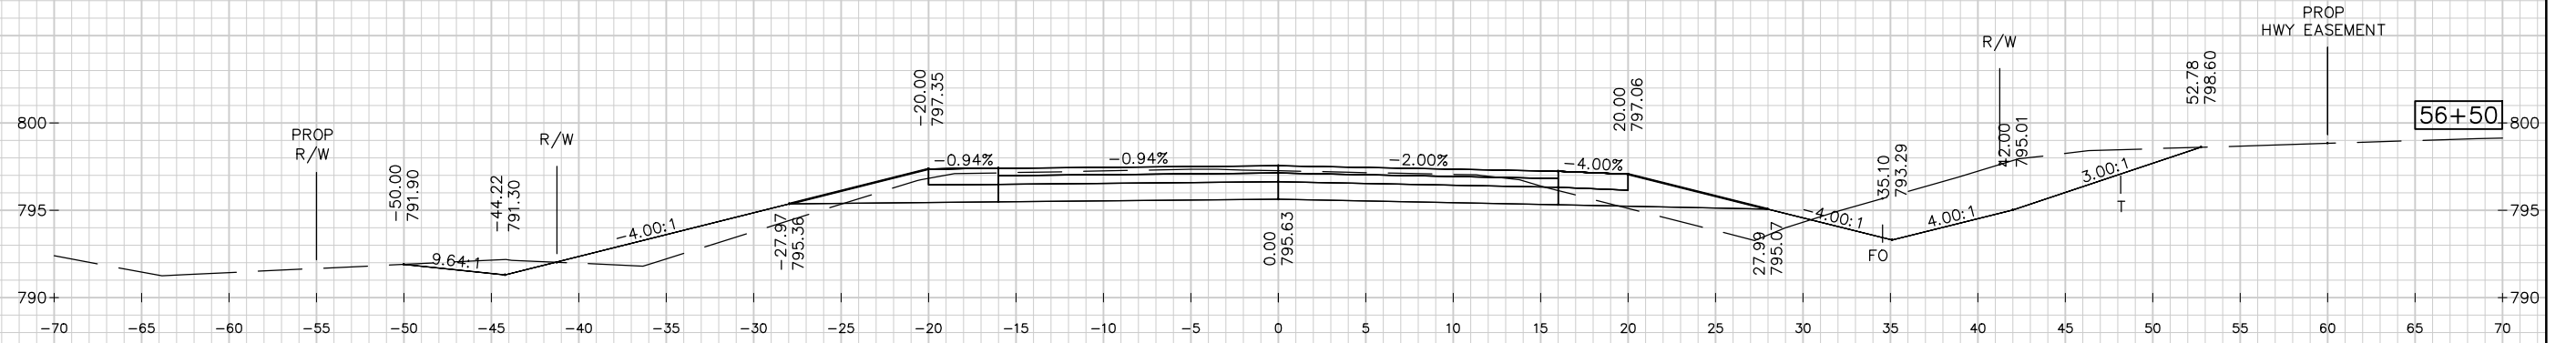


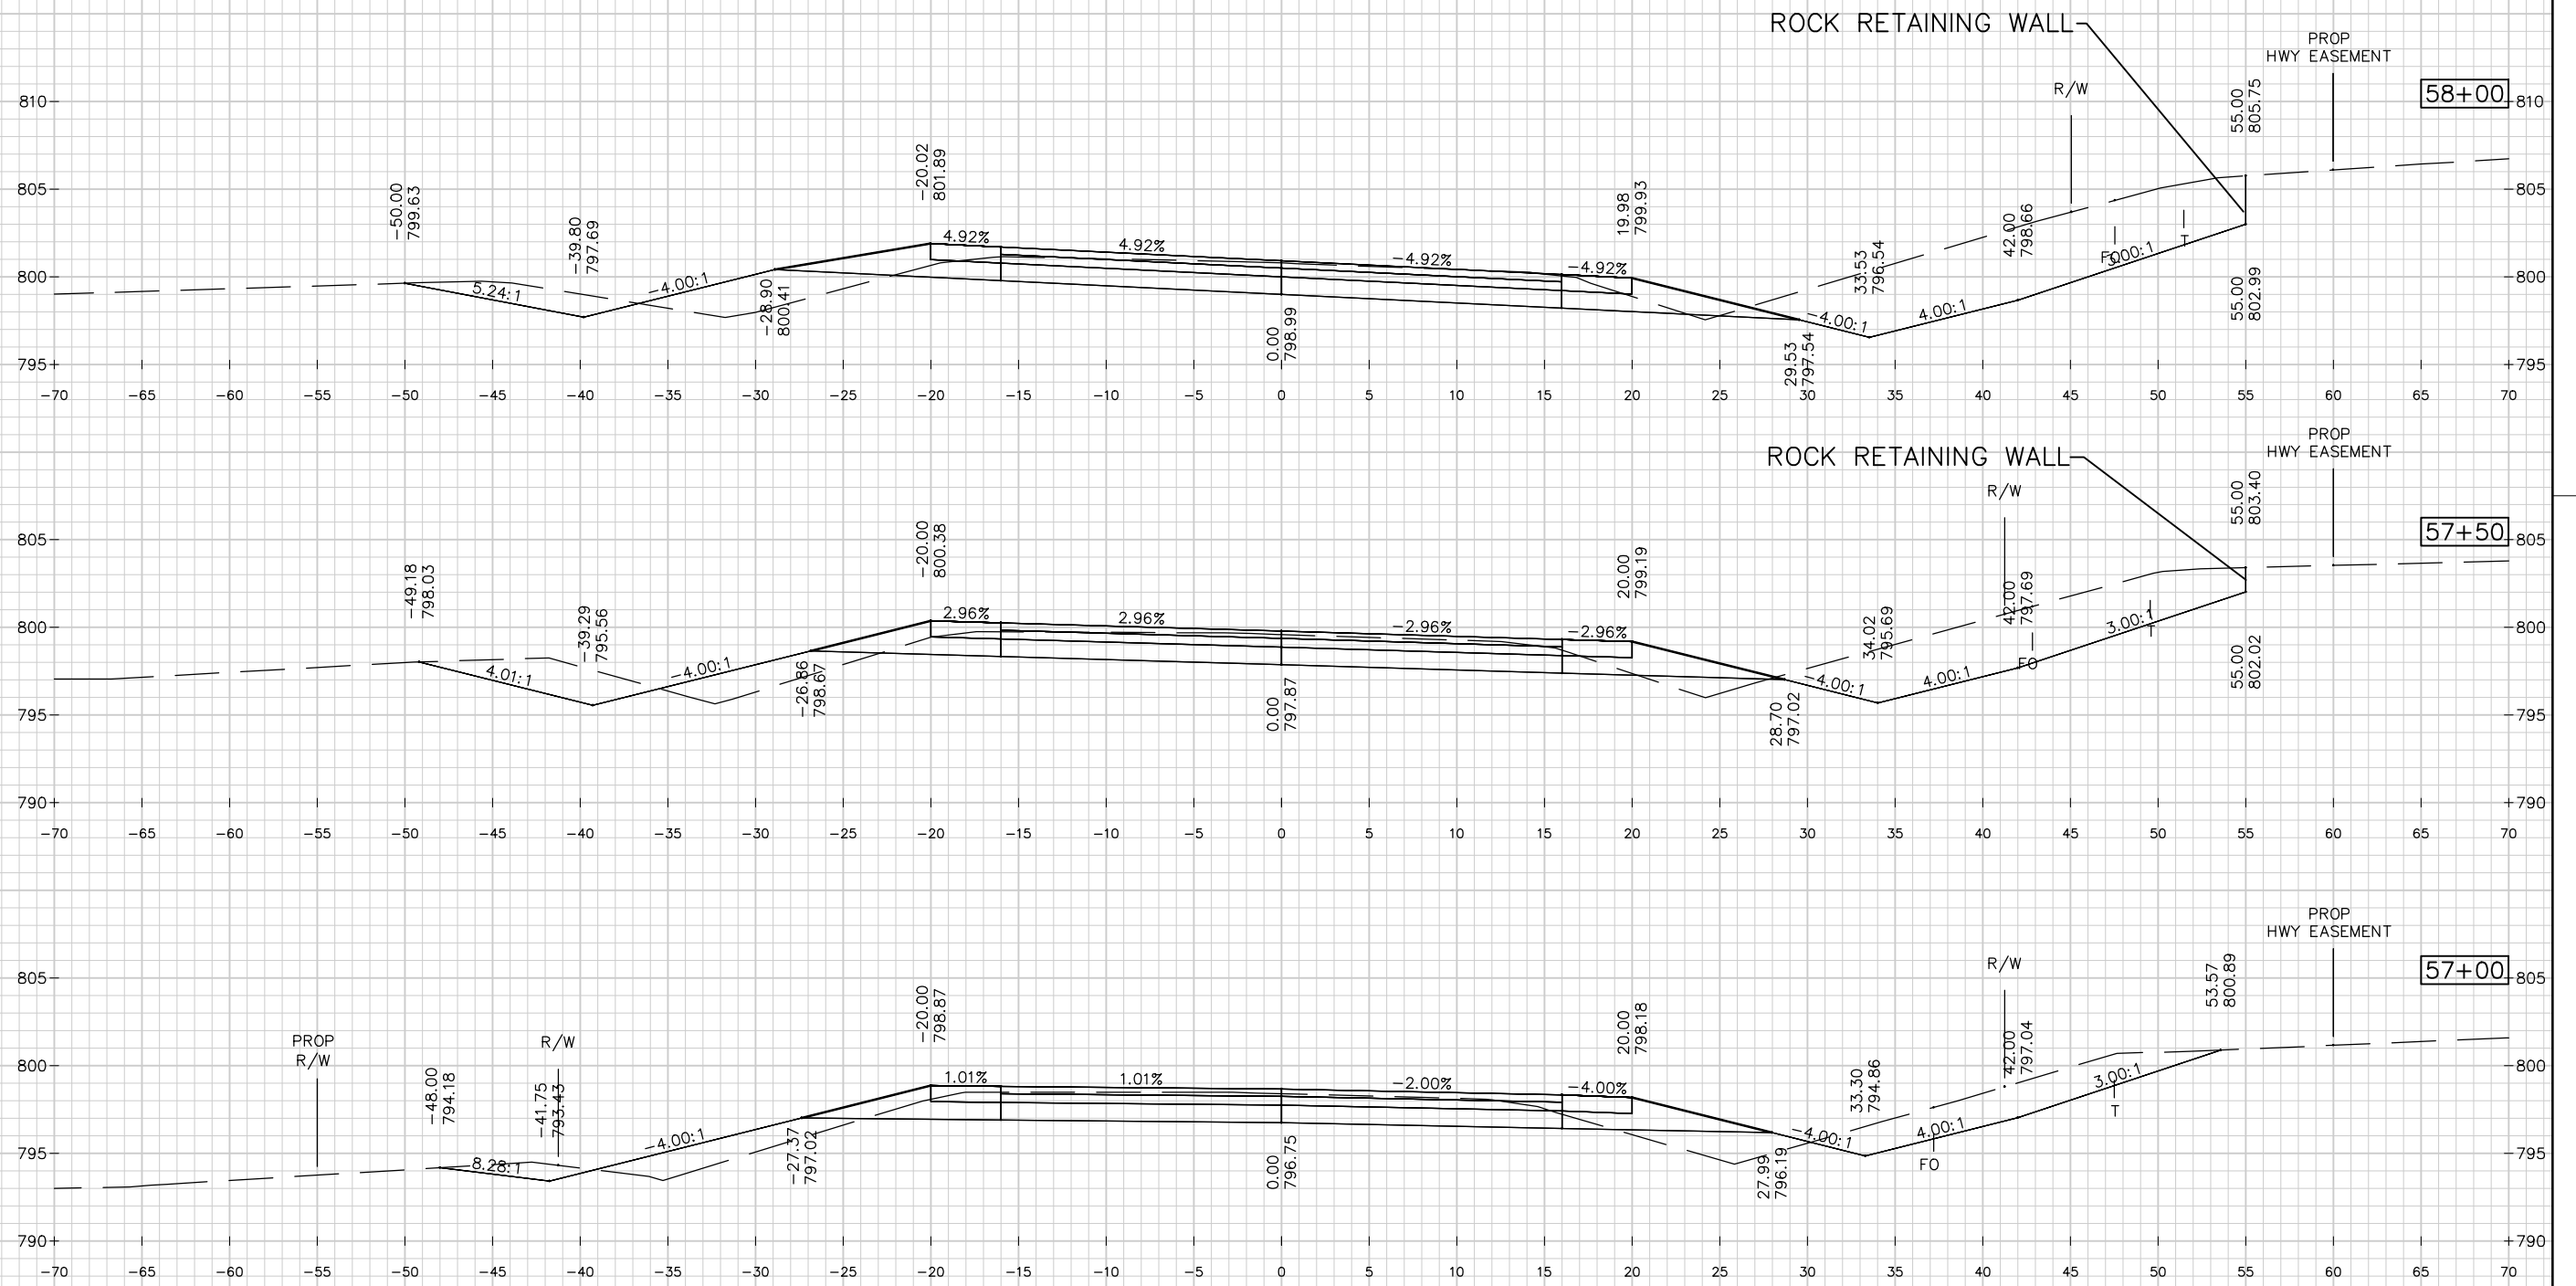


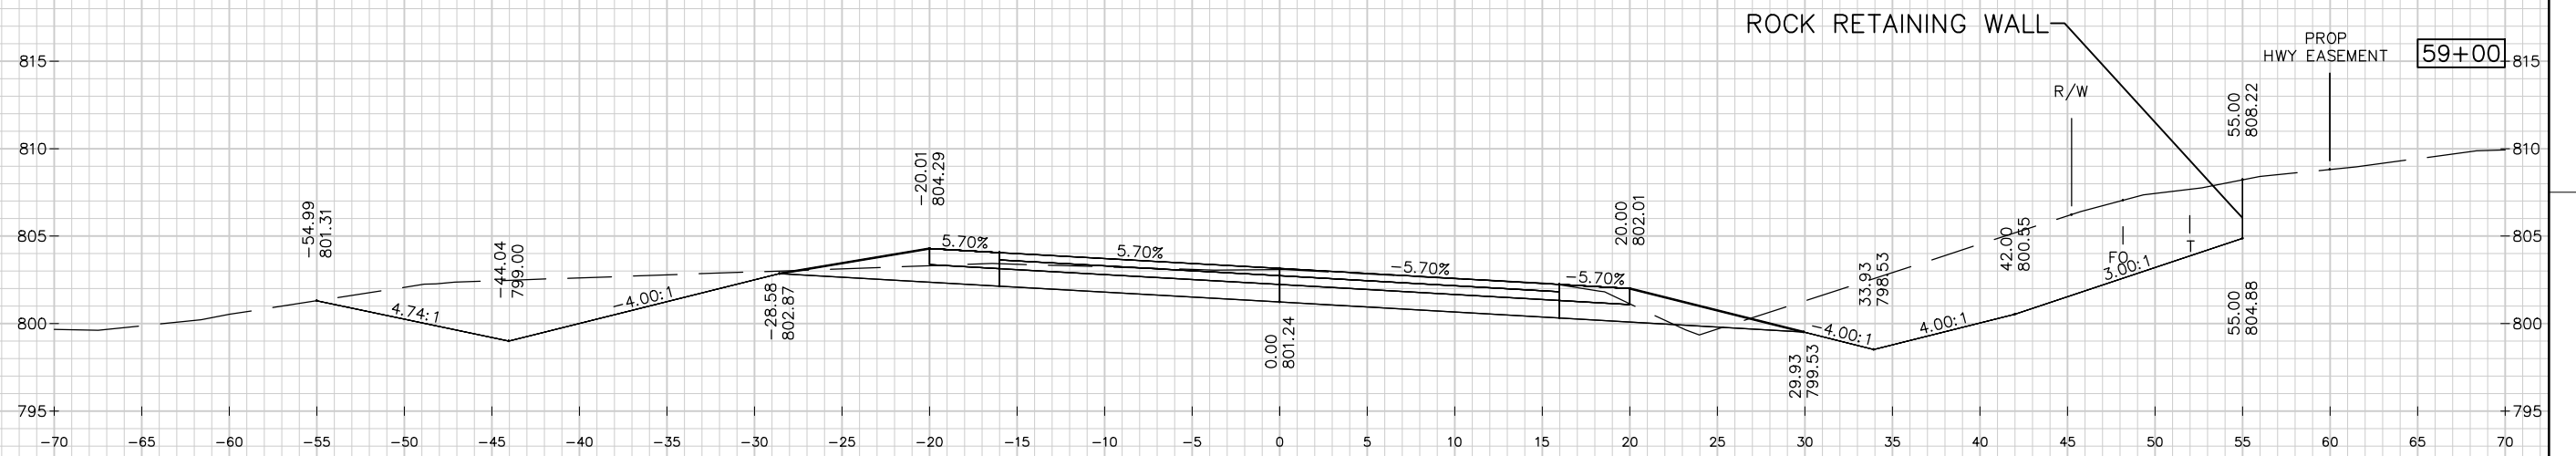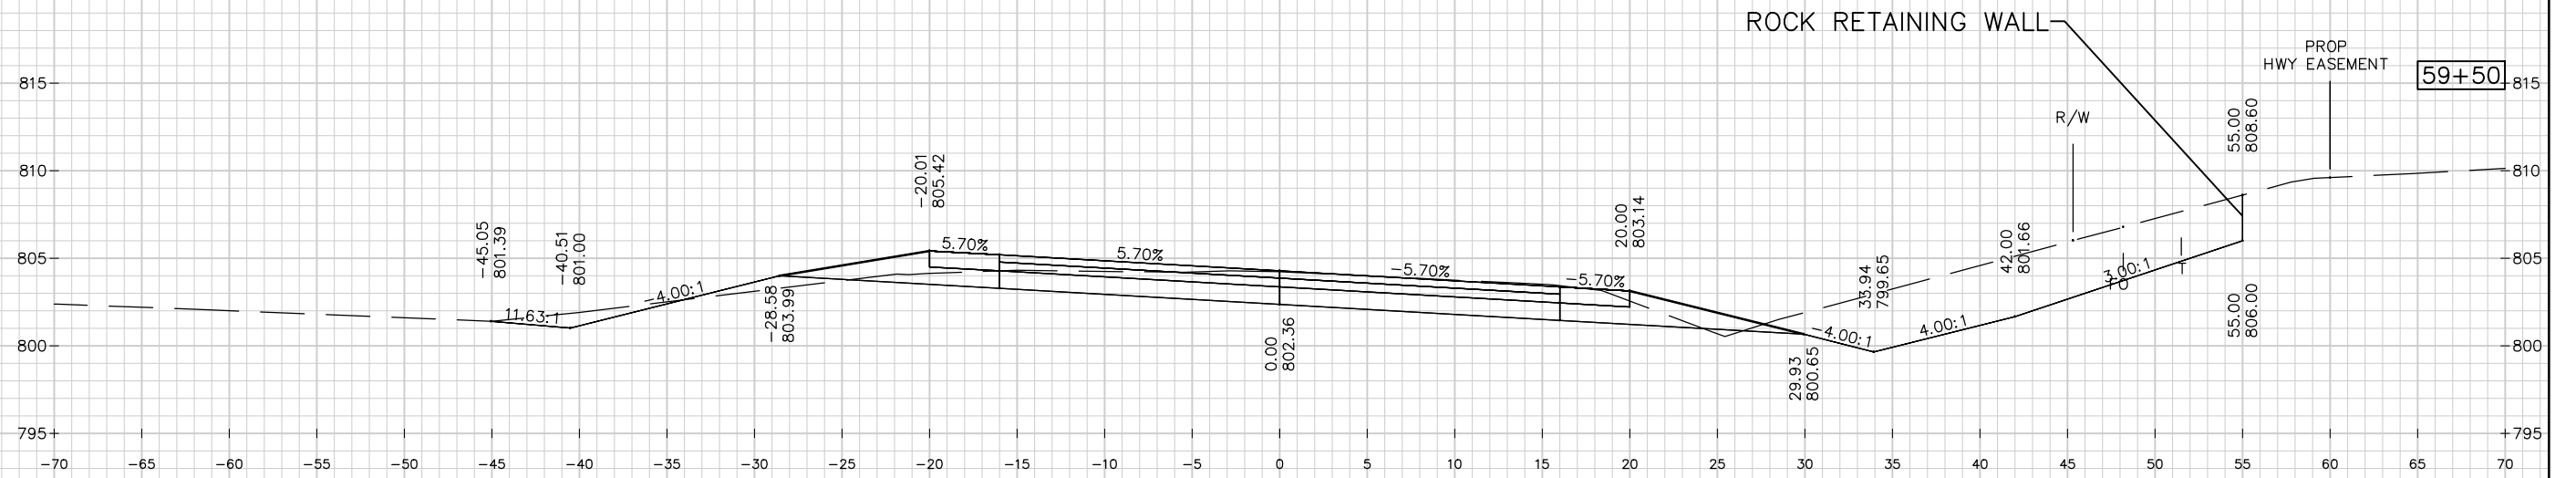




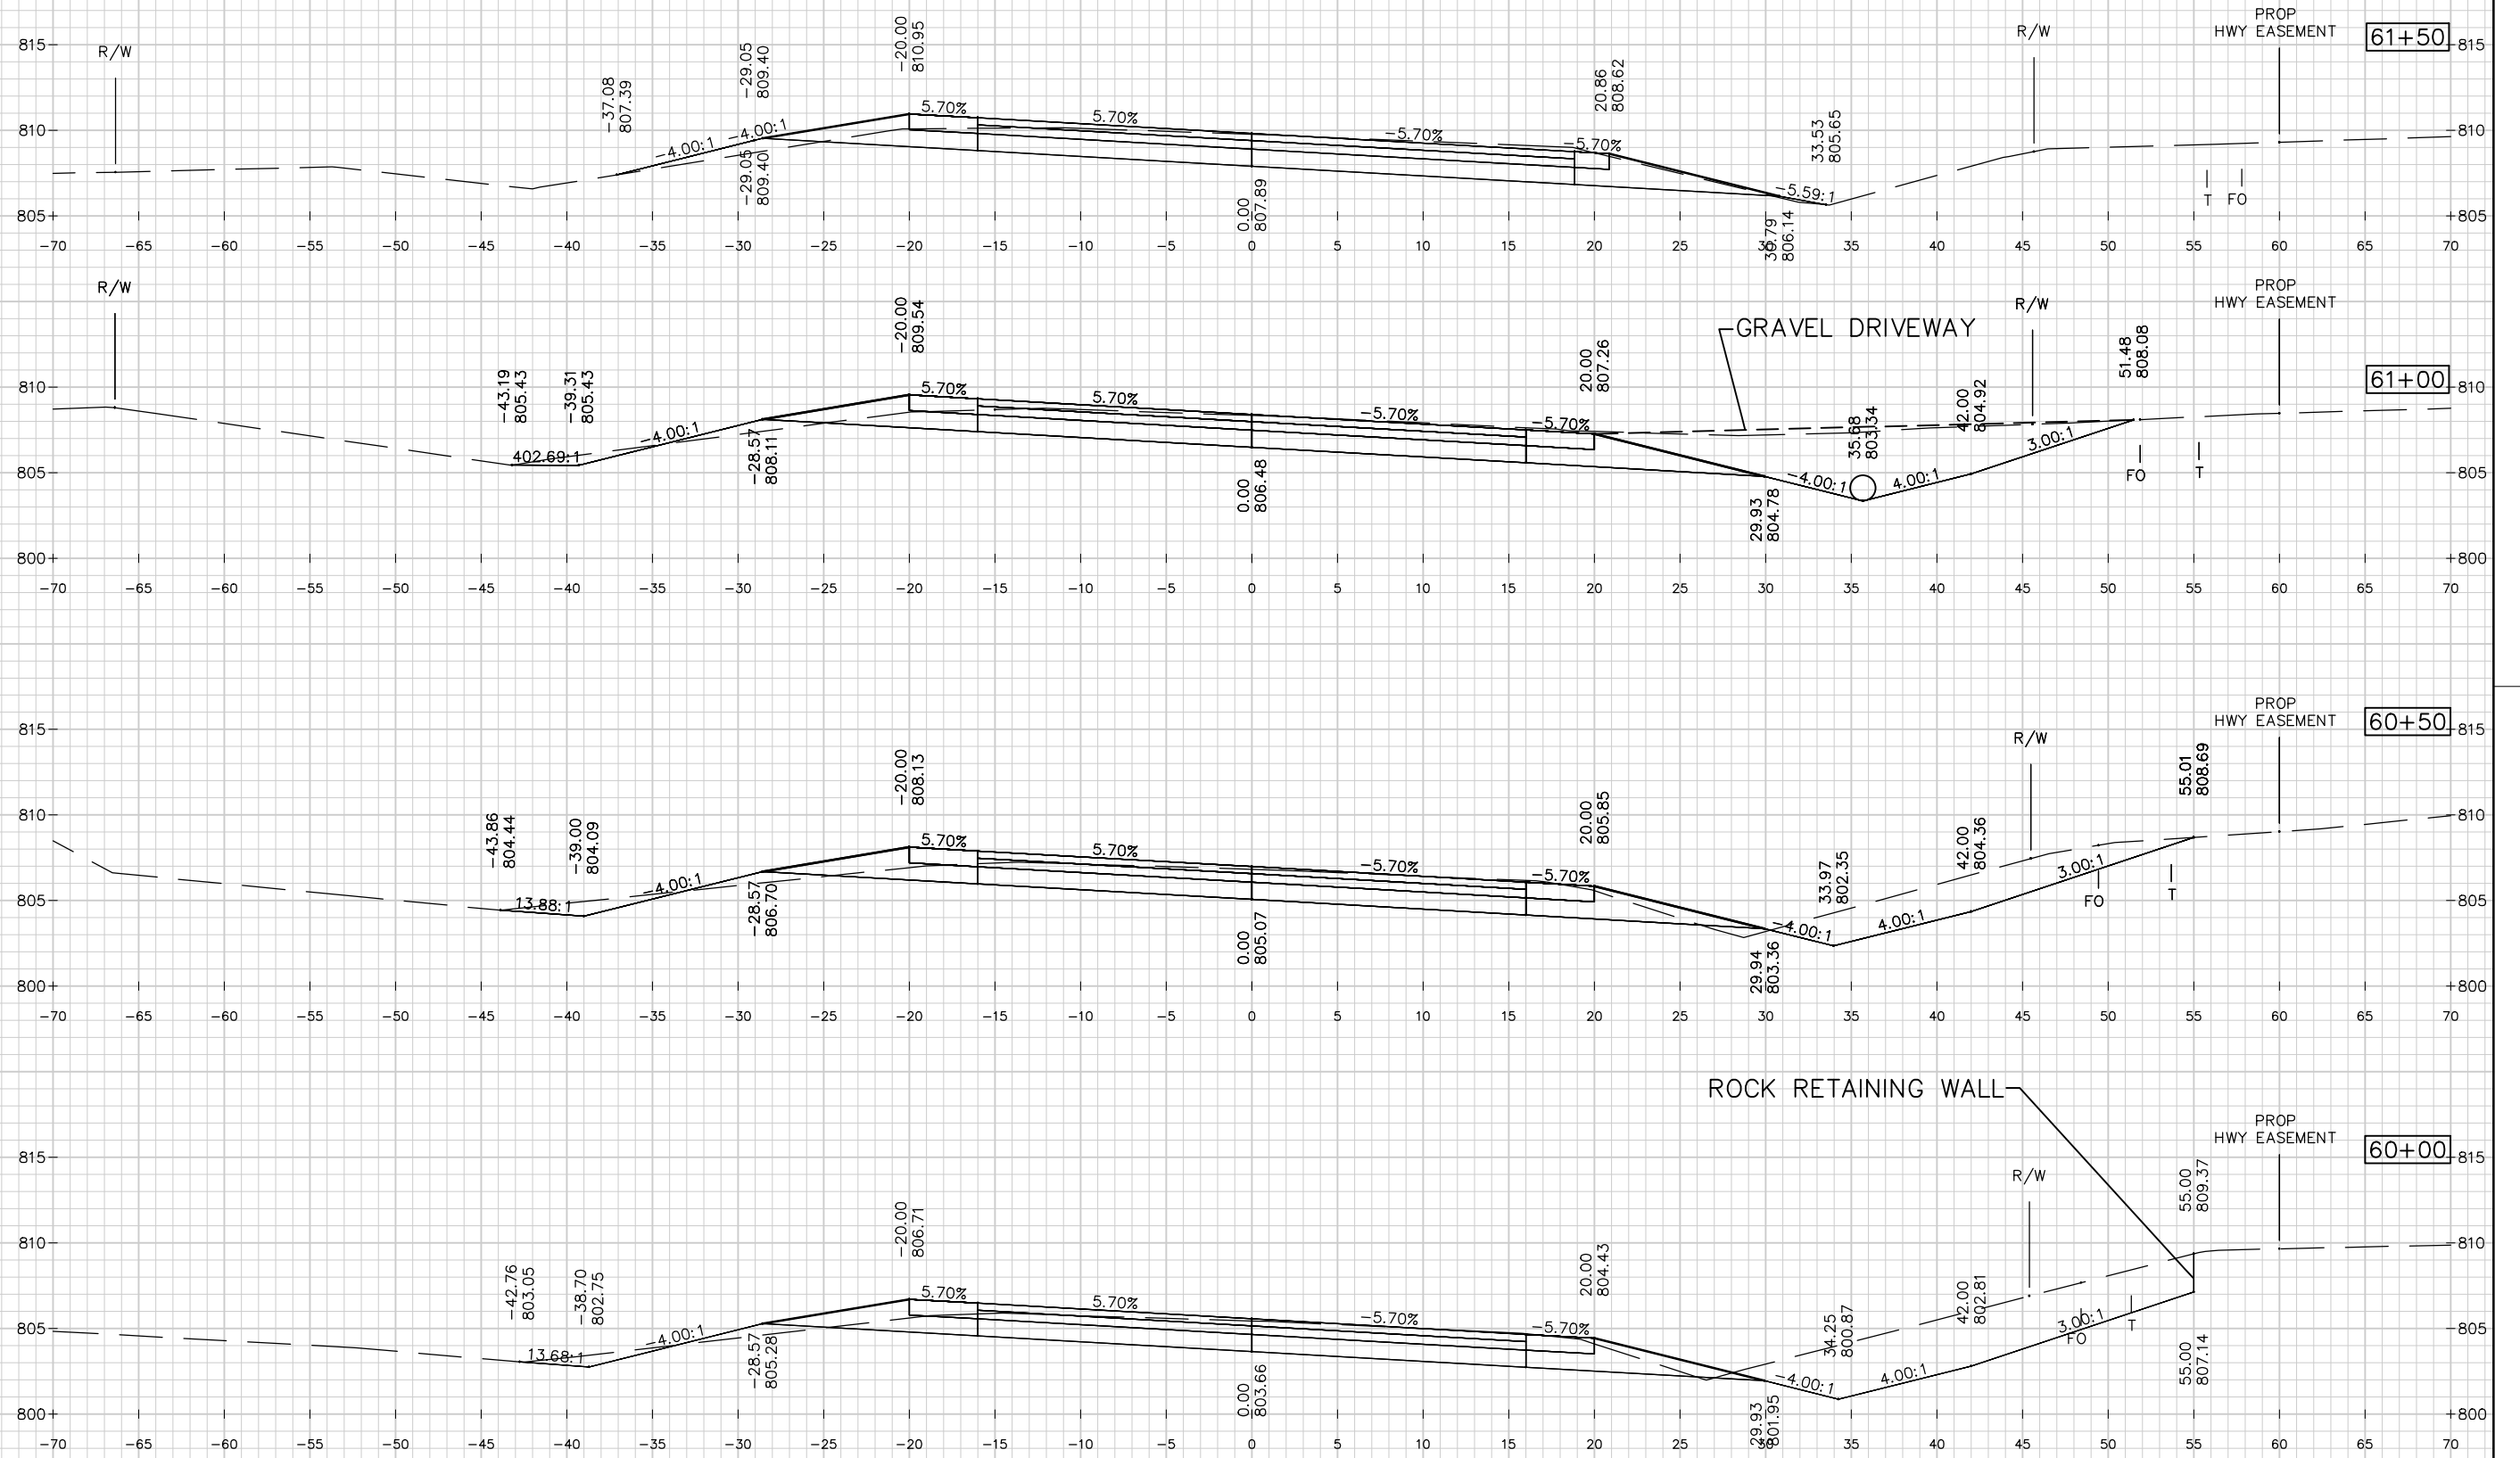


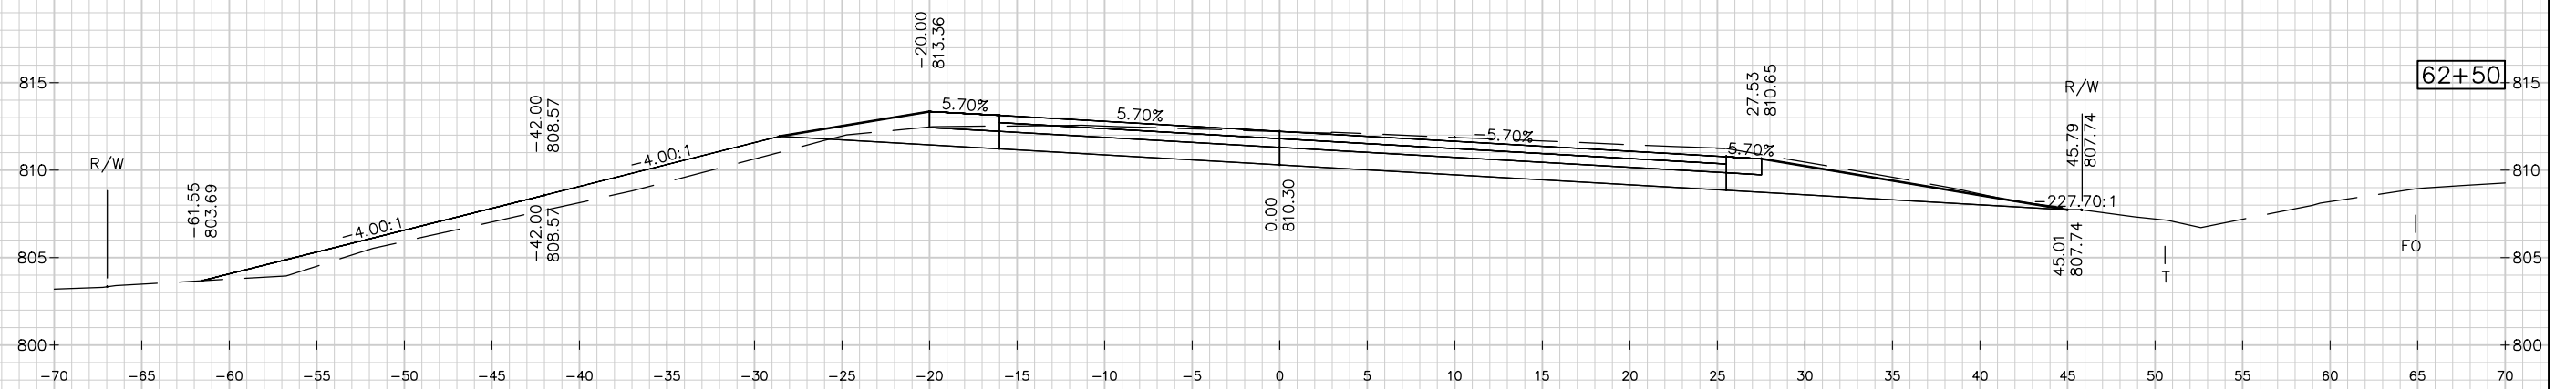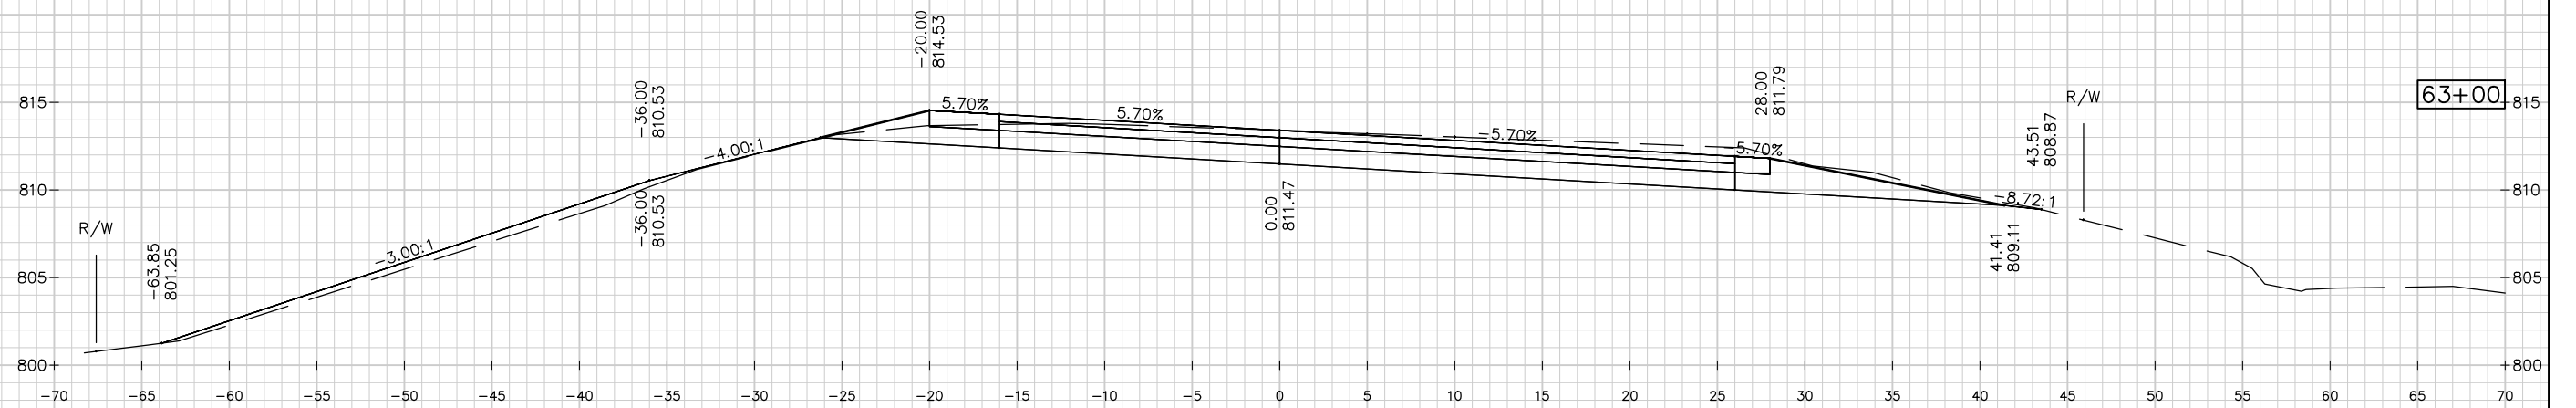


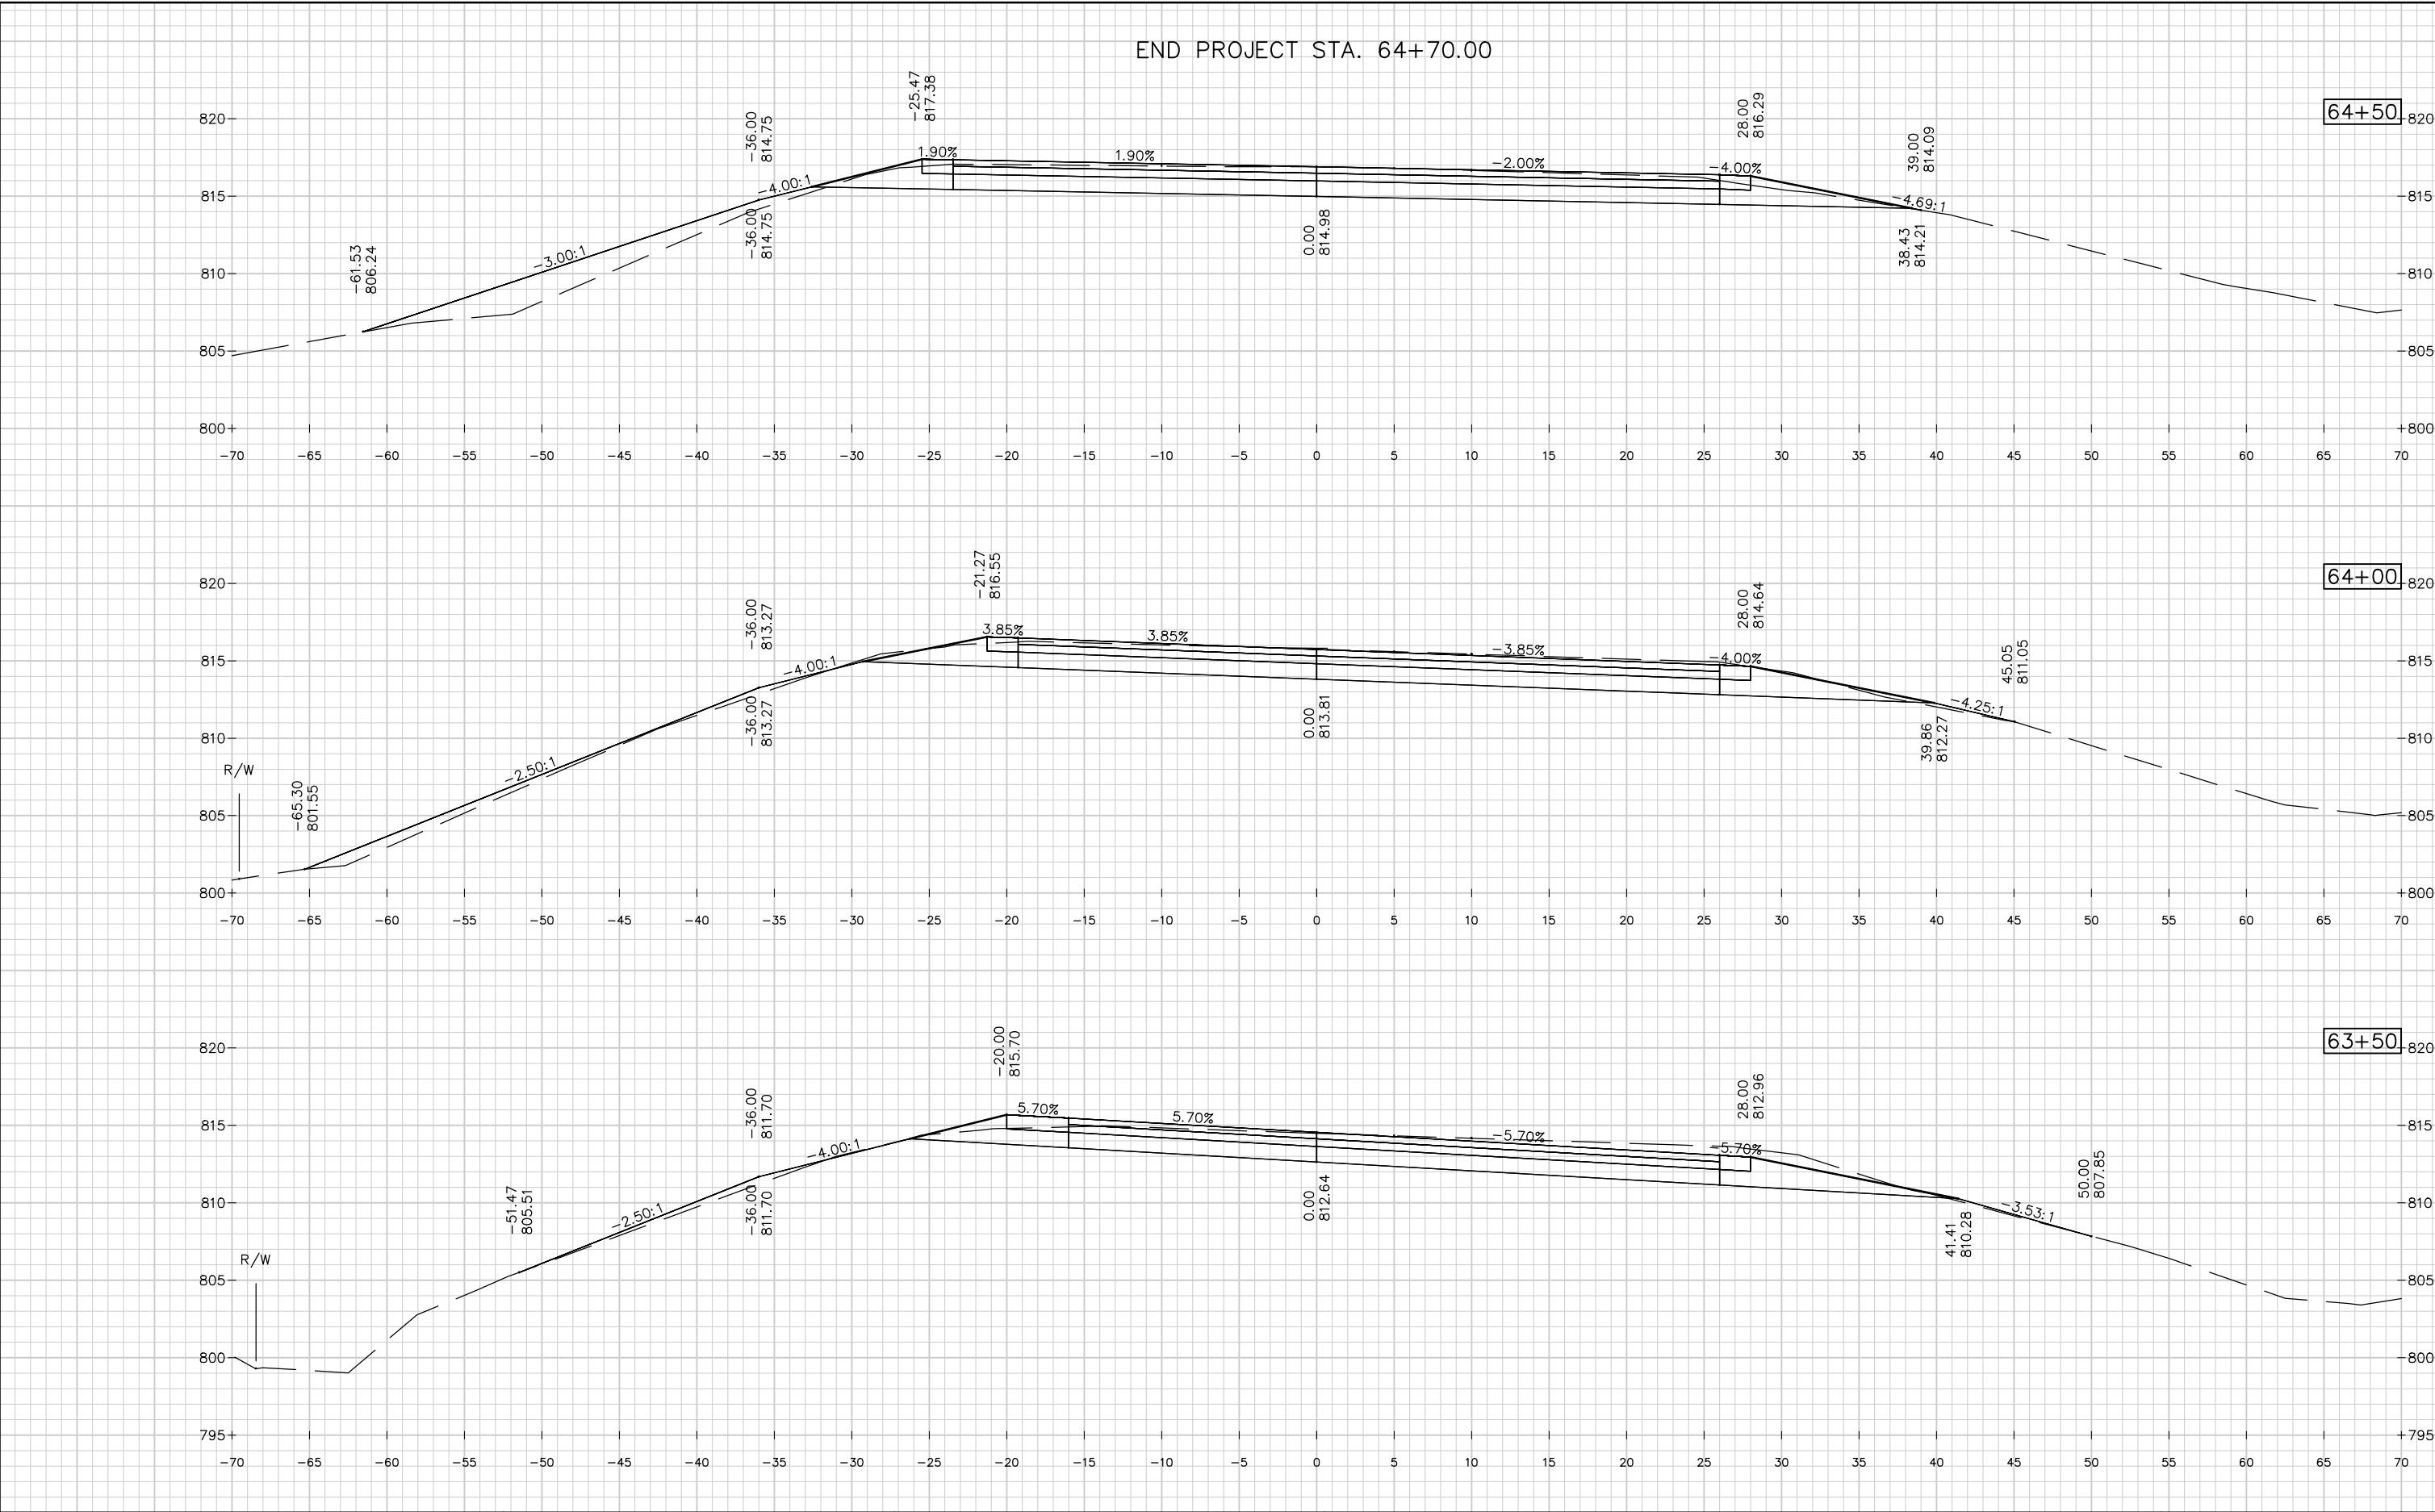

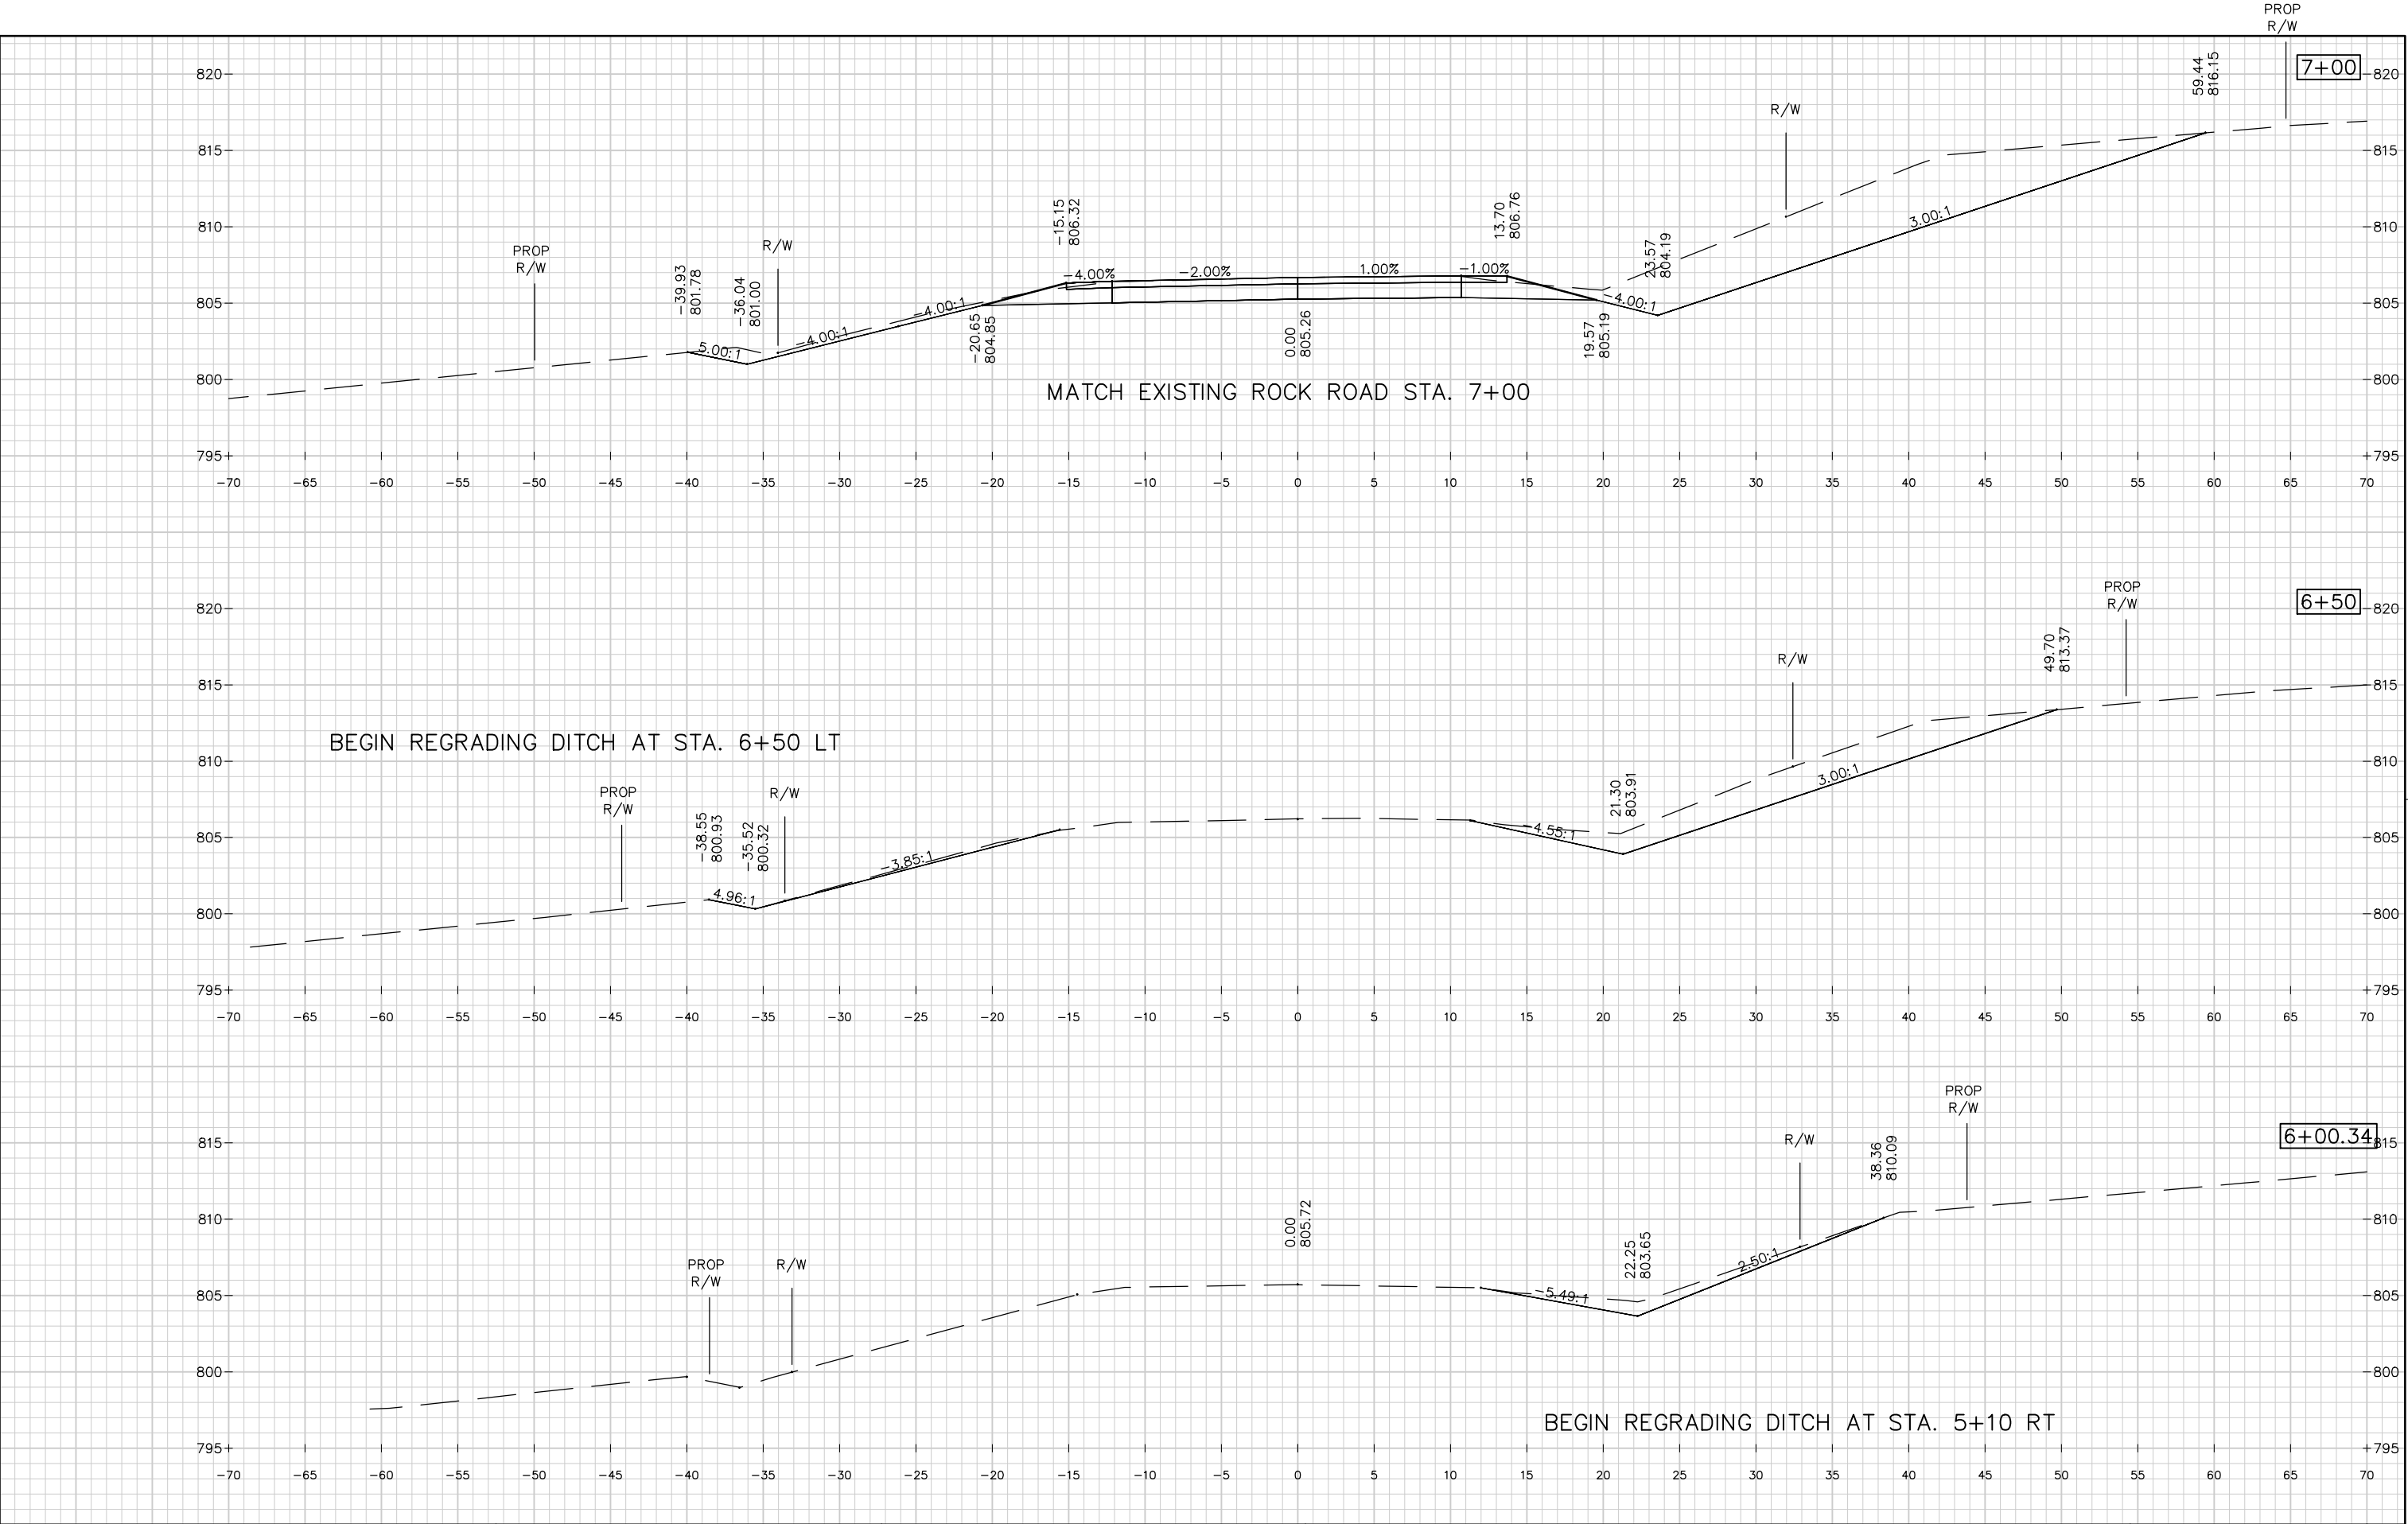

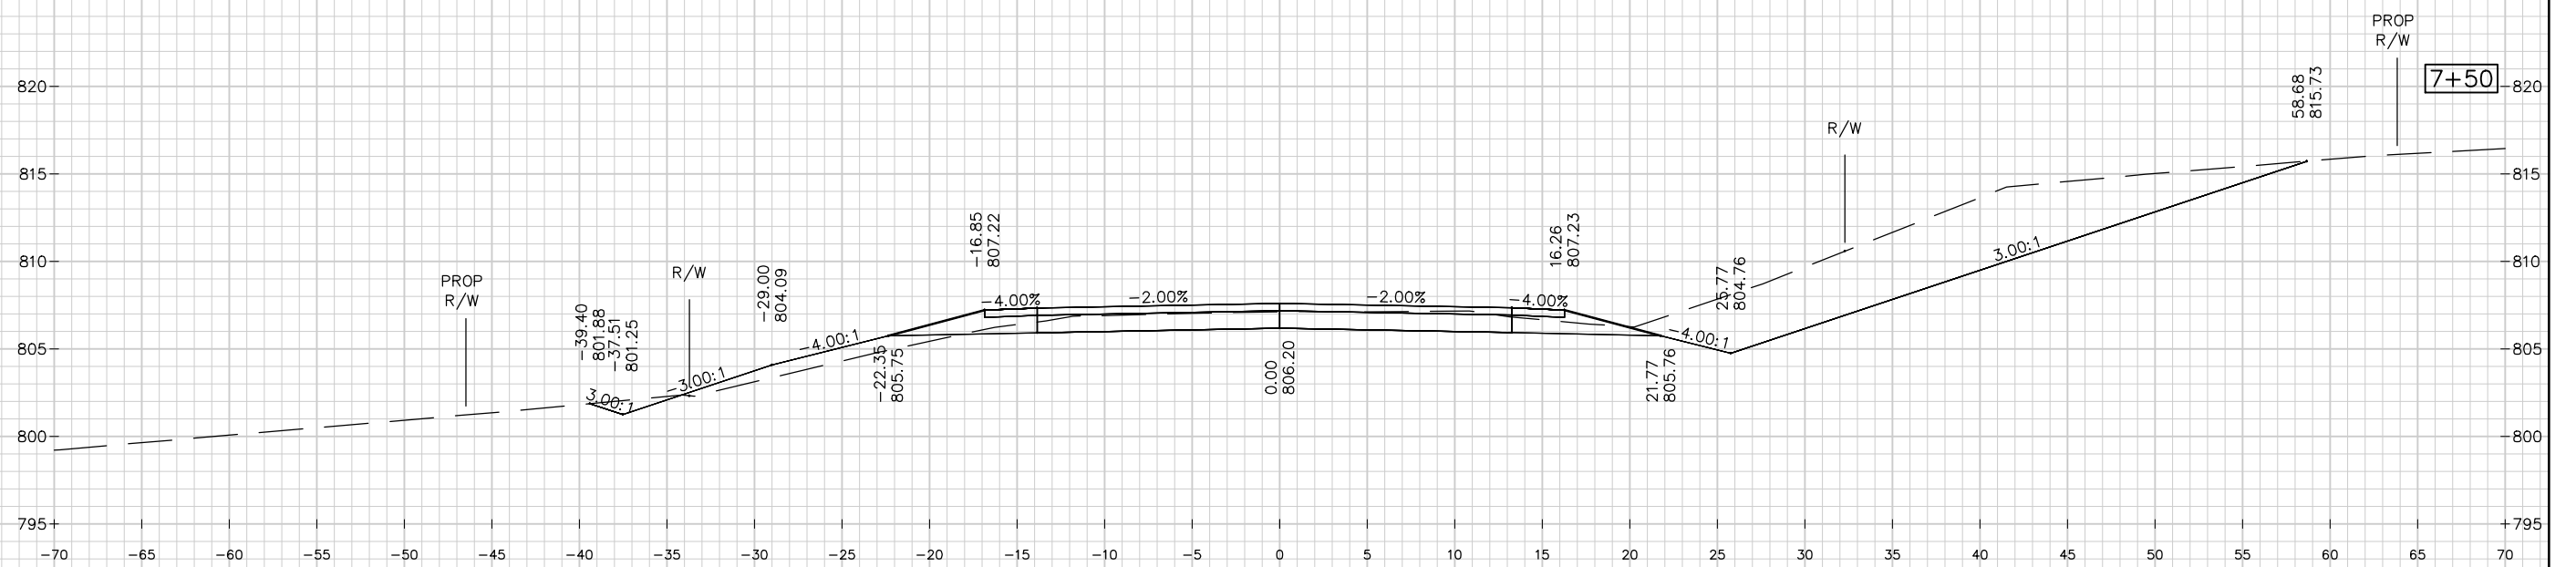

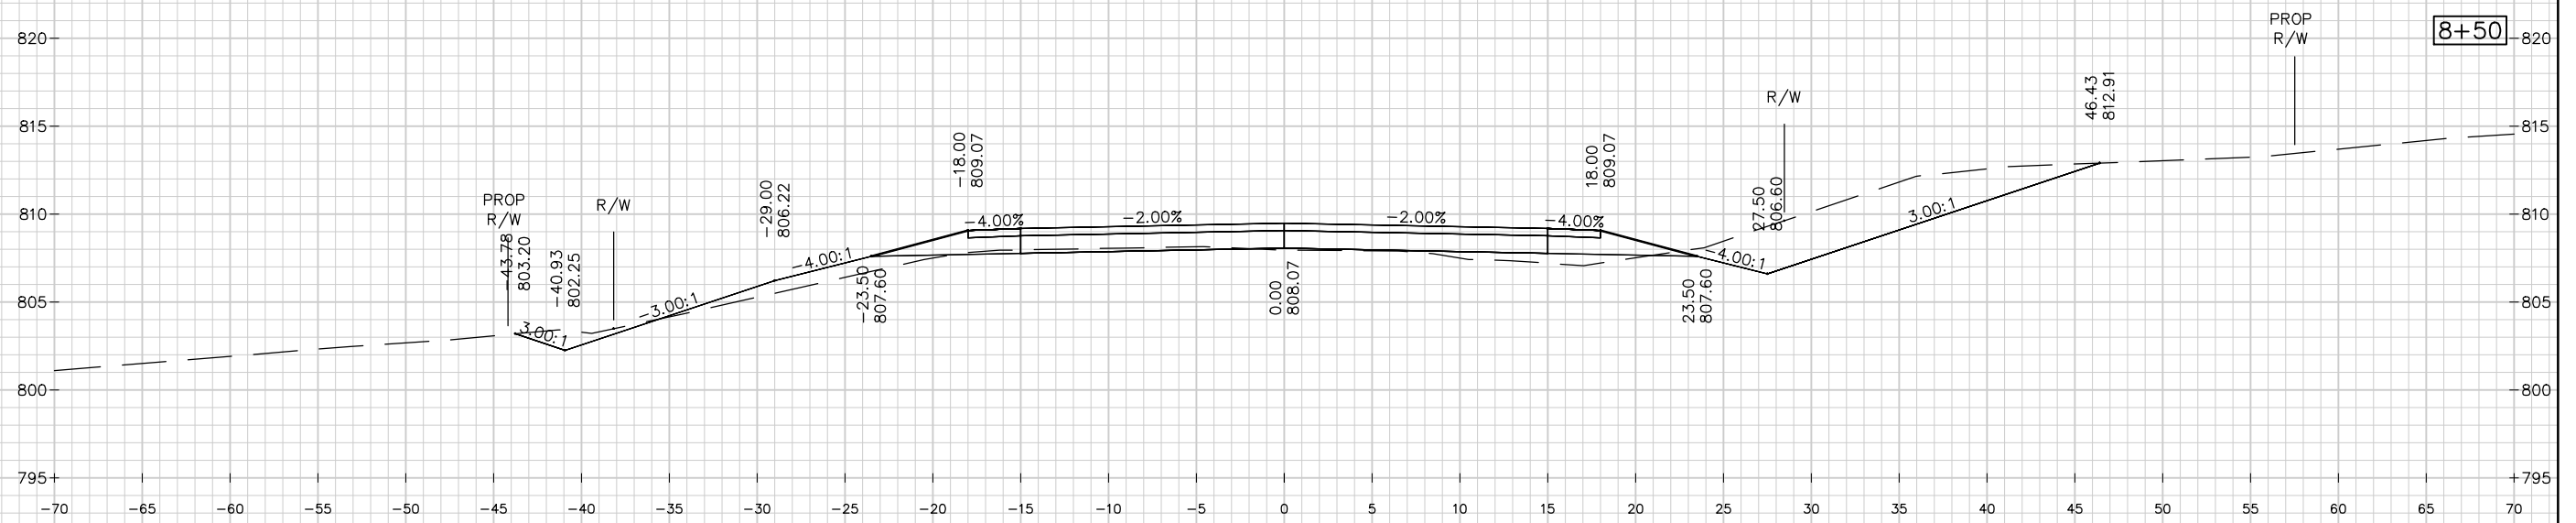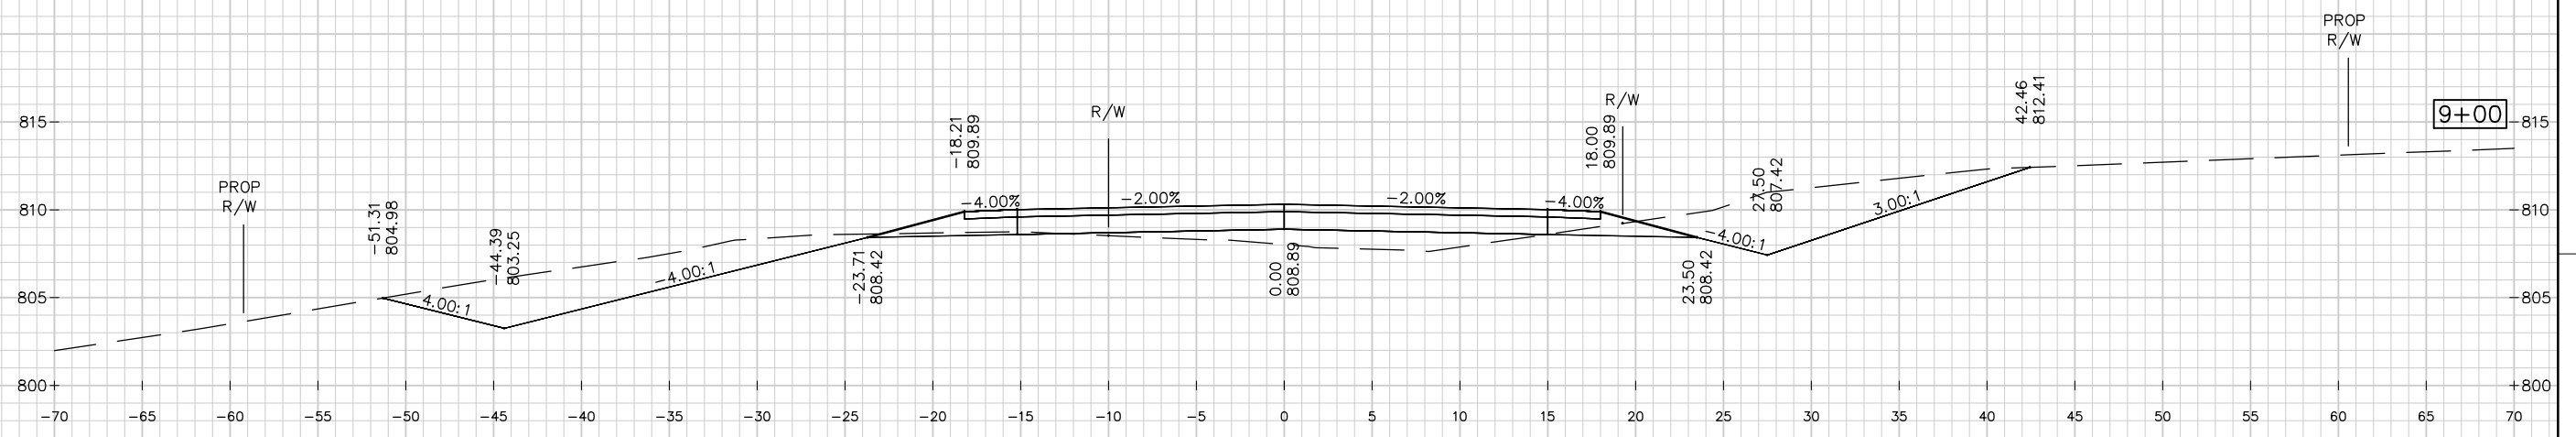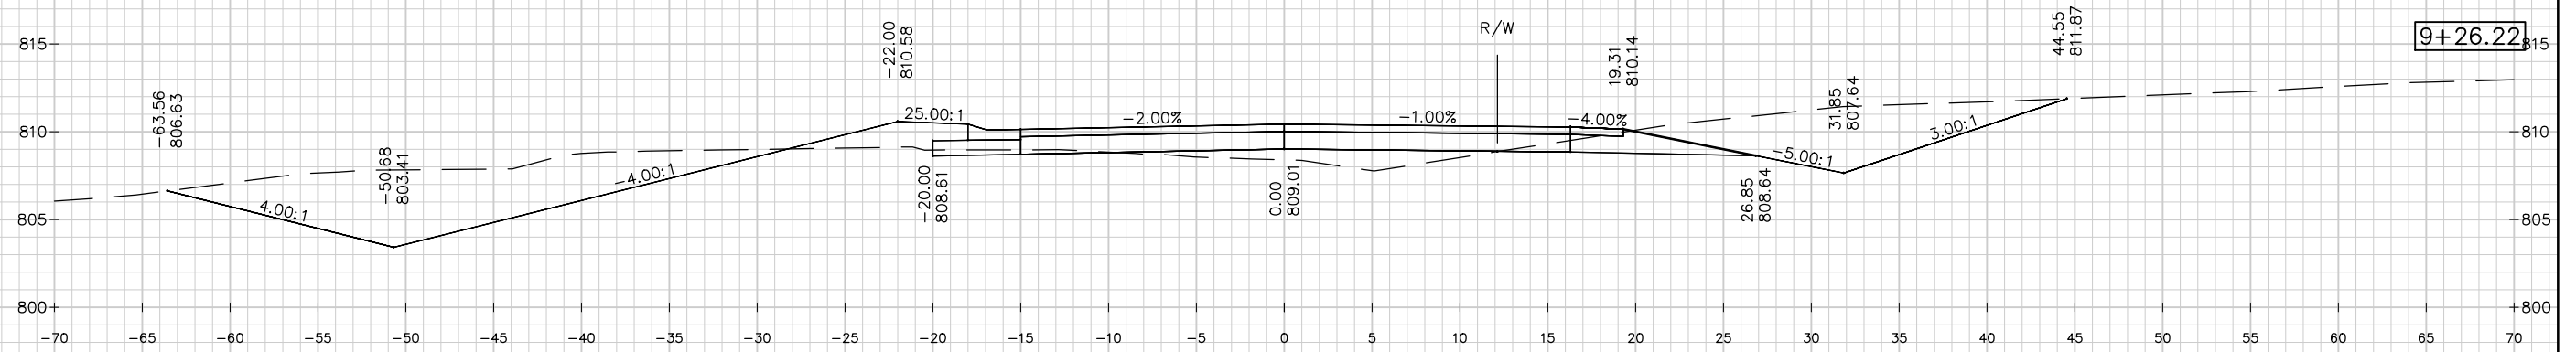

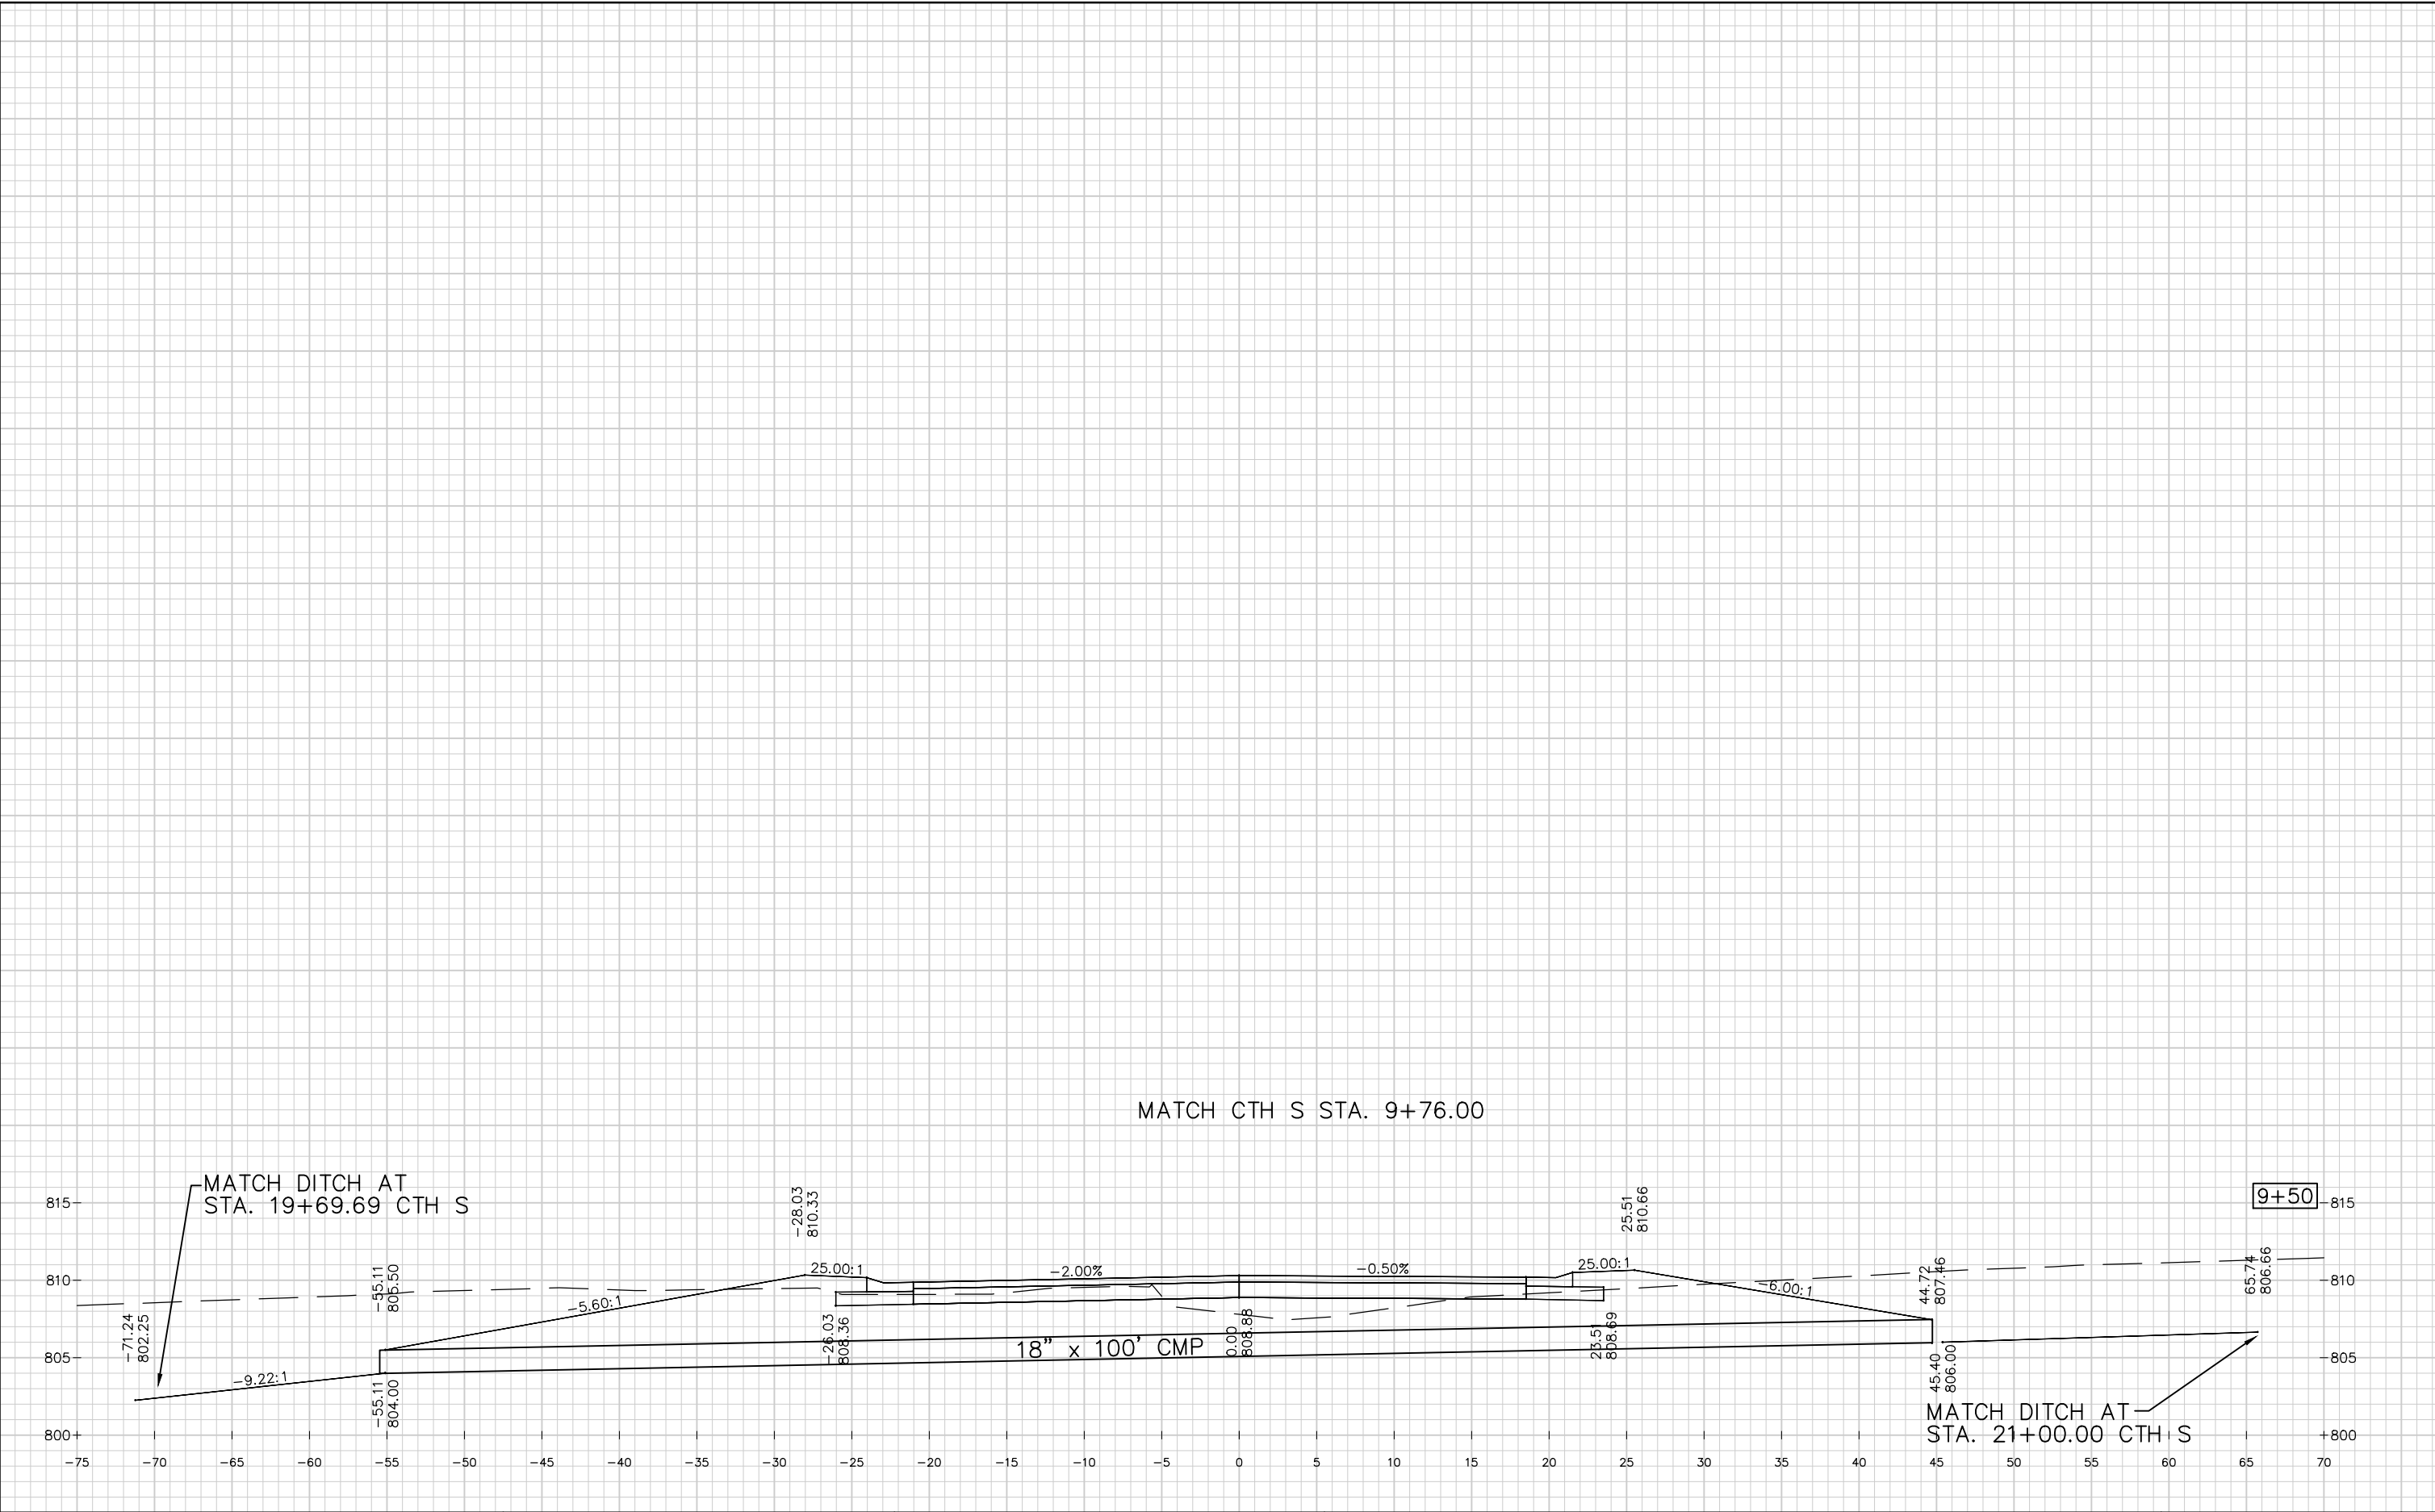

PROJECT NO:	HWY: CTH S	COUNTY: OUTAGAMIE	ROCK ROAD CROSS SECTIONS	SHEET: 86	E
-------------	------------	-------------------	--------------------------	-----------	---

