

AS BUILT PLAN

Index of Sheets

Sheet No	1	Title
Sheet No	2-2.8	Typical Sections and Details
Sheet No	3-3.2	Estimate of Quantities
Sheet No	3A13B	Miscellaneous Quantities
Sheet No	4	Right of Way Plat
Sheet No	5-5.4	Plan and Profile
Sheet No	6-6.21	Standard Detail Drawings
Sheet No		Standard Sign Plates
Sheet No		Structure Plans
Sheet No		Computer Earthwork Data
Sheet No	9-9.5	Cross Sections

TOTAL SHEETS - 49

STATE OF WISCONSIN
DEPARTMENT OF TRANSPORTATION

PLAN OF PROPOSED IMPROVEMENT

LYNNDALE DR. & CAPITOL DR. INTERSECTION

(TOWN OF GRAND CHUTE)

PRIME CONTRACTOR: SUMMERS CONSTRUCTION CO. C.T.H. "A"

SUBS: MURPHY CONSTRUCTION CO. OUTAGAMIE COUNTY

ELMSTAR ELECTRIC CORP.

HIGHWAY SAFETY

TIMME, INC.

TRAFFIC SIGNING & MARKING, INC.


STATE PROJECT NUMBER
6521-2-71

STATE PROJECT	FEDERAL PROJECT	
	PROJECT	CONTRACT
6521-2-71	M 1201(14)	I

CONSTRUCTION STARTED : 4-6-92
CONSTRUCTION COMPLETED : 6-25-92

AS BUILT PLAN
NO.

SUPERVISOR APRIS ROZITE
RESIDENT ARNIE HAEVERS
CONTRACTOR SUMMERS CONST. CO.
COMPLETED 6-25-92

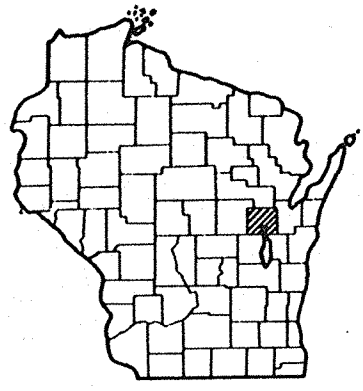


Design Designation

	C.T.H. "A"	CAPITOL DRIVE
A.D.T. (1987)	8,926	2,456
A.D.T. (2009)	14,988	10,308
D.H.V. (2009)	2,248	1,546
D.	50-50%	50-50%
T. % OF A.D.T.	8.5	6.8
V.	35 M.P.H.	25 M.P.H.
E.S.A.L.S.	2,555,730	

Conventional Signs

County Line	=====	Caution Symbol (Combustible fluids under pressure)	
Township or Range Line	-----	Railroads	+++++
Section Line	-----	Fence	-x-x-x-
Corporate or City Limits	=====	Culverts in Place	-----
Property line	-----	Culverts Required	-----
Lot Line	-----	Power Pole	□
Existing Right of Way Line	-----	Telephone or Telegraph Pole	□
New Right of Way Line	-----	Right of Way Markers	-----
Base or Survey Line	-----	Marsh	~~~~~
Slope Intercept	-----	Wooded Area	~~~~~
Existing Roadway or Private Entrance	-----	Grade Elevation	-----

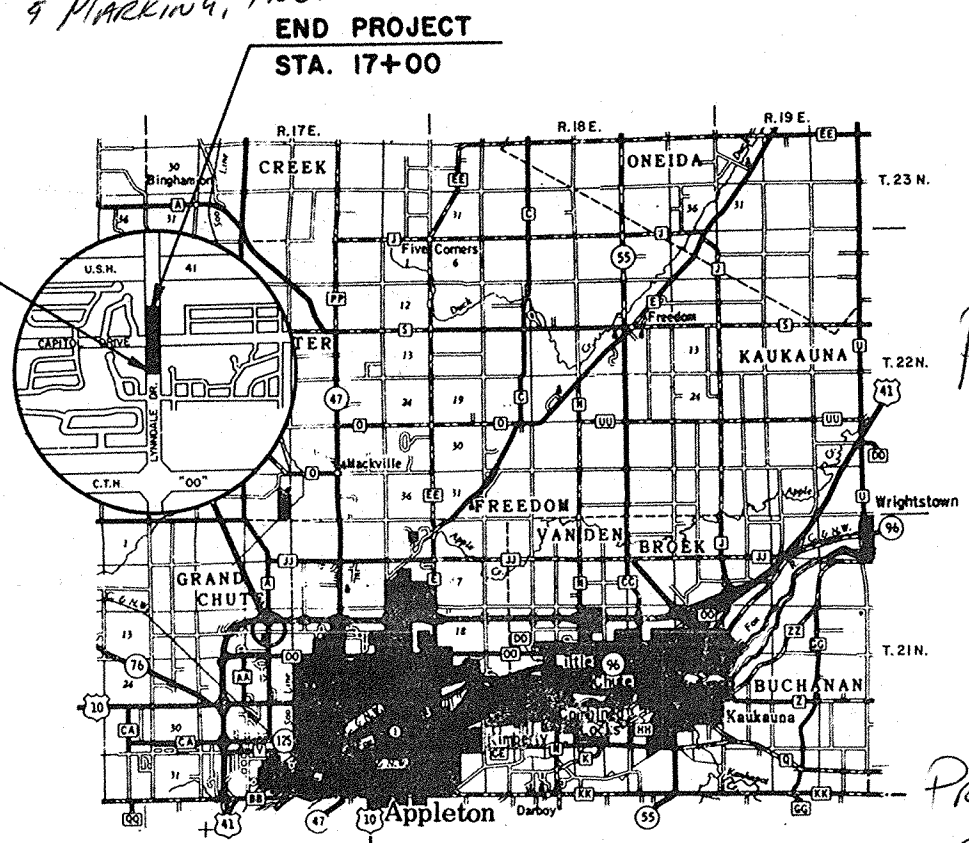

Layout
Scale 0 1 2 Mi.
Total Net Length of Centerline = 0.265 Mi. URBAN

PROJECT ENGINEER:
ARNIE HAEVERS
OMNNI ENGINEERS
303 S. BLUEMOUND DR.
APPLETON, WI 54914

PROJECT PERSONNEL LISTED
ON PAGE 3 OF P.E. DIARY
#1 6521-02-71

NOTE: ALL COORDINATES ON THIS PLAN ARE SCALED FROM U.S.G.S. TOPOGRAPHIC MAP, APPLETON, WISCONSIN, 7.5 MINUTE QUADRANGLE, CENTRAL ZONE, FOR IDENTIFICATION ONLY.
ELEVATIONS SHOWN ON THIS PLAN ARE REFERENCED TO U.S.G.S. DATUM.

APPROVED FOR OUTAGAMIE COUNTY	
11/20/90	<u>M. J. ...</u> Commissioner
ORIGINAL PLANS PREPARED BY OMNNI ENGINEERS & SURVEYORS APPLETON, WISCONSIN	
11/15/90	<u>Dennis M. Haddock</u> Date Signature
STATE OF WISCONSIN DEPARTMENT OF TRANSPORTATION	
Surveyor: OMNNI ENGINEERS	District Checker: RGG
Designer: OMNNI ENGINEERS	C.O. Checker: ENB
District Supervisor: J.C.L.	C.O. Coordinator: MTH
Approved:	
DATE: 8/29/91	<u>James Lamm</u> District Director
Approved:	
DATE: 10/7/91	<u>R. Mor</u> State Traffic Engineer for HWYS.
Approved:	
DATE: 11/3/91	<u>James Smith</u> Regional Chief Road Design Engineer
U.S. DEPARTMENT OF TRANSPORTATION FEDERAL HIGHWAY ADMINISTRATION REGION 5 WISCONSIN DIVISION	
Approved:	
Date: _____	

A-12

A-12

GENERAL NOTES

THE LOCATIONS OF EXISTING AND PROPOSED UTILITY FACILITIES AS SHOWN ON THE PLANS ARE APPROXIMATE. THERE MAY BE OTHER UTILITY FACILITIES WITHIN THE PROJECT AREA THAT ARE NOT SHOWN.

NO TREES OR SHRUBS ARE TO BE REMOVED WITHOUT APPROVAL OF THE ENGINEER.

THE ALLOWANCE USED FOR EXPANDING THE FILLS TO COMPUTE THE VOLUME OF MATERIAL REQUIRED IS 30%.

WHEN THE QUANTITY OF ITEMS OF SUBBASE, BASE OR SURFACE COURSE IS MEASURED FOR PAYMENT BY THE TON, THE DEPTH OF THICKNESS OF THE COURSE SHOWN ON THE PLANS IS APPROXIMATE AND THE ACTUAL THICKNESS WILL DEPEND ON THE DISTRIBUTION OF MATERIAL AS DIRECTED BY THE ENGINEER.

THE COST OF CONNECTING EXISTING STORM SEWERS OR DRAINAGE STRUCTURES TO NEW STORM SEWER SHALL BE INCIDENTAL TO OTHER CONSTRUCTION ITEMS. STORM SEWER FITTINGS, SUCH AS TEES AND BENDS, WILL BE PAID FOR AT THE CONTRACT UNIT PRICE PER LINEAR FOOT FOR REINFORCED CONCRETE PIPE (CLASS III) STORM SEWER OF THE SAME DIAMETER.

INLET AND DISCHARGE ELEVATIONS FOR DRAINAGE STRUCTURES SHOWN ARE APPROXIMATE AND SHALL BE DETERMINED BY THE ENGINEER IN THE FIELD.

CURB HEIGHTS AT THE ENDS OF CURB AND GUTTER SHALL BE TAPERED FROM 6 TO 0 INCHES IN 3 FEET, WHERE APPLICABLE.

ALL DISTURBED AREAS ARE TO BE TOPSOILED, FERTILIZED, SEEDED AND MULCHED. SEED SHALL BE MIXTURE NO. 40. FERTILIZER SHALL BE TYPE "B".

IF EXCAVATION BELOW SUBGRADE IS REQUIRED, IT WILL BE MEASURED AND PAID FOR AS UNCLASSIFIED EXCAVATION. THE LIMITS OF E.B.S. WILL BE DETERMINED BY THE ENGINEER IN THE FIELD.

THE EXACT LOCATION AND LIMITS OF PRIVATE ENTRANCES, FIELD ENTRANCES AND COMMERCIAL ENTRANCES SHALL BE DETERMINED BY THE ENGINEER IN THE FIELD.

THE EXACT LOCATIONS OF ALL EROSION CONTROL ITEMS SHALL BE DETERMINED BY THE ENGINEER IN THE FIELD.

ALL SILT FENCE, DELIVERED, SHALL MEET THE REQUIREMENTS OF SILTY SOILS.

THE QUANTITY OF SALVAGED TOPSOIL WAS COMPUTED FROM MEASUREMENTS BETWEEN THE FINISHED SUBGRADE SHOULDER POINTS OR BACK OF CURB AND THE SLOPE INTERCEPTS AS SHOWN ON THE CROSS SECTIONS PLUS 5 FEET PER STATION FOR ROUNDING.

CURB RAMP OPENINGS AS SHOWN ON THE PLANS ARE APPROXIMATE. THE EXACT LOCATIONS SHALL BE GIVEN BY THE ENGINEER IN THE FIELD.

PROPERTY LINES AS SHOWN ARE APPROXIMATE.

WHERE SLOPE INTERCEPT LINES FALL OUTSIDE OF THE EXISTING RIGHT-OF-WAY, TEMPORARY LIMITED EASEMENTS TO ACCOMPLISH CONSTRUCTION WORK WITHIN THE SLOPE INTERCEPTS HAVE BEEN OBTAINED. THESE RIGHTS ARE EXTENDED TO THE CONTRACTOR.

LANDMARK REFERENCE MONUMENTS SHALL BE TYPE "D".

ALL SINGLE AGGREGATE ASPHALTIC PAVEMENT SHALL BE TYPE D1.

COUNTY SURVEYOR OR SURVEY CONTACT PERSON.

MR. FRANK M. CHARLESWORTH
OUTAGAMIE COUNTY COURT HOUSE
410 S. WALNUT STREET
APPLETON, WISCONSIN 54911
TELEPHONE: (414) 832-5255

STANDARD ABBREVIATIONS

AH.	AHEAD	N.	NORTH
A.D.T.	AVERAGE DAILY TRAFFIC	NORM.	NORMAL
ASPH.	ASPHALT	NO.	NUMBER
B.M.	BENCH MARK	PAV'T.	PAVEMENT
BK.	BACK	P.E.	PRIVATE ENTRANCE
C.	CENTERLINE	P.I.	POINT OF INTERSECTION
CL.	CLASS	P.K.	PARKER-KALON FASTENER
CONC.	CONCRETE	P.L.	PROPERTY LINE
C.P.C.P.	CORRUGATED PLASTIC CULVERT PIPE	P.O.T.	POINT OF TANGENCY
C.S.C.P.	CORRUGATED STEEL CULVERT PIPE	R.	RADIUS
C.T.H.	COUNTY TRUNK HIGHWAY	R.C.P.	REINFORCED CONCRETE PIPE
C.Y.	CUBIC YARD	R.C.P.S.S.	REINFORCED CONCRETE PIPE STORM SEWER
CWT.	HUNDRED WEIGHT	RD.	ROAD
D.H.V.	DESIGN HOUR VOLUME	REQ'D.	REQUIRED
D.	DIRECTIONAL SPLIT	RT.	RIGHT
DWY.	DRIVEWAY	R/W	RIGHT-OF-WAY
E.	EAST	SHLDR.	SHOULDER
EA.	EACH	S.	SOUTH
EL.	ELEVATION	S.F.	SQUARE FEET
EOP.	EDGE OF PAVEMENT	S.Y.	SQUARE YARD
F.L.	FLOWLINE	§	SURVEY LINE
FLG.	FLANGE	S.T.H.	STATE TRUNK HIGHWAY
'/, FT./FT.	FOOT PER FOOT	STA.	STATION
IN.	INCH	T.	PERCENT TRUCK TRAFFIC
LB.	POUND	TYP.	TYPICAL
L.F.	LINEAR FOOT	UNCL.	UNCLASSIFIED
L.S.	LUMP SUM	U.S.H.	UNITED STATES HIGHWAY
LT.	LEFT	V.	DESIGN SPEED
M.H.	MANHOLE	V.C.	VERTICAL CURVE
MAX.	MAXIMUM	VAR.	VARIABLE
MI.	MILE	W.	WEST
M.P.H.	MILE PER HOUR		
MIN.	MINIMUM		


UTILITIES

ELECTRIC	WISCONSIN ELECTRIC POWER COMPANY P.O. BOX 1699 APPLETON, WISCONSIN 54913 ATT: BUDGET ENGINEERING SUPERVISOR TELEPHONE: (414) 735-8445
TELEPHONE	WISCONSIN BELL, INC. 221 W. WASHINGTON STREET FOURTH FLOOR, OSPE APPLETON, WISCONSIN 54911 ATT: MR. MICHAEL LOOMIS CABLE LOCATE: (800) 242-8511 (TOLL FREE)
GAS	WISCONSIN NATURAL GAS COMPANY 800 SOUTH LYNNDAL DRIVE APPLETON, WISCONSIN 54914 ATT: MR. J. G. HERB TELEPHONE: (414) 735-8357
CABLE TV	CABLEVISION OF THE FOX CITIES 1620 SOUTH LAWE STREET APPLETON, WISCONSIN 54915 ATT: MR. STEVE GUSTAVUS TELEPHONE: (414) 738-3160
SANITARY SEWERS & WATERMAINS	TOWN OF GRAND CHUTE SANITARY DISTRICTS NO. 1 AND NO. 2 P.O. BOX 1192 APPLETON, WISCONSIN 54912 ATT: MR. DOUG HUNTOON TELEPHONE: (414) 832-1581
DIGGERS HOTLINE	CABLE LOCATE TELEPHONE: (800) 242-8511 (TOLL FREE)

STANDARD DETAIL DRAWINGS


8A5-8a & b	INLET COVERS
8A5-8c	MANHOLE COVERS
8B6-3	MANHOLES, TYPE 1
8C1-4	INLETS, TYPES 1, 2, AND 3
8D1-11	CONCRETE CURB, CONCRETE CURB AND GUTTER AND PAVEMENT TIES
8D4-3	CONCRETE SURFACE DRAIN & ASPHALTIC FLUME
8D5-8	CURB RAMPS
8E9-3	SILT FENCE
8F1-10a	APRON ENDWALLS FOR CULVERT PIPE
9B2-4	CONDUIT
9B3-5	CONCRETE BASES
9B6-2	CAST BASES
9B9-2	CONCRETE CONTROL CABINET BASES
9B10-2	PULL BOX
9B11-1a	POLE MOUNTINGS FOR TRAFFIC SIGNALS, TYPE 2
9B11-1b	HARDWARE DETAILS FOR POLE MOUNTINGS
15C2-2	BARRICADES AND TRAFFIC CONTROL FOR ROAD CLOSURES
15C7-1	PAVEMENT MARKING SYMBOLS
15C8-3	PAVEMENT MARKING
16A1-4	LANDMARK REFERENCE MONUMENTS AND COVERS
8C5-1	INLETS, TYPE 8, 9, 10 & 11

STATE PROJECT NUMBER	SHEET NO.
6521-2-71	2.1
TYPICAL CROSS SECTIONS FOR	
C.T.H. "A"	OUTAGAMIE COUNTY

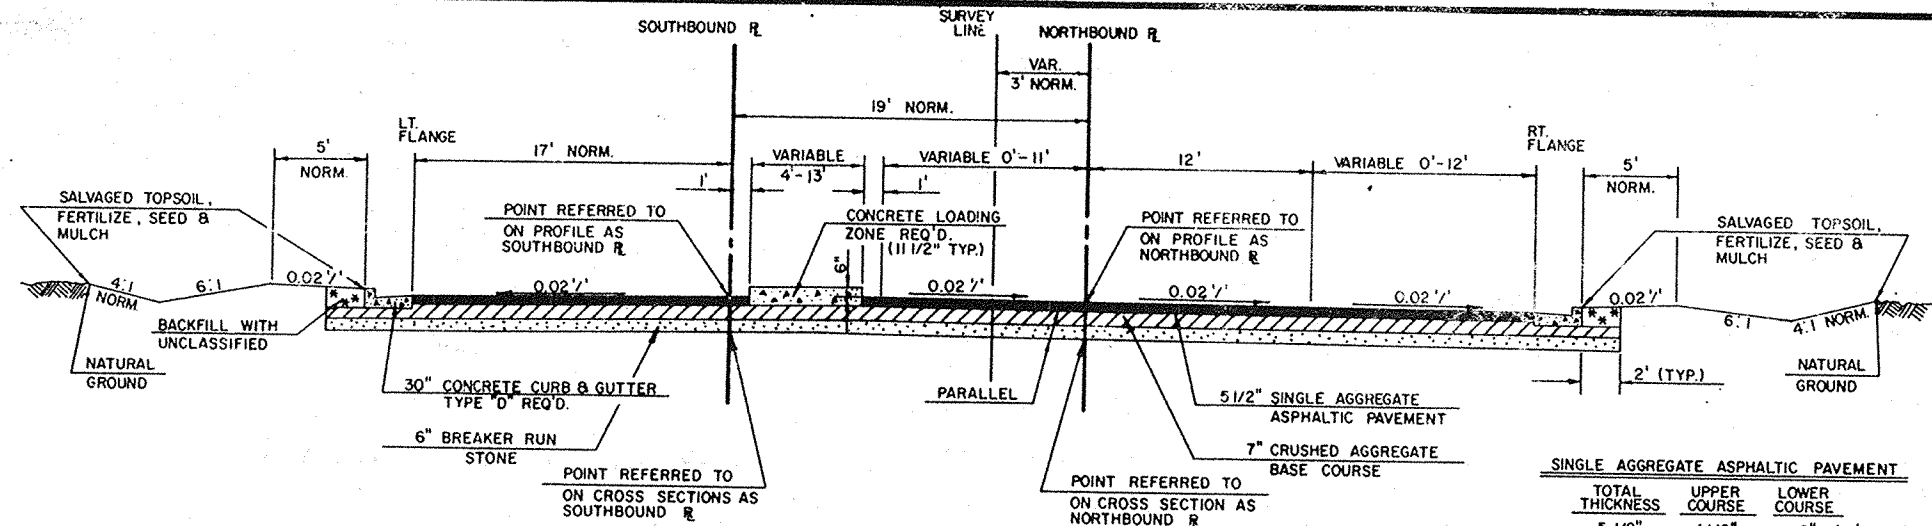

TYPICAL FINISHED CROSS SECTION FOR LYNNDALE DRIVE


STA. 4"SB" + 00 TO STA. 9"SB" + 19
STA. 7"NB" + 50 TO STA. 9"NB" + 22
STA. 10"SB" + 78 TO STA. 12"SB" + 00

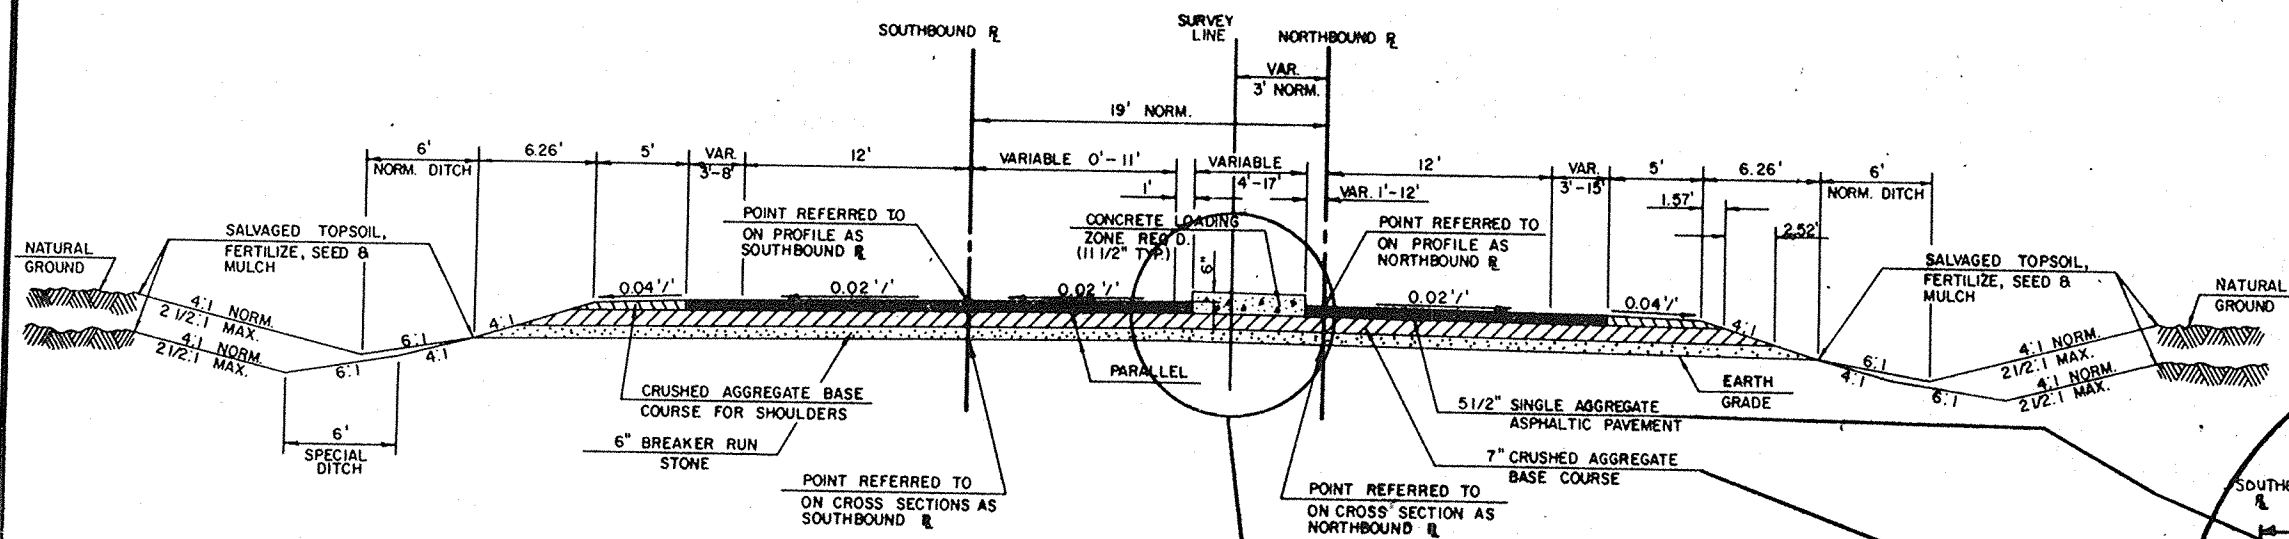

TYPICAL FINISHED CROSS SECTION FOR LYNNDALE DRIVE


STA. 3"SB" + 00 TO STA. 4"SB" + 00
STA. 3"NB" + 00 TO STA. 7"NB" + 50
STA. 12"SB" + 00 TO STA. 17"SB" + 00
STA. 10"NB" + 81 TO STA. 17"NB" + 00

NOTE: TERRACE WILL BE ELIMINATED
FROM STA. 44+05 TO STA. 46+50, RT.

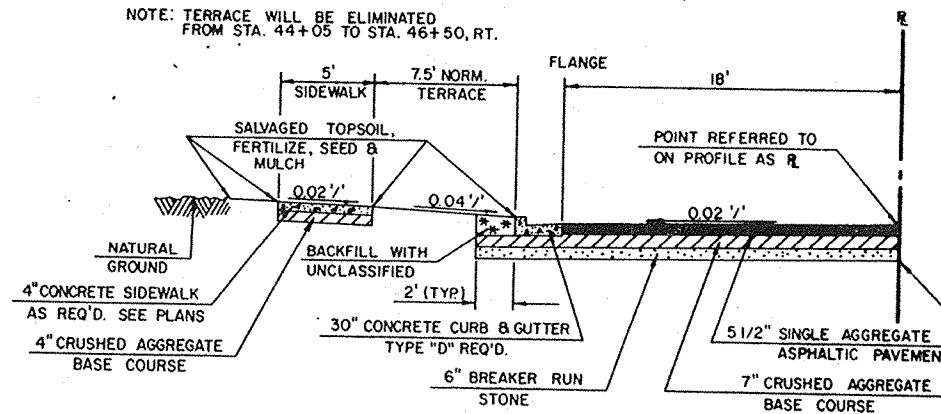


1/2 TYPICAL FINISHED CROSS SECTION FOR CAPITOL DRIVE

STA. 40+33 TO STA. 42+30, LT.
STA. 40+75 TO STA. 42+22, RT.
STA. 44+01 TO STA. 45+40, LT.
STA. 44+05 TO STA. 46+50, RT.

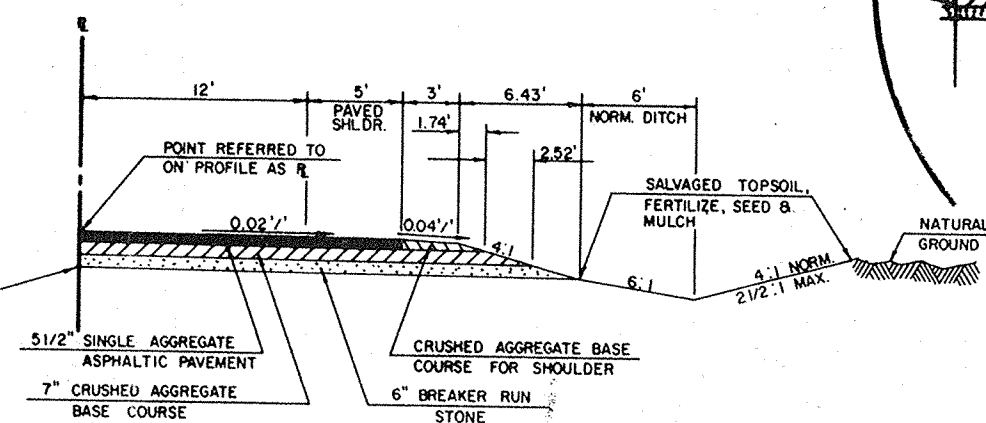



1/2 TYPICAL FINISHED CROSS SECTION FOR CAPITOL DRIVE

STA. 40+15 TO STA. 40+75, RT.
STA. 45+40 TO STA. 47+00, LT.

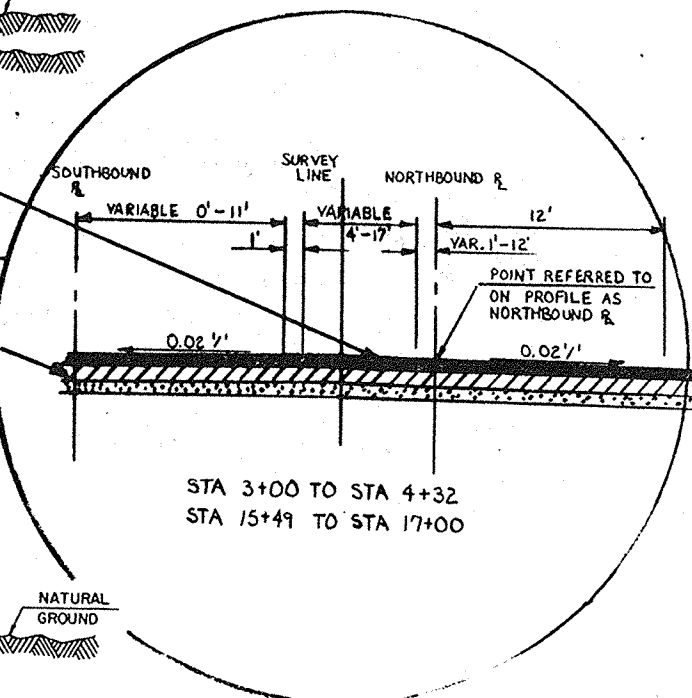


STA. 3+00 TO STA. 4+32
STA. 15+49 TO STA. 17+00


STATE PROJECT NUMBER	SHEET NO.
6521-2-71	2.2
CONSTRUCTION DETAILS FOR	
C.T.H. "A"	OUTAGAMIE COUNTY

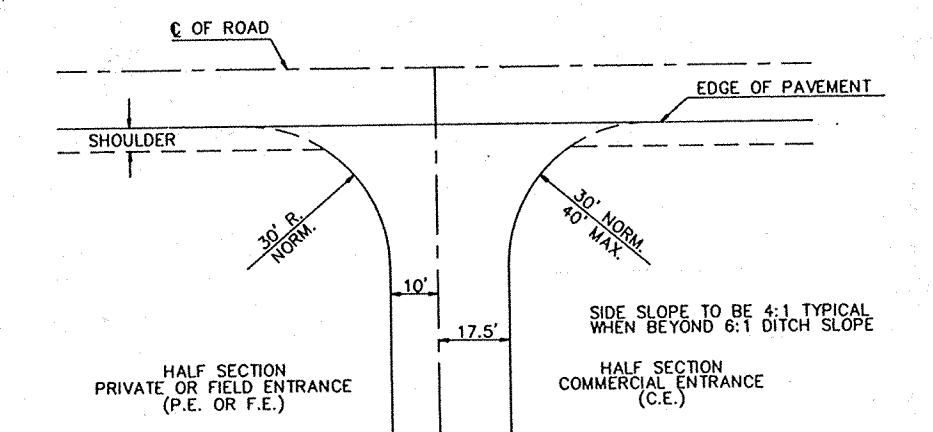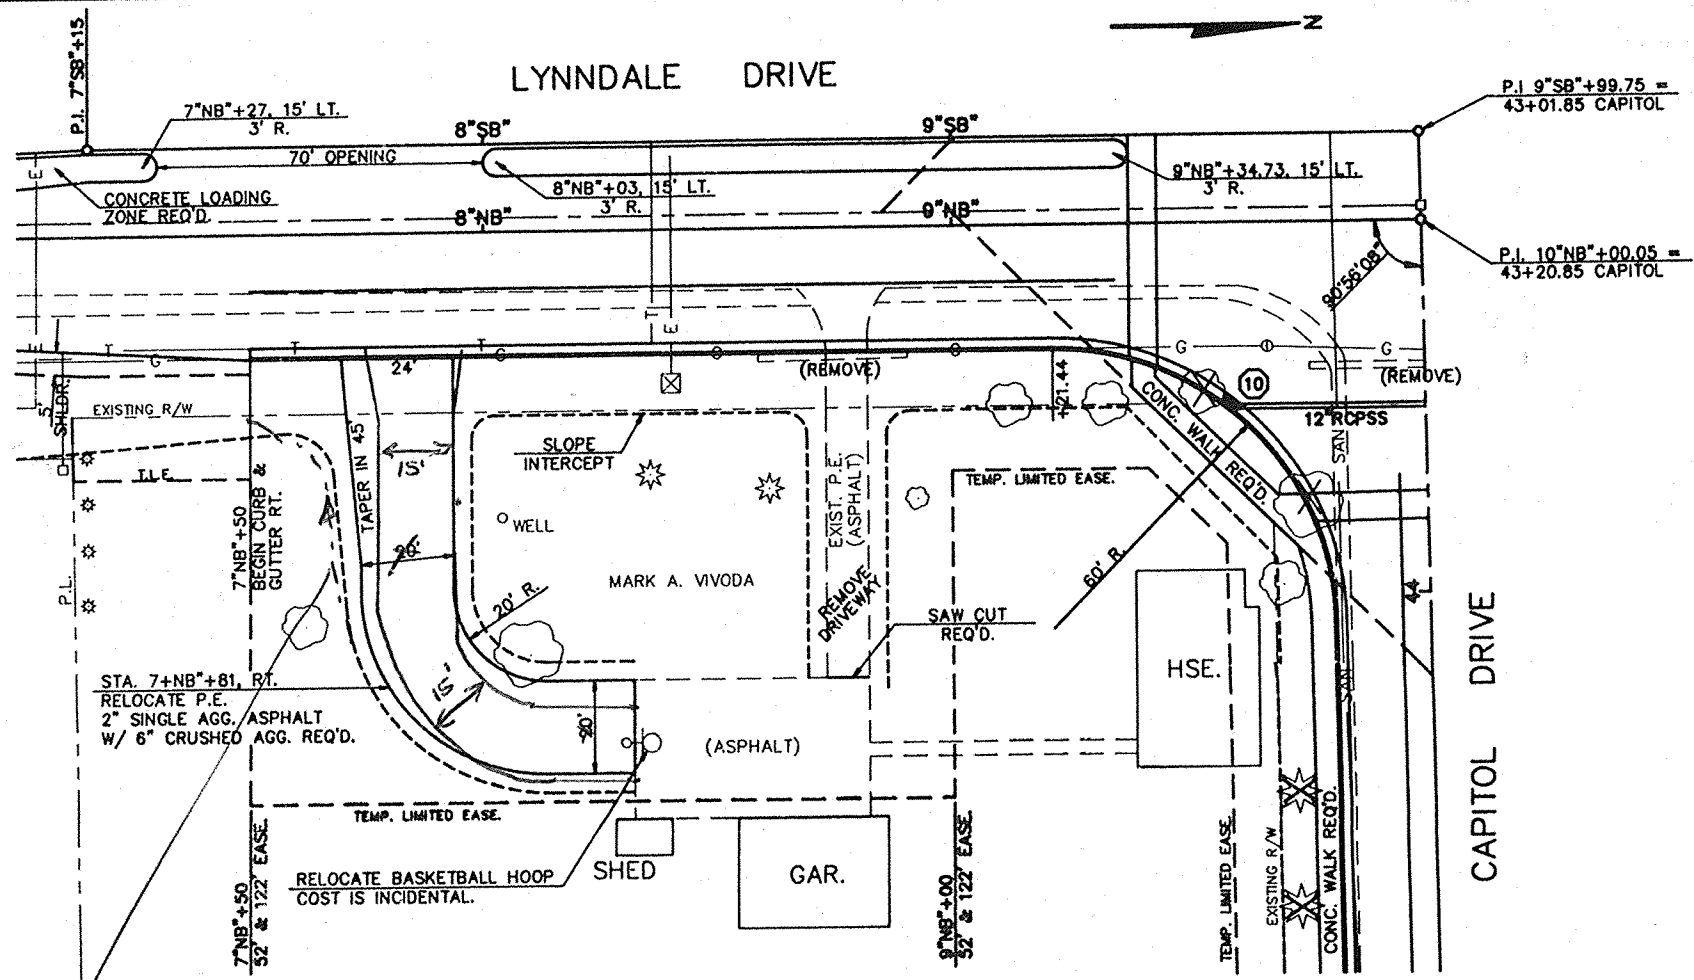


PLAN OF ENTRANCE

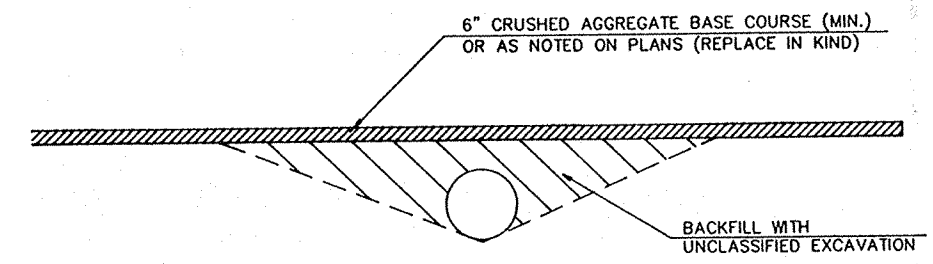


PROFILE OF ENTRANCE

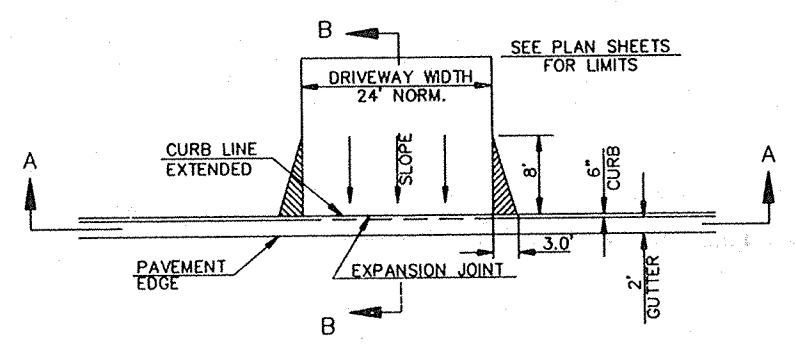

DRIVEWAY DETAIL

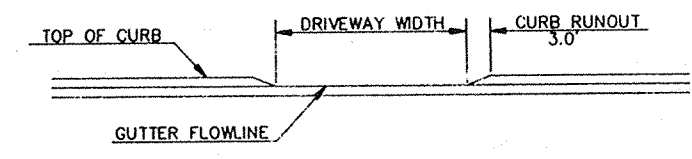


SECTION A-A

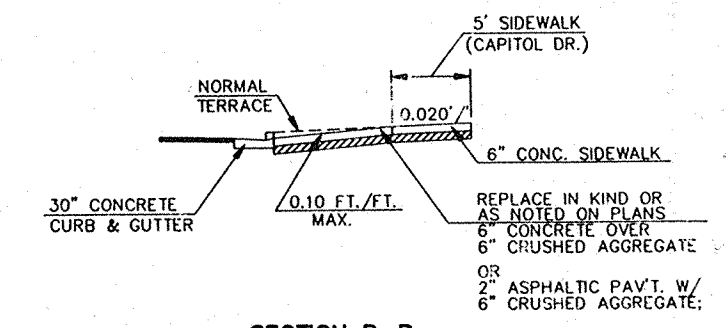


SECTION B-B

SWINE FOR
YARD DRAINAGE


STATE PROJECT NUMBER	SHEET NO.
6521-2-71	2.3
CONSTRUCTION DETAILS FOR OUTAGAMIE COUNTY	
C.T.H. "A"	

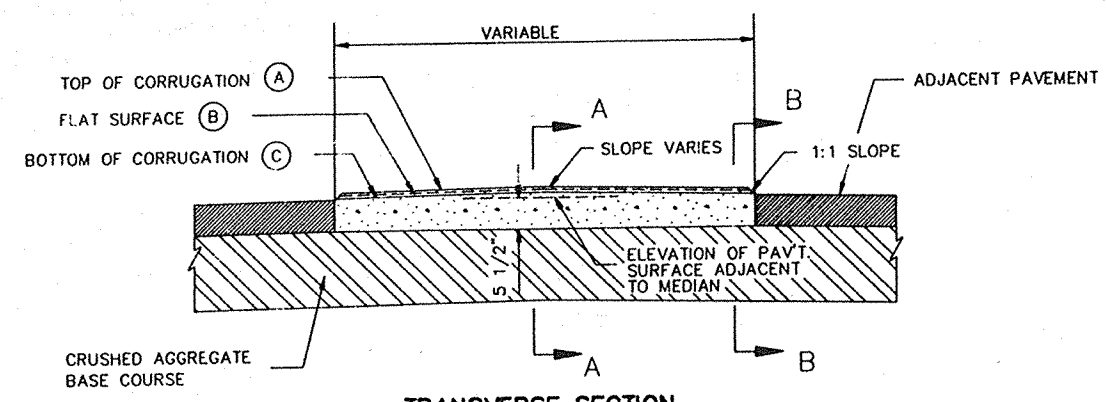


TRANSVERSE SECTION

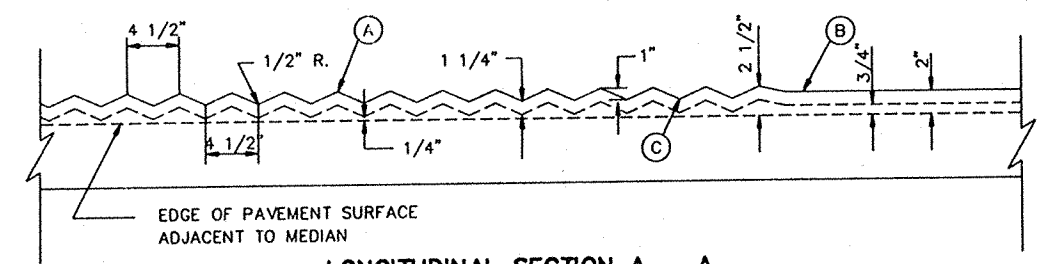


LONGITUDINAL SECTION A - A

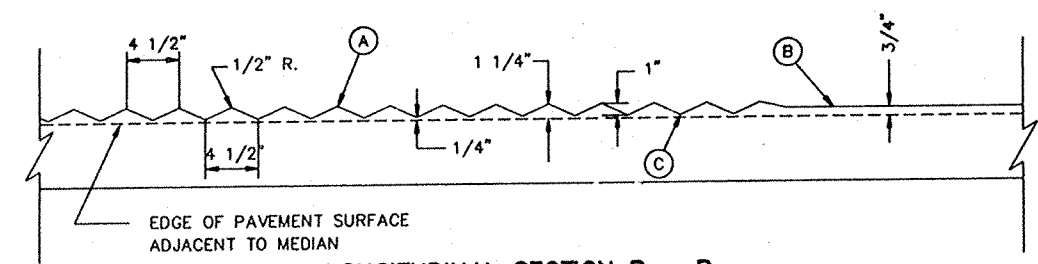


LONGITUDINAL SECTION B - B

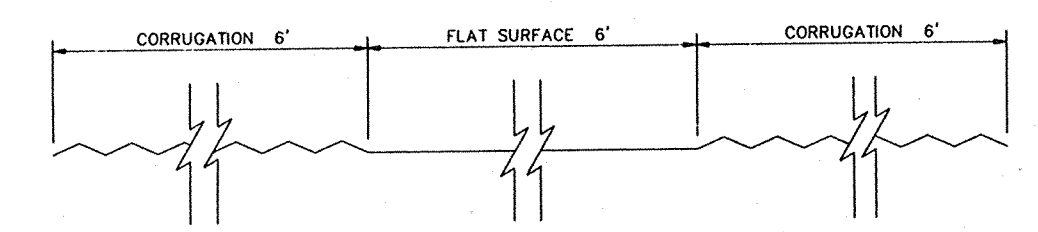


**PROFILE ALONG TOP OF PROPOSED MEDIAN
CONCRETE CORRUGATED MEDIAN**

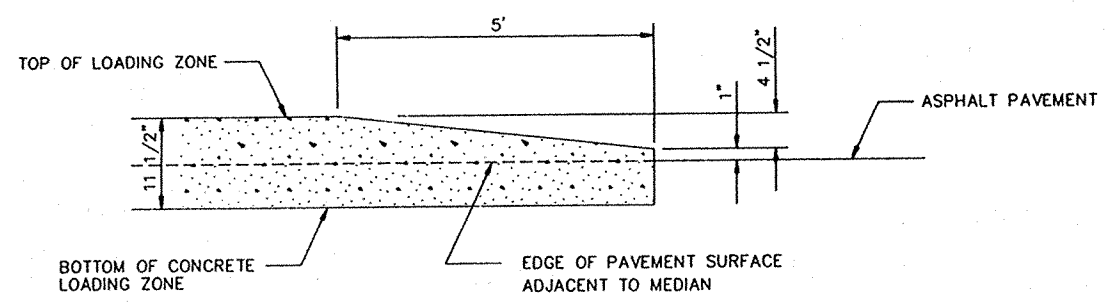


CONCRETE MEDIAN NOSE DETAIL

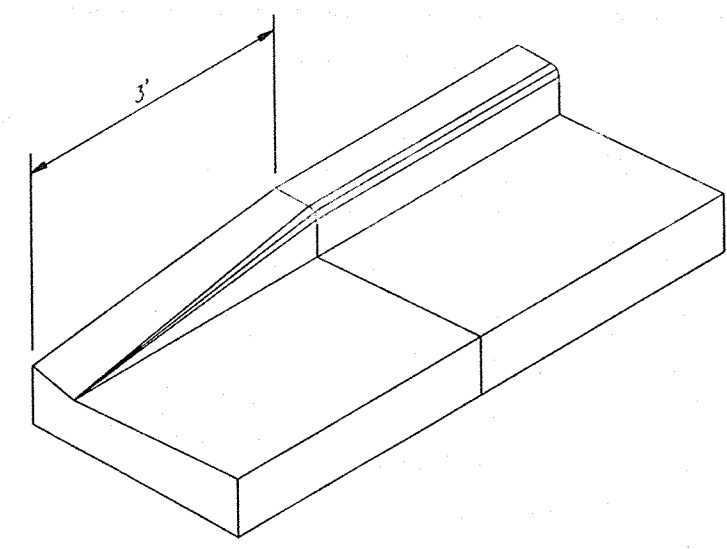


CURB & GUTTER TERMINI DETAIL

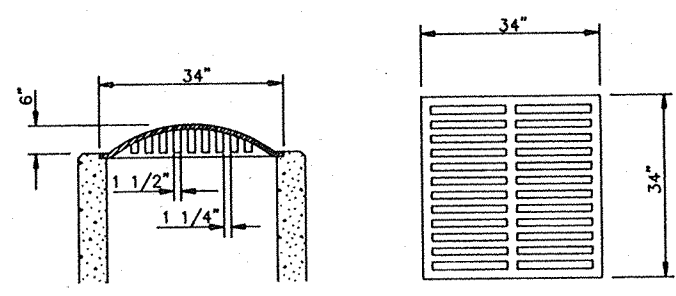


SPECIAL DITCH GRATE
34" X 34", APPROXIMATE WEIGHT 190 LBS.

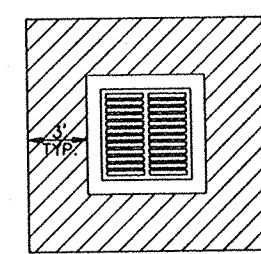

SOD AT INLET

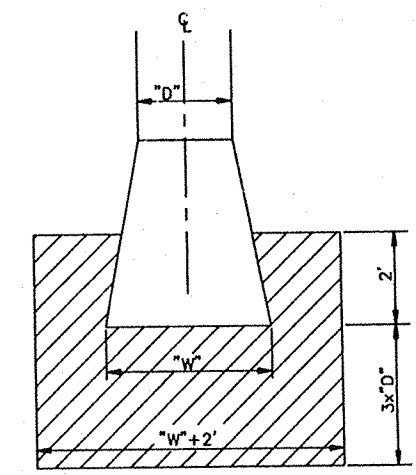


SOD AT PIPE END DETAIL

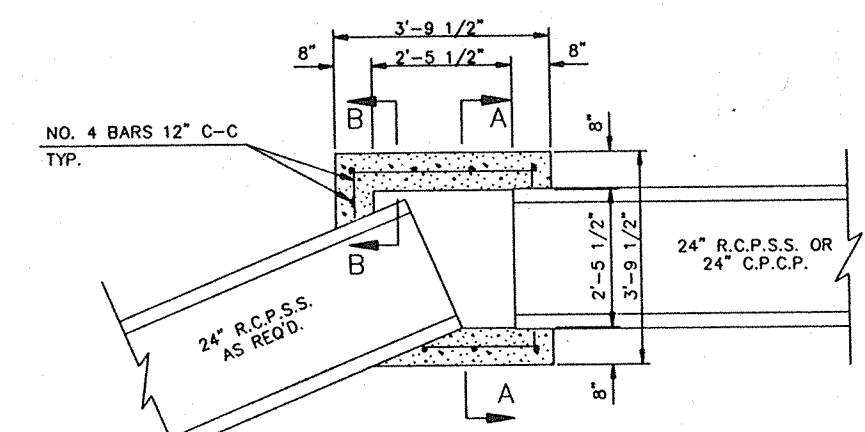


**PLAN VIEW
SPECIAL INLET**

STA. 47+12, CAPITOL DRIVE, LT.
STA. 47+85 CAPITOL DRIVE, RT.

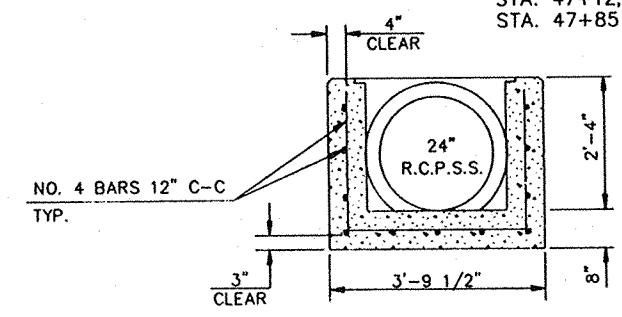


SECTION A-A

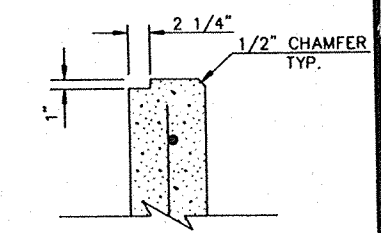

SECTION B-B

STORM SEWER SCHEMATIC

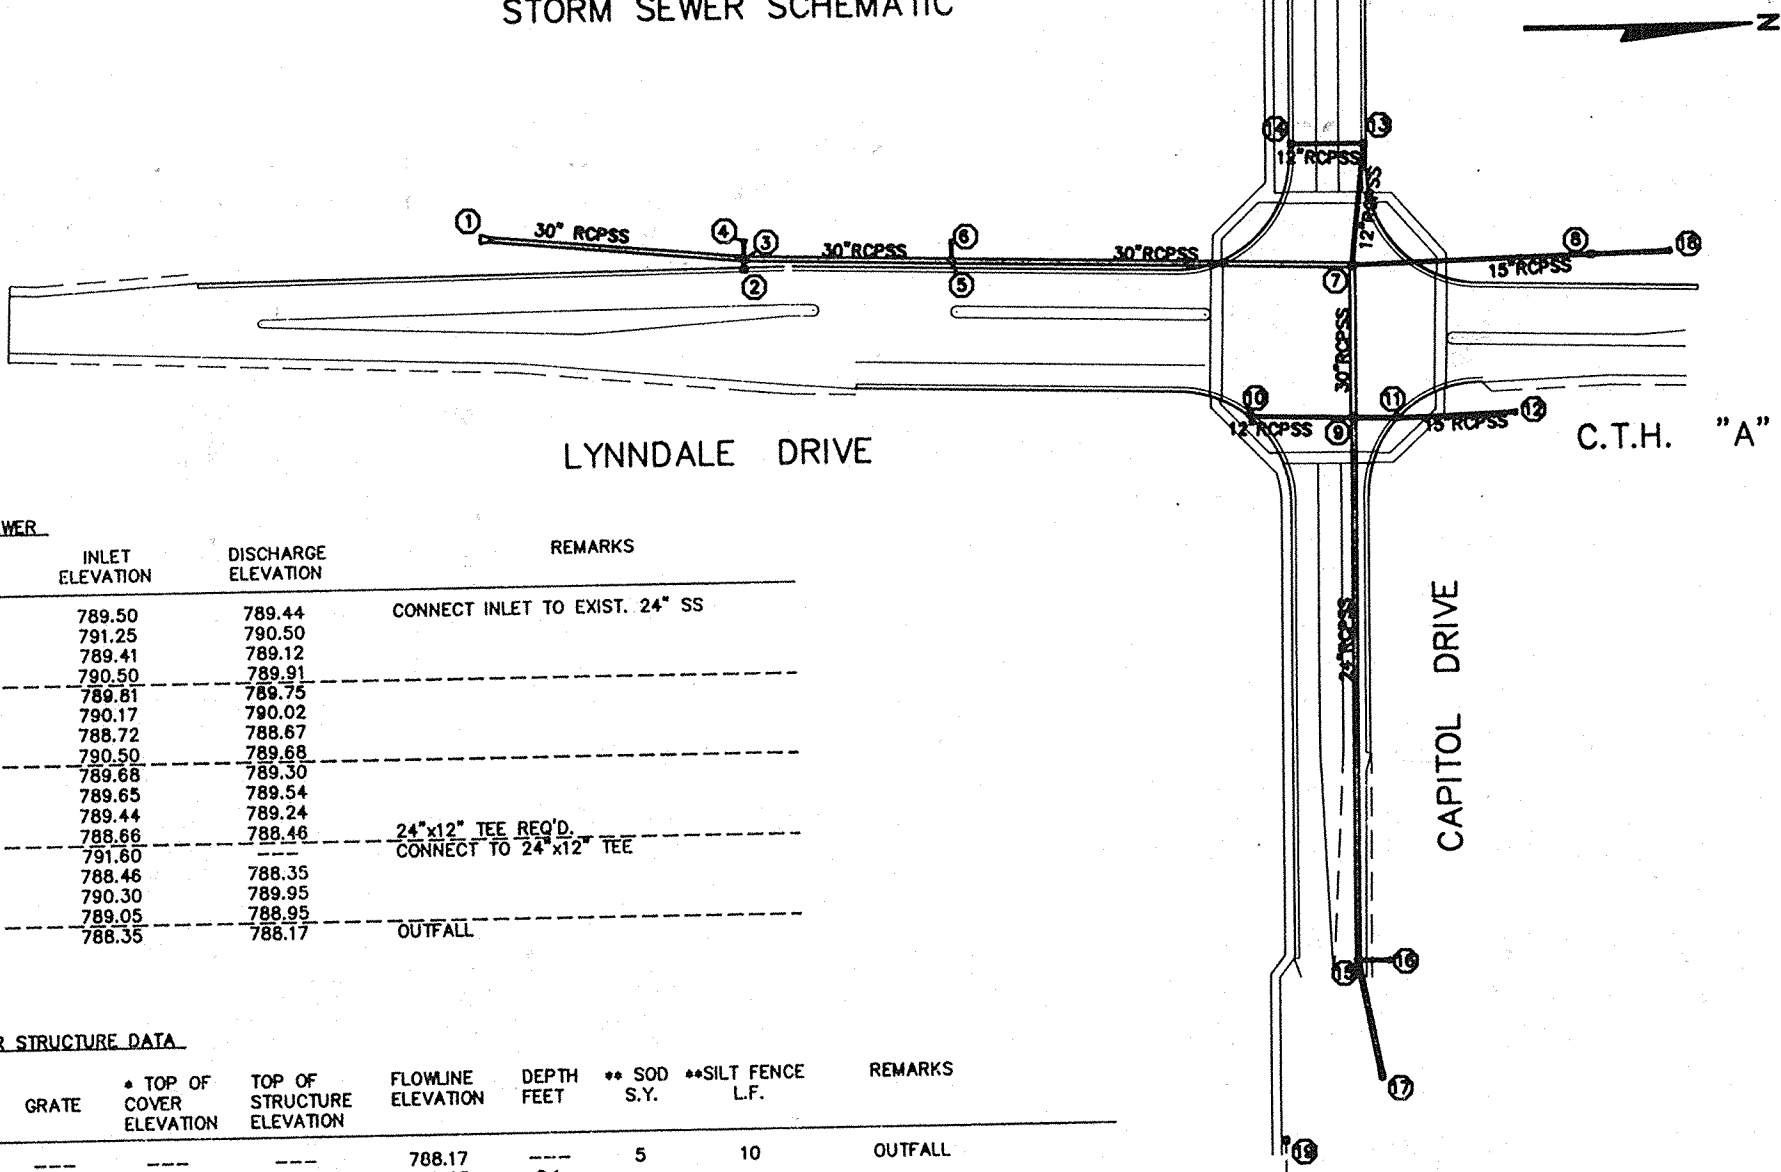

LOCATION		DIAMETER INCHES	LENGTH LIN. FT.	TYPE	INLET ELEVATION	DISCHARGE ELEVATION	REMARKS
FROM	TO						
17	15	24	62	R.C.P. CL. IV S.S.	789.50	789.44	CONNECT INLET TO EXIST. 24" SS
16	15	15	13	R.C.P. CL. IV S.S.	791.25	790.50	
15	9	24	286	R.C.P. CL. IV S.S.	789.41	789.12	
12	11	15	63	R.C.P. CL. IV S.S.	790.50	789.91	
11	9	15	19	R.C.P. CL. IV S.S.	789.81	789.75	
10	9	12	50	R.C.P. CL. IV S.S.	790.17	790.02	
9	7	30	77	R.C.P. CL. IV S.S.	788.72	788.67	
18	8	15	39	R.C.P. CL. IV S.S.	790.50	789.68	
8	7	15	124	R.C.P. CL. IV S.S.	789.68	789.30	
14	13	12	36	R.C.P. CL. IV S.S.	789.65	789.54	
13	7	12	61	R.C.P. CL. IV S.S.	789.44	789.24	
7	5	30	214	R.C.P. CL. IV S.S.	788.66	788.46	
6	5	12	6	R.C.P. CL. IV S.S.	791.60	789.60	24"x12" TEE REQ'D. CONNECT TO 24"x12" TEE
5	3	30	110	R.C.P. CL. IV S.S.	788.46	788.35	
4	3	12	7	R.C.P. CL. IV S.S.	790.30	789.95	
2	3	12	3	R.C.P. CL. IV S.S.	789.05	788.95	OUTFALL
3	1	30	138	R.C.P. CL. IV S.S.	788.35	788.17	

STORM SEWER STRUCTURE DATA															
STRUCTURE NO.	STATION	LOCATION	STRUCTURE	STRUCTURE TYPE	COVER	GRATE	* TOP OF COVER ELEVATION	TOP OF STRUCTURE ELEVATION	FLOWLINE ELEVATION	DEPTH FEET	** SOD S.Y.	**SILT FENCE L.F.	REMARKS		
1	5+50	C.T.H. "A"	SURVEY TL 48' LT.	ENDWALL	30-INCH	---	---	---	788.17	---	5	10	OUTFALL		
2	6+90	C.T.H. "A"	SURVEY TL 34' LT.	INLET	3	H ***	LEFT	791.86	791.16	789.05	2.1	---		---	
3	6+90	C.T.H. "A"	SURVEY TL 39' LT.	MANHOLE	1	J	---	792.40	791.30	788.35	3.0	---		---	
4	6+90	C.T.H. "A"	SURVEY TL 49' LT.	ENDWALL	12-INCH	---	---	---	---	790.30	---	2	10	---	
5	8+00	C.T.H. "A"	SURVEY TL 39' LT.	24"x12" TEE	---	---	---	---	---	788.46	---	---	---	---	
6	8+00	C.T.H. "A"	SURVEY TL 48' LT.	ENDWALL	12-INCH	---	---	---	---	791.60	---	2	10	---	
7	10+14	C.T.H. "A"	SURVEY TL 39' LT.	MANHOLE	3	J	---	793.02	791.92	788.66	3.3	---	---	---	
8	11+40	C.T.H. "A"	SURVEY TL 42' LT.	INLET	8	MS	---	791.70	790.83	789.68	1.2	8	10	---	
9	10+14	C.T.H. "A"	SURVEY TL 42' RT.	MANHOLE	1	J	---	792.87	791.77	788.72	3.1	---	---	---	
10	9+61	C.T.H. "A"	SURVEY TL 43' RT.	INLET	3	H	RIGHT	792.23	791.53	790.17	1.4	---	---	---	
11	10+36	C.T.H. "A"	SURVEY TL 42' RT.	INLET	3	H	LEFT	792.40	791.70	789.81	1.9	---	---	---	
12	11+00	C.T.H. "A"	SURVEY TL 38' RT.	ENDWALL	15-INCH	---	---	---	---	790.50	---	2	10	---	
13	42+15	CAPITOL DR.	18' LT.	INLET	3	H ***	LEFT	792.16	791.46	789.44	2.0	---	---	---	
14	42+15	CAPITOL DR.	18' RT.	INLET	3	H	LEFT	792.16	791.46	789.65	1.8	---	---	---	
15	46+50	CAPITOL DR.	13' LT.	MANHOLE	1	J	---	794.03	792.93	789.41	3.5	---	---	---	
16	46+50	CAPITOL DR.	20' LT.	ENDWALL	15-INCH	---	---	---	---	791.25	---	2	10	---	
17	47+12	CAPITOL DR.	25' LT.	SPECIAL INLET	---	---	SPECIAL DITCH GRATE	791.64	791.64	789.50	2.1	8	10	---	
18	11+80	C.T.H. "A"	SURVEY TL 43' LT.	ENDWALL	15-INCH	---	---	---	---	790.50	---	2	10	---	
19	47+85	CAPITOL DR.	26' RT.	SPECIAL INLET	---	---	SPECIAL DITCH GRATE	794.00	794.00	791.33	2.6	4	10	CONNECT TO EXIST. 24" C.P.C.P.	
TOTALS											35	90			

* TOP OF COVER ELEVATION FOR INLET COVERS IS OUTER FLOWLINE ELEVATION.
** QUANTITY INCLUDED ELSEWHERE.
*** SPECIAL GRATE NO. 1 REQ'D.

NOTE: STRUCTURE LOCATION REFERENCED TO SURVEY LINE.

20 CONN BLACK TAPE

BLACK TAPE

SB-1

SB-1

SB-2

A-3

A-2

C-4 North

NB-R - R

NB-R - R

SB-R - R/BLK

NB-Y - O

NB-Y - O

SB-Y - O/BLK

NB-G - G

NB-G - G

SB-G - GR/BLK

DW ϕ 8 - BLK

Y ϕ 5 - OR/RED

Y ϕ 1 - R/WH

W ϕ 8 - BLU

G ϕ 5 - BLU/RED

G ϕ 1 - GR/WH

PB Com - WH

PB ϕ 8 - R/GRE

BLACK TAPE

RED TAPE

RED TAPE

C-1 SB-3

B-3 SB-4

B-2 SB-5 D-1

SB-R - R/BLK

WB-R - R/BLK

WB-R - R/BLK

EBR - R

SB-Y - O/BLK

WB-Y - O/BLK

W-Y - O/BLK

EB-Y - O

SB-G - G/BLK

WB-G - G/BLK

W-G - G/BLK

E-G - G

DW ϕ 8 - BLK

Y ϕ 3 - R/WH

Y ϕ 3 - R/WH

W ϕ 8 - BLU

G ϕ 3 - GR/WH

G ϕ 3 - GR/WH

PB Com - WH

DW ϕ 6 - BLK

DW ϕ 6 - BLK

PB ϕ 8 - R/GRE

W ϕ 6 - BLU

W ϕ 6 - BLU

PB Com - WH

PB Com - WH

PB ϕ 6 - R/GRE

PB ϕ 6 - R/GRE

RED TAPE

SB-6

D-1

EB-R - R

EB-Y - O

EB-G - G

DW ϕ 2 - BLK/WHW ϕ 2 - BLW/WH

PB-Com - WH

PB- ϕ 2 - WH/RED

RED TAPE

SB-7

D-3

EB-R - R

EB-Y - O

EB-G - G

DW ϕ 2 - BLK/WHW ϕ 2 - BLW/WH

PB-Com - WH

PB- ϕ 2 - WH/RED

BLACK TAPE

SB-8

A-1

NB-R - R

NB-Y - O

NB-G - G

DW ϕ 4 - BLK/WHW ϕ 4 - BLW/WH

PBComm - WH

PB ϕ 4 - W/RED

BLACK TAPE

A-4 SB-9

NB-R - R

NB-Y - O

NB-G - G

Y ϕ 5 - OR/REDG ϕ 5 - BLW/RED

C-2

SB-R - R/BLK

SB-Y - O/BLK

SB-G - G/BLK

Y ϕ 1 - R/WHG ϕ 1 - GR/WH

BLACK TAPE

SB-10

C-3

SB-R - R/BLK

SB-4 - O/BLK





SB-4 - G/BLK

DW 4 - BLK/WH

W 4 - BLK/WH

PB-com - WH

PB-4 - W/RED

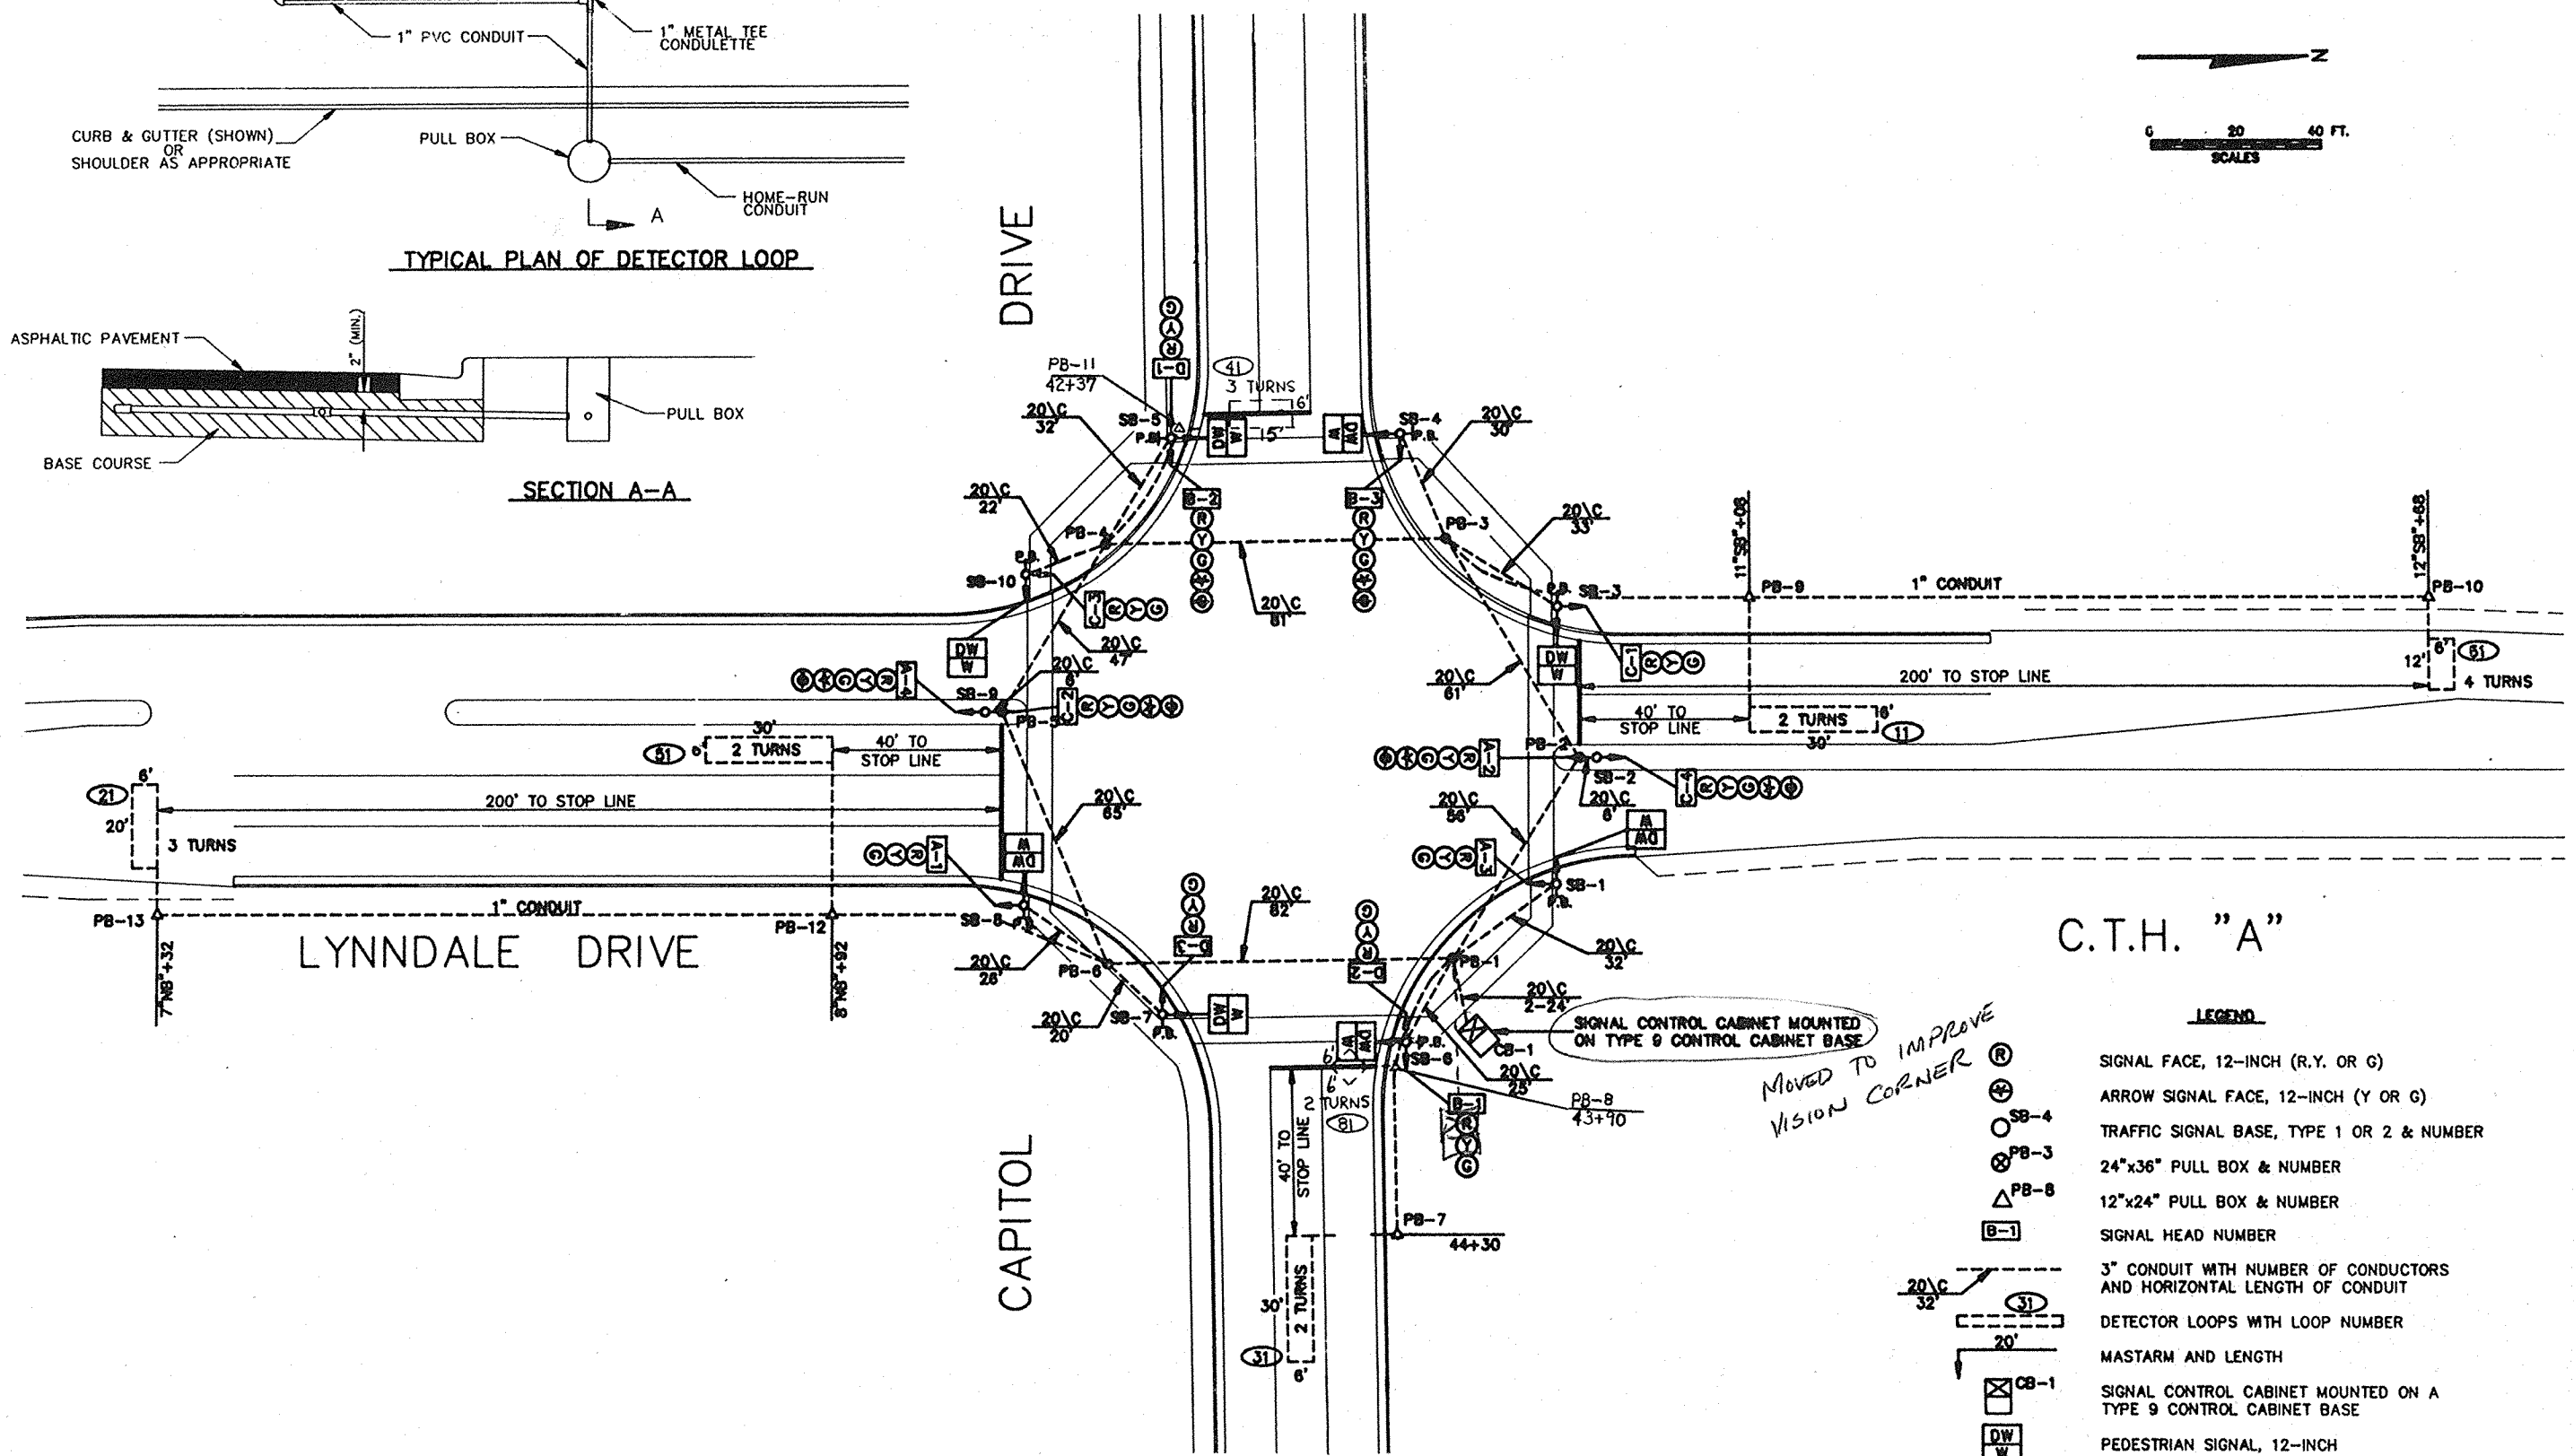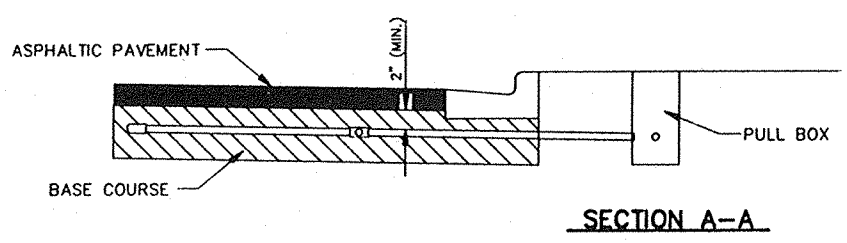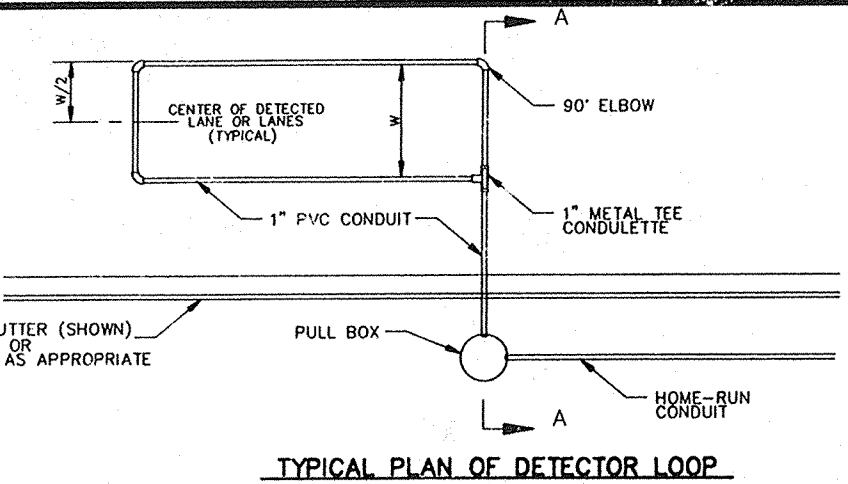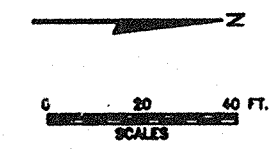







C.T.H. "A"

LEGEND

- (R) SIGNAL FACE, 12-INCH (R.Y. OR G)
- (Y) ARROW SIGNAL FACE, 12-INCH (Y OR G)
- (PB-1, PB-2, PB-3, PB-4, PB-5, PB-6, PB-7, PB-8, PB-9, PB-10, PB-11, PB-12, PB-13) TRAFFIC SIGNAL BASE, TYPE 1 OR 2 & NUMBER
- (PB-1, PB-2, PB-3, PB-4, PB-5, PB-6, PB-7, PB-8, PB-9, PB-10, PB-11, PB-12, PB-13) 24"x36" PULL BOX & NUMBER
- (PB-1, PB-2, PB-3, PB-4, PB-5, PB-6, PB-7, PB-8, PB-9, PB-10, PB-11, PB-12, PB-13) 12"x24" PULL BOX & NUMBER
- (B-1) SIGNAL HEAD NUMBER
- (3" C 32, 3" C 33, 3" C 34, 3" C 35, 3" C 99, 3" C 100) 3" CONDUIT WITH NUMBER OF CONDUCTORS AND HORIZONTAL LENGTH OF CONDUIT
- (31, 32, 33, 34, 99, 100) DETECTOR LOOPS WITH LOOP NUMBER
- (MASTARM 100, MASTARM 150, MASTARM 200, MASTARM 250, MASTARM 300, MASTARM 350, MASTARM 400, MASTARM 450, MASTARM 500, MASTARM 550, MASTARM 600, MASTARM 650, MASTARM 700, MASTARM 750, MASTARM 800, MASTARM 850, MASTARM 900, MASTARM 950, MASTARM 1000) MASTARM AND LENGTH
- (CB-1) SIGNAL CONTROL CABINET MOUNTED ON A TYPE 9 CONTROL CABINET BASE
- (DW, W, C, S) PEDESTRIAN SIGNAL, 12-INCH
- (P) PEDESTRIAN PUSHBUTTON

MOVED TO IMPROVE VISION CORNER

STATE PROJECT NUMBER	SHEET NO.
6521-2-71	2.8
CONSTRUCTION DETAILS FOR	
C.T.H. "A"	OUTAGAMIE COUNTY

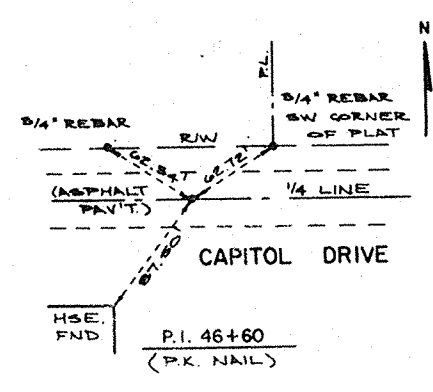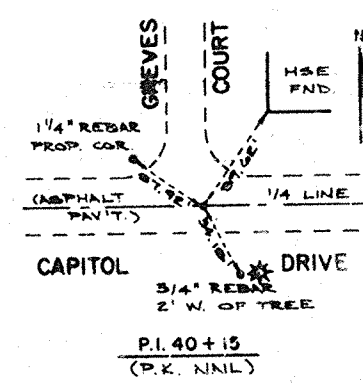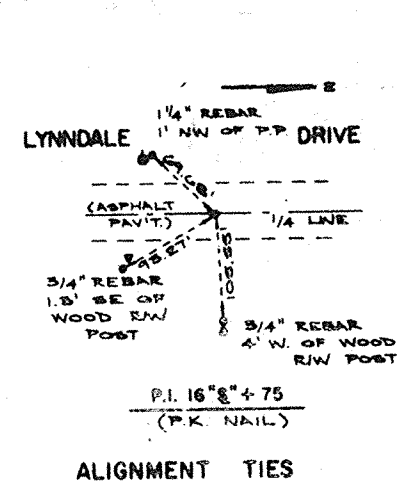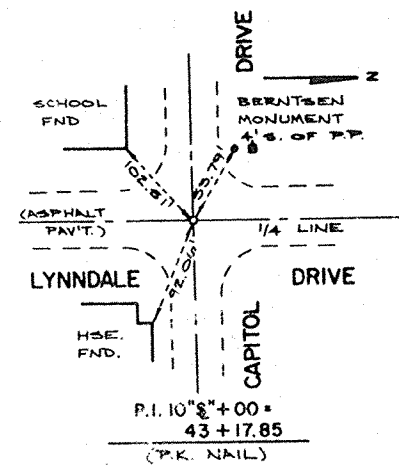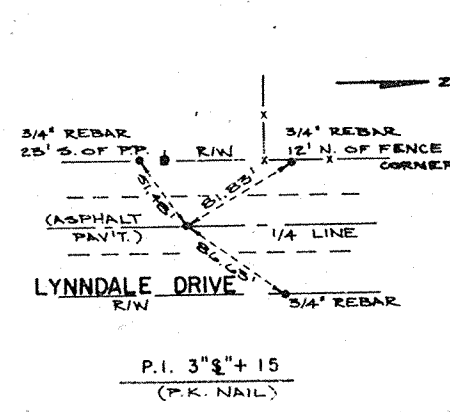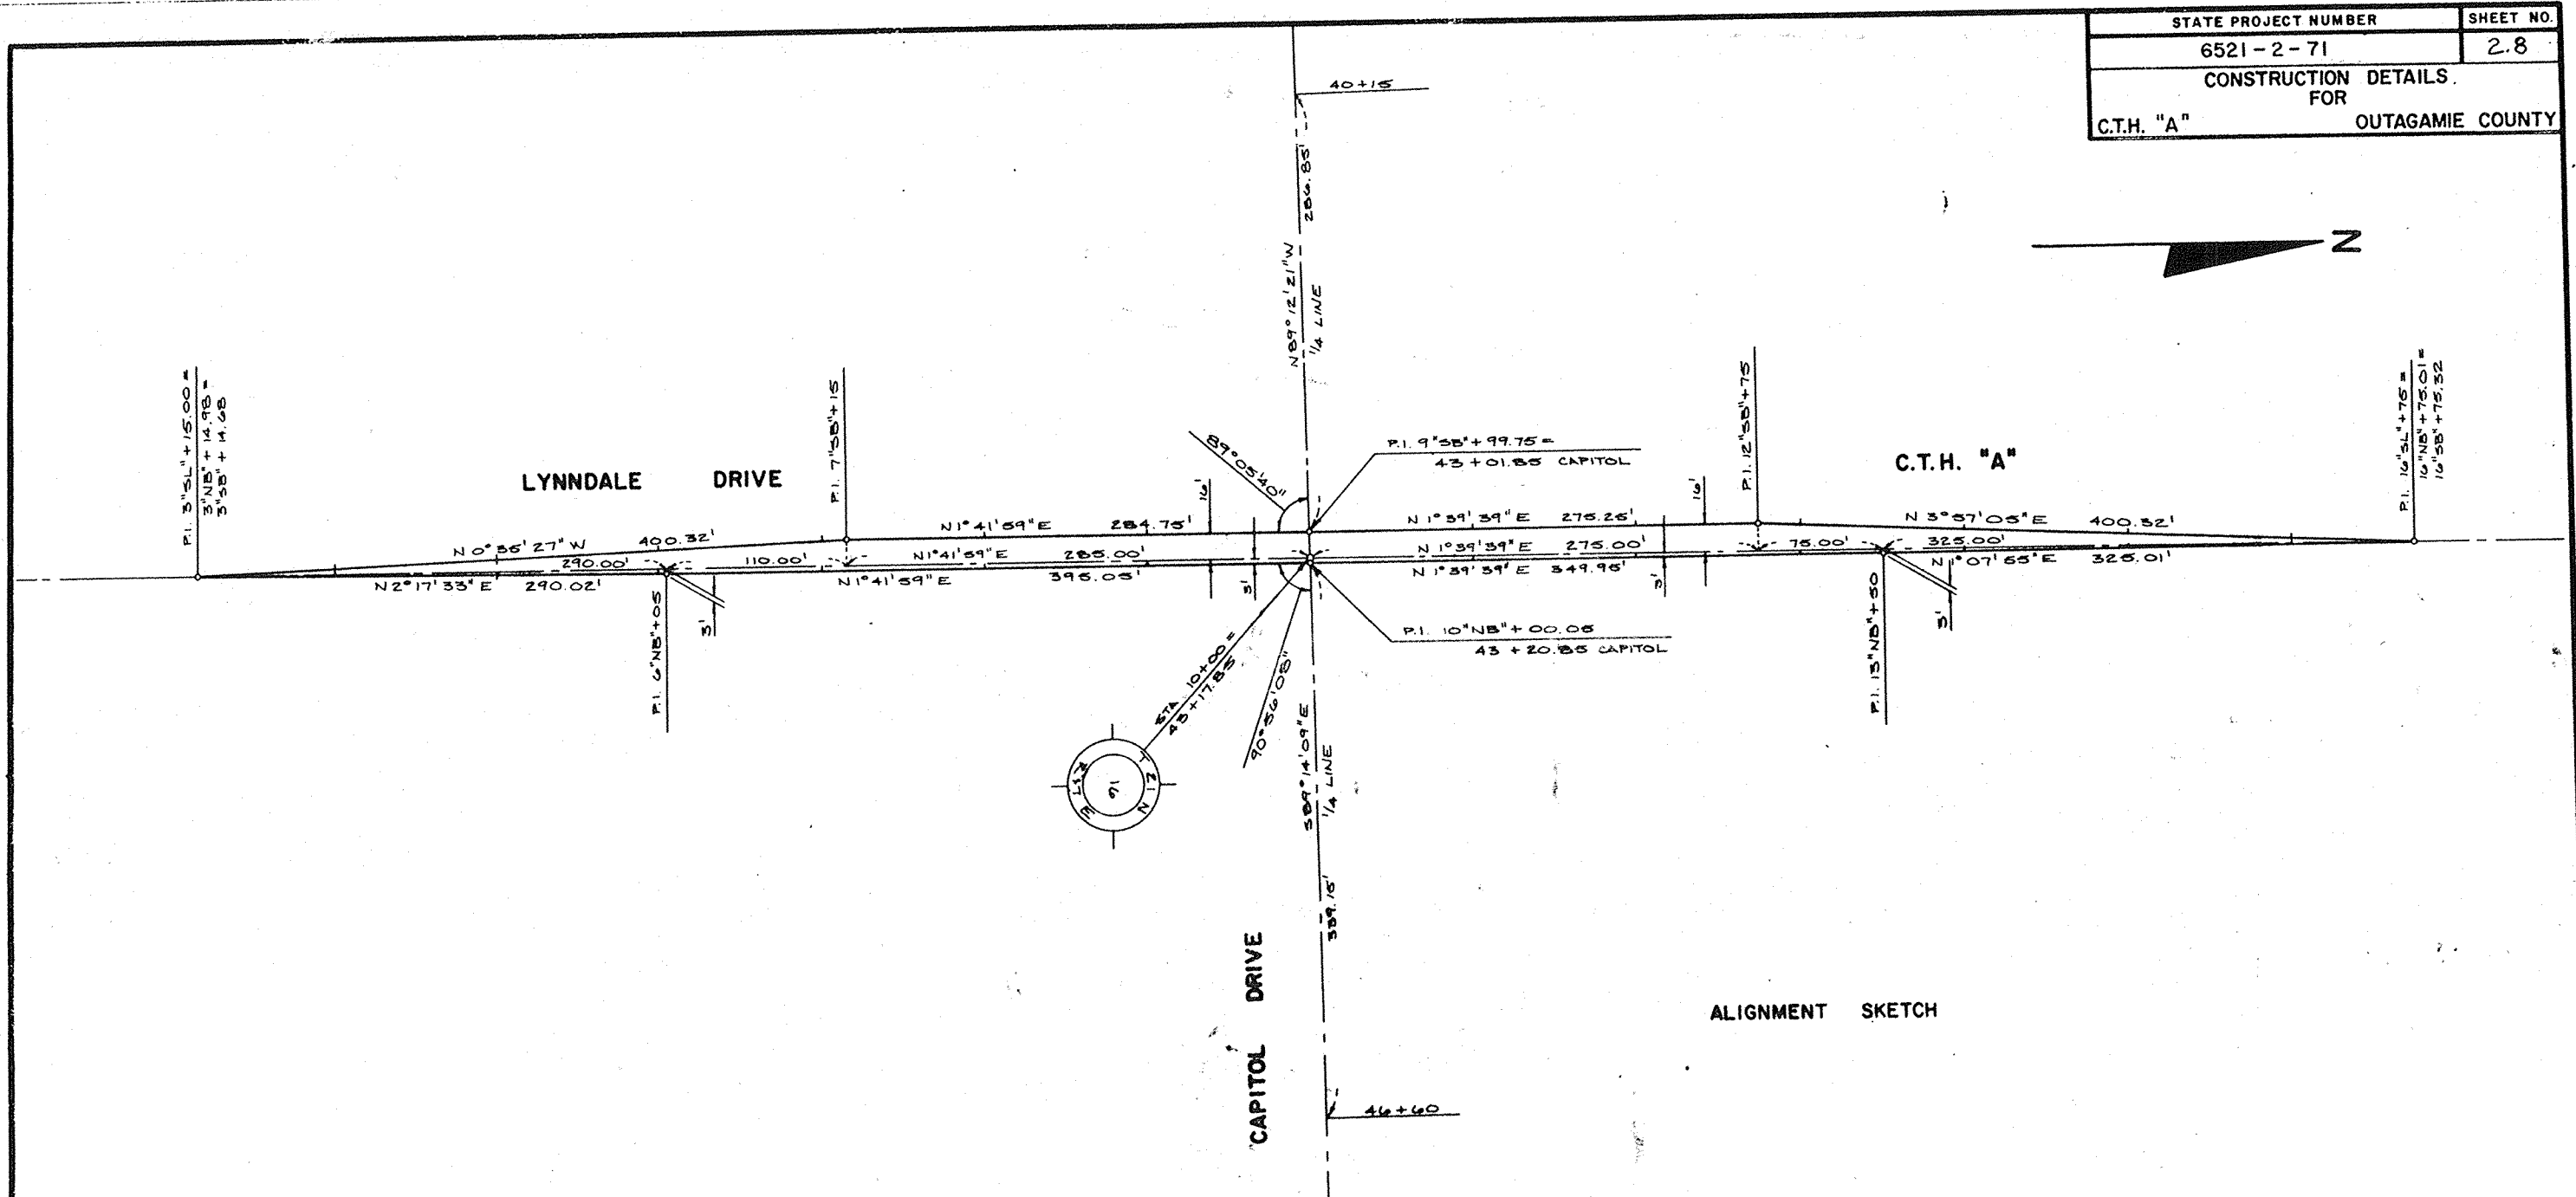

DATE 10/11/91

ESTIMATE OF QUANTITIES

ITEM	ITEM DESCRIPTION	UNIT	TOTAL	6521-02-71 QUANTITY
------	------------------	------	-------	------------------------

20102	CLEARING	I.D.	114.00	114.00
-------	----------	------	--------	--------

20105	GRUBBING	I.D.	114.00	114.00
-------	----------	------	--------	--------

20402	REMOVING ASPHALTIC SURFACE	S.Y.	70.00	70.00
-------	----------------------------	------	-------	-------

20412	REMOVING FENCE	L.F.	353.00	353.00
-------	----------------	------	--------	--------

20503	UNCLASSIFIED EXCAVATION	C.Y.	6,446.00	6,446.00
-------	-------------------------	------	----------	----------

21301	FINISHING ROADWAY	L.S.	1.00	1.00
-------	-------------------	------	------	------

30404	CRUSHED AGGREGATE BASE COURSE	TON	5,700.00	5,700.00
-------	-------------------------------	-----	----------	----------

40204	ASPHALTIC MATERIAL FOR TACK COAT	GAL.	460.00	460.00
-------	----------------------------------	------	--------	--------

40501	ASPHALTIC MATERIAL FOR PLANT MIXES	TON	200.00	200.00
-------	------------------------------------	-----	--------	--------

41531	CONCRETE DRIVEWAY	S.Y.	46.00	46.00
-------	-------------------	------	-------	-------

52003	CULVERT PIPE, CLASS III, 18-INCH	L.F.	52.00	52.00
-------	----------------------------------	------	-------	-------

52005	CULVERT PIPE, CLASS III, 24-INCH	L.F.	64.00	64.00
-------	----------------------------------	------	-------	-------

52007	CULVERT PIPE, CLASS III, 30-INCH	L.F.	70.00	70.00
-------	----------------------------------	------	-------	-------

52061	APRON ENDWALLS FOR CULVERT PIPE, 18-INCH	EACH	2.00	2.00
-------	--	------	------	------

52063	APRON ENDWALLS FOR CULVERT PIPE, 24-INCH	EACH	2.00	2.00
-------	--	------	------	------

52065	APRON ENDWALLS FOR CULVERT PIPE, 30-INCH	EACH	2.00	2.00
-------	--	------	------	------

52260	REINFORCED CONCRETE APRON ENDWALLS FOR CULVERT PIPE, 12-INCH	EACH	2.00	2.00
-------	--	------	------	------

52261	REINFORCED CONCRETE APRON ENDWALLS FOR CULVERT PIPE, 15-INCH	EACH	3.00	3.00
-------	--	------	------	------

52266	REINFORCED CONCRETE APRON ENDWALLS FOR CULVERT PIPE, 30-INCH	EACH	1.00	1.00
-------	--	------	------	------

60133	CONCRETE CURB AND GUTTER, 30-INCH, TYPE D	L.F.	1,917.00	1,917.00
-------	---	------	----------	----------

60204	CONCRETE SIDEWALK, 4-INCH	S.F.	3,630.00	3,630.00
-------	---------------------------	------	----------	----------

60206	CONCRETE SIDEWALK, 6-INCH	S.F.	460.00	460.00
-------	---------------------------	------	--------	--------

60210	CONCRETE LOADING ZONE	S.F.	7,550.00	7,550.00
-------	-----------------------	------	----------	----------

60850	REINFORCED CONCRETE PIPE, CLASS IV, STORM SEWER, 12-INCH	L.F.	163.00	163.00
-------	--	------	--------	--------

Sheet 3

ITEM	ITEM DESCRIPTION	UNIT	TOTAL	6521-02-71 QUANTITY
60851	REINFORCED CONCRETE PIPE, CLASS IV, STORM SEWER, 15-INCH	L.F.	258.00	258.00
60854	REINFORCED CONCRETE PIPE, CLASS IV, STORM SEWER, 24-INCH	L.F.	348.00	348.00
60856	REINFORCED CONCRETE PIPE, CLASS IV, STORM SEWER, 30-INCH	L.F.	539.00	539.00
61110	MANHOLES, TYPE 1	EACH	4.00	4.00
61122	INLETS, TYPE 3	EACH	5.00	5.00
61123	INLETS, TYPE 8	EACH	1.00	1.00
61151	MANHOLE COVERS, TYPE J	EACH	4.00	4.00
61167	INLET COVERS, TYPE H	EACH	5.00	5.00
61170	INLET COVERS, TYPE MS	EACH	1.00	1.00
61331	NONMETALLIC CONDUIT, 1-INCH	L.F.	569.00	569.00
61336	NONMETALLIC CONDUIT, 3-INCH	L.F.	672.00	672.00
61801	MAINTENANCE AND REPAIR OF HAUL ROADS	L.S.	1.00	1.00
61910	MOBILIZATION	L.S.	1.00	1.00
62001	CONCRETE CORRUGATED MEDIAN	S.F.	590.00	590.00
62101	LANDMARK REFERENCE MONUMENTS	EACH	4.00	4.00
62203	ASPHALTIC FLUMES	S.Y.	7.00	7.00
62301	CALCIUM CHLORIDE SURFACE TREATMENT	TON	6.00	6.00
62401	WATER	MGAL	86.00	86.00
62505	SALVAGED TOPSOIL	S.Y.	9,700.00	9,700.00
62702	MULCHING	S.Y.	9,700.00	9,700.00
62815	SILT FENCE, DELIVERED	L.F.	130.00	130.00
62816	SILT FENCE, INSTALLED	L.F.	130.00	130.00
62817	SILT FENCE MAINTENANCE	L.F.	260.00	260.00
62905	FERTILIZER, TYPE B	CWT.	7.00	7.00
63002	SEEDING	LB.	180.00	180.00
63101	SODDING	S.Y.	77.00	77.00
64012	CONCRETE BASES, TYPE 1	EACH	10.00	10.00
64210	FIELD LABORATORY	L.S.	1.00	1.00

Sheet 3.1

6521-02-71
QUANTITY

TOTAL

UNIT

ITEM DESCRIPTION

ITEM

64220 FIELD OFFICE, TYPE C L.S. 1.00 1.00

64301 TRAFFIC CONTROL L.S. 1.00 1.00

64313 TRAFFIC CONTROL, DAYS 2,490.00 2,490.00

64321 TRAFFIC CONTROL, DAYS 2,490.00 2,490.00

64405 PAVEMENT MARKING, L.F. 3,545.00 3,545.00

PREFORMED PLASTIC

64412 PAVEMENT MARKING, L.F. 745.00 745.00

CHANNELIZING, PREFORMED PLASTIC

64434 PAVEMENT MARKING, L.F. 112.00 112.00

STOP LINE, PREFORMED PLASTIC, 18-INCH

64454 PAVEMENT MARKING, L.F. 422.00 422.00

CROSSWALK, PREFORMED PLASTIC, 6-INCH

64469 PAVEMENT MARKING, EACH 7.00 7.00

ARROWS, PREFORMED PLASTIC, SINGLE

64478 PAVEMENT MARKING, EACH 7.00 7.00

WORDS, PREFORMED PLASTIC

64484 TEMPORARY PAVEMENT L.F. 2,120.00 2,120.00

MARKING

64493 PAVEMENT MARKING, L.F. 192.00 192.00

CURB RAMP, EPOXY

64496 PAVEMENT MARKING, S.F. 70.00 70.00

ISLAND NOSE, EPOXY

64401 SAWING EXISTING L.F. 450.00 450.00

PAVEMENT

90001 REMOVING EXISTING L.S. 1.00 1.00

SIGNAL EQUIPMENT

90003 TRAFFIC SIGNAL L.F. 930.00 930.00

CABLE 20 CONDUCTOR, NO. 12

90004 SPECIAL INLET EACH 2.00 2.00

90005 SPECIAL DITCH GRATE EACH 2.00 2.00

90359 BREAKER RUN STONE TON 4,400.00 4,400.00

90364 SINGLE AGGREGATE TON 3,140.00 3,140.00

ASPHALTIC PAVEMENT, TYPE D4

90785 CONCRETE CONTROL EACH 1.00 1.00

CABINET BASES, TYPE 9

90792 PULL BOXES, EACH 7.00 7.00

12X24-INCH

90797 PULL BOXES, EACH 6.00 6.00

24X36-INCH

90800 PEDESTAL BASES EACH 10.00 10.00

90811 TRAFFIC SIGNAL EACH 10.00 10.00

STANDARDS, 15-FT.

6521-02-71
QUANTITY

TOTAL

UNIT

ITEM DESCRIPTION

ITEM

90817 TRAFFIC SIGNAL EACH 8.00 8.00

FACES, 3-12 VERTICAL

90819 TRAFFIC SIGNAL EACH 6.00 6.00

FACES, 5-12 VERTICAL

90830 PEDESTRIAN SIGNAL EACH 8.00 8.00

FACES, 12-INCH

90833 PEDESTRIAN PUSH EACH 8.00 8.00

BUTTONS

90834 TRAFFIC SIGNAL L.S. 1.00 1.00

MOUNTING HARDWARE, CTH "A"

90838 BACKPLATES EACH 14.00 14.00

90859 TRAFFIC SIGNAL EACH 1.00 1.00

CONTROLLER, FULLY ACTUATED, 8 PHASE

90865 ELECTRICAL SERVICE, L.S. 1.00 1.00

TRAFFIC SIGNALS, CTH "A"

90870 LOOP DETECTOR L.S. 1.00 1.00

AMPLIFIER, CTH "A"

90871 LOOP DETECTOR L.F. 491.00 491.00

CONDUIT, 1-INCH

Sheet 3.2

90872 LOOP DETECTOR WIRE L.F. 1,148.00 1,148.00

90873 LOOP DETECTOR LEAD L.F. 1,520.00 1,520.00

IN CABLE

CLEARING AND GRUBBING			
STATION	LOCATION	CLEARING I.D.	GRUBBING I.D.
9"NB"+54	LYNNDAL DR., 36' RT.	24	24
40+22	CAPITOL DR., 30' RT.	8	8
40+35	CAPITOL DR., 29' RT.	8	8
41+18	CAPITOL DR., 37' RT.	3	3
42+40	CAPITOL DR., 29' RT.	28	28
42+63	CAPITOL DR., 36' RT.	4	4
43+81	CAPITOL DR., 25' RT.	24	24
44+42	CAPITOL DR., 29' RT.	5	5
44+67	CAPITOL DR., 29' RT.	10	10
TOTALS		114	114

REMOVING FENCE			
STATION TO STATION	LOCATION	TYPE	L.F.
7"SB"+93 - 9"SB"+74	28' LT.	CHAIN LINK	190
41+12	28' RT.	CHAIN LINK	32
41+70 - 42+73	27' RT.	CHAIN LINK	131
TOTALS			353

REMOVING ASPHALTIC SURFACE			
STATION	LOCATION	S.Y.	
8"NB"+77	OBLITERATE P.E. RT.	70	
TOTALS		70	

SAWING EXISTING PAVEMENT			
STATION	LOCATION	L.F.	
3"NB"+00	LYNNDAL DR.	32	
5"SB"+54 - 7"SB"+83	PARKING LOT LT.	229	
8"NB"+78	P.E., 96' RT.	10	
16"NB"+45	F.E. RT.	24	
17"NB"+00	LYNNDAL DR.	26	
40+15	CAPITOL DR.	40	
46+15	P.E. RT.	14	
46+80	CAPITOL DR.	75	
TOTALS		450	

EARTHWORK SUMMARY				
STATION TO STATION	UNCL. EXC. C.Y.	FILL C.Y.	FILL EXPANSION	WASTE C.Y.
3"NB"+00 - 17"NB"+00	4303	1101	30%	2872
40+15 - 42+85	852	352	30%	394
43+42 - 47+00	1291	393	30%	780
TOTALS	6446	1846		4046

BREAKER RUN STONE			
STATION TO STATION	LOCATION	TON	
3"NB"+00 - 17"NB"+00	LYNNDAL DR.	3564	
40+15 - 42+22	CAPITOL (WEST)	356	
44+05 - 47+00	CAPITOL (EAST)	480	
TOTALS		4400	

CROSS DRAINS										
STATION	LOCATION	DIAMETER INCHES	LENGTH FEET	TYPE	CLASS	THICKNESS STEEL INCH	ALUMINUM INCH	APRON ENDWALLS EACH	** SOD S.Y.	** SILT FENCE L.F.
5"NB"+28.50	C.T.H. "A"	30	70	C.P.	III	0.079	0.075	2	19	20
15"NB"+63	C.T.H. "A"	24	64	C.P.	III	0.079	0.075	2	14	20
TOTALS									33	40
** QUANTITY INCLUDED ELSEWHERE										

PRIVATE ENTRANCE PIPES									
STATION	LOCATION	DIAMETER INCHES	LENGTH FEET	TYPE	CLASS	THICKNESS STEEL INCH	ALUMINUM INCH	APRON ENDWALLS EACH	** SOD S.Y.
12"NB"+59	C.T.H. "A", RT.	18	52	C.P.	III	0.064	0.080	2	9
TOTALS									9
** QUANTITY INCLUDED ELSEWHERE									

CRUSHED AGGREGATE BASE COURSE				
STATION TO STATION	LOCATION	ROADWAY TON	SHOULDER TON	
3"NB"+00 - 17"NB"+00	LYNNDAL DR.	3882	277	
40+15 - 42+22	CAPITOL (WEST)	402	10	
44+05 - 47+00	CAPITOL (EAST)	536	20	
P.E.			409	
UNDER SIDEWALK			84	
TOTALS		4900	800	

CONCRETE LOADING ZONE			
STATION TO STATION	LOCATION	S.F.	
4"NB"+32 - 7"NB"+30	LYNNDAL DR.	2530	
8"NB"+00 - 9"NB"+38	LYNNDAL DR.	819	
10"NB"+82 - 14"NB"+25	LYNNDAL DR.	3804	
14"NB"+85 - 15"NB"+49	LYNNDAL DR.	297	
TOTALS		7550	

CONCRETE CORRUGATED MEDIAN			
STATION TO STATION	LOCATION	S.F.	
14"NB"+25 - 14"NB"+95	LYNNDAL DR.	580	

CONCRETE CURB & GUTTER, 30-INCH, TYPE "D"			
STATION TO STATION	LOCATION	L.F.	
4"SB"+00 - 9"SB"+19	LT.	519	
7"NB"+50 - 9"NB"+22	RT.	172	
C.T.H. "A" SW RADIUS		94	
C.T.H. "A" SE RADIUS		94	
C.T.H. "A" NW RADIUS		94	
C.T.H. "A" NE RADIUS		94	
10"SB"+78 - 12"SB"+00	LT.	122	
40+33 - 42+30	LT.	197	
40+75 - 42+22	RT.	147	
44+01 - 45+40	LT.	139	
46+03 - 48+80	RT.	245	
TOTALS		1817	

CONCRETE SIDEWALK, 4-INCH			
STATION TO STATION	LOCATION	S.F.	
40+75 - 40+83	RT.	40	
41+07 - 41+23	RT.	80	
41+47 - 42+46	RT.	495	
42+48 - 42+78	RT.	280	
42+48 - 42+86	LT.	315	
43+45 - 43+79	LT.	290	
43+49 - 43+79	RT.	245	
43+79 - 46+05	RT.	1130	
46+25 - 46+93	RT.	340	
47+17 - 48+00	RT.	415	
TOTALS		3630	

CONCRETE SIDEWALK, 6-INCH			
STATION TO STATION	LOCATION	S.F.	
40+83 - 41+07	RT.	120	
41+23 - 41+47	RT.	120	
46+05 - 46+25	RT.	100	
46+93 - 47+17	RT.	120	
TOTALS		460	

CONCRETE DRIVEWAY			
STATION	LOCATION	S.Y.	
40+94	RT.	23	
41+37	RT.	23	
TOTALS		46	

SALVAGED TOPSOIL, MULCHING, FERTILIZER AND SEEDING					
STATION TO STATION	LOCATION	SALVAGED TOPSOIL S.Y.	MULCHING S.Y.	FERTILIZER CWT.	SEED NO. 40 LBS.
3"NB"+00 - 17"NB"+00	LYNNDAL DR.	6001	6001	4.3	112
40+15 - 42+85	CAPITOL (WEST)	1741	1741	1.3	32
43+42 - 48+00	CAPITOL (EAST)	1689	1689	1.2	31
7"NB"+81, RT.	RELOCATE P.E.	122	122	0.1	2
8"NB"+75, RT.	REMOVE P.E.	167	167	0.1	3
TOTALS		9700	9700	7.0	180

SODDING AND SILT FENCE, DELIVERED, INSTALLED & MAINTAINED				
LOCATION	SOD S.Y.	SILT FENCE DELIVERED L.F.	SILT FENCE INSTALLED L.F.	SILT FENCE MAINTENANCE L.F.
CROSS DRAINS	33	40	40	80
P.E. PIPES	9	---	---	---
STORM SEWER STRUCTURES	35	90	90	180
TOTALS	77	130	130	260

SINGLE AGGREGATE ASPHALTIC PAVEMENT, TYPE D1					
STATION TO STATION	LOCATION	PAVT. DEPTH INCHES	ASPHALTIC PAVEMENT TONS	ASPHALTIC MAT'L. FOR PAVT. TONS	ASPHALTIC MAT'L. FOR TACK COAT GAL.
3"NB"+00 - 17"NB"+00	LYNNDAL DR.	5-1/2"	2428	155	364
40+15 - 42+22	CAPITOL (WEST)	5-1/2"	277	18	42
44+05 - 47+00	CAPITOL (EAST)	5-1/2"	364	23	54
DRIVEWAYS		2"	71	4	---
TOTALS			3140	200	460

TRAFFIC SIGNAL FACES			
FACE NUMBER	SIGNAL BASE NUMBER	3-12 VERTICAL EACH	5-12 VERTICAL EACH
A-1	SB-8	1	---
A-2	SB-2	---	1
A-3	SB-1	1	---
A-4	SB-9	---	1
B-1	SB-6	1	---
B-2	SB-5	---	1
B-3	SB-4	---	1
C-1	SB-3	1	---
C-2	SB-9	---	1
C-3	SB-10	1	---
C-4	SB-2	---	1
D-1	SB-5	1	---
D-2	SB-6	1	---
D-3	SB-7	1	---
TOTALS		8	6

• ALL SIGNAL HEADS TO HAVE BACKPLATES

NON-PARTICIPATING

NONMETALLIC CONDUIT & TRAFFIC SIGNAL CABLE			
LOCATION FROM TO		NONMETALLIC CONDUIT 1-INCH L.F.	TRAFFIC SIGNAL CABLE 20 CONDUCTOR NO. 12 L.F.
CB-1	PB-1	---	48 (2 @ 24)
PB-1	SB-6	---	25
PB-1	SB-1	---	32
PB-1	PB-2	---	56
PB-1	PB-6	---	82
PB-1	PB-7	77	---
PB-2	SB-2	---	6
PB-2	PB-3	---	61
PB-3	SB-3	---	33
PB-3	PB-10	235	---
PB-3	SB-4	---	30
PB-3	PB-4	---	81
PB-4	SB-5	---	32
PB-4	PB-11	32	---
PB-4	SB-10	---	22
PB-4	PB-5	---	47
PB-5	SB-9	---	6
PB-5	PB-6	---	65
PB-6	PB-13	225	---
PB-6	SB-7	---	20
PB-6	SB-8	---	26
TOTALS		569	930

NON-PARTICIPATING

PAVEMENT MARKING, PREFORMED PLASTIC			
STATION TO STATION		4-INCH (EDGE LINE, WHITE) L.F.	4-INCH (NO PASSING, YELLOW) L.F.
3"SB"+00	4"SB"+00	100	---
3"NB"+00	4"NB"+34	---	134
3"SB"+00	4"SB"+34	---	134
3"NB"+00	7"NB"+50	450	---
7"NB"+15	9"NB"+32	---	217
7"NB"+50	9"NB"+32	---	182
10"SB"+88	11"SB"+85	---	97
10"NB"+81	17"NB"+00	619	---
12"SB"+00	17"SB"+00	500	---
15"NB"+49	17"NB"+00	---	151
15"SB"+49	17"SB"+00	---	151
40+15	40+75	60	---
40+15	40+33	18	---
40+15	42+34	---	436
41+35	42+34	---	99
43+80	47+00	---	620
43+80	45+40	---	150
45+40	47+00	160	---
46+50	46+60	10	---
TOTALS		1917	1828

745

PULL BOXES				
BOX NUMBER	STATION	LOCATION	(SIZE) 12"x24" EACH	(SIZE) 24"x36" EACH
PB-1	10"NB"+38	CTH "A" 43' RT.	---	1
PB-2	10"NB"+68	CTH "A" 4' LT.	---	1
PB-3	10"SB"+37	CTH "A" 37' LT.	---	1
PB-4	9"SB"+56	CTH "A" 36' LT.	---	1
PB-5	9"SB"+32	CTH "A" 4' RT.	---	1
PB-6	9"NB"+57	CTH "A" 45' RT.	---	1
PB-7	44+30	CAP. DR. 23' RT.	1	---
PB-8	43+70	CAP. DR. 23' RT.	1	---
PB-9	11"SB"+08	CTH "A" 23' LT.	1	---
PB-10	12"SB"+68	CTH "A" 23' LT.	1	---
PB-11	42+37	CAP. DR. 23' LT.	1	---
PB-12	8"NB"+92	CTH "A" 33' RT.	1	---
PB-13	7"NB"+32	CTH "A" 33' RT.	1	---
TOTALS			7	6

NON-PARTICIPATING

TRAFFIC CONTROL DRUMS AND WARNING LIGHTS					
STATION TO STATION		LOCATION	APPROXIMATE SERVICE PERIOD DAYS	NUMBER IN SERVICE	WARNING LIGHT DAYS
UNDISTRIBUTED		SIDE RDS. & P.E.'S	83	30	2490

2490

PAVEMENT MARKING, PREFORMED PLASTIC			
STATION	LOCATION	6-INCH, CROSSWALK (SOLID WHITE) L.F.	18-INCH, STOP LINE (SOLID WHITE) L.F.
9+32	LYNNDALE DR.	---	37
9+41	LYNNDALE DR.	136	---
10+59	LYNNDALE DR.	112	---
10+88	LYNNDALE DR.	---	25
42+34	CAPITOL DR.	---	25
42+43	CAPITOL DR.	84	---
43+81	CAPITOL DR.	90	---
43+80	CAPITOL DR.	---	25
TOTALS		422	112

LOOP DETECTOR CONDUIT, WIRE SIZE AND AMPLIFIER					
NUMBER	LOCATION	LOOP DETECTOR CONDUIT, 1-INCH L.F.	LOOP DETECTOR WIRE L.F.	LOOP DETECTOR SIZE	LEAD IN WIRE L.F.
21	7"NB"+32 CTH "A"	63	178	6 X 20	331
51	8"NB"+92 CTH "A"	108	216	6 X 30	171
11	11"SB"+08 CTH "A"	98	196	6 X 30	216
61	12"SB"+68 CTH "A"	46	164	6 X 12	376
41	42+37 CAP. DR.	52	146	6 X 15	250
31	44+30 CAP. DR.	92	184	6 X 30	101
81	43+70 CAP. DR.	32	64	6 X 6	75
TOTALS		491	1148	1520	7

NON-PARTICIPATING

TEMPORARY PAVEMENT MARKING			
LOCATION		4-INCH (EDGE LINE, WHITE) L.F.	4-INCH (NO PASSING, YELLOW) L.F.
CAPITOL DR. (WEST)		480	480
CAPITOL DR. (EAST)		600	600
TOTALS		1,080	1,080

PAVEMENT MARKING, PREFORMED PLASTIC				
STATION	LOCATION	ARROWS, TYPE 1 EACH	ARROWS, TYPE 2 EACH	WORDS, "ONLY" EACH
7"NB"+56	LYNNDALE DR.	---	---	1
8"NB"+00	LYNNDALE DR.	---	1	---
8"NB"+74	LYNNDALE DR.	---	---	3
9"NB"+16	LYNNDALE DR.	1	2	---
10"SB"+84	LYNNDALE DR.	---	1	---
11"SB"+26	LYNNDALE DR.	---	---	1
41+76	CAPITOL DR.	---	---	1
42+18	CAPITOL DR.	---	1	---
44+06	CAPITOL DR.	---	1	---
44+48	CAPITOL DR.	---	---	1
TOTALS		1	6	7

CONCRETE BASES, TRAFFIC SIGNAL STANDARDS, POLES AND PEDESTRIAN SIGNAL FACES							
NUMBER	STATION	LOCATION	CONCRETE BASES TYPE 1 EACH	CONCRETE CONTROL CABINET BASES TYPE 9 EACH	TRAFFIC SIGNAL STANDARDS 15-FOOT EACH	PEDESTRIAN SIGNAL FACES 12-INCH EACH	PEDESTRIAN PUSH BUTTON EACH
SB-1	10"NB"+63	CTH "A" 26' RT.	1	---	1	1	1
SB-2	10"NB"+72	CTH "A" 4' LT.	1	---	1	---	1
SB-3	10"SB"+63	CTH "A" 21' LT.	1	---	1	1	1
SB-4	42+40	CAP. DR. 27' LT.	1	---	1	1	1
SB-5	42+40	CAP. DR. 27' RT.	1	---	1	1	1
SB-6	43+85	CAP. DR. 26' LT.	1	---	1	1	1
SB-7	43+77	CAP. DR. 31' RT.	1	---	1	1	1
SB-8	9"NB"+37	CTH "A" 31' RT.	1	---	1	1	1
SB-9	9"SB"+28	CTH "A" 4' RT.	1	---	1	---	1
SB-10	9"SB"+37	CTH "A" 29' LT.	1	---	1	1	1
CB-1	43+82	CAP. DR. 42' LT.	---	1	---	---	---
TOTALS			10	1	10	8	10

NON-PARTICIPATING

LANDMARK REFERENCE MONUMENTS			
STATION	LOCATION	DESCRIPTION	EACH
10+NB"+00	INTERSECTION OF LYNNDALE DR. & CAPITOL DR.	CENTER OF SECTION 16 (T-21-N) (R-17-E)	4

PAVEMENT MARKING, EPOXY			
STATION	LOCATION	(SAFETY) ISLAND NOSES (YELLOW) S.F.	CURB RAMP 4-INCH (YELLOW) L.F.
44+34	LYNNDALE DR.	7	---
7+27	LYNNDALE DR.	14	---
8+03	LYNNDALE DR.	14	---
9+35	LYNNDALE DR.	14	---
9+40	LYNNDALE DR.	---	48
10+80	LYNNDALE DR.	---	48
10+85	LYNNDALE DR.	14	---
15+49	LYNNDALE DR.	7	---
42+45	CAPITOL DR.	---	48
43+80	CAPITOL DR.	---	48
TOTALS		70	192

Conventional Signs and Abbreviations


--- SECTION LINE	AC	ACRES	N	NORTH
--- QUARTER LINE	ETUX	AND WIFE	P.C.	POINT OF CURVATURE
--- TOWNSHIP AND RANGE LINE	Δ	CENTRAL ANGLE	P.I.	POINT OF INTERSECTION
--- PROPOSED OR NEW CENTERLINE	COR.	CORNER	P.T.	POINT OF TANGENCY
--- PROPOSED OR NEW R/W LINE	C.T.H.	COUNTY TRUNK HIGHWAY	R	RADIUS
--- EXISTING R/W LINE	D	DEGREE OF CURVE	R/W	RIGHT OF WAY
--- PROPERTY LINE	E	EAST	SEC.	SECTION
--- SLOPE INTERCEPTS	L	LENGTH OF CURVE	S	SOUTH
--- LIMITED HIGHWAY EASEMENT	L.H.E.	LIMITED HIGHWAY EASEMENT	STA.	STATION
--- R/W POINT	LC	LONG CHORD	T	TOWN
--- FENCE	LCB	LONG CHORD BEARING	T	TANGENT LENGTH OF CURVE
--- SECTION OR QUARTER CORNER	MI	MILE	W	WEST
--- POWER POLE	R.	RANGE		
--- TELEPHONE PEDESTAL				
--- UNDERGROUND TELEPHONE CABLE				
--- UNDERGROUND GAS MAIN				
--- UNDERGROUND WATER MAIN				
--- UNDERGROUND SANITARY SEWER				

SCHEDULE OF LANDS & INTERESTS REQUIRED

PARCEL NUMBER	SHEET NUMBER	OWNER	INTEREST REQUIRED	L.H.E. ACRES		R/W ACRES REQ'D.			TOTAL ACRES REM.
				TEMP.	PERM.	NEW	EXISTING	TOTAL	
1	4.0	G. & S. INVESTMENTS, INC.	L.H.E.	0.02					
2	4.0	APPLETON AREA SCHOOL DISTRICT, A WISCONSIN MUNICIPAL CORPORATION	FEE TITLE & L.H.E.	0.17		0.13	0.72	0.85	4.87
3	4.0	MARK A. VIVODA & REBECCA R. VIVODA	FEE TITLE & L.H.E.	0.12		0.01	0.42	0.43	1.16
4	4.0	ROBERT W. PRICE & ELIZABETH A. PRICE	L.H.E.	0.07					
6	4.0	JAMES D. MORISSETTE & MICHELLE A. MORISSETTE	FEE TITLE & L.H.E.	0.07		0.02		0.02	0.34
7	4.0	MARIE GRIESBACH, LAND CONTRACT VENDOR THE APPLETON COMMUNITY EVANGELICAL FREE CHURCH, LAND CONTRACT VENDEE	FEE TITLE & L.H.E.	0.06		0.17	0.26	0.43	4.83
8	4.0	LYNN P. LOROCK & JOYCE C. LOROCK	L.H.E.	0.03					
9	4.0	DAVID J. EBBEN & SUEZETE A. EBBEN	L.H.E.	0.03					
10	4.0	JONATHAN J. OLIG & ANN M. OLIG	L.H.E.	0.01					
11	4.0	JEROME G. GREVE & AUDREY M. GREVE	L.H.E.	0.05					
12	4.0	EWALD GREVE & ELINORE GREVE	L.H.E.	0.02					
13	4.0	ROLAND W. CAPTAIN & RUTH E. CAPTAIN	L.H.E.	0.02					
14	4.0	WISCONSIN BELL, INC.	RELEASE OF RIGHTS						
15	4.0	WISCONSIN ELECTRIC POWER COMPANY	RELEASE OF RIGHTS						

*ACQUIRED IN THE NAME OF OUTAGAMIE COUNTY.

R/W PROJECT NUMBER 6521-02-00	SHEET NUMBER 4.0	TOTAL SHEETS 4.0
FEDERAL PROJECT NUMBER		
PLAT OF RIGHT OF WAY REQUIRED FOR LYNNDALE DR. & CAPITOL DR. INTERSECTION (TOWN OF GRAND CHUTE) C.T.H. "A" OUTAGAMIE COUNTY		
DATE MARCH 28, 1989	REVISION DATE MAY 15, 1989	
6521-02-71		4.0

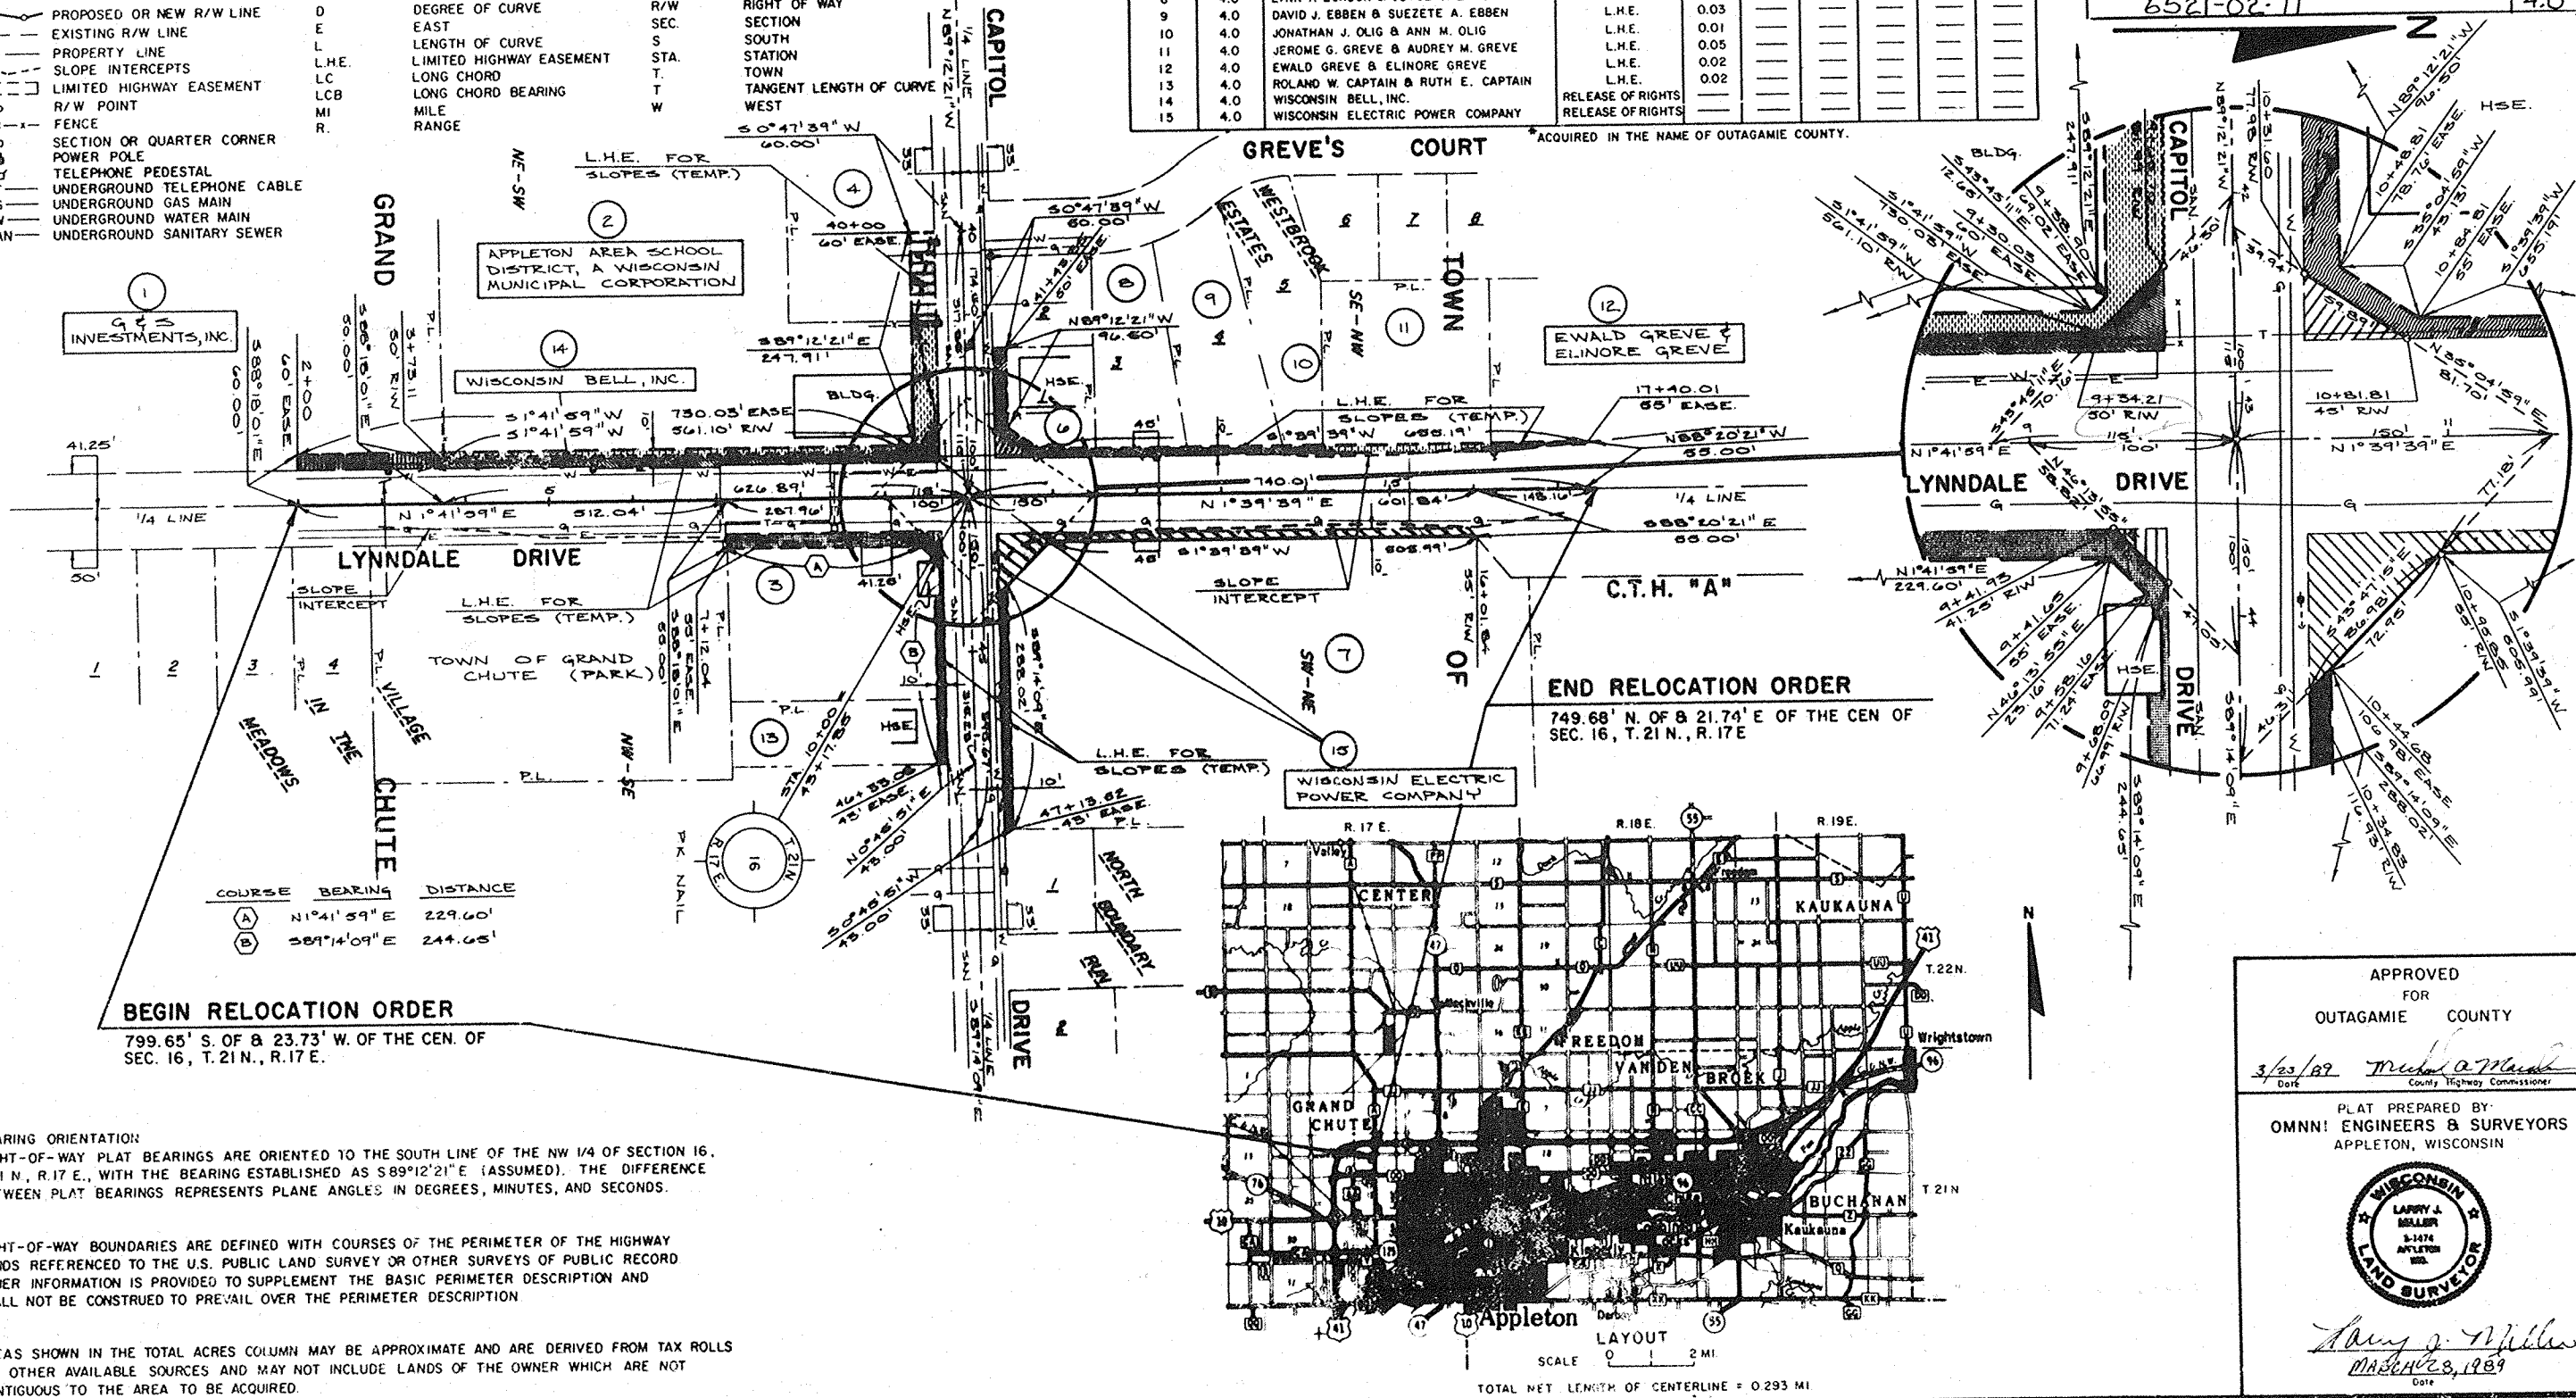


APPROVED FOR OUTAGAMIE COUNTY
3/23/89 <i>Michael J. Miller</i> Date County Highway Commissioner
PLAT PREPARED BY: OMNI ENGINEERS & SURVEYORS APPLETON, WISCONSIN


<i>Larry J. Miller</i> Date MARCH 23, 1989

BEARING ORIENTATION:
RIGHT-OF-WAY PLAT BEARINGS ARE ORIENTED TO THE SOUTH LINE OF THE NW 1/4 OF SECTION 16, T.21 N., R.17 E., WITH THE BEARING ESTABLISHED AS S89°12'21" E (ASSUMED). THE DIFFERENCE BETWEEN PLAT BEARINGS REPRESENTS PLANE ANGLES IN DEGREES, MINUTES, AND SECONDS.

RIGHT-OF-WAY BOUNDARIES ARE DEFINED WITH COURSES OF THE PERIMETER OF THE HIGHWAY LANDS REFERENCED TO THE U.S. PUBLIC LAND SURVEY OR OTHER SURVEYS OF PUBLIC RECORD. OTHER INFORMATION IS PROVIDED TO SUPPLEMENT THE BASIC PERIMETER DESCRIPTION AND SHALL NOT BE CONSTRUED TO PREVAIL OVER THE PERIMETER DESCRIPTION.

AREAS SHOWN IN THE TOTAL ACRES COLUMN MAY BE APPROXIMATE AND ARE DERIVED FROM TAX ROLLS OR OTHER AVAILABLE SOURCES AND MAY NOT INCLUDE LANDS OF THE OWNER WHICH ARE NOT CONTIGUOUS TO THE AREA TO BE ACQUIRED.

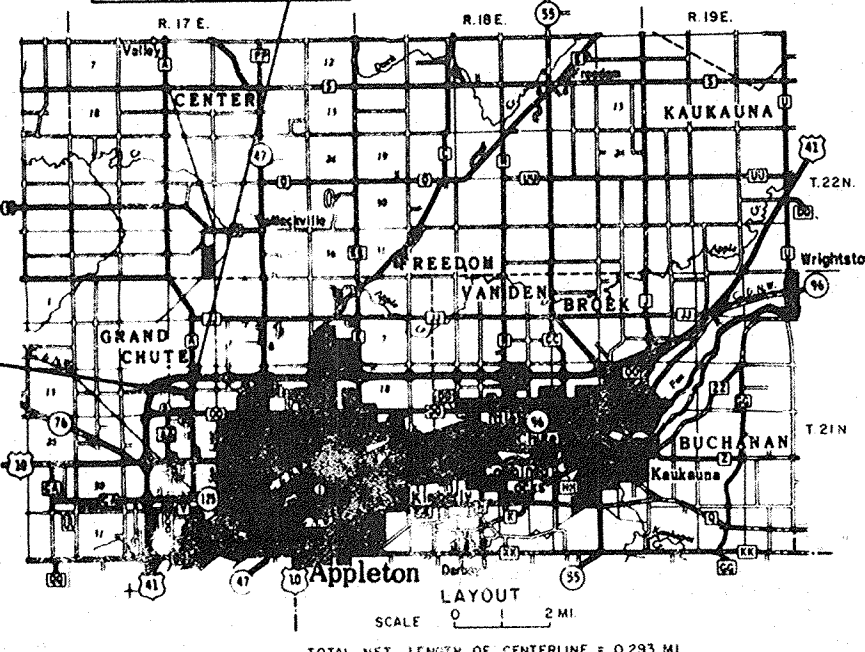

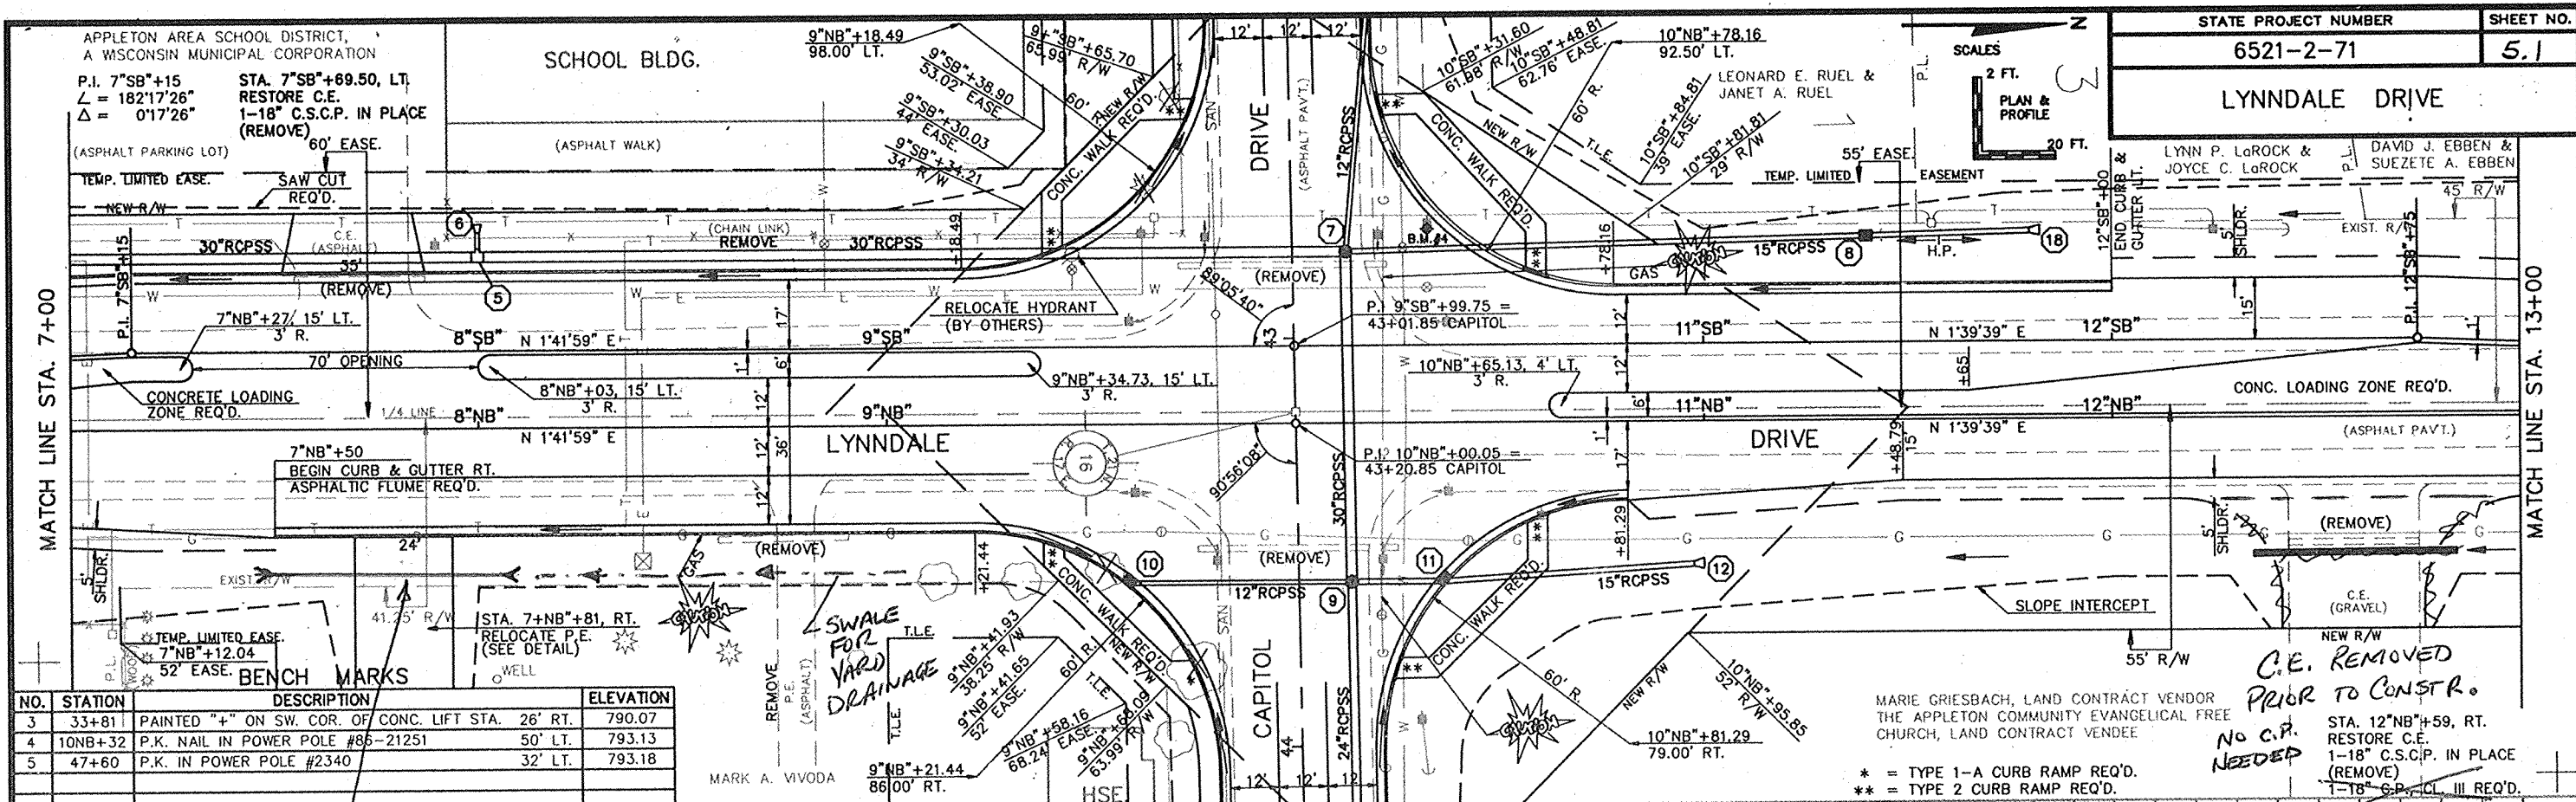

NO.	STATION	DESCRIPTION	ELEVATION
3	33+81	PAINTED "+" ON SW. COR. OF CONC. LIFT STA. 26' RT.	790.07
4	10NB+32	P.K. NAIL IN POWER POLE #86-21251	50' LT. 793.13
5	47+60	P.K. IN POWER POLE #2340	32' LT. 793.18


MARIE GRIESBACH, LAND CONTRACT VENDOR
THE APPLETON COMMUNITY EVANGELICAL FREE
CHURCH, LAND CONTRACT VENUEE

* = TYPE 1-A CURB RAMP REQ'D.
** = TYPE 2 CURB RAMP REQ'D.


C.E. REMOVED
PRIOR TO CONSTR.

NO C.P. NEEDED


STA. 12+NB+59, RT.
RESTORE C.E.
1-18" C.S.C.P. IN PLACE
(REMOVE)
1-18" G.P. CL. III REQ'D.

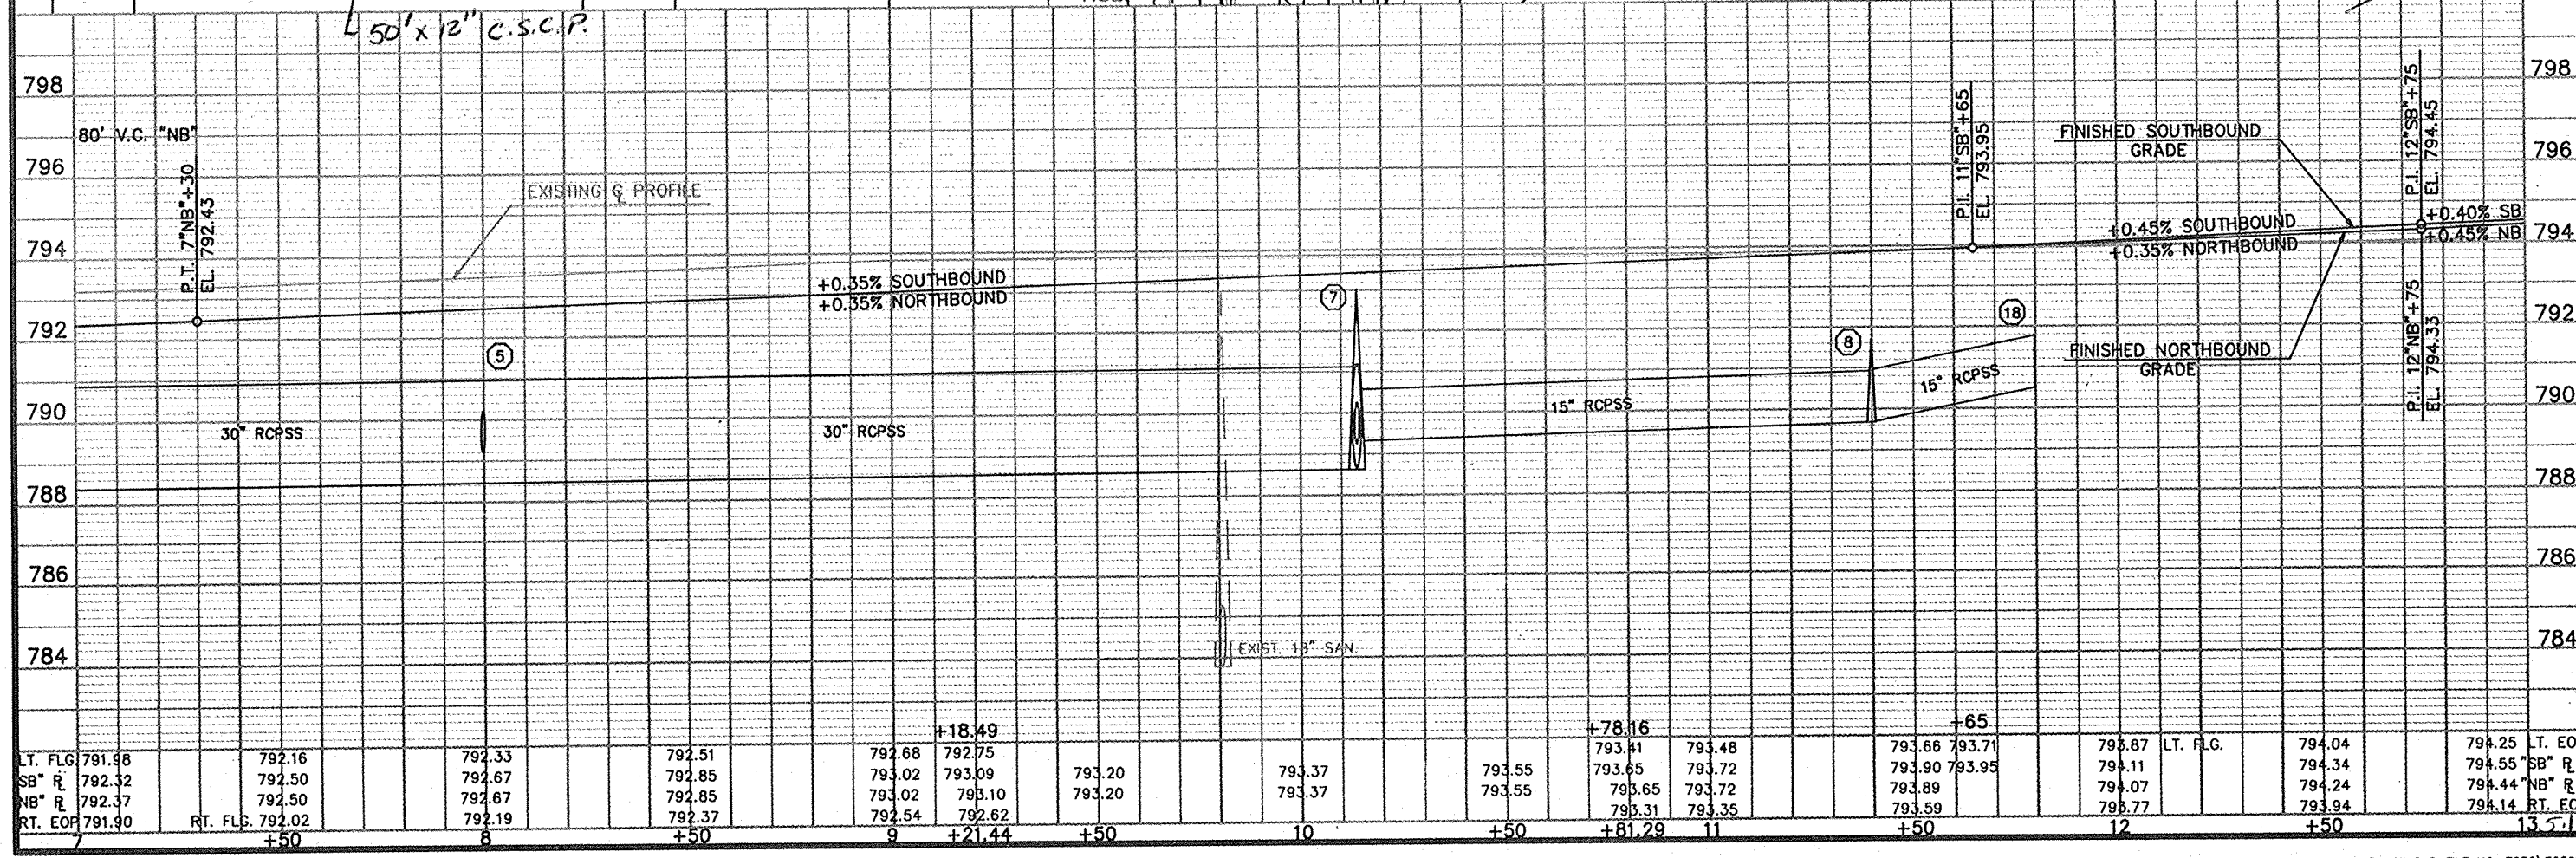


LT. FLG	791.98	792.16	792.33	792.51	792.68	792.75	793.02	793.20	793.37	793.55	793.65	793.72	793.89	793.95	794.11	794.24	794.34	794.44	794.55	LT. EOP
SB" R	792.32	792.50	792.67	792.85	793.02	793.09	793.20	793.37	793.55	793.65	793.72	793.89	793.95	794.11	794.24	794.34	794.44	794.55	SB" R	
NB" R	792.37	792.50	792.67	792.85	793.02	793.10	793.20	793.37	793.55	793.65	793.72	793.89	793.95	794.11	794.24	794.34	794.44	794.55	NB" R	
RT. EOP	791.90	RT. FLG	792.02	792.19	792.37	792.62	792.75	793.02	793.20	793.37	793.55	793.65	793.72	793.89	793.95	794.11	794.24	794.34	794.44	RT. EOP
		+50		8	+50	9	+21.44	+50	10	+50	+81.29	11	+50	12	+50					13.51

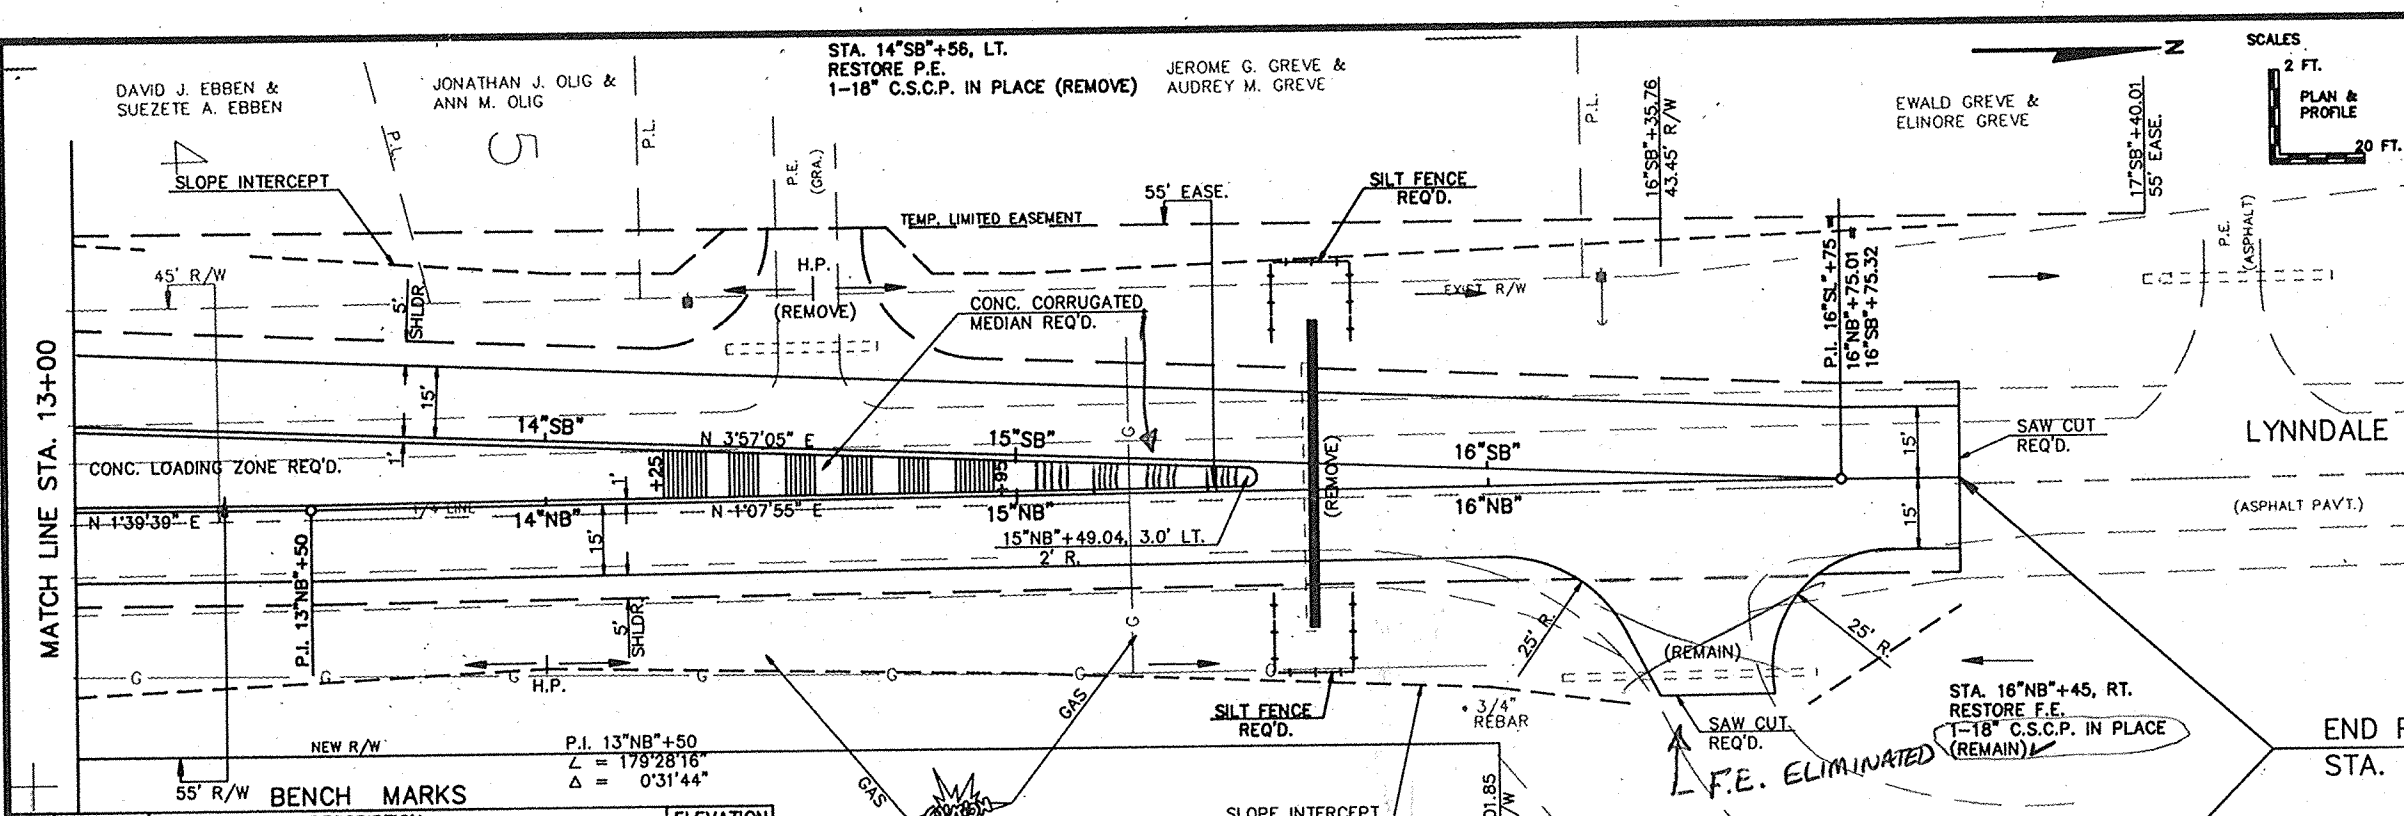

NO.	STATION	DESCRIPTION	ELEVATION
4	10NB+32	P.K. NAIL IN POWER POLE #86-21251	50' LT. 793.13

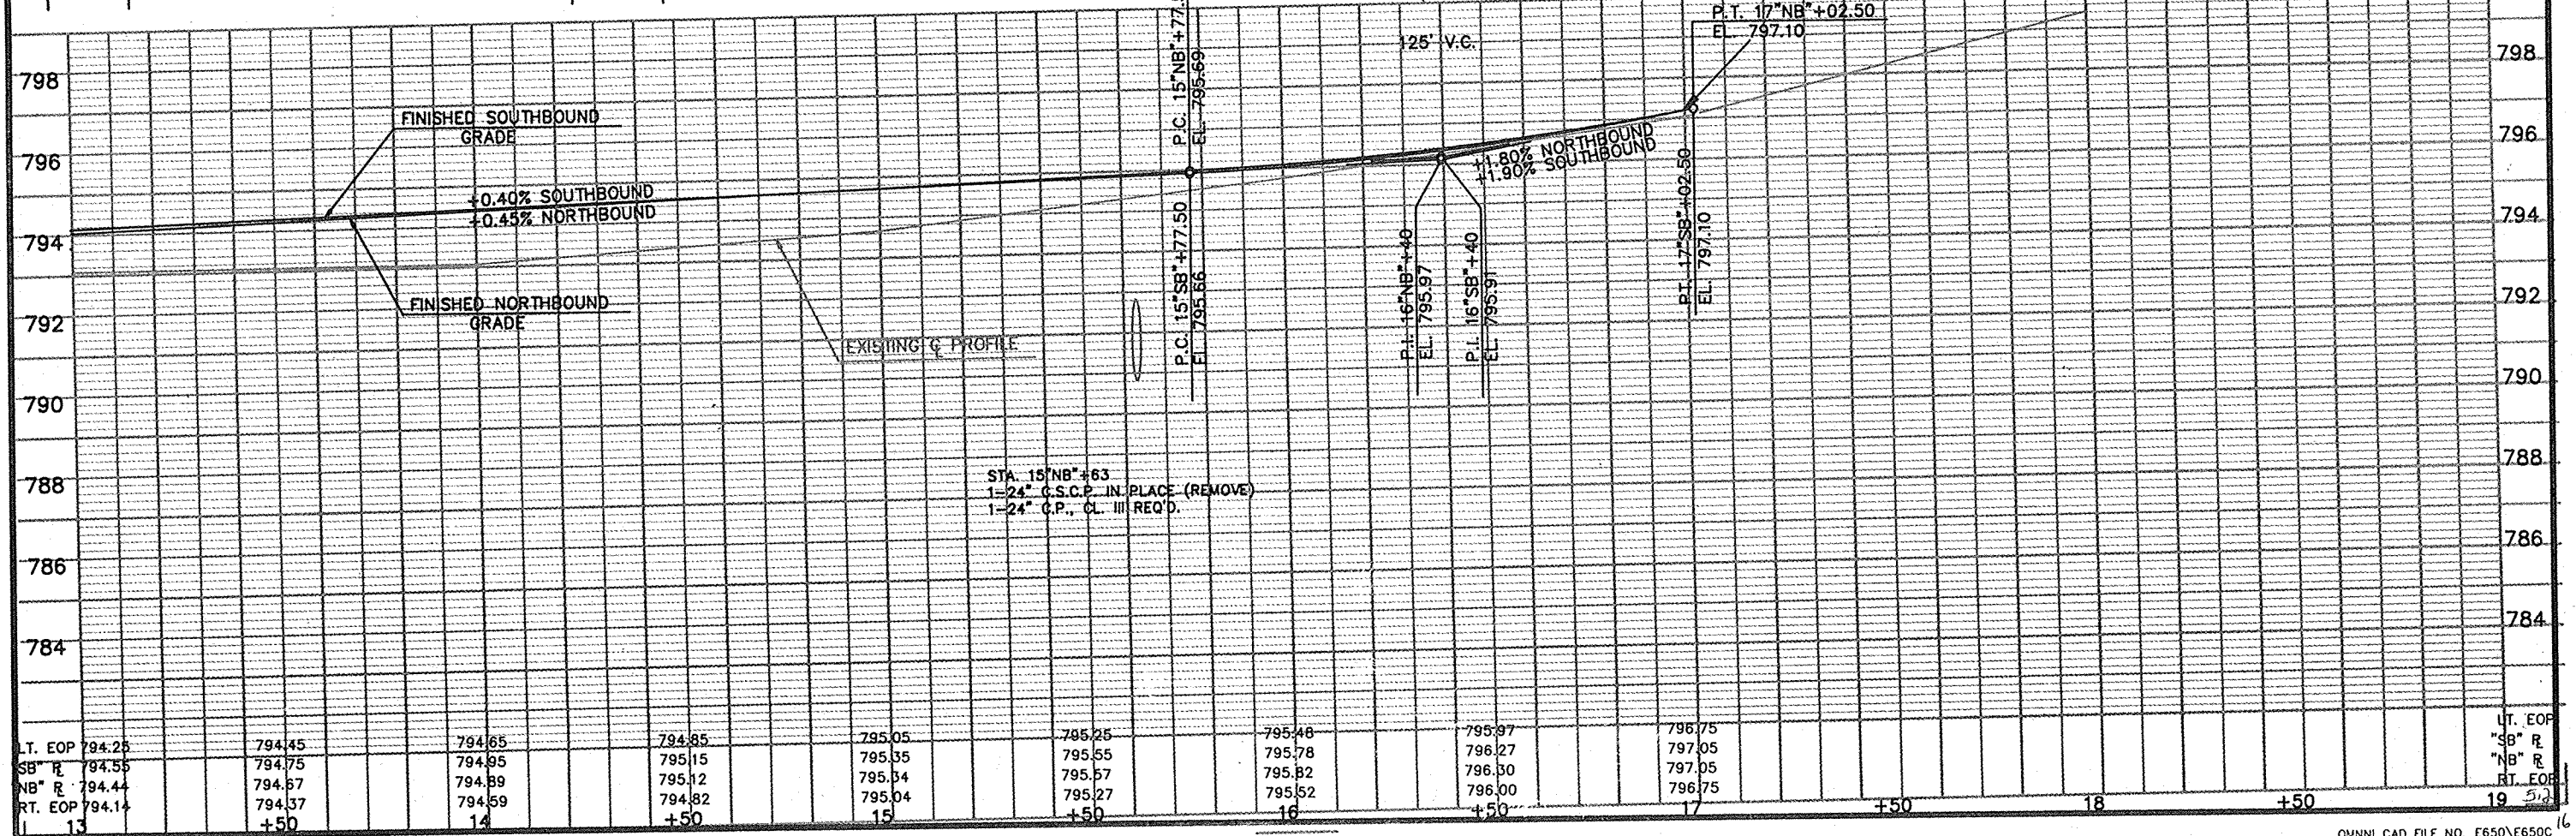

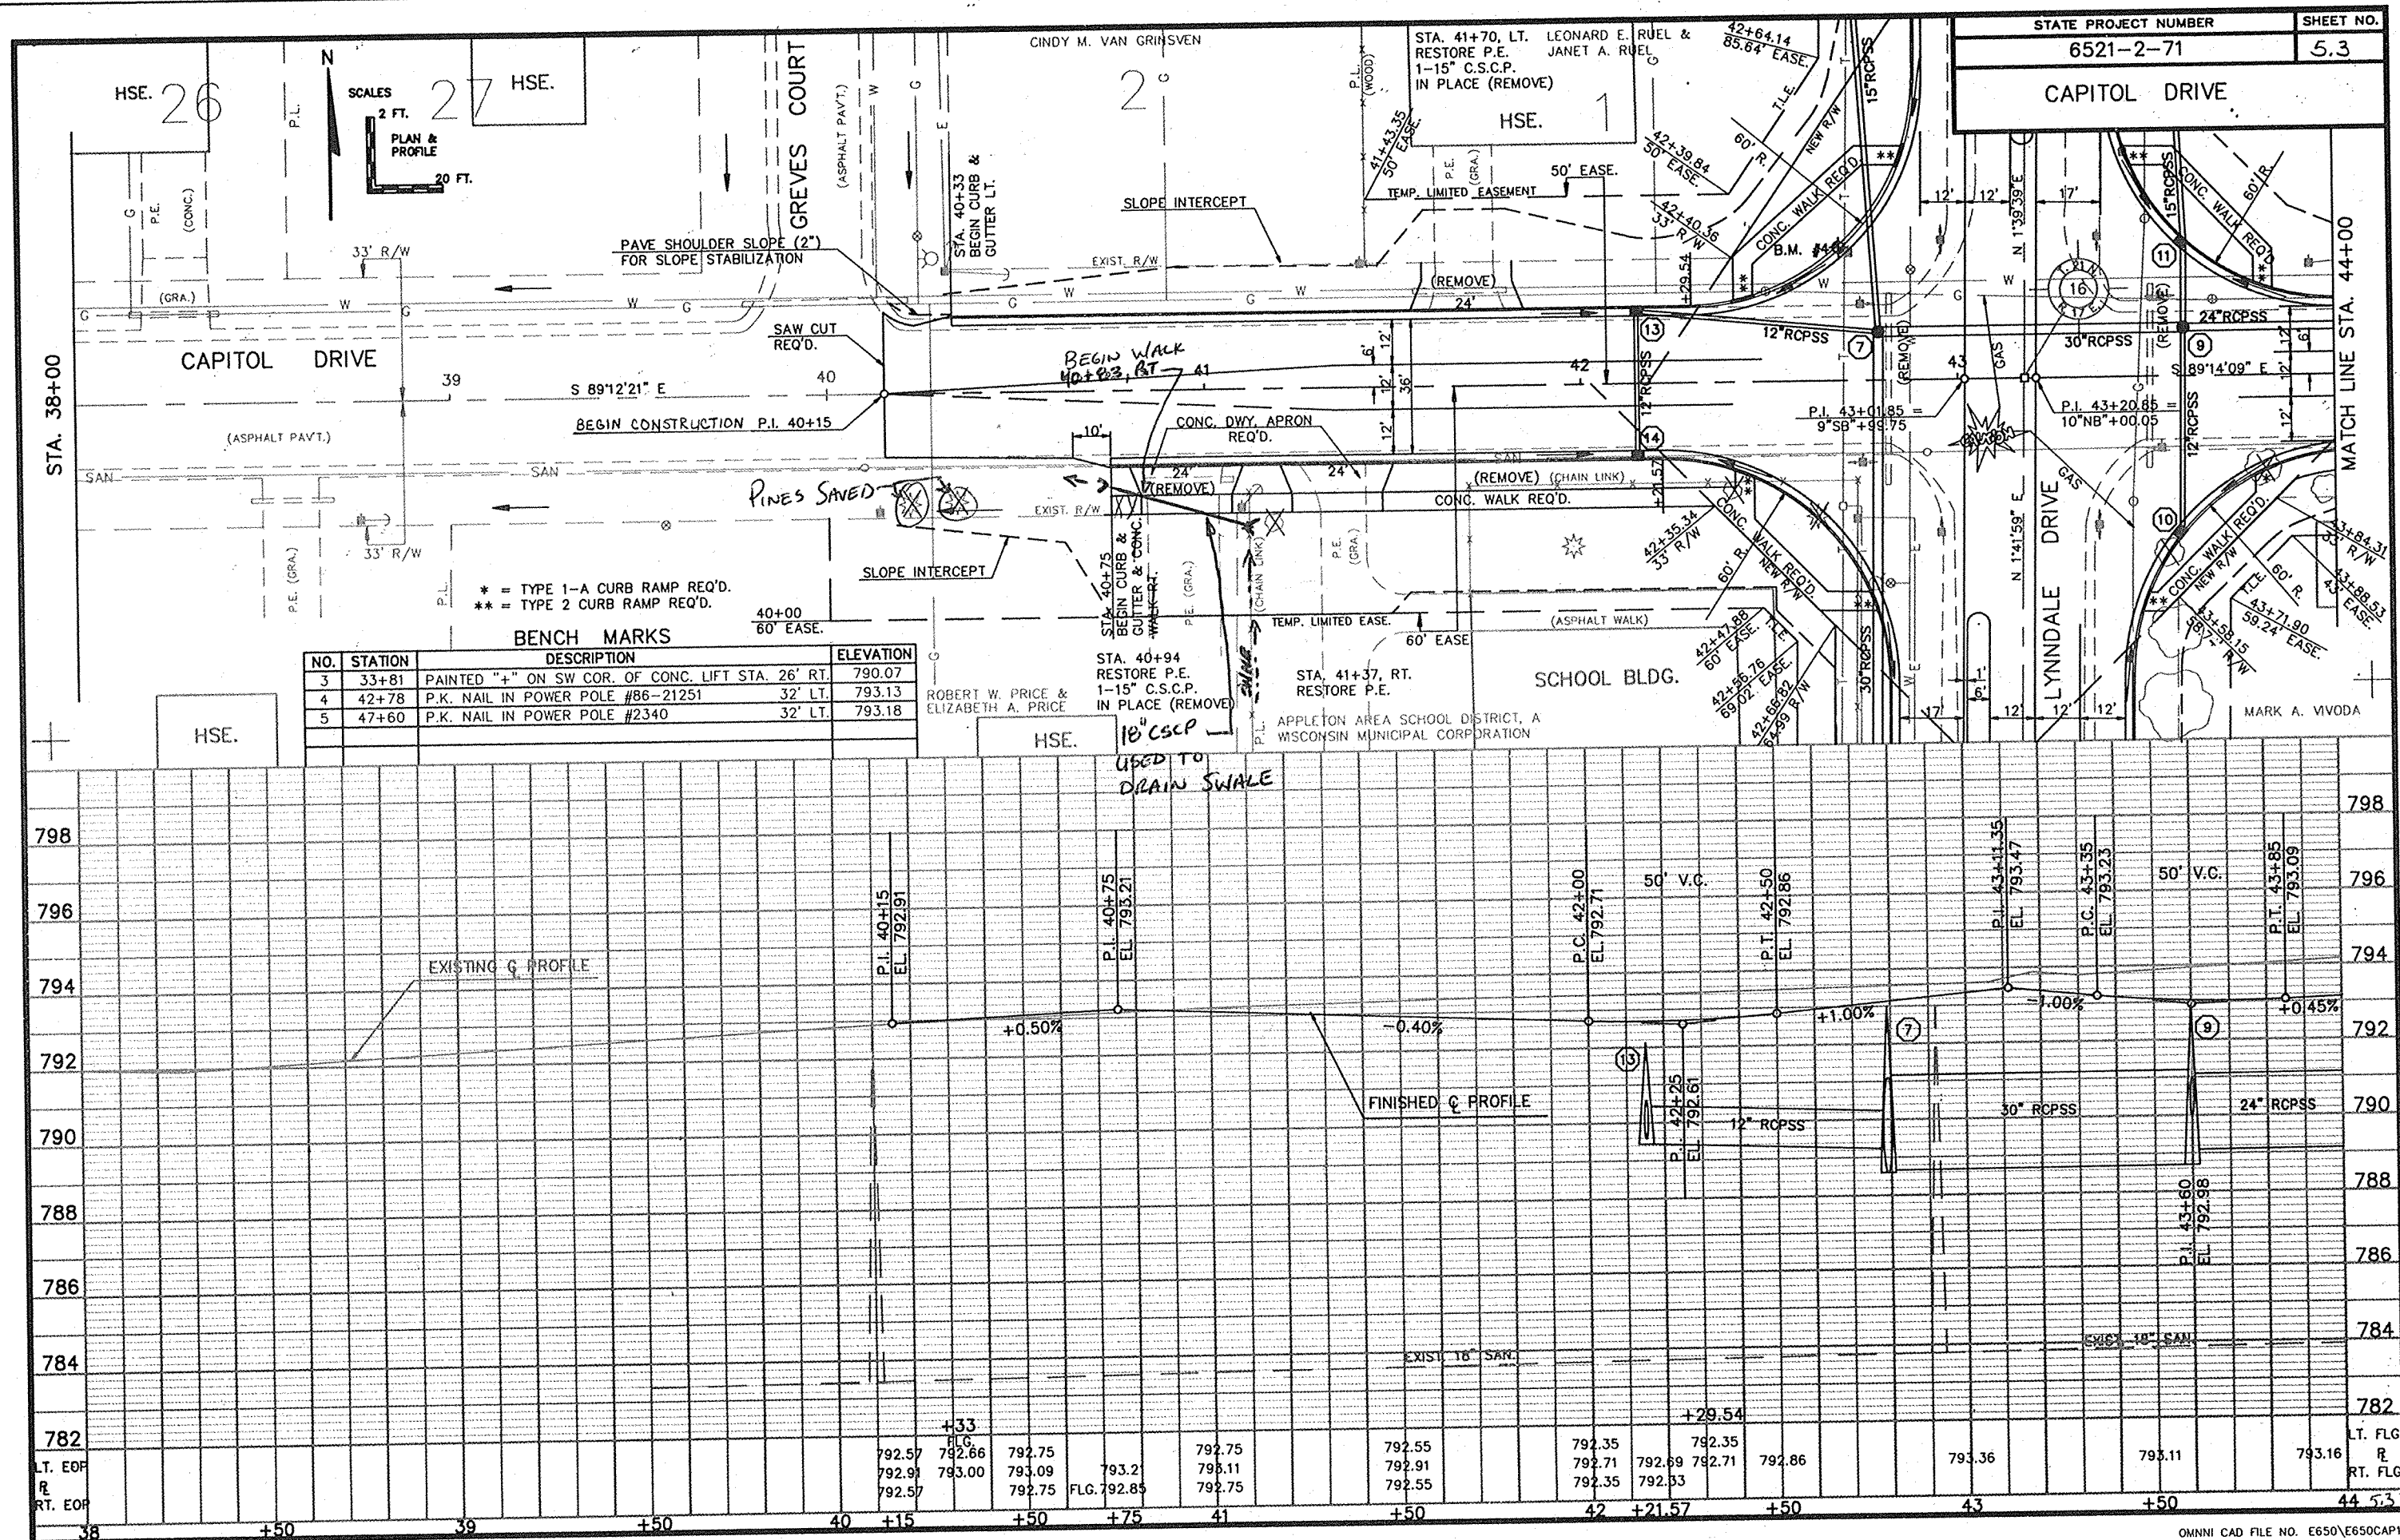

MARIE GRIESBACH, LAND CONTRACT VENDOR
THE APPLETON COMMUNITY EVANGELICAL FREE
CHURCH, LAND CONTRACT VENDEE

STA. 46+82, LT.
RESTORE C.E.
1-18" C.S.C.P. IN PLACE
(REMOVE)


STATE PROJECT NUMBER
6521-2-71

SHEET NO.
5.4

CAPITOL DRIVE


2



SCALES
2 FT.
PLAN &
PROFILE
20 FT.

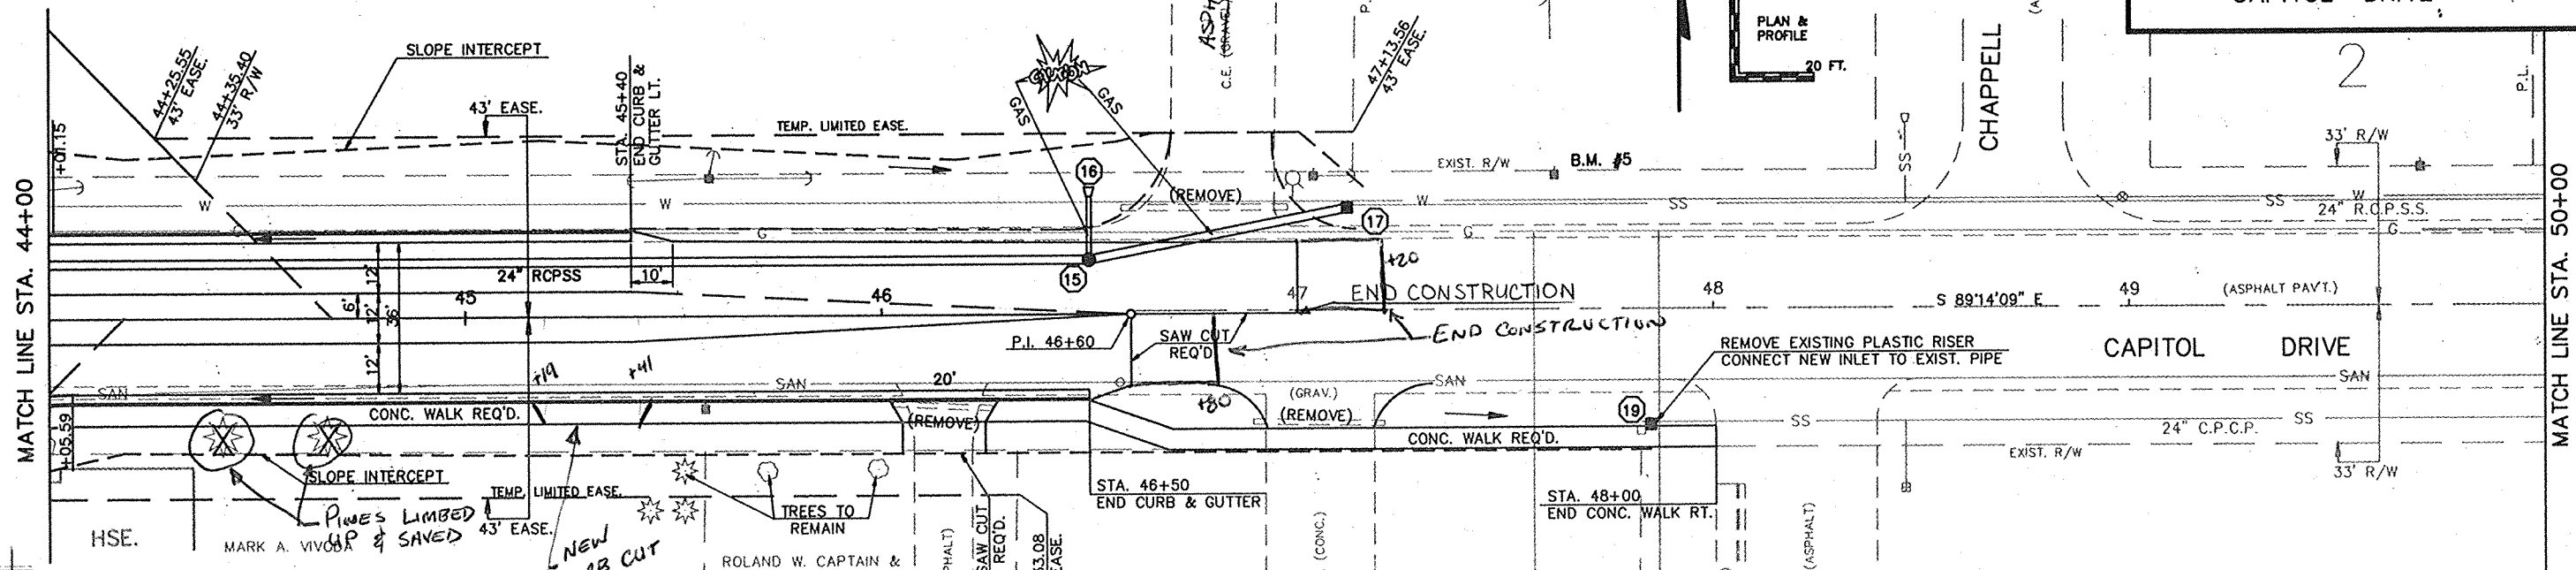


BENCH MARKS

NO.	STATION	DESCRIPTION	ELEVATION
3	33+81	PAINTED "+" ON SW COR. ON CONC. LIFT STA. 26' RT.	790.07
4	42+78	P.K. NAIL IN POWER POLE #86-21251	32' LT. 793.13
5	47+62	P.K. IN POWER POLE #2340	32' LT. 793.18

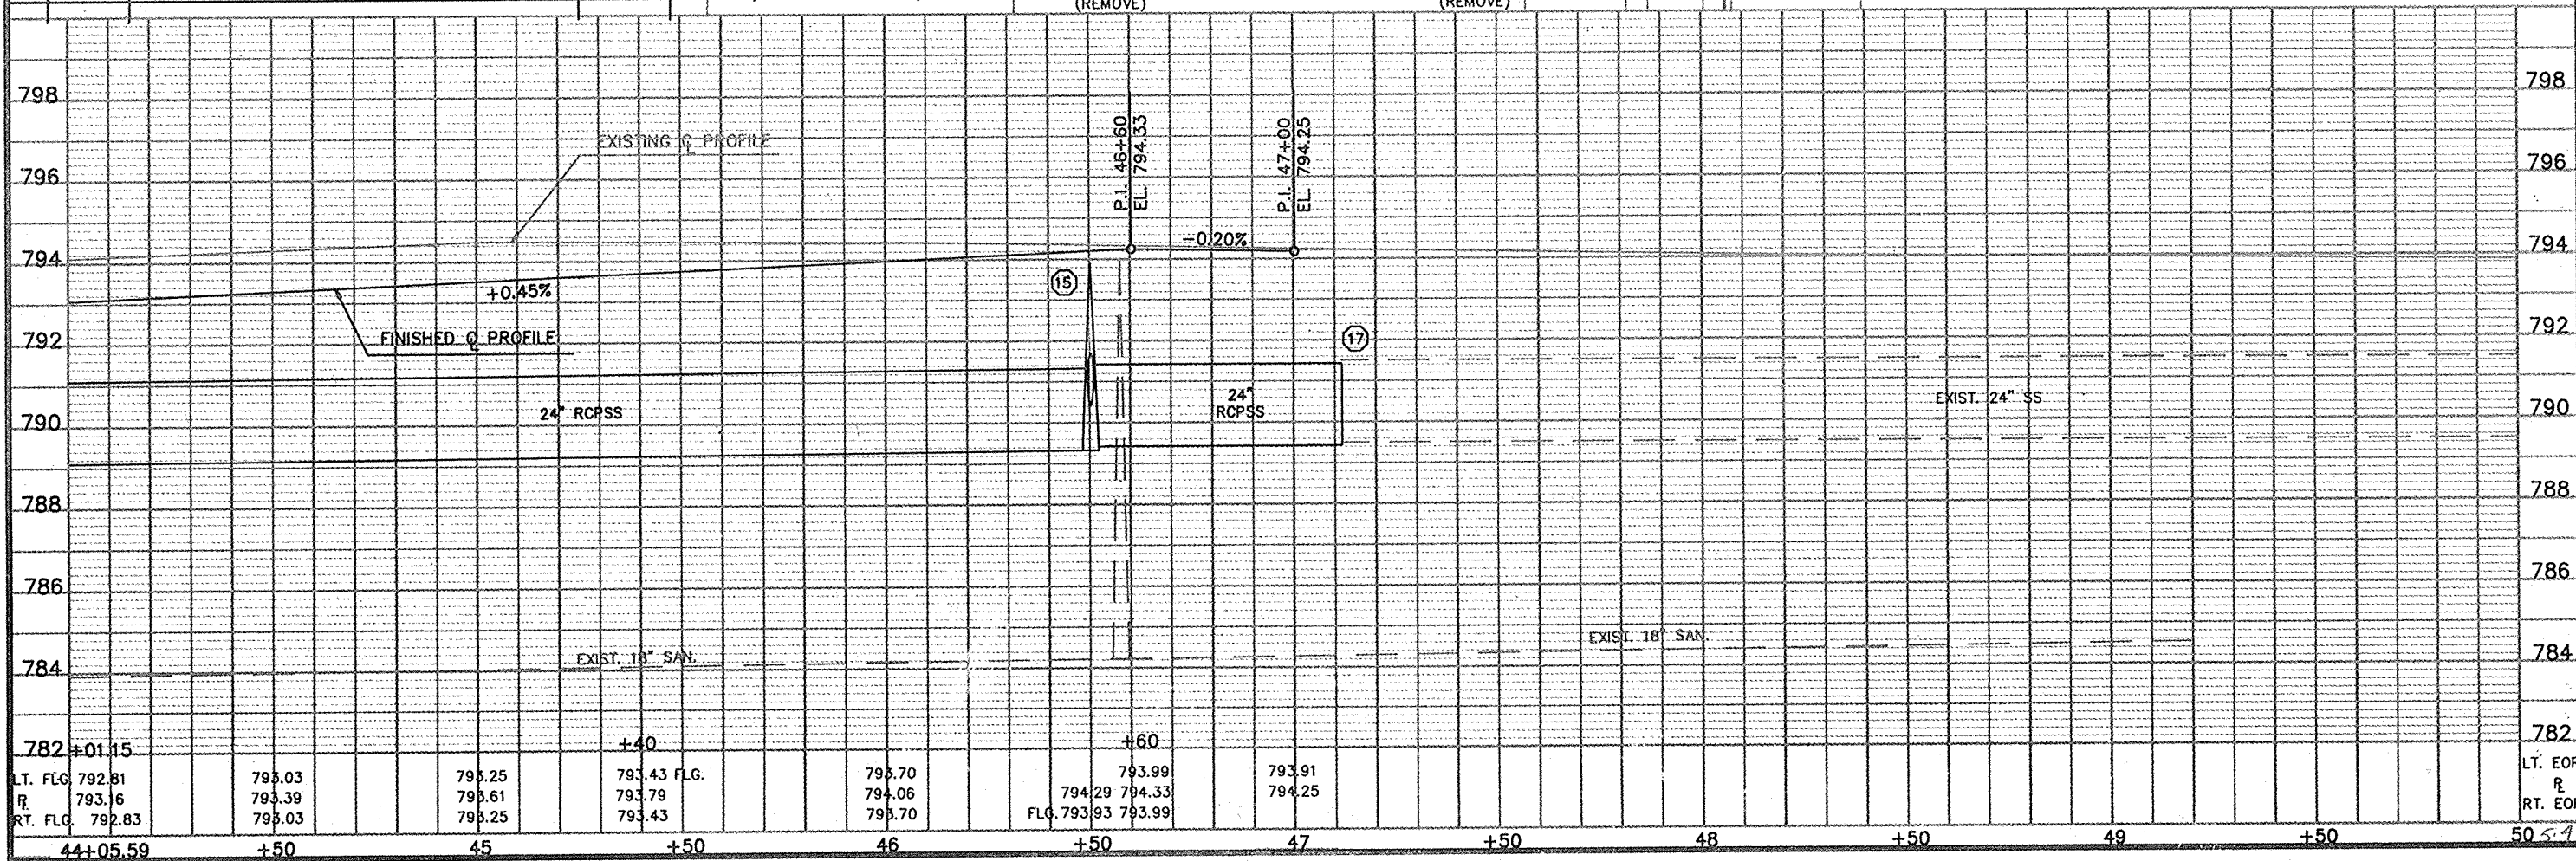


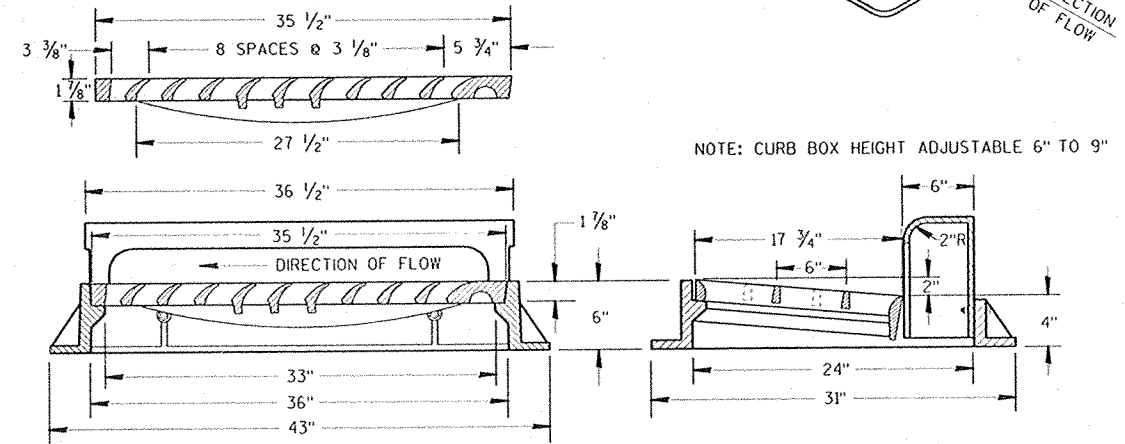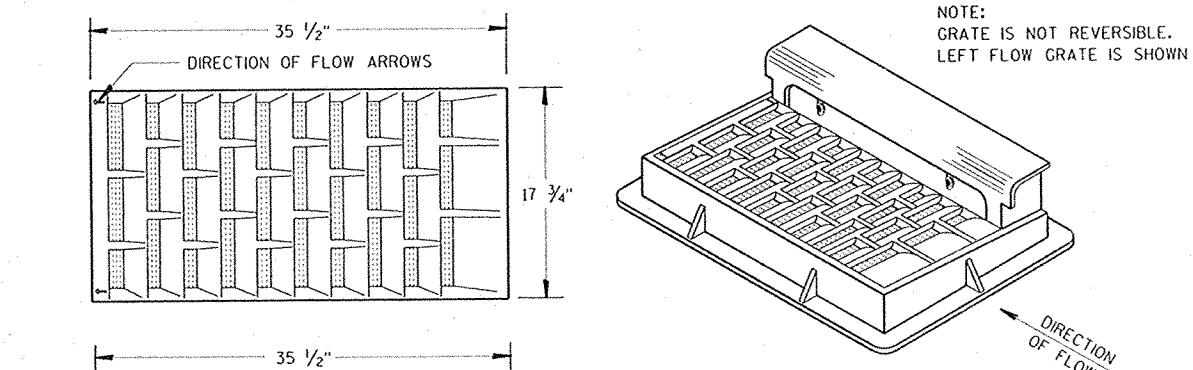




TYPE "H"
(APPROXIMATE WEIGHT 510 LBS.)

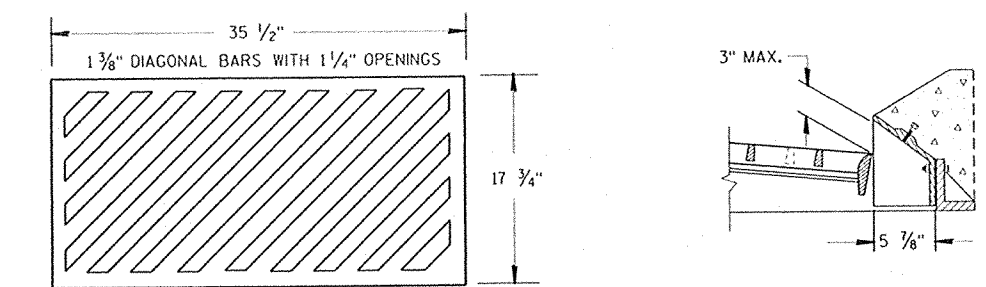



SPECIAL GRATE NO. 1
(APPROXIMATE WEIGHT 175 LBS.)
(NOTE AS TYPE H1 ON DRAINAGE TABLE)

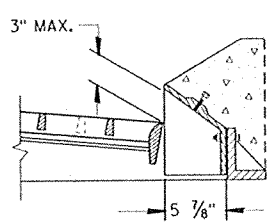



**MOUNTABLE CURB BOX
FOR TYPE "H" COVER**
(FOR USE WITH TYPES G & J CONCRETE CURB & CUTTER, 30 INCH)

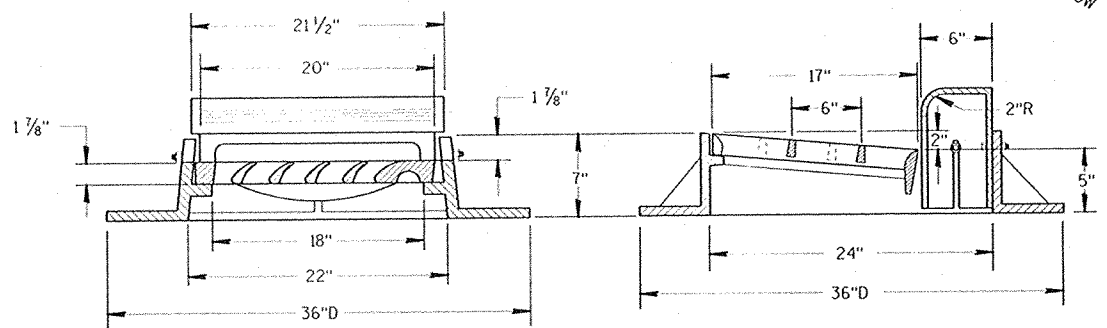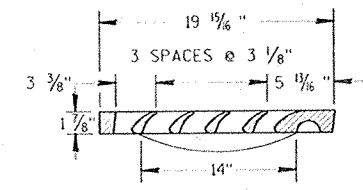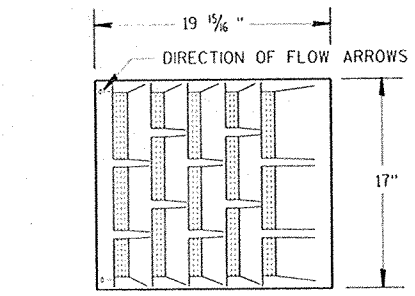



TYPE "A"
(APPROXIMATE WEIGHT 410 LBS.)

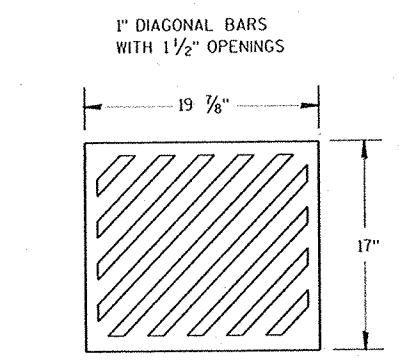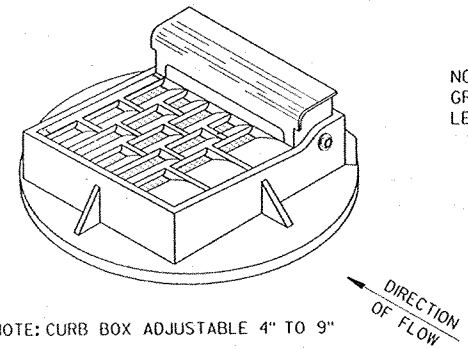

SPECIAL GRATE NO. 1
(APPROXIMATE WEIGHT 85 LBS.)
(NOTE AS TYPE A1 ON DRAINAGE TABLE)

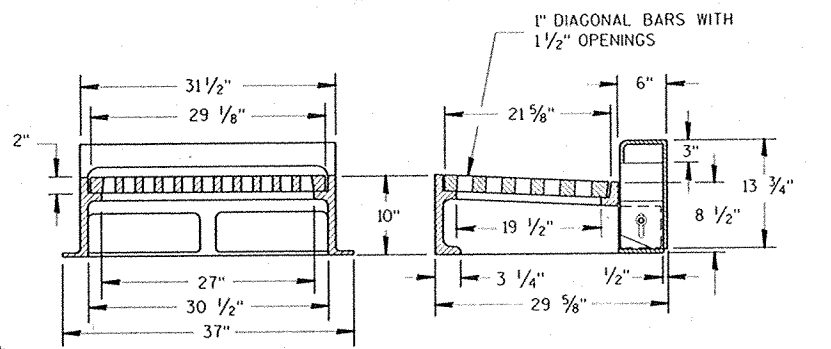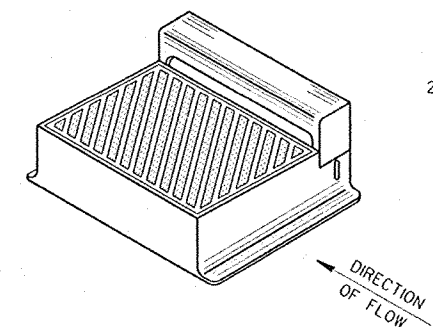

TYPE "WM"
(APPROXIMATE WEIGHT 650 LBS.)

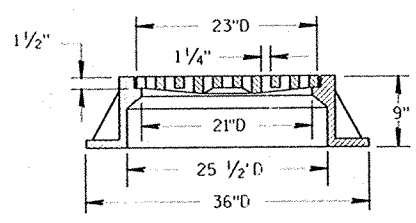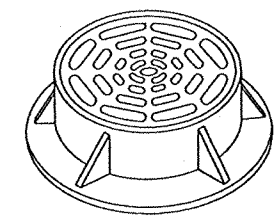

TYPE "C"
(APPROXIMATE WEIGHT 365 LBS.)

GENERAL NOTES

DETAILS OF CONSTRUCTION, MATERIALS AND WORKMANSHIP NOT SHOWN ON THIS DRAWING SHALL CONFORM TO THE PERTINENT REQUIREMENTS OF THE STANDARD SPECIFICATIONS AND THE APPLICABLE SPECIAL PROVISIONS.

DETAIL DRAWINGS FOR PROPOSED ALTERNATE DESIGNS FOR CATCH BASIN, MANHOLE AND INLET COVERS SHALL BE SUBMITTED TO THE ENGINEER FOR APPROVAL PROVIDING THAT SUCH ALTERNATE DESIGNS MAKE PROVISION FOR EQUIVALENT CAPACITY AND STRENGTH.



ROUND FRAMES AND COVERS SHALL HAVE CONTINUOUSLY MACHINED BEARING SURFACES TO PREVENT ROCKING AND RATTLING.

THE ACTUAL WEIGHT OF COVERS MAY VARY WITHIN 5 PERCENT, PLUS OR MINUS, OF THE APPROXIMATE WEIGHT.



INLET COVERS

STATE OF WISCONSIN
DEPARTMENT OF TRANSPORTATION




APPROVED
11/30/90
DATE
STATE DESIGN ENGINEER FOR HWYS
FHWA

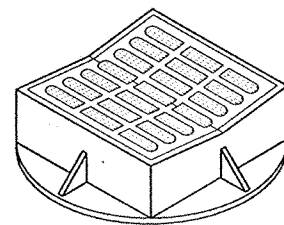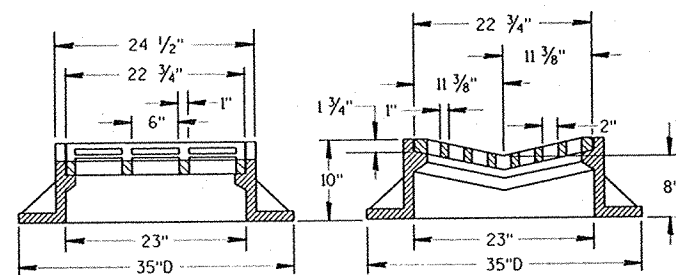


TYPE "B"
(APPROXIMATE WEIGHT 400 LBS.)

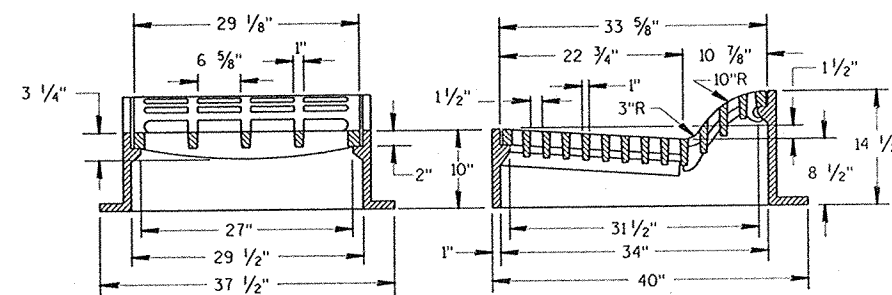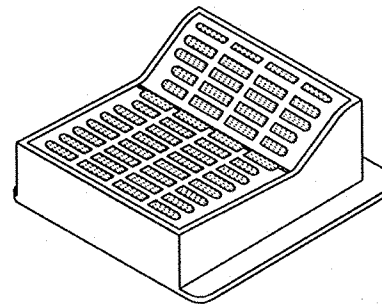

TYPE "F" ①
(APPROXIMATE WEIGHT 835 LBS.)

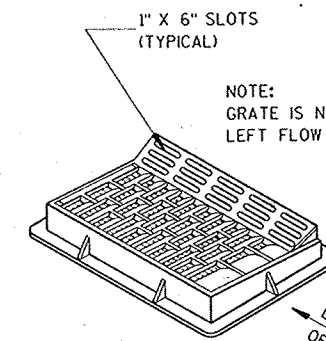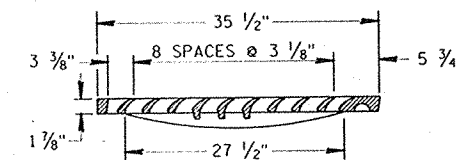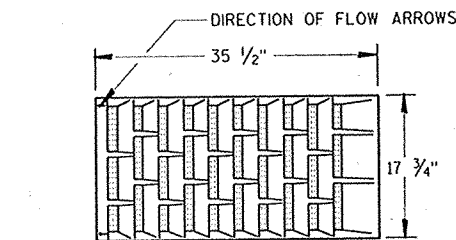

NOTE:
GRATE IS NOT REVERSIBLE.
LEFT FLOW GRATE IS SHOWN

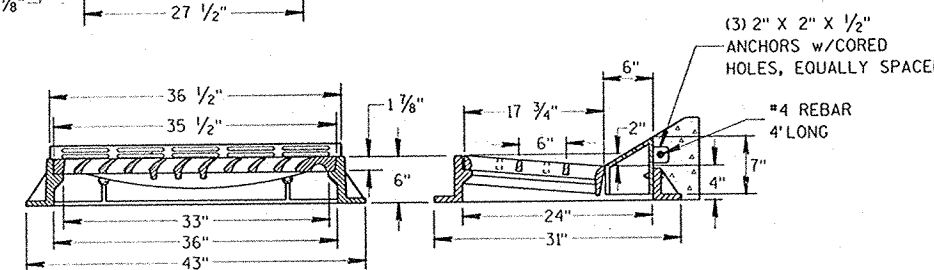

TYPE "HM" ①
(APPROXIMATE WEIGHT 510 LBS.)

NOTE:
SPECIAL GRATE NO. 1 FOR THE
TYPE "H" COVER MAY ALSO BE
USED FOR THE TYPE "HM" COVER


GENERAL NOTES

DETAILS OF CONSTRUCTION, MATERIALS AND WORKMANSHIP NOT SHOWN ON THIS DRAWING SHALL CONFORM TO THE PERTINENT REQUIREMENTS OF THE STANDARD SPECIFICATIONS AND THE APPLICABLE SPECIAL PROVISIONS.



DETAIL DRAWINGS FOR PROPOSED ALTERNATE DESIGNS FOR INLET COVERS SHALL BE SUBMITTED TO THE ENGINEER FOR APPROVAL PROVIDING THAT SUCH ALTERNATE DESIGNS MAKE PROVISION FOR EQUIVALENT CAPACITY AND STRENGTH.

THE ACTUAL WEIGHT OF COVERS MAY VARY WITHIN 5 PERCENT, PLUS OR MINUS, OF THE APPROXIMATE WEIGHT.



① FOR USE WITH CONCRETE CURB & GUTTER, 36 INCH.

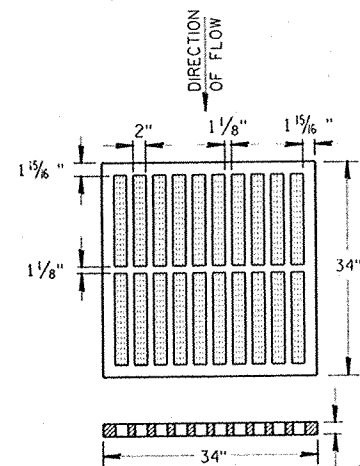

TYPE "MS"
(APPROXIMATE GRATE WEIGHT 285 LBS.)

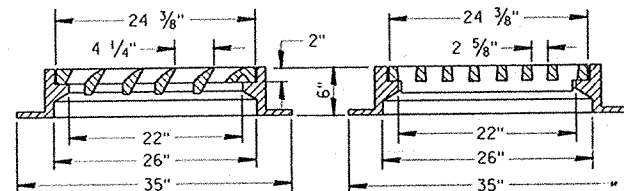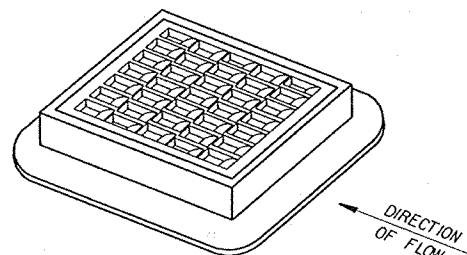

TYPE "S"
(APPROXIMATE WEIGHT 400 LBS.)

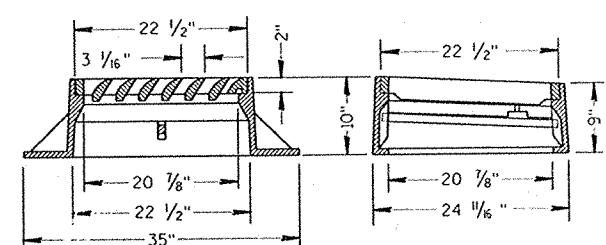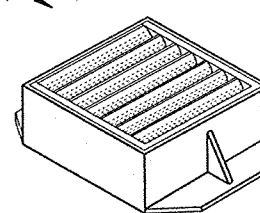



TYPE "V"
(APPROXIMATE WEIGHT 400 LBS.)

INLET COVERS



STATE OF WISCONSIN
DEPARTMENT OF TRANSPORTATION

APPROVED
11/30/90
DATE
FHWA

STATE DESIGN ENGINEER FOR HWYS

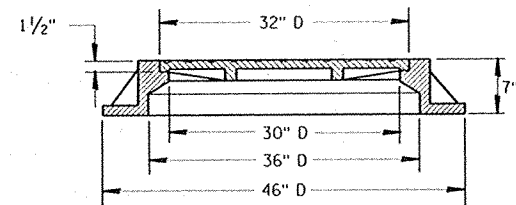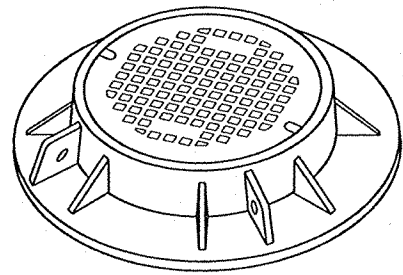

TYPE "K"
(APPROXIMATE WEIGHT 550 LBS.)

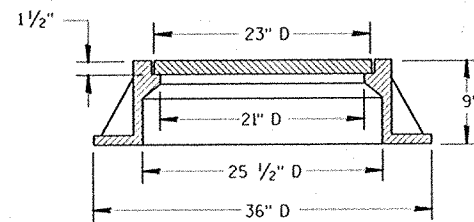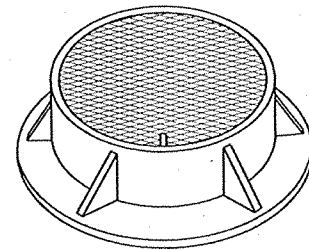

TYPE "J"
(APPROXIMATE WEIGHT 395 LBS.)


GENERAL NOTES

DETAILS OF CONSTRUCTION, MATERIALS AND WORKMANSHIP NOT SHOWN ON THIS DRAWING SHALL CONFORM TO THE PERTINENT REQUIREMENTS OF THE STANDARD SPECIFICATIONS AND THE APPLICABLE SPECIAL PROVISIONS.



DETAIL DRAWINGS FOR PROPOSED ALTERNATE DESIGNS FOR MANHOLE COVERS SHALL BE SUBMITTED TO THE ENGINEER FOR APPROVAL PROVIDING THAT SUCH ALTERNATE DESIGNS MAKE PROVISION FOR EQUIVALENT CAPACITY AND STRENGTH.

ROUND FRAMES AND COVERS SHALL HAVE CONTINUOUSLY MACHINED BEARING SURFACES TO PREVENT ROCKING AND RATTLING.



THE ACTUAL WEIGHT OF COVERS MAY VARY WITHIN 5 PERCENT, PLUS OR MINUS, OF THE APPROXIMATE WEIGHT.

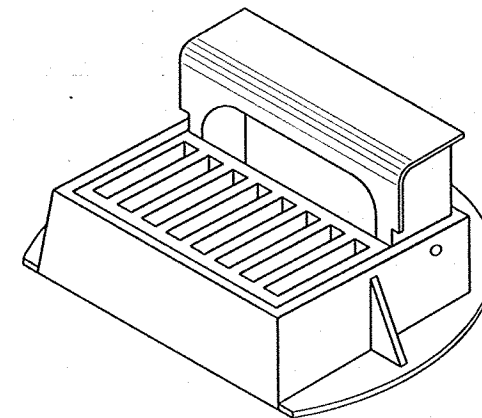

CURB BOX ADJUSTABLE 4" TO 10"

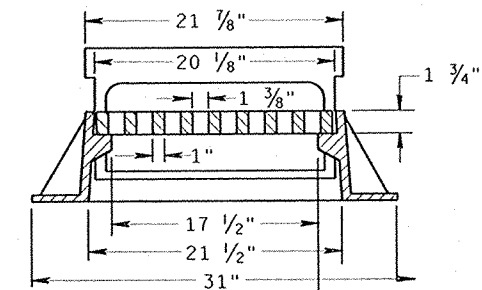
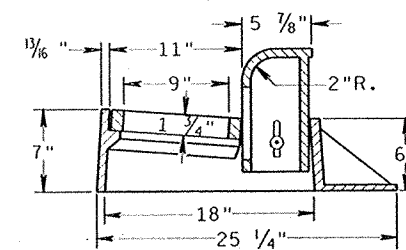


INLET COVER TYPE "Z"
(APPROXIMATE WEIGHT 270 LBS.)

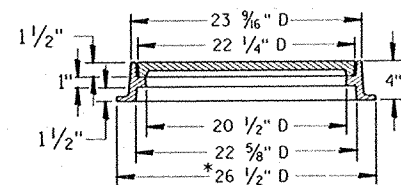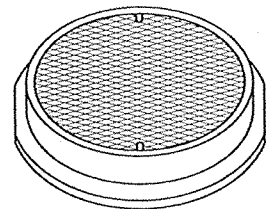

* THIS DIMENSION IS 25 1/2" ON BEVELED SIDE

TYPE "L"
(APPROXIMATE WEIGHT 146 LBS.)

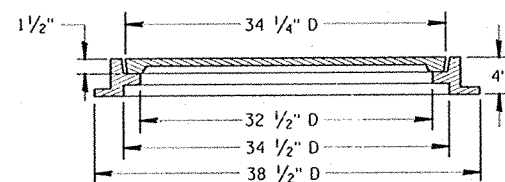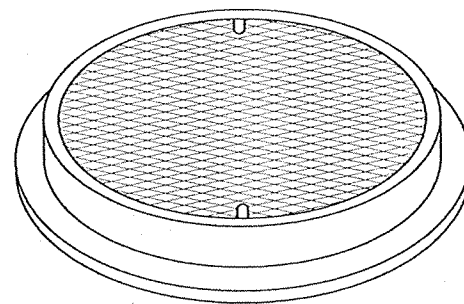


TYPE "M"
(APPROXIMATE WEIGHT 385 LBS.)


INLET AND MANHOLE COVERS

STATE OF WISCONSIN
DEPARTMENT OF TRANSPORTATION


APPROVED
11/30/90
DATE
STATE DESIGN ENGINEER FOR HWYS
FHWA

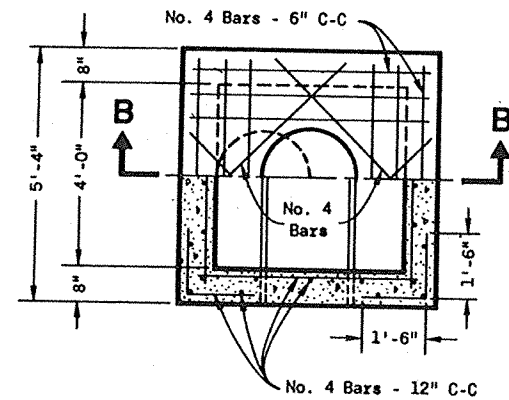


HALF SECTION A-A

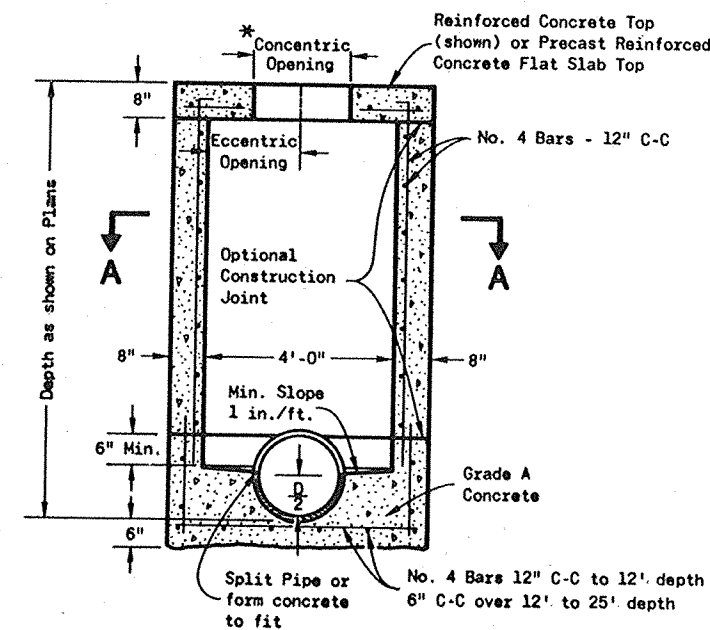

SECTION B-B
REINFORCED CONCRETE

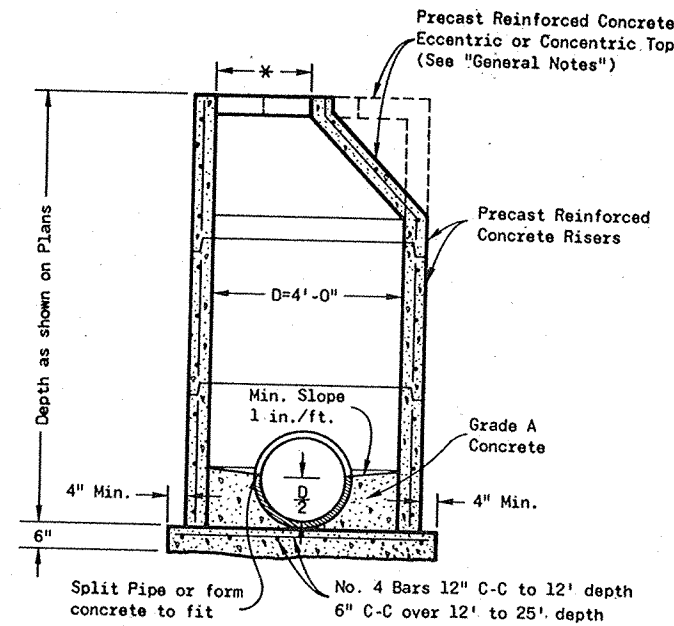

PRECAST REINFORCED CONCRETE

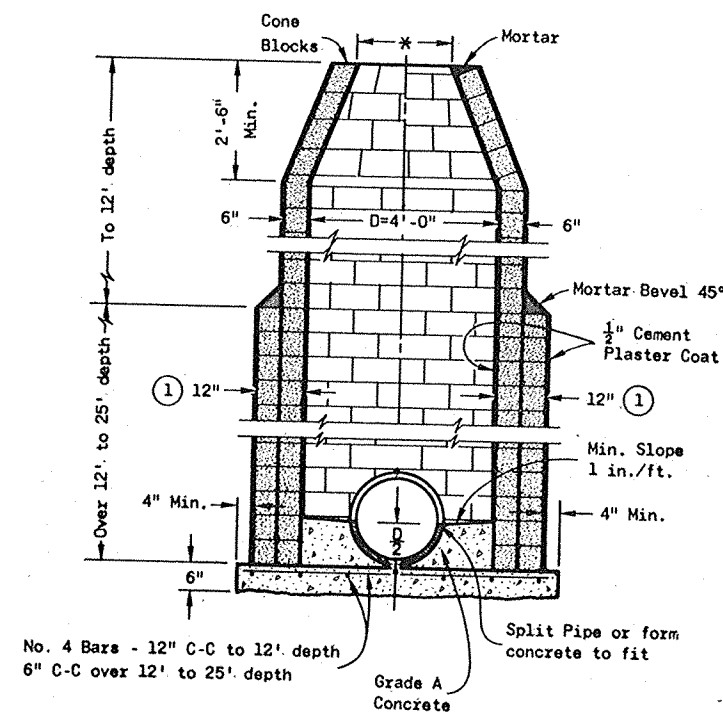

CONCRETE BLOCK

GENERAL NOTES

Details of construction, materials and workmanship not shown on this drawing shall conform to the pertinent requirements of the Standard Specifications and the applicable Special Provisions.

Detailed drawings for proposed alternate designs for underground drainage structures shall be submitted to the Engineer for approval providing that such alternate designs make provision for equivalent capacity and strength.

All drainage structures are designated on the plans as "Manholes 1-C", "Catch Basins 1-B", "Inlets 3-H", etc. The first digit designates the masonry portion of the structure, and the following letter designates the type of cover to be used to comprise the complete unit.

Precast Reinforced Bases shall be placed on a bed of material at least 6 inches in depth, which meets the requirements for Granular Backfill. This bedding shall be compacted and provide uniform support for the entire area of the base.

Precast Reinforced Concrete Cone Tops (Eccentric or Concentric) may be used on concrete block structures. The Cone Tops shall be installed on a bed of mortar.

Eccentric Cone Tops may be used on all structures, and Concentric Cone Tops shall be used only on structures 5 feet or less in depth, unless otherwise directed by the Engineer.

Steps meeting the following requirements shall be installed in all structures over 5 feet in depth: 16 inch C-C maximum spacing; project a minimum clear distance of 4 inches from the wall at the point of embedment; minimum length of 10 inches; minimum wall embedment of 3 inches; and be capable of supporting a concentrated load of 300 lbs. Ferrous metal steps not painted or treated to resist corrosion shall have a minimum cross sectional dimension of 1 inch.

Solid Aluminum steps shall have a minimum cross sectional dimension of 0.75 inch. Aluminum surfaces to be embedded in concrete shall be given one coat of suitable quality paint, such as zinc chromate primer conforming to Federal Specification TT-P-645 or equivalent. Steps of approved Polypropylene plastic coated reinforcement bar will be acceptable.

All bar steel reinforcement shall be embedded 2 inches clear unless otherwise shown or noted.

Precast Reinforced Concrete Risers may be placed with tongue up or down.

All Precast Inlet Units shall conform to the pertinent requirements of AASHTO Designation M 199.

* Use 2'-0" diameter opening with Type "C", "L" and "J" covers, or 3'-0" diameter with Type "K" and "M" covers.

① 2 courses 6" block.


MANHOLES TYPE 1

MANHOLES TYPE 1

State of Wisconsin
Department of Transportation


APPROVED
4-13-82
DATE

CHIEF DESIGN ENGINEER

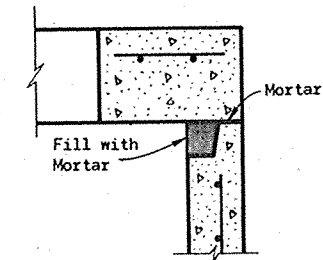

DETAIL "A"

*Selection of square or circular design will be based on the pipe sizes and the Inlet Cover being utilized.

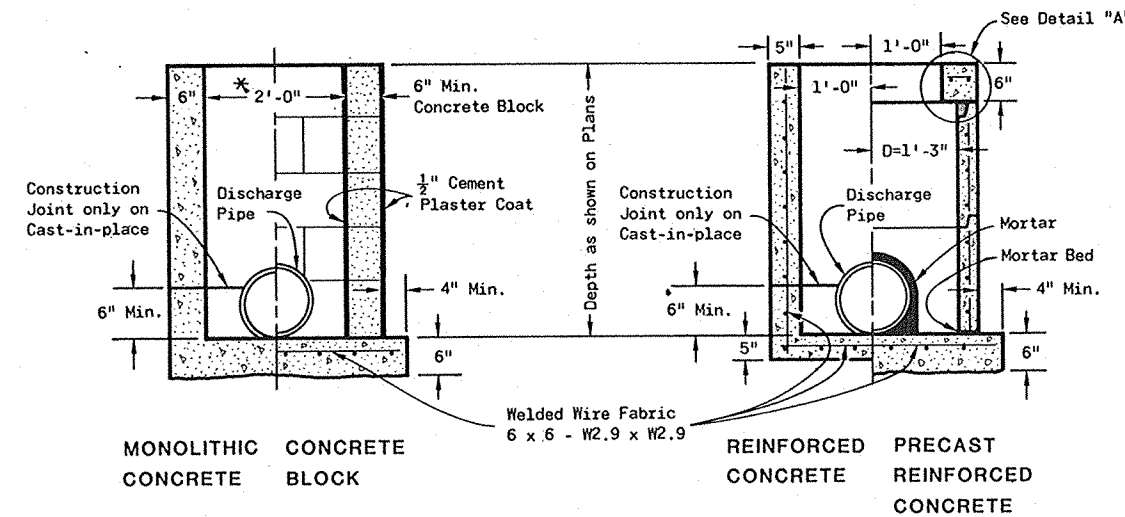

INLETS TYPE 1

GENERAL NOTES

Details of construction, materials and workmanship not shown on this drawing shall conform to the pertinent requirements of the Standard Specifications and the applicable Special Provisions.

Detailed drawings for proposed alternate designs for underground drainage structures shall be submitted to the Engineer for approval providing that such alternate designs make provision for equivalent capacity and strength.

All Precast Inlet units shall conform to the pertinent requirements of AASHTO Designation M 199.

All drainage structures are designated on the plans as "Manholes 1-C", "Catch Basins 1-B", "Inlets 3-H", etc. The first digit designates the masonry portion of the structure, and the following letter designates the type of cover to be used to comprise the complete unit.


Precast Reinforced Bases shall be placed on a bed of material at least 6 inches in depth, which meets the requirements for Granular Backfill. This bedding shall be compacted and provide uniform support for the entire area of the base.

Precast Reinforced Concrete Flat Slab Tops may be used on the structures. The Tops shall be installed on a bed of mortar.


All Bar Steel reinforcement shall be embedded 2 inches clear unless otherwise shown or noted.

Precast Reinforced Concrete Risers shall be placed with tongue down.


- ① Use 2'-6" opening for Type 2 Inlets and 3'-0" opening for Type 3 Inlets.

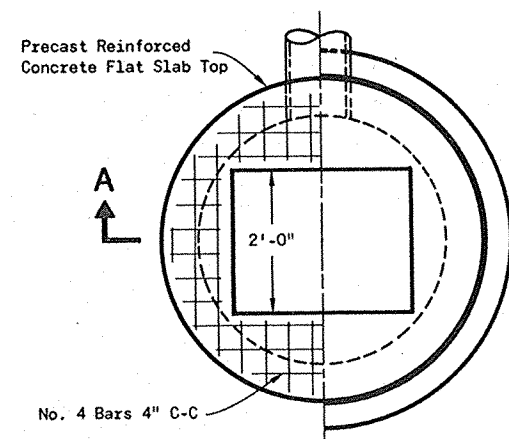


PLAN VIEW

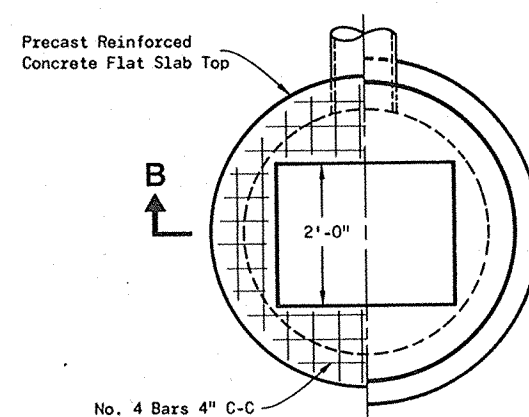


PLAN VIEW

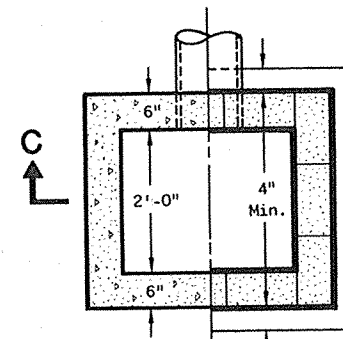

PLAN VIEW

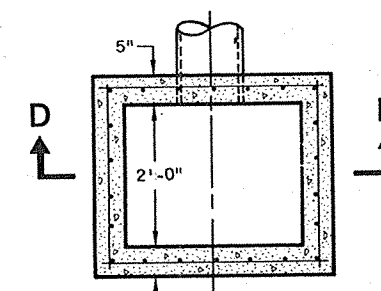


PLAN VIEW

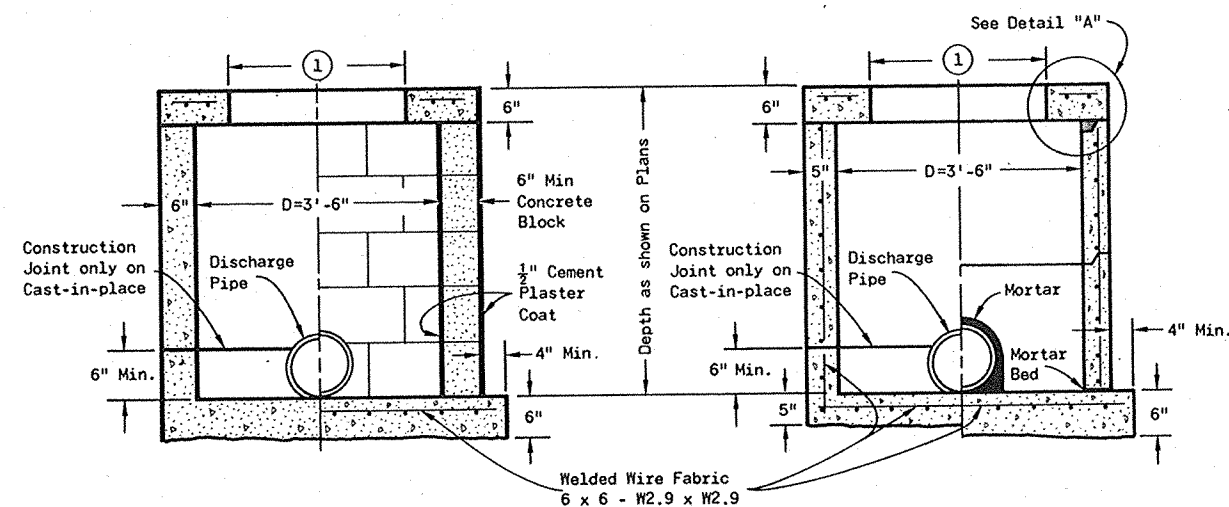


MONOLITHIC CONCRETE
CONCRETE BLOCK

SECTION A-A

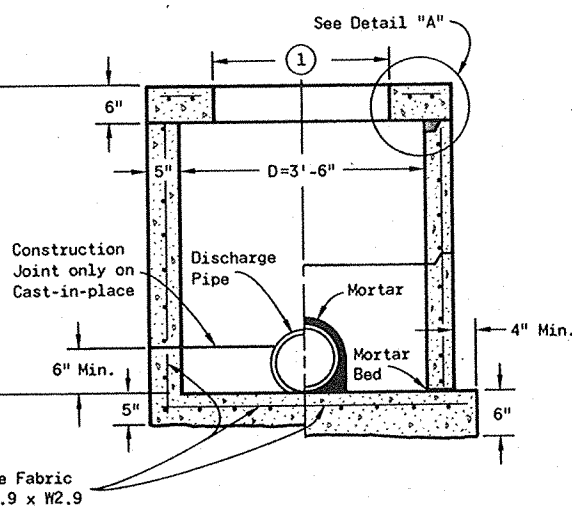


REINFORCED CONCRETE
PRECAST REINFORCED CONCRETE

SECTION B-B

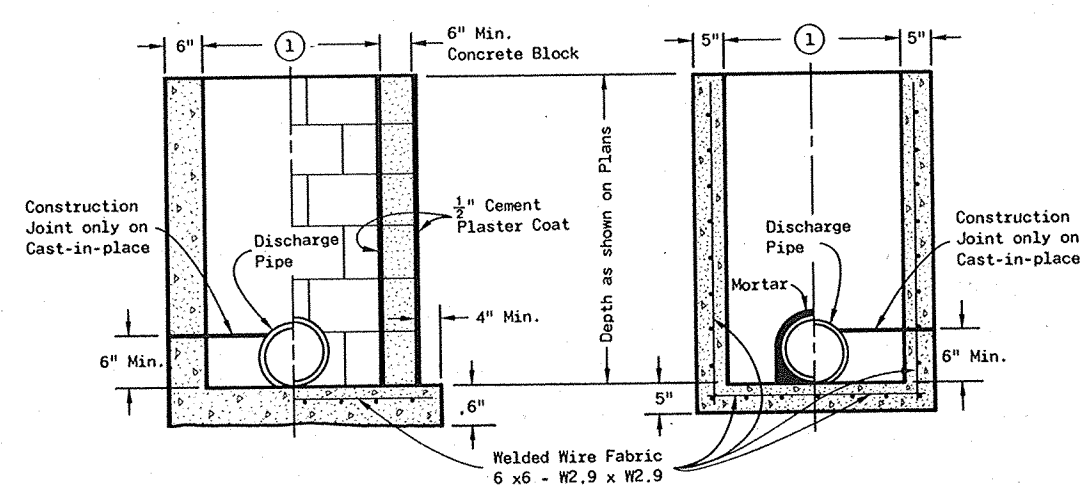

MONOLITHIC CONCRETE
CONCRETE BLOCK

SECTION C-C

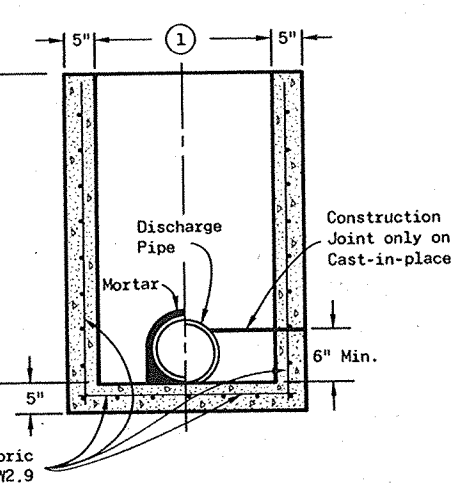

PRECAST REINFORCED CONCRETE
REINFORCED CONCRETE

SECTION D-D

INLETS TYPE 2 & 3


INLETS TYPE 1, 2 & 3

State of Wisconsin
Department of Transportation


APPROVED
4-13-82
DATE
FWA

CHIEF DESIGN ENGINEER


S.D.D. 8 C 1-4

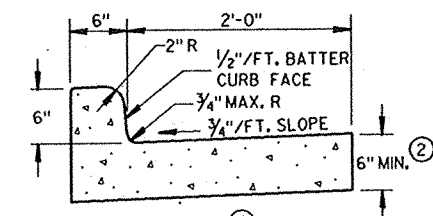


TYPES A & D

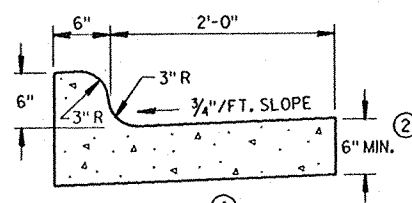


TYPES K & L

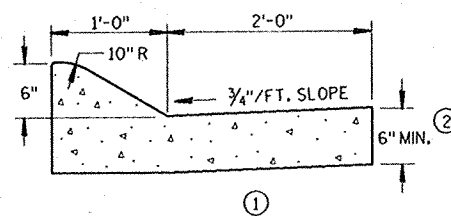


TYPES A & D
CONCRETE CURB & GUTTER 36"

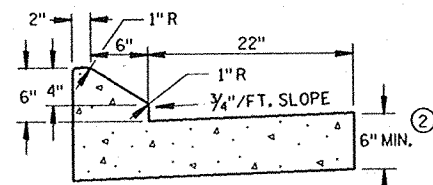

TYPES G & J

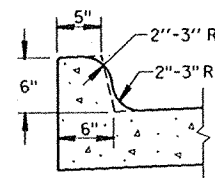


OPTIONAL CURB SHAPE
FOR TYPES K & L

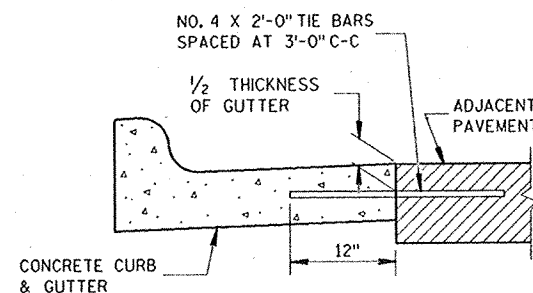


TYPICAL TIE BAR LOCATION

CONCRETE CURB & GUTTER 30"

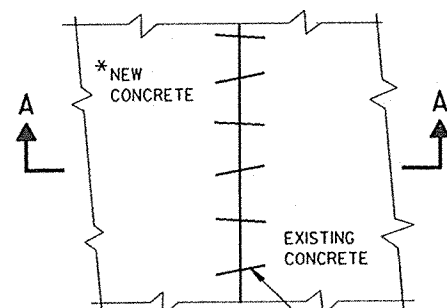

PLAN VIEW

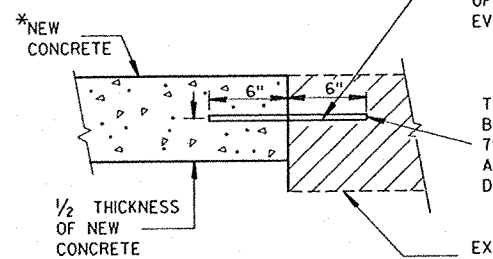


SECTION A-A
PAVEMENT TIES

*NEW CURB & GUTTER,
SURFACE DRAINS,
CONCRETE PAVEMENT
OR OTHER NEW CONCRETE.


NO. 6 X 12" DEF. BARS
SPACED 3'-0" C-C,
INSTALLED ON 6:1 SKEW
HORIZONTALLY. DIRECTION
OF SKEW ALTERNATING AFTER
EVERY ONE OR TWO BARS.

THE HOLE FOR THE BAR SHALL
BE DRILLED TO A DEPTH OF
7" AND TO SUCH A DIAMETER
AS TO PROVIDE A TIGHT
DRIVEN FIT

EXISTING
CONCRETE

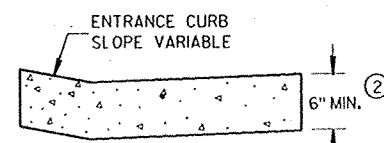


DRIVEWAY ENTRANCE CURB
(WHEN DIRECTED BY THE ENGINEER)

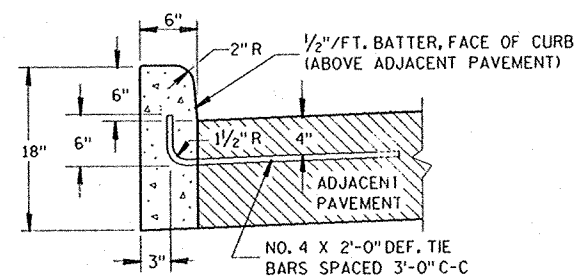


TYPES A & D


CONCRETE CURB

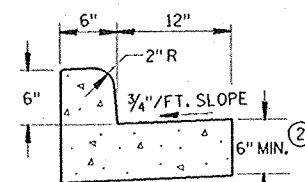


TYPES A & D
CONCRETE CURB & GUTTER 18"

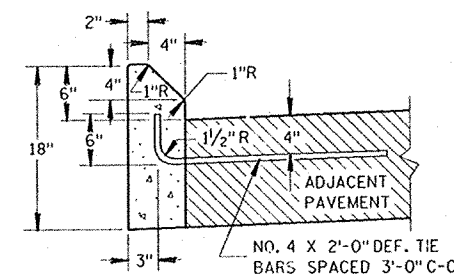

TYPES G & J

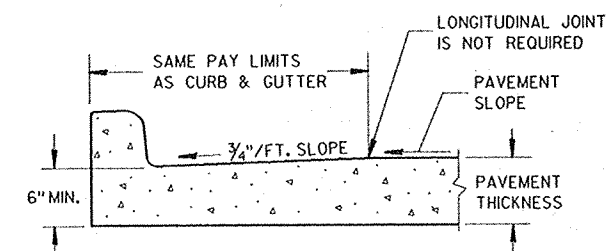

PARTIAL SECTION OF PAVEMENT
WITH INTEGRAL CURB & GUTTER

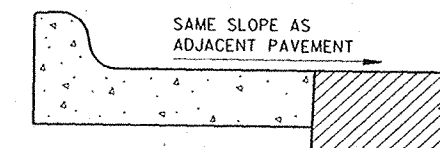

REVERSE SLOPE GUTTER
(TYPICAL FOR ALL CURB & GUTTER TYPES)

GENERAL NOTES

DETAILS OF CONSTRUCTION, MATERIALS AND WORKMANSHIP NOT SHOWN ON THIS DRAWING SHALL CONFORM TO THE PERTINENT REQUIREMENTS OF THE CONTRACT.

SEALANT IS NOT REQUIRED IN THE JOINTS OF CONCRETE CURB OR CONCRETE CURB & GUTTER EXCEPT AS REQUIRED FOR INTEGRAL GUTTER.

PAVEMENT TIES ARE REQUIRED, WHEN INCLUDED IN THE CONTRACT, WHERE CONCRETE CURB, CONCRETE CURB AND GUTTER OR CONCRETE PAVEMENT IS PLACED ADJACENT TO EXISTING CONCRETE.

PAVEMENT TIES AND TIE BARS SHALL BE EPOXY COATED IN CONFORMANCE WITH SUBSECTION 505.2.4 OF THE STANDARD SPECIFICATIONS.

INTEGRAL CURB & GUTTER SHALL CONFORM TO THE DETAILS SHOWN FOR CONCRETE CURB & GUTTER INCLUDING THE TRANSVERSE GUTTER SLOPE. TIE BARS AND A LONGITUDINAL CONSTRUCTION JOINT ARE NOT REQUIRED WITH THIS ALTERNATE.

PAVEMENT JOINTS SHALL BE EXTENDED THROUGH INTEGRAL CURB & GUTTER. JOINTS IN INTEGRAL GUTTER SHALL HAVE THE SAME DIMENSIONS AS THE JOINTS IN THE ADJACENT PAVEMENT. JOINTS IN INTEGRAL CURB SHALL BE 1/8" WIDE.

JOINTS IN INTEGRAL CURB & GUTTER SHALL BE SEALED TO THE FACE OF CURB WITH THE SAME SEALANT SPECIFIED FOR THE PAVEMENT JOINT. THE COST OF FURNISHING AND INSTALLING THIS SEALANT SHALL BE INCIDENTAL TO THE ITEM CONCRETE CURB & GUTTER.

UNLESS OTHERWISE SHOWN ON THE TYPICAL CROSS SECTIONS, THE BASE COURSE AND UNCLASSIFIED EXCAVATION LIMITS ARE TWO FEET BEHIND THE BACK OF CURBS.

- ① TIE BARS ARE REQUIRED FOR CURB AND GUTTER TYPES A, G AND K.
- ② THE BOTTOM OF CURB AND GUTTER MAY BE CONSTRUCTED EITHER LEVEL OR PARALLEL TO THE SLOPE OF THE SUBGRADE OR BASE COURSE PROVIDED A 6" MINIMUM GUTTER THICKNESS IS MAINTAINED.
- ③ WHEN REVERSE SLOPE GUTTER IS REQUIRED, THE LOCATIONS WILL BE SHOWN ELSEWHERE IN THE PLAN.


CONCRETE CURB, CONCRETE
CURB & GUTTER AND
PAVEMENT TIES

STATE OF WISCONSIN
DEPARTMENT OF TRANSPORTATION


APPROVED
10-23-86
DATE

STATE DESIGN ENGINEER FOR HWYS


FHWA

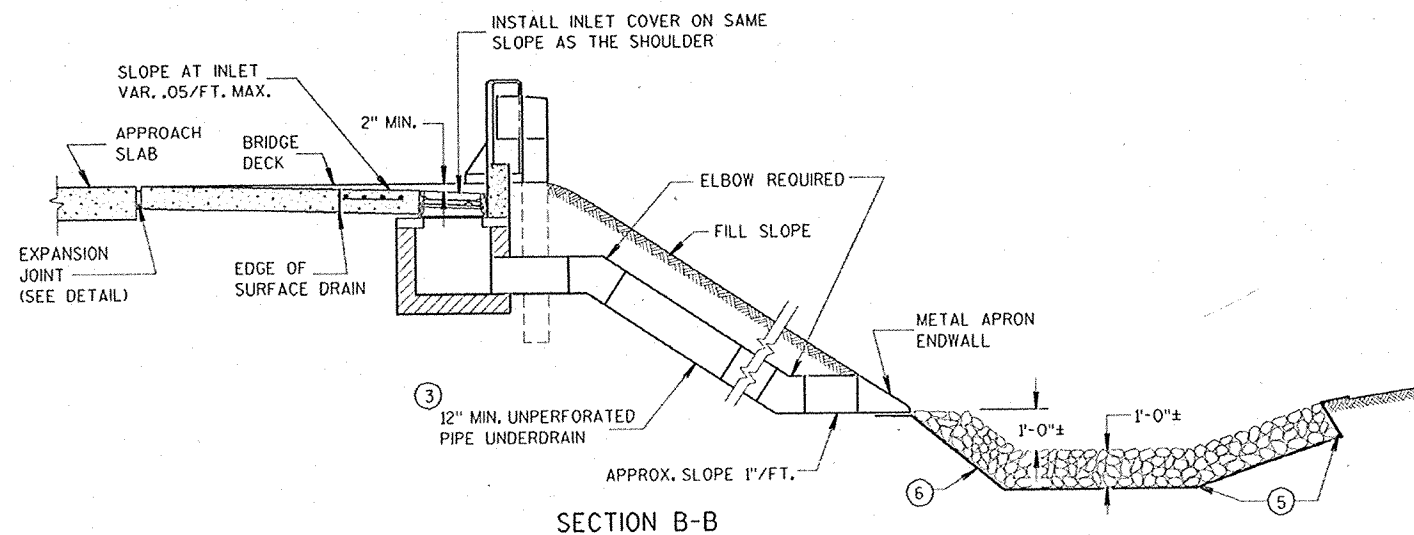


SECTION B-B

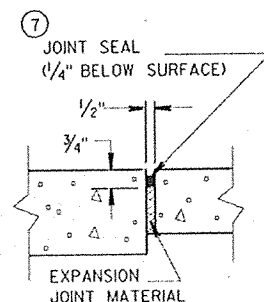


EXPANSION JOINT DETAIL

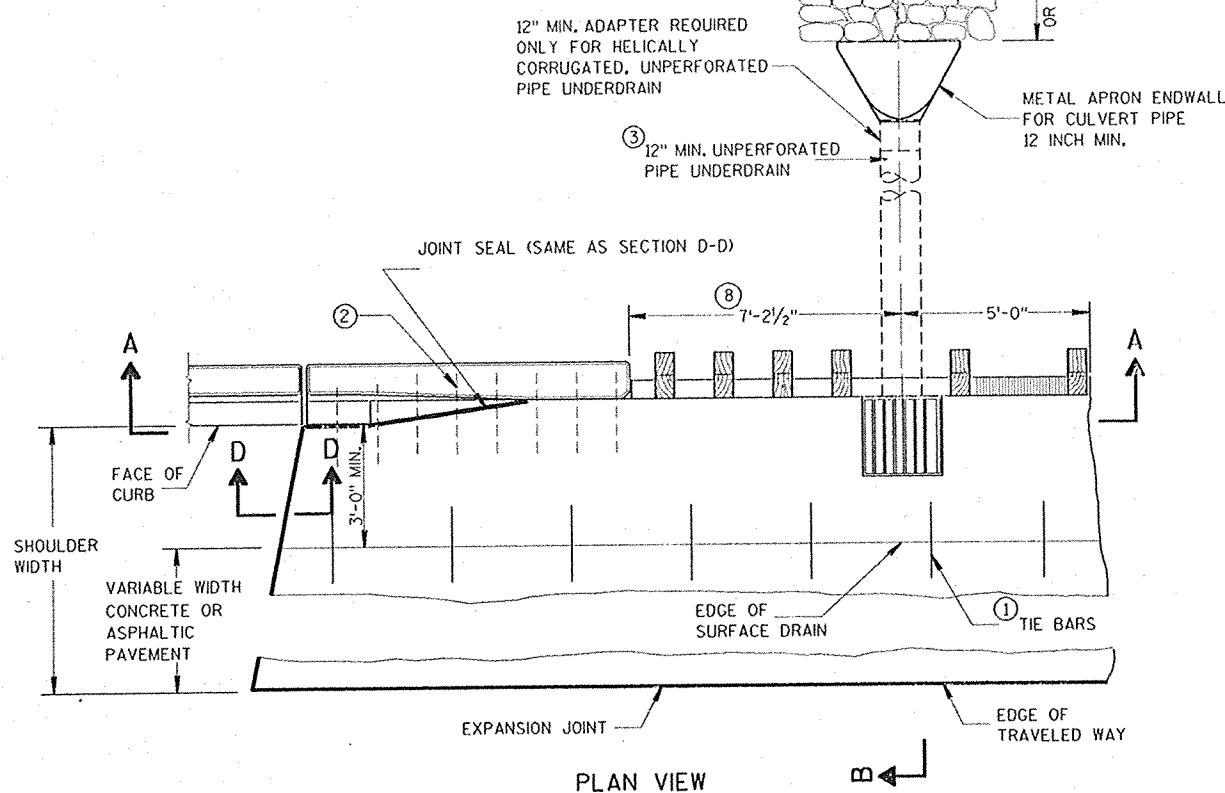


PLAN VIEW

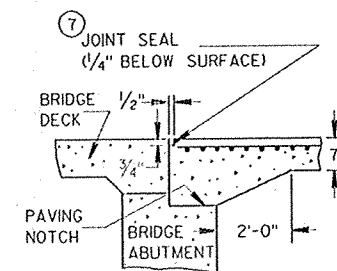


SECTION D-D

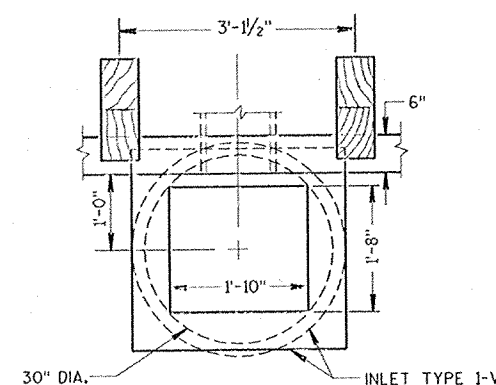


PLAN VIEW

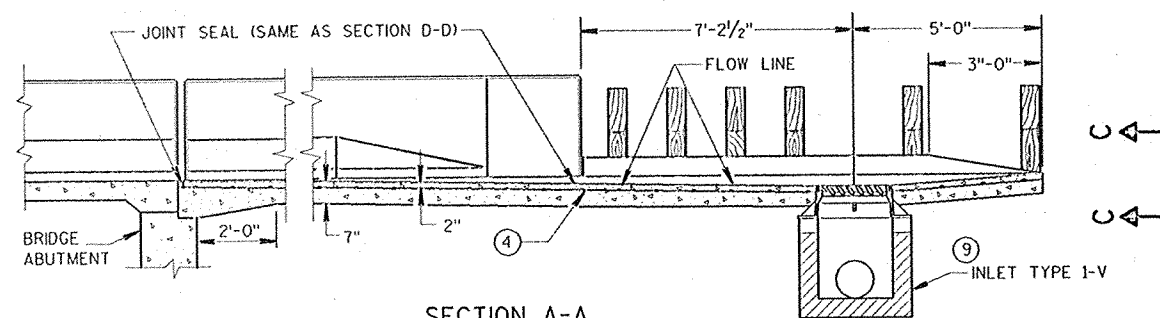

SECTION A-A

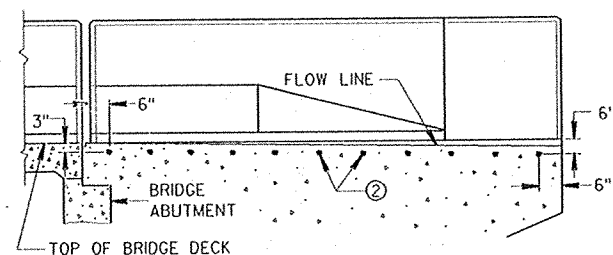

LOCATION OF TIE BARS IN WINGWALL

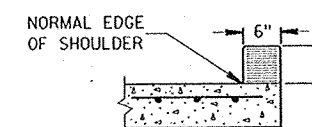

SECTION C-C

GENERAL NOTES

DETAILS OF CONSTRUCTION, MATERIALS, AND WORKMANSHIP NOT SHOWN ON THIS DRAWING SHALL CONFORM TO THE PERTINENT REQUIREMENTS OF THE STANDARD SPECIFICATIONS AND APPLICABLE SPECIAL PROVISION.


- ① NO. 4 X 2'-0" TIE BARS SPACED AT 3'-0" CENTERS TO BE USED ONLY WHEN ADJACENT TO P.C. CONCRETE.
- ② NO. 4 X 2'-0" TIE BARS SPACED AT 12" CENTERS TO BE PLACED BY BRIDGE CONTRACTOR, OR PAVEMENT TIES PLACED AS DIRECTED BY THE ENGINEER.
- ③ THE PIPE UNDERDRAIN MAY BE ANY ONE OF THE SIX MATERIALS LISTED IN THE STANDARD SPECIFICATIONS SECTION 612.2 (EXCEPT SECTION 612.2.3 DRAIN TILE).
- ④ MINIMUM REINFORCEMENT SHALL BE 6" X 6" - W4.0 X W4.0 OR NO. 3 BARS LONGITUDINAL AND TRANSVERSE SPACING 12" C-C.
- ⑤ LIMITS OF ADDITIONAL RIPRAP WHEN SPECIAL DITCH IS REQUIRED.
- ⑥ GEOTEXTILE FABRIC, TYPE 'R'
- ⑦ HOT POURED SEALANT UNLESS OTHERWISE SPECIFIED.
- ⑧ THIS DIMENSION MAY VARY DEPENDING ON THE SPACING OF POSTS FOR THE STEEL PLATE BEAM GUARD. THE TYPICAL LOCATION FOR THE SURFACE DRAIN IS WHERE THE POST SPACING WIDENS TO 3'-1 1/2".
- ⑨ SEE CURRENT STANDARD DETAIL DRAWINGS 8A5 AND 8C1 FOR DETAILS.

CONCRETE SURFACE DRAIN
DROP INLET TYPE
AT STRUCTURES


STATE OF WISCONSIN
DEPARTMENT OF TRANSPORTATION

APPROVED
7/2/90
DATE
FHWA


STATE DESIGN ENGINEER FOR HWYS

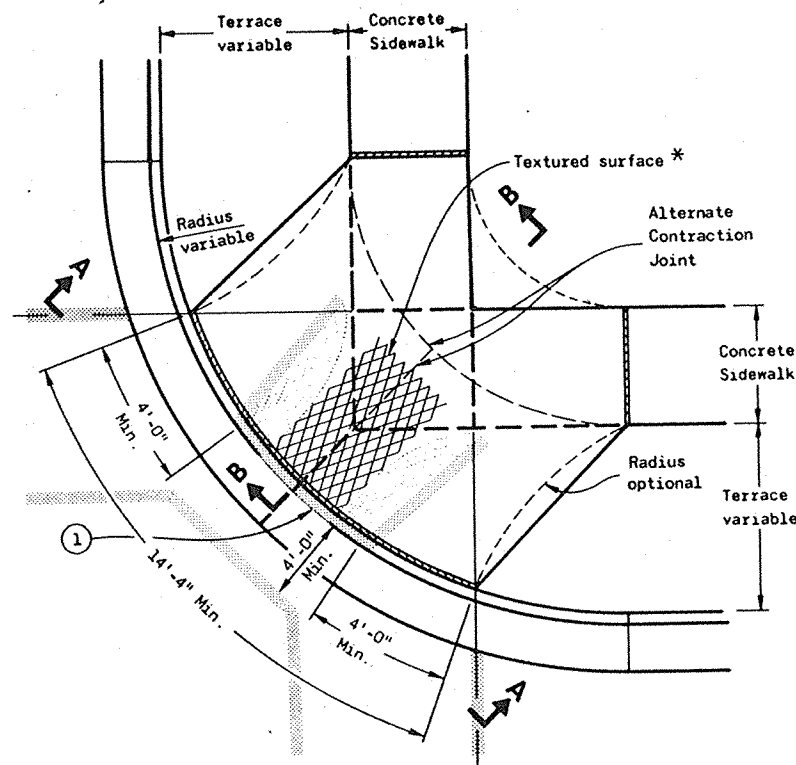


PLAN VIEW
TYPE 1 RAMP
(CENTER OF CORNER RADIUS)

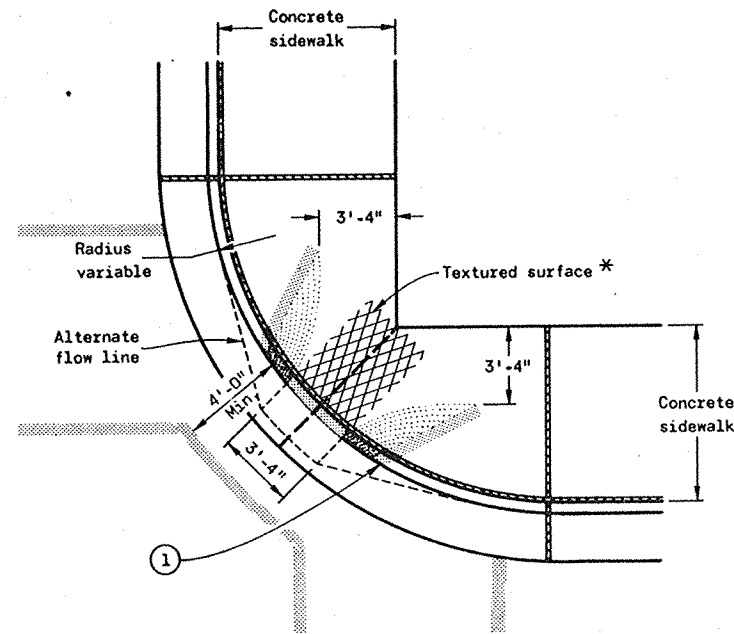

PLAN VIEW
TYPE 1-A RAMP
(NO TERRACE)

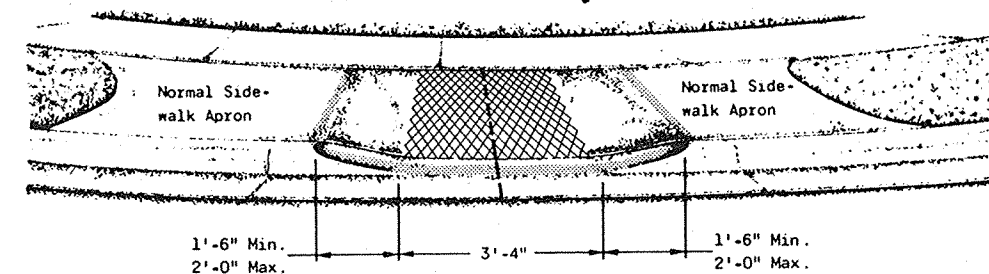


VIEW A-A

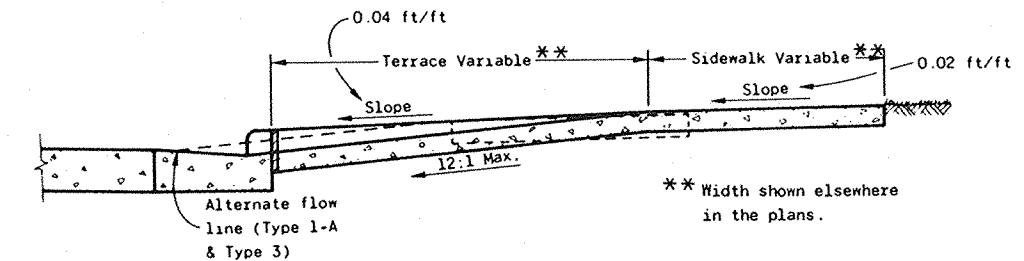


SECTION B-B

$\frac{1}{2}$ " EXPANSION JOINTS - SIDEWALK
CONTRACTION JOINTS


Location of joints may be varied from those shown to better fit site conditions and/or local government preference.

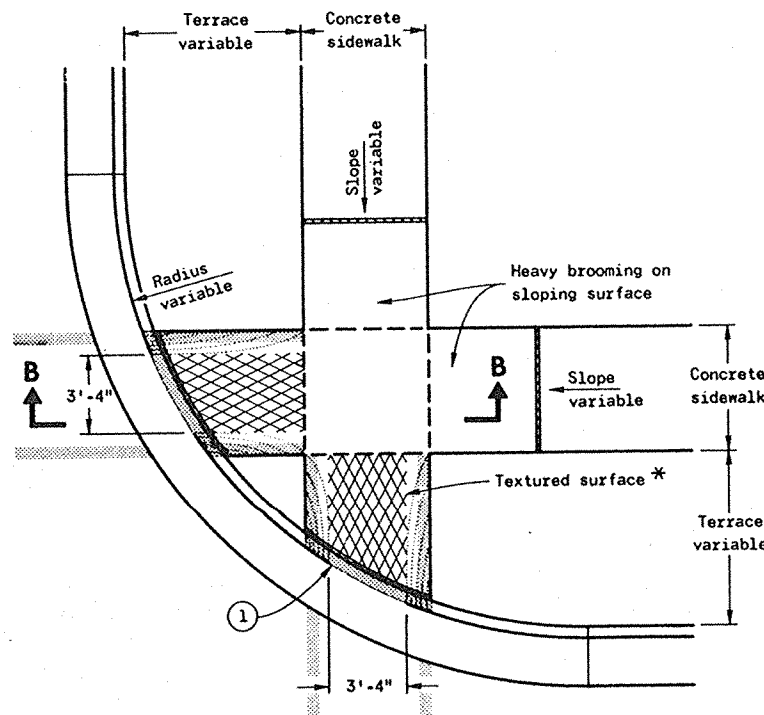

PLAN VIEW
TYPE 2 RAMP
(ON LINE WITH SIDEWALK)

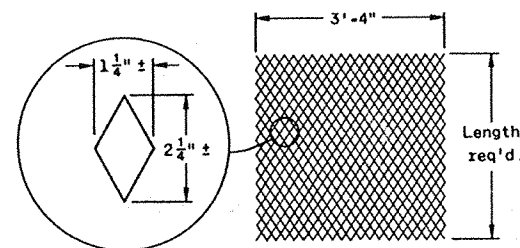

DETAIL OF DIAMOND PATTERN *

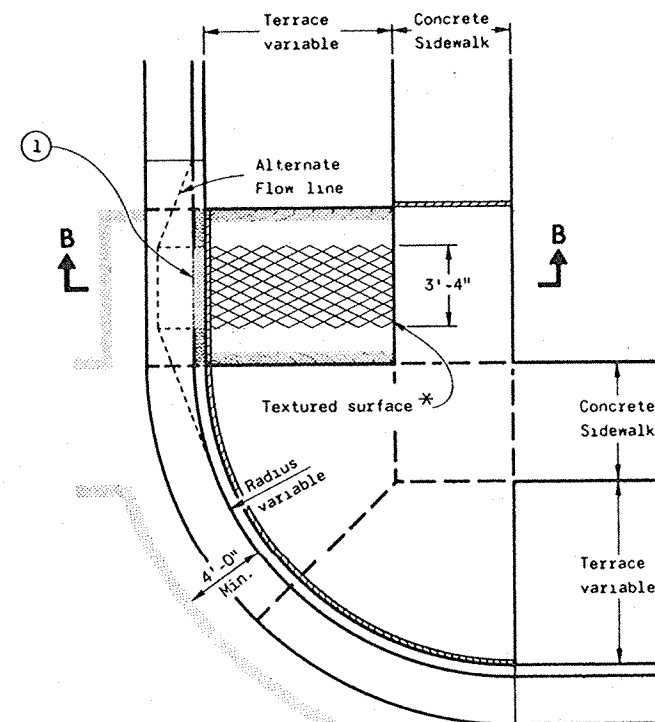

PLAN VIEW
TYPE 3 RAMP
(OUTSIDE OF CROSSWALK AREA)

GENERAL NOTES

Details of construction, materials and workmanship not shown on this drawing shall conform to the pertinent requirements of the Standard Specifications and the applicable Special Provisions.

Ramps shall be built at 12:1 or flatter. When necessary, the sidewalk elevation may be lowered to meet the high point on the ramp.

Type 1 or Type 1-A Ramps shall have a normal sidewalk apron and curb on both sides of ramp.

Curb ramps shall be measured and paid for as Concrete Sidewalk and Concrete Curb and Gutter.

Surface texturing shall consist of linear impressions approximately $\frac{1}{4}$ inch to $\frac{3}{8}$ inch in depth and width, oriented to provide a uniform pattern of diamond shapes measuring approximately $1\frac{1}{4}$ inches in width by $2\frac{1}{4}$ inches in length, with the length being parallel to the direction of pedestrian movement. This surface texture may be achieved by impressing and removing a piece of expanded metal regular industrial mesh into the surface of the ramp while the concrete is in a plastic state.

① The ramp shall be bordered on both sides and on the curb line with a 4 inch wide yellow stripe or with brick of a contrasting color. Normally the paint stripe alternate will be used. The municipality or the department will apply this striping unless otherwise specified in the contract.


If a municipality requires the brick alternate, special details and provisions are shown elsewhere in the plans.

CURB RAMPS

State of Wisconsin
Department of Transportation


APPROVED
10-23-84
DATE
FHWA

D. J. Strand
CHIEF DESIGN ENGINEER

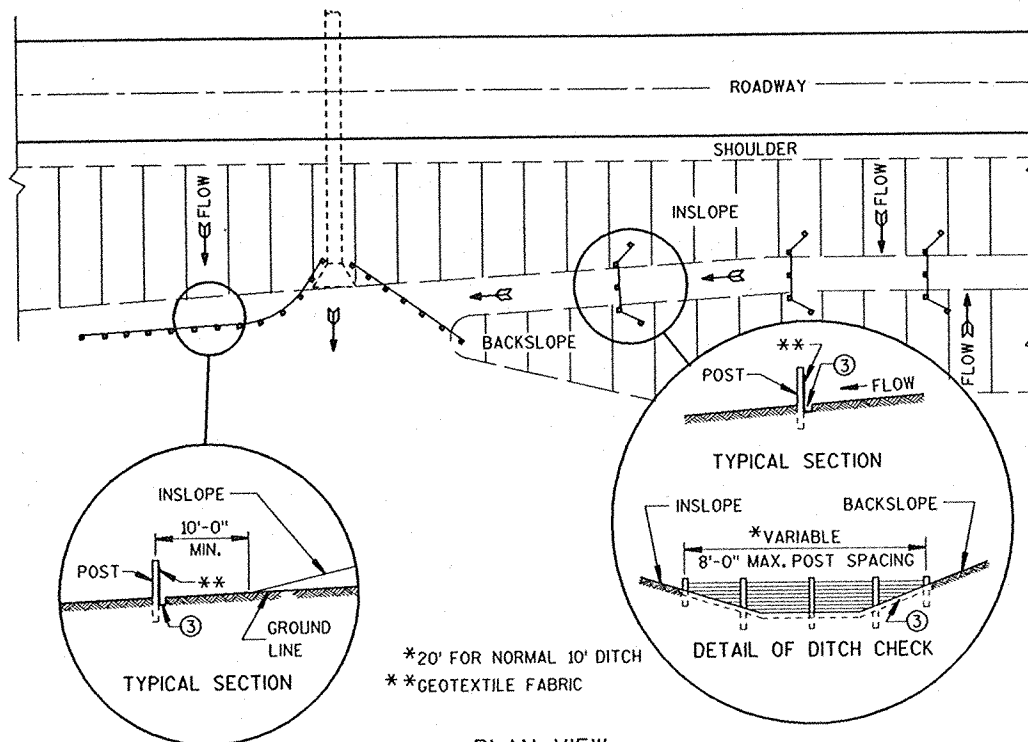

PLAN VIEW

TYPICAL APPLICATIONS OF SILT FENCE

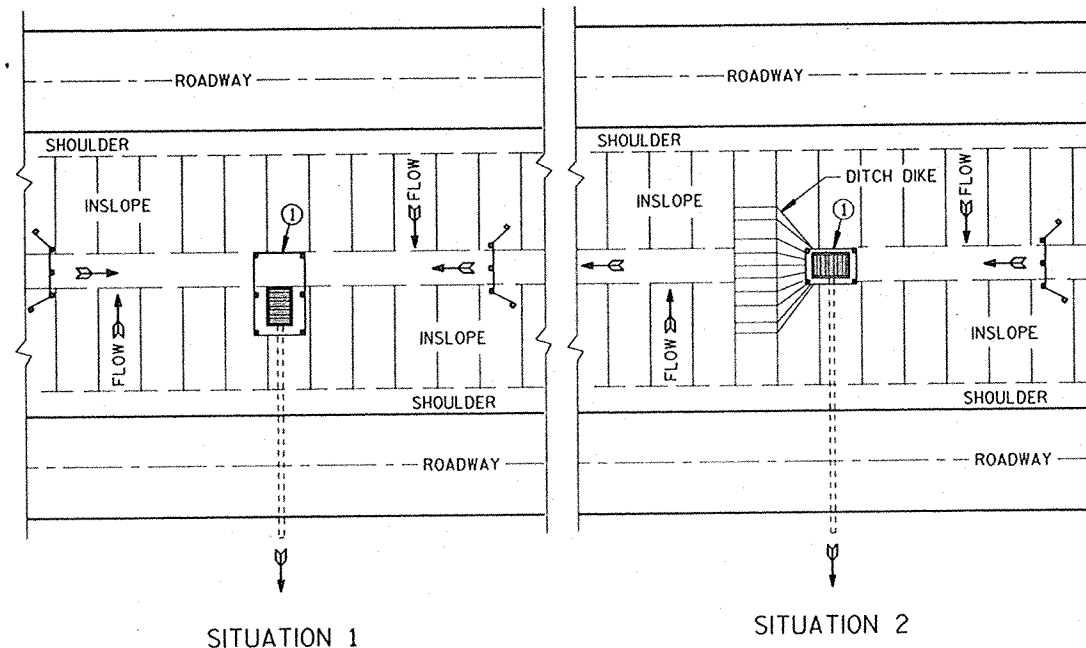

PLAN VIEW

SILT FENCE AT MEDIAN SURFACE DRAINS


GENERAL NOTES

DETAIL OF CONSTRUCTION NOT SHOWN ON THIS DRAWING SHALL CONFORM TO THE PERTINENT REQUIREMENTS OF THE STANDARD SPECIFICATIONS AND APPLICABLE SPECIAL PROVISIONS.

WHEN POSSIBLE THE SILT FENCE SHOULD BE CONSTRUCTED IN AN ARC OR HORSESHOE SHAPE, WITH THE ENDS POINTING UPSLOPE TO MAXIMIZE BOTH STRENGTH AND EFFECTIVENESS.



- CROSS BRACE WITH 2" X 4" WOODEN FRAME OR EQUIVALENT AT TOP OF POSTS AS DIRECTED BY THE ENGINEER.
- MINIMUM 14 GAGE WIRE REQUIRED, FOLD FABRIC 3" OVER THE WIRE AND STAPLE OR PLACE WIRE RINGS ON 12" C-C.
- EXCAVATE A TRENCH A MINIMUM OF 4" WIDE & 6" DEEP TO BURY AND ANCHOR THE GEOTEXTILE FABRIC. FOLD MATERIAL TO FIT TRENCH AND BACKFILL & COMPACT TRENCH WITH EXCAVATED SOIL.
- WIRE SUPPORT FENCE SHALL BE 14 GAGE MINIMUM WOVEN WIRE WITH A MAXIMUM MESH SPACING OF 6". SECURE TOP OF GEOTEXTILE FABRIC TO TOP OF FENCE WITH STAPLES OR WIRE RINGS AT 12" C-C.
- GEOTEXTILE FABRIC SHALL BE REINFORCED WITH AN INDUSTRIAL POLYPROPYLENE NETTING WITH A MAXIMUM MESH SPACING OF 3/4" OR EQUAL. A HEAVY DUTY NYLON TOP SUPPORT CORD OR EQUIVALENT IS REQUIRED.
- STEEL POSTS SHALL BE STUDDED "TEE" OR "U" TYPE WITH A MINIMUM WEIGHT OF 1.28 LBS/LINEAL FOOT (WITHOUT ANCHOR). FIN ANCHORS SUFFICIENT TO RESIST POST MOVEMENT ARE REQUIRED. WOOD POSTS SHALL BE A MINIMUM SIZE OF 4" DIA. OR 1 1/2" X 3 1/2" EXCEPT WOOD POSTS FOR GEOTEXTILE FABRIC REINFORCED WITH NETTING SHALL BE A MINIMUM SIZE OF 1 1/8" X 1 1/8" OAK OR HICKORY.

ALTERNATES A & B ARE EQUAL AND EITHER MAY BE USED.

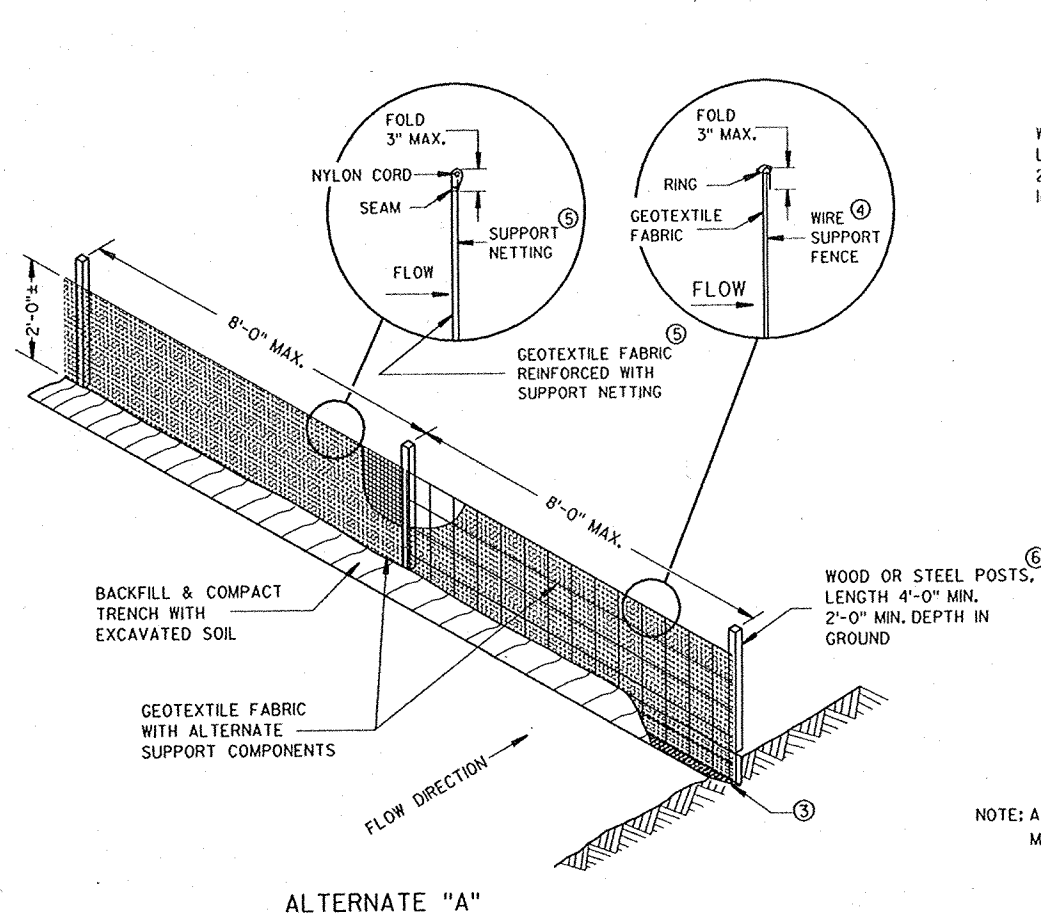


NOTE: ADDITIONAL POST DEPTH OR TIE BACKS MAY BE REQUIRED IN UNSTABLE SOILS

SILT FENCE

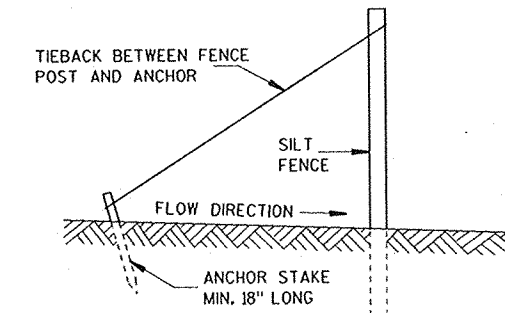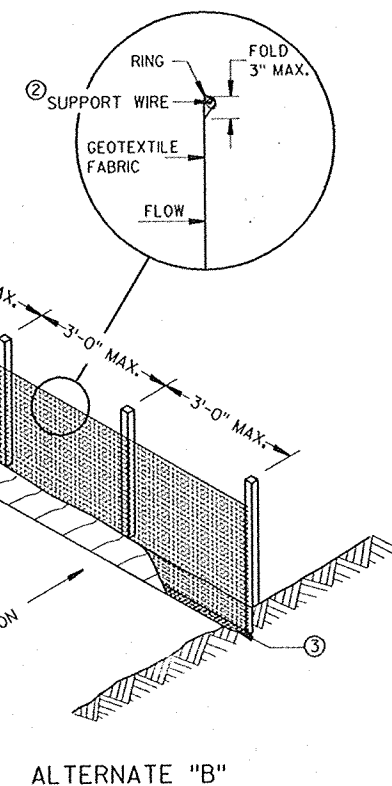

SILT FENCE TIE BACK
(WHEN REQUIRED BY THE ENGINEER)

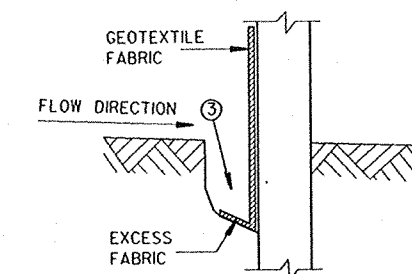

TRENCH DETAIL

SILT FENCE


STATE OF WISCONSIN
DEPARTMENT OF TRANSPORTATION

APPROVED
8-31-88
DATE
FHWA



STATE DESIGN ENGINEER FOR HWYS

METAL APRON ENDWALLS											
PIPE DIA. (IN.)	MIN. THICK. (Inches)		DIMENSIONS (Inches)							APPROX. SLOPE	BODY
	STEEL	ALUM.	A (±1")	B (MAX.)	H (±1/2")	L (±1/2")	L ₁ (1)	L ₂ (1)	W (±2")		
12	.064	.060	6	6	6	21	12	17 1/2	24	2 1/2 to 1	1 Pc.
15	.064	.060	7	8	6	26	14	21 1/4	30	2 1/2 to 1	1 Pc.
18	.064	.060	8	10	6	31	15	28 1/4	36	2 1/2 to 1	1 Pc.
21	.064	.060	9	12	6	36	18	29 1/2	42	2 1/2 to 1	1 Pc.
24	.079	.075	10	13	6	41	18	37 1/4	48	2 1/2 to 1	1 Pc.
30	.079	.075	12	16	8	51	18	52 1/4	60	2 1/2 to 1	1 Pc.
36	.109	.105	14	19	9	60	24	59 1/4	72	2 1/2 to 1	2 Pc.
42	.109	.105	16	22	11	69	24	75 1/2	84	2 1/2 to 1	2 Pc.
48	.109	.105	18	27	12	78	24	81	90	2 1/4 to 1	3 Pc.
54	.109	.105	18	30	12	84	30	85 1/2	102	2 1/4 to 1	3 Pc.
60	.109x	.105x	18	33	12	87	—	114	120	2 to 1	3 Pc.
66	.109x	.105x	18	36	12	87	—	—	120	2 to 1	3 Pc.
72	.109x	.105x	18	39	12	87	—	—	126	2 to 1	3 Pc.
78	.109x	.105x	18	42	12	87	—	—	132	1 1/2 to 1	3 Pc.
84	.109x	.105x	18	45	12	87	—	—	138	1 1/2 to 1	3 Pc.
90	.109x	.105x	18	37	12	87	—	—	144	1 1/2 to 1	3 Pc.
96	.109x	.105x	18	35	12	87	—	—	150	1 1/2 to 1	3 Pc.

X EXCEPT CENTER PANEL
SEE GENERAL NOTES

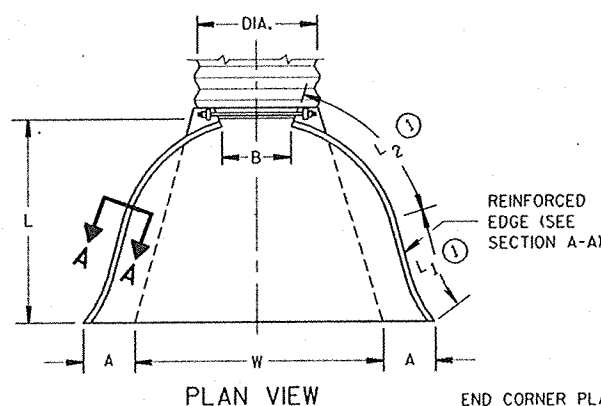




END CORNER PLATES MAY BE FASTENED TO APRON PROPER BY BOLTS, RIVETS, OR RESISTANCE SPOT WELDS WHICH WILL HOLD THE SURFACES TIGHTLY TOGETHER

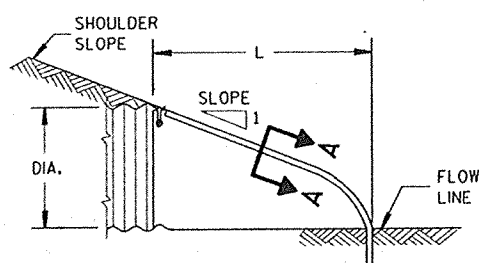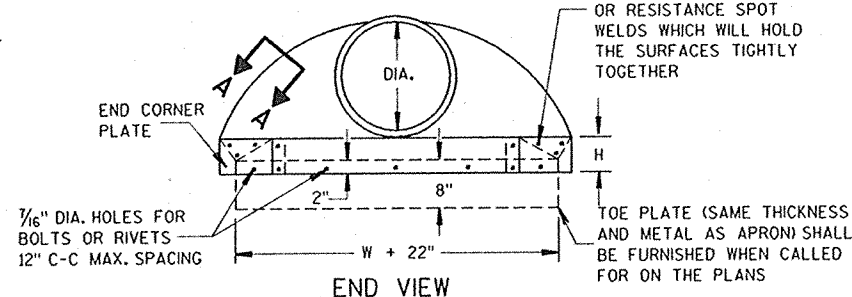

SIDE ELEVATION
METAL ENDWALLS


REINFORCED CONCRETE APRON ENDWALLS											
PIPE DIA. (IN.)	DIMENSIONS (Inches)							APPROX. SLOPE			
	T	A	B	C	D	E	G				
12	2	4	24	48 1/8	72 1/8	24	2	3 to 1			
15	2 1/4	6	27	46	73	30	2 1/4	3 to 1			
18	2 1/2	9	27	46	73	36	2 1/2	3 to 1			
21	2 3/4	9	36	37 1/2	73 1/2	42	2 3/4	3 to 1			
24	3	9 1/2	43 1/2	30	73 1/2	48	3	3 to 1			
27	3 1/4	10 1/2	49 1/2	24	73 1/2	54	3 1/4	3 to 1			
30	3 1/2	12	54	19 1/4	73 1/2	60	3 1/2	3 to 1			
36	4	15	63	34 1/4	97 1/4	72	4	3 to 1			
42	4 1/2	21	63	35	98	78	4 1/2	3 to 1			
48	5	24	72	26	98	84	5	3 to 1			
54	5 1/2	27	65	33 1/4-35	98 1/4-100	90	5 1/2	2 1/2 to 1			
60	6	30-35	60	39	99	96	5	2 to 1			
66	6 1/2	30-35	60	39	99	102	5 1/2	2 to 1			
72	7	30-35	78	21	99	108	6	2 to 1			
78	7 1/2	30-35	78	21	99	114	6 1/2	2 to 1			
84	8	36	90 1/2	21	111 1/2	120	6 1/2	1 1/2 to 1			
90	8 1/2	41	87 1/2	24	111 1/2	132	6 1/2	1 1/2 to 1			

*MINIMUM
**MAXIMUM

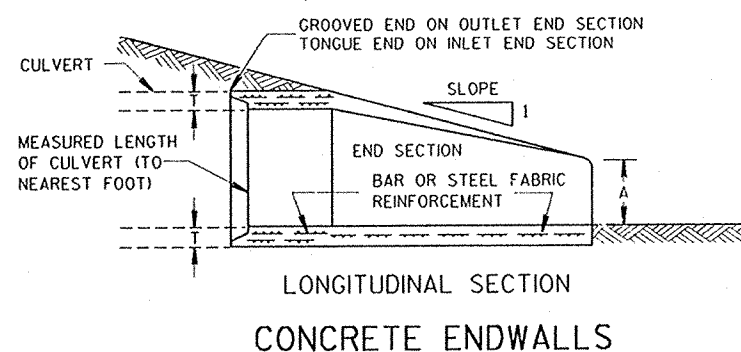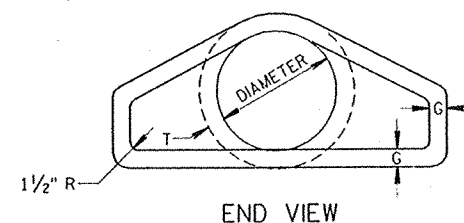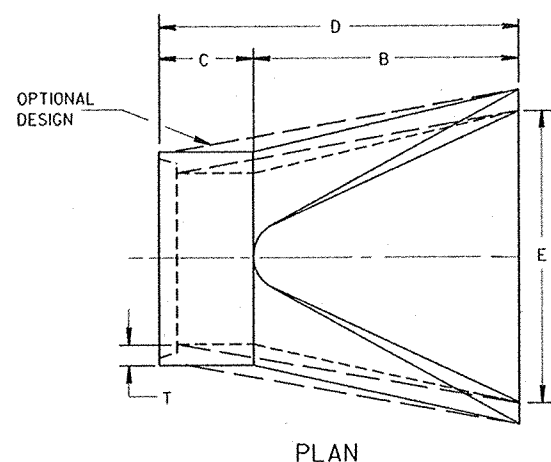


LONGITUDINAL SECTION
CONCRETE ENDWALLS


1" WIDE, 12 GA. (0.109" THICK) GALVANIZED STRAP WITH STANDARD 6" X 1/2" BAND BOLT AND NUT

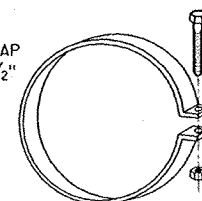


ALTERNATE FOR TYPE 1 CONNECTION
END SECTION CONNECTOR STRAP

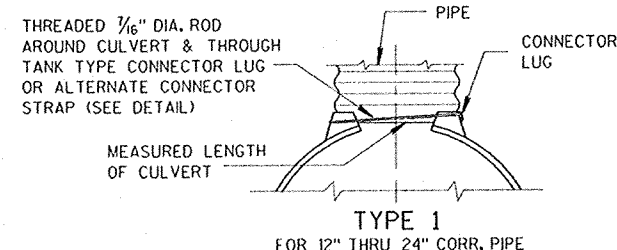


TYPE 1
FOR 12" THRU 24" CORR. PIPE

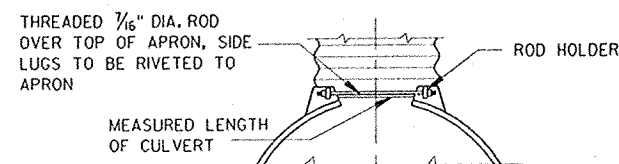

TYPE 2
FOR 30" THRU 96" CORR. PIPE

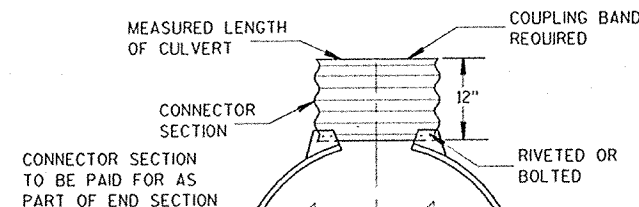

TYPE 3
FOR 42" THRU 96" CORR. PIPE

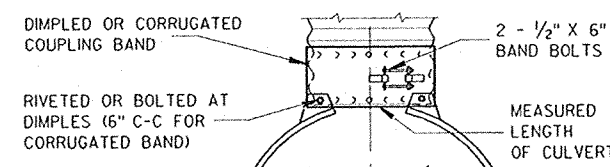

TYPE 5
ALTERNATE FOR:
ALL SIZES CORRUGATED CIRCULAR PIPE


NOTE: DIMPLED BAND FITS OVER OUTSIDE OF ENDWALL, AND CORRUGATED BAND FITS INSIDE ENDWALL. DIMPLED BAND MAY BE USED WITH HELICALLY CORRUGATED PIPE.

FOR CIRCUMFERENTIALLY CORRUGATED PIPE USE ENDWALL CONNECTION DETAILS 1, 2, 3 OR 5 AS APPLICABLE.

FOR HELICALLY CORRUGATED PIPE USE ENDWALL CONNECTION DETAILS 1, 2 OR 5.

FOR HELICALLY CORRUGATED PIPES WITH TWO CIRCUMFERENTIAL CORRUGATIONS AT EACH END USE ENDWALL CONNECTION DETAILS 1, 2 OR 3.

CONNECTION DETAILS

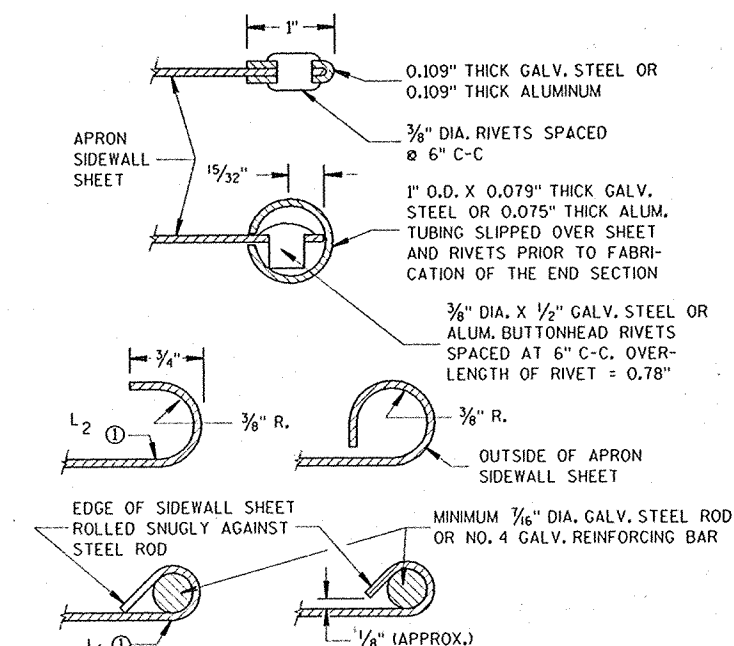

SECTION A-A

GENERAL NOTES

DETAILS OF CONSTRUCTION, MATERIALS AND WORKMANSHIP NOT SHOWN ON THIS DRAWING SHALL CONFORM TO THE PERTINENT REQUIREMENTS OF THE STANDARD SPECIFICATIONS AND THE APPLICABLE SPECIAL PROVISIONS.

CONCRETE CULVERT ENDWALLS MAY NOT BE USED WITH GALVANIZED STEEL OR ALUMINUM CULVERT PIPE OR VICE VERSA. GALVANIZED STEEL OR ALUMINUM ENDWALLS SHALL NORMALLY BE INSTALLED ON CULVERT PIPE OF THE SAME METAL.

ALL THREE PIECE STEEL APRON ENDWALLS FOR 60" DIAMETER PIPE AND LARGER SHALL HAVE 0.109" SIDES AND 0.138" CENTER PANELS. ALL THREE PIECE ALUMINUM APRON ENDWALLS FOR 60" DIAMETER PIPE AND LARGER SHALL HAVE 0.105" SIDES AND 0.134" CENTER PANELS. THE WIDTH OF CENTER PANELS SHALL BE GREATER THAN 20 PERCENT OF THE PIPE PERIMETER.

LAP SEAMS SHALL BE TIGHTLY JOINED BY GALVANIZED RIVETS OR BOLTS FOR STEEL UNITS AND ALUMINUM RIVETS AND BOLTS FOR ALUMINUM UNITS. FOR THE 60" THROUGH 96" DIAMETER APRON ENDWALL SIZES, THE REINFORCED EDGES AND CENTER PANEL SEAMS SHALL BE FURTHER REINFORCED WITH GALVANIZED STEEL OR ALUMINUM STIFFENER ANGLES. THE ANGLES SHALL BE ATTACHED BY GALVANIZED NUTS AND BOLTS FOR STEEL UNITS AND ALUMINUM NUTS AND BOLTS FOR ALUMINUM UNITS.

WHERE TWO OR MORE PIPES WITH APRON ENDWALLS ARE LAID ADJACENT TO EACH OTHER, THEY SHALL BE SEPARATED BY A DISTANCE SUFFICIENT TO PROVIDE A MINIMUM CLEARANCE OF 6 INCHES BETWEEN APRON ENDWALLS.


① FOR PIPE SIZES UP TO 60" DIAMETER, A 180° ROLLED EDGE MAY BE USED INSTEAD OF STEEL ROD REINFORCEMENT. SEE SECTION A-A.

APRON ENDWALLS FOR CULVERT PIPE


STATE OF WISCONSIN
DEPARTMENT OF TRANSPORTATION

APPROVED
12/17/87
DATE
FHWA

STATE DESIGN ENGINEER FOR HWYS

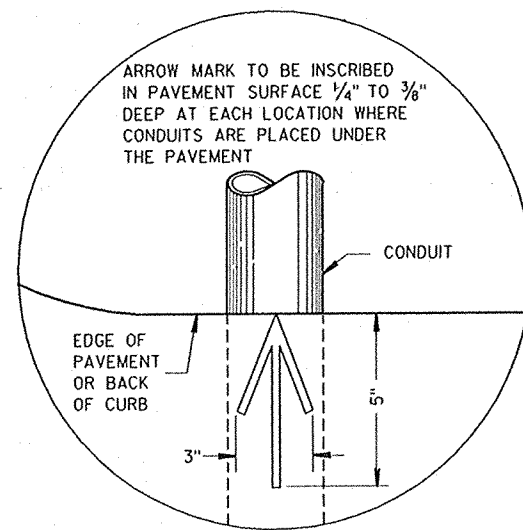


PLAN VIEW
ARROW MARK

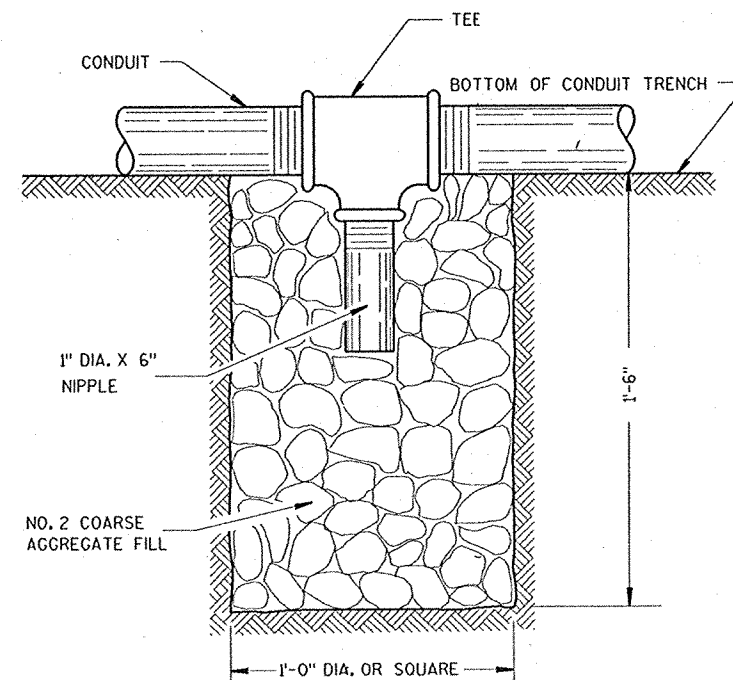

NOTE: INSTALL AT LOCATIONS WHERE CONDUITS CANNOT BE PITCHED TO DRAIN INTO A PULL BOX.

DRAIN SUMP FOR CONDUIT

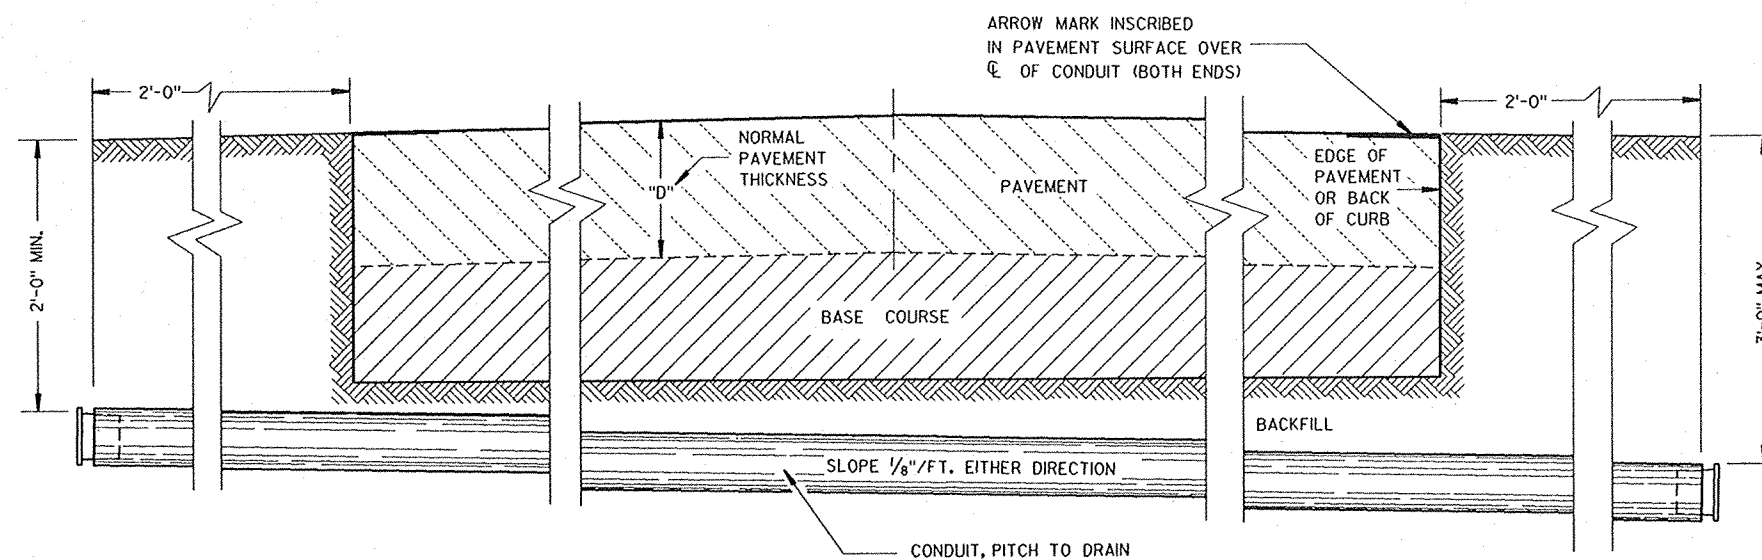

SIDE ELEVATION

DETAIL FOR CONDUIT UNDER PAVED HIGHWAYS

GENERAL NOTES

DETAILS OF CONSTRUCTION, MATERIALS AND WORKMANSHIP NOT SHOWN ON THIS DRAWING SHALL CONFORM TO THE PERTINENT REQUIREMENTS OF THE CONTRACT.

METALLIC (STANDARD SPECIFICATION 613) OR NONMETALLIC (STANDARD SPECIFICATION 613) CONDUIT SHALL BE FURNISHED AND PLACED AS SHOWN.

DEPTH OF CONDUIT INSTALLED BELOW THE TRAVELED WAY SHALL BE 24 INCHES MINIMUM AND 36 INCHES MAXIMUM.

DEPTH OF CONDUIT INSTALLED THAT IS NOT BELOW THE TRAVELED WAY SHALL BE 18 INCHES MINIMUM AND 36 INCHES MAXIMUM.

ANY EXCEPTION TO THE MAXIMUM DEPTH SHALL BE ONLY WITH THE WRITTEN APPROVAL OF THE ENGINEER.

THE TRENCH SHALL NOT BE BACKFILLED PRIOR TO INSPECTION OF THE CONDUIT.

ALL METALLIC CONDUIT RACEWAY ENDS SHALL BE REAMED AND THREADED.

ALL METALLIC CONDUIT IN WHICH WIRE OR CABLE IS TO BE INSTALLED SHALL BE BUSHED WITH APPROVED THREADED BUSHINGS BEFORE INSTALLATION OF THE WIRE OR CABLE.

ALL METALLIC CONDUITS IN WHICH WIRE OR CABLE IS NOT TO BE INSTALLED SHALL BE CAPPED WITH THREADED PROTECTIVE CAPS, AS APPROVED BY THE ENGINEER.

ALL NONMETALLIC CONDUIT SHALL BE CAPPED OR PLUGGED IMMEDIATELY AFTER INSTALLATION.

NONMETALLIC CONDUITS IN WHICH WIRE OR CABLE IS NOT BEING INSTALLED SHALL REMAIN CAPPED OR PLUGGED.

WHEN REQUIRED TO CONNECT NONMETALLIC CONDUIT TO METALLIC CONDUIT, ONLY U.L. LISTED ADAPTER FITTINGS SHALL BE USED.

PRIOR TO CONDUIT ACCEPTANCE, CONDUIT CAPS OR PLUGS SHALL BE REMOVED, AND THE CAPS, PLUGS AND CONDUIT ENDS SHALL BE THOROUGHLY CLEANED AND THEN THE CAPS OR PLUGS REINSTALLED TO ASSURE THAT THE CAPS OR PLUGS CAN BE EASILY REMOVED IN THE FUTURE.

ALL CONDUIT BEING FURNISHED AND INSTALLED SHALL HAVE THE U.L. LABEL FIRMLY ATTACHED.

CONDUIT RUNS SHALL BE THE SAME SIZE PIPE FROM ONE END TO THE OTHER (FROM PULL BOX TO PULL BOX OR JUNCTION BOX TO JUNCTION BOX).

A #12 GAUGE, GALVANIZED PULL WIRE SHALL BE INSTALLED IN EACH RUN OF CONDUIT THAT DOES NOT RECEIVE CABLE OR WIRE UNDER THIS CONTRACT. THE PULL WIRE SHALL BE DOUBLED BACK 2 FEET AT EACH END CAP OF THE CONDUIT RUN.

CONDUIT


STATE OF WISCONSIN
DEPARTMENT OF TRANSPORTATION

APPROVED
1-29-88
DATE

STATE TRAFFIC ENGINEER FOR HWYS


FHWA

FORM DEPTH SHALL BE NO MORE THAN 6" BELOW GRADE ON THE LOWER SIDE OF BASE

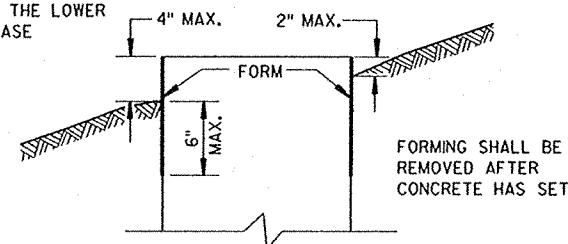


FORMING DETAIL


QUANTITY REQUIREMENTS	CONCRETE BASE TYPE		
	1	2	5
APPROX. CUBIC YARDS OF CONCRETE	.32	.57	.40
LBS. OF HOOP BAR STEEL	NONE	23	16
LBS. OF VERTICAL BAR STEEL	NONE	60	18

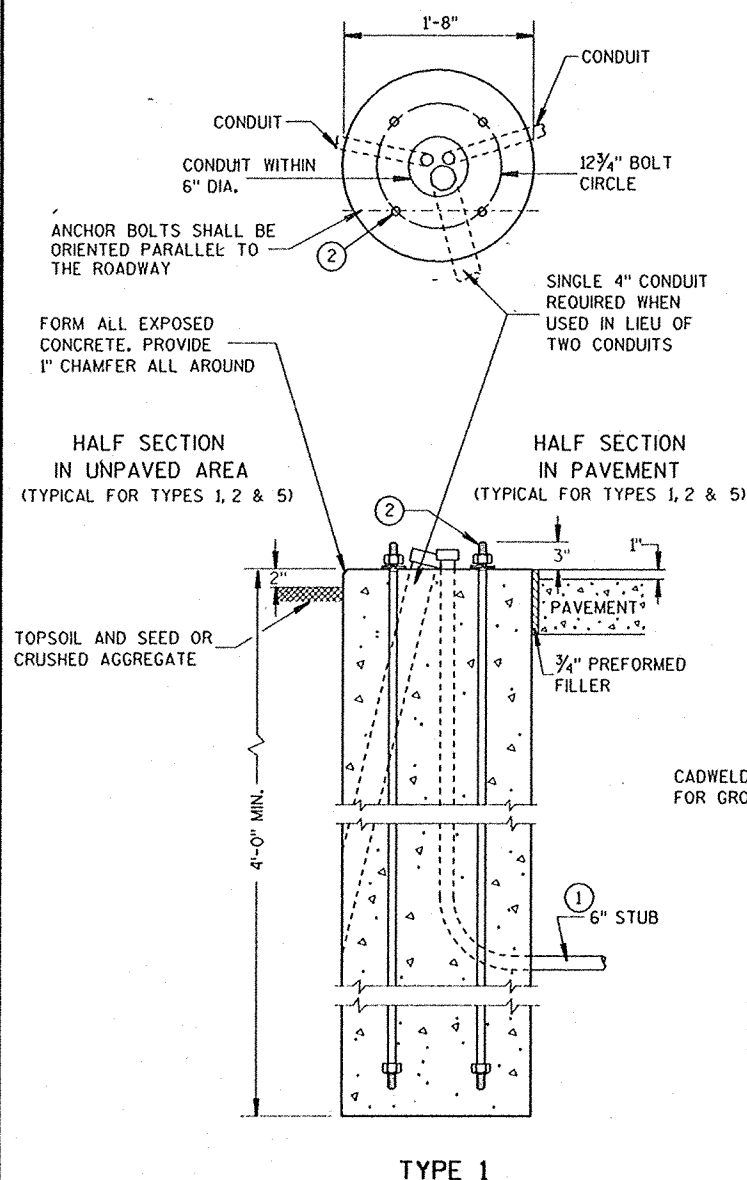

TYPE 1

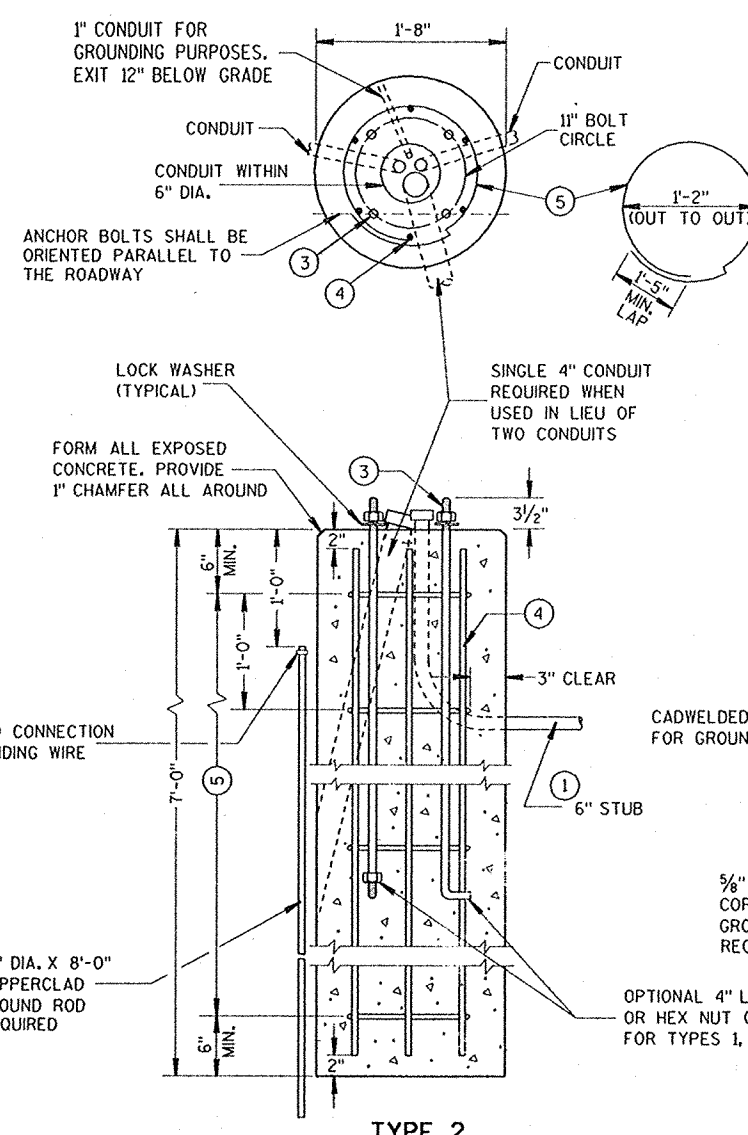

TYPE 2

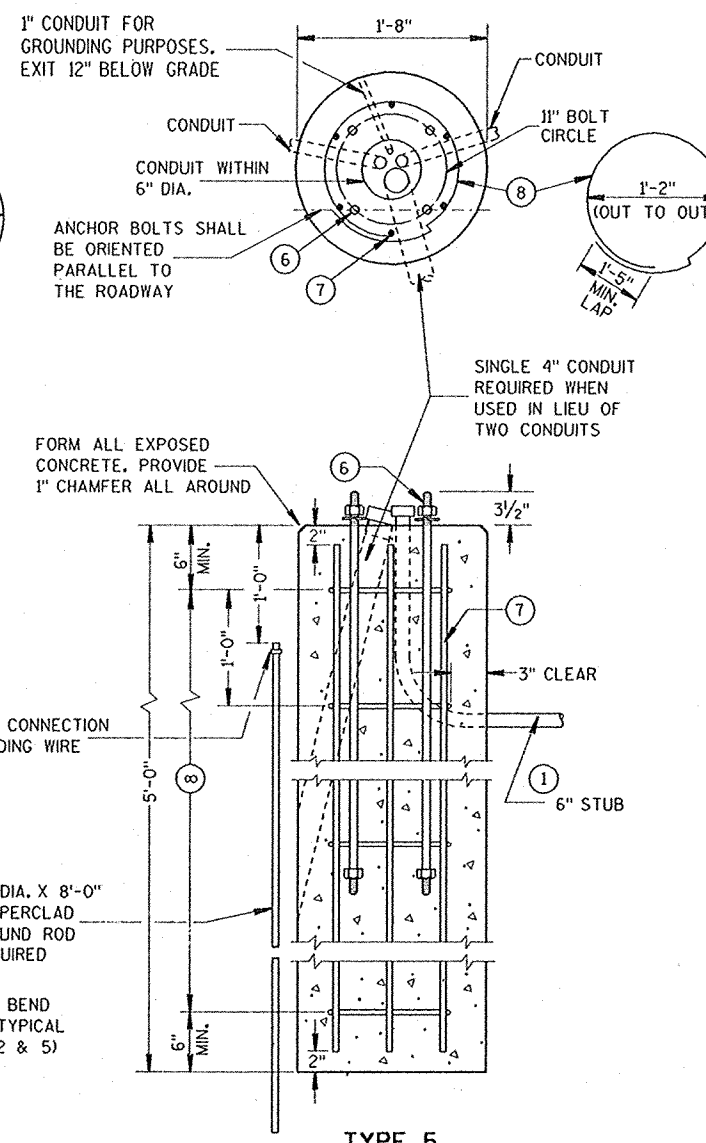

TYPE 5

CONCRETE BASES

GENERAL NOTES

DETAILS OF CONSTRUCTION, MATERIALS AND WORKMANSHIP NOT SHOWN ON THIS DRAWING SHALL CONFORM TO THE PERTINENT REQUIREMENTS OF THE CONTRACT.

TOP SURFACES OF CONCRETE BASES SHALL BE TROWEL FINISHED AND LEVEL.

MINIMUM BENDING RADIUS OF CONDUIT = 6 X THE DIAMETER.

CONDUIT HEIGHT ABOVE CONCRETE BASES SHALL BE 1 INCH. ALL METALLIC CONDUIT ENDS SHALL BE REAMED AND THREADED.

ALL METALLIC CONDUITS IN WHICH WIRE OR CABLE IS NOT TO BE INSTALLED SHALL BE CAPPED.

ALL NONMETALLIC CONDUITS IN WHICH WIRE OR CABLE IS NOT INSTALLED SHALL BE PLUGGED.

ALL CONDUIT ENDS AT THE TOP OF CONCRETE BASES SHALL BE CAPPED IF METALLIC OR PLUGGED IF NONMETALLIC IMMEDIATELY AFTER PLACEMENT AND BEFORE CONCRETE IS POURED. CONDUITS IN WHICH WIRE OR CABLE IS NOT INSTALLED SHALL REMAIN CAPPED OR PLUGGED.

ENDS OF CONDUIT INSTALLED BELOW GRADE FOR FUTURE USE SHALL BE CAPPED IF METALLIC OR PLUGGED IF NONMETALLIC.

WHEN REQUIRED TO CONNECT NONMETALLIC CONDUIT TO METALLIC CONDUIT, ONLY ADAPTER FITTINGS, U.L. LISTED FOR ELECTRICAL USE, SHALL BE USED.

IF A BASE REQUIRES A DEEP FORM BECAUSE OF LOOSE DIRT OR FILL, THE FORM SHALL BE REMOVED BEFORE BACKFILLING AROUND THE BASE. BACKFILL SHALL BE TAMPED TIGHT AGAINST THE BASE CONCRETE BASE IN LAYERS OF 1 FOOT OR LESS.

A NO. 6 AWG, STRANDED COPPER GROUNDING WIRE SHALL BE CADWELDED TO THE GROUND ROD FOR TYPE 2 AND TYPE 5 BASES.

THE GROUNDING WIRE SHALL BE FURNISHED AND INSTALLED TO ENTER THE BASE OF THE TYPE 2 AND TYPE 5 BASES THROUGH A 1 INCH CONDUIT INSTALLED FOR GROUNDING PURPOSES, LEAVING A 4 FOOT COIL OF WIRE ABOVE THE CONCRETE BASE. THE GROUNDING WIRE SHALL BE NEATLY COILED AND THE COILS TIED TOGETHER.

WHEN ANCHOR BOLTS USING THE ALTERNATE "L" BEND ARE FURNISHED, THE 4" "L" BEND SHALL BE IN ADDITION TO THE SPECIFIED ANCHOR BOLT BAR LENGTH.

- 1 THE MINIMUM DEPTH OF CONDUIT EXITING THE CONCRETE BASE AND INSTALLED BELOW THE TRAVELED WAY SHALL BE 24 INCHES. THE MINIMUM DEPTH OF CONDUIT EXITING THE CONCRETE BASE THAT IS NOT INSTALLED BELOW THE TRAVELED WAY SHALL BE 18 INCHES. THE MAXIMUM DEPTH OF ALL CONDUIT SHALL BE 36 INCHES EXCEPT WITH WRITTEN APPROVAL BY THE ENGINEER.
- 2 (4) 1" DIA. X 3'-6" ANCHOR BOLTS.
- 3 (4) 1" DIA. X 5'-0" ANCHOR BOLTS.
- 4 (6) NO. 6 X 6'-8" BAR STEEL REINFORCEMENT.
- 5 (7) NO. 4 X 5'-1" BAR STEEL REINFORCEMENT @ 1'-0" C-C.
- 6 (4) 1" DIA. X 3'-6" ANCHOR BOLTS.
- 7 (6) NO. 4 X 4'-8" BAR STEEL REINFORCEMENT
- 8 (5) NO. 4 X 5'-1" BAR STEEL REINFORCEMENT @ 1'-0" C-C.

CONCRETE BASES

STATE OF WISCONSIN
DEPARTMENT OF TRANSPORTATION

APPROVED
1-29-88
DATE

STATE TRAFFIC ENGINEER FOR HWYS


FHWA

GENERAL NOTES


DETAILS OF CONSTRUCTION, MATERIALS AND WORKMANSHIP NOT SHOWN ON THIS DRAWING SHALL CONFORM TO THE PERTINENT REQUIREMENTS OF THE CONTRACT.

FOUR (4) BOLTS TO BE FURNISHED WITH EACH TRANSFORMER BASE. BOLTS SHALL BE 1" DIAMETER, 4" IN LENGTH, WITH WASHERS, LOCK WASHERS AND NUTS. BOLTS, NUTS AND WASHERS SHALL BE GALVANIZED IN ACCORDANCE WITH ASTM A-153, CLASS C.


LEVELING SHIMS, IF NEEDED, SHALL BE DESIGNED FOR THE PURPOSE AND USED UNDER CAST BASES WHEN PLUMBING POLES OR STANDARDS DURING INSTALLATION. THE USE OF WASHERS IN LIEU OF PROPER LEVELING SHIMS IS NOT ACCEPTABLE.

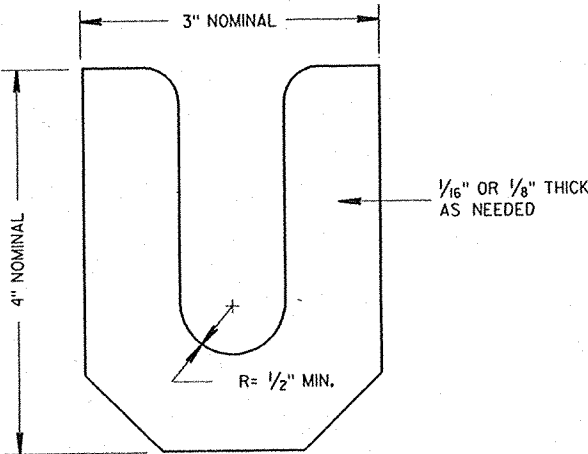


LEVELING SHIM

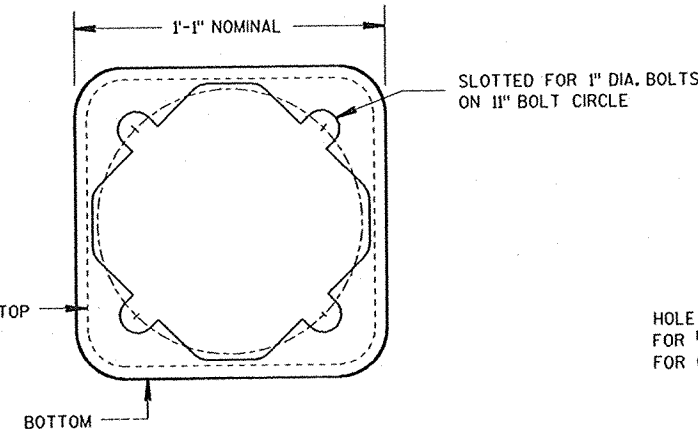


BOTTOM VIEW (TRANSFORMER BASE)

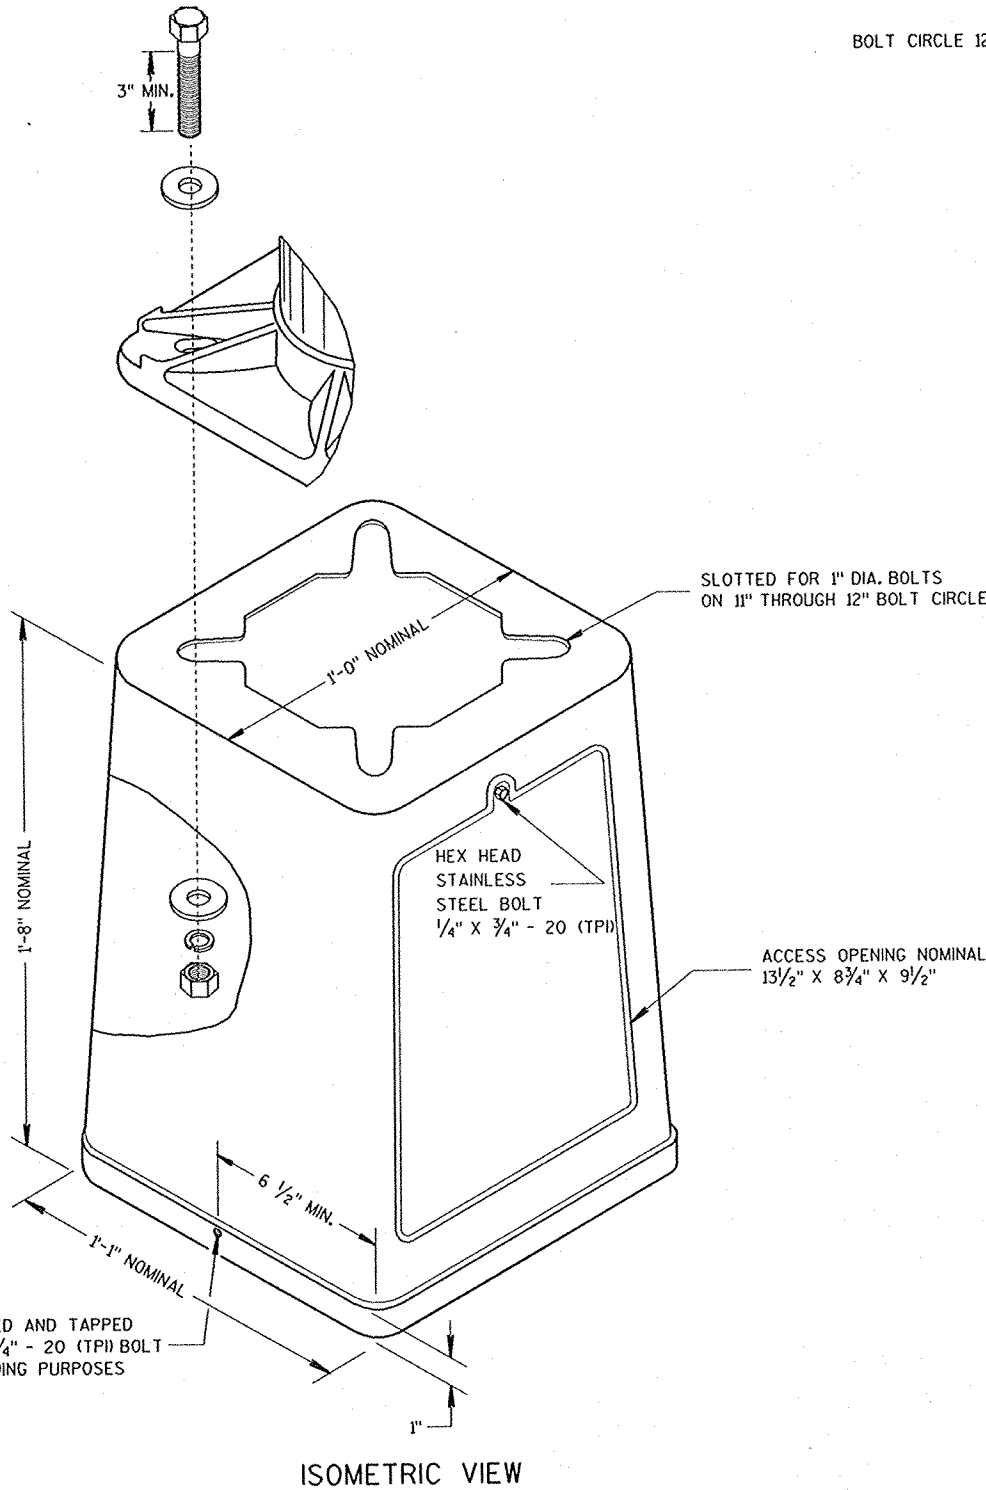


TRANSFORMER BASE
INTENDED FOR USE WITH TYPE 2, 3, 4 & 5 POLES

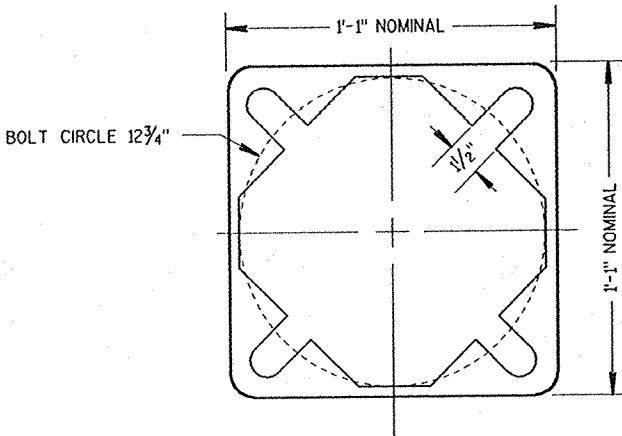

BOTTOM VIEW (PEDESTAL BASE)

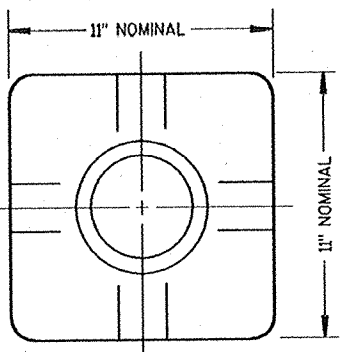


TOP VIEW (PEDESTAL BASE)

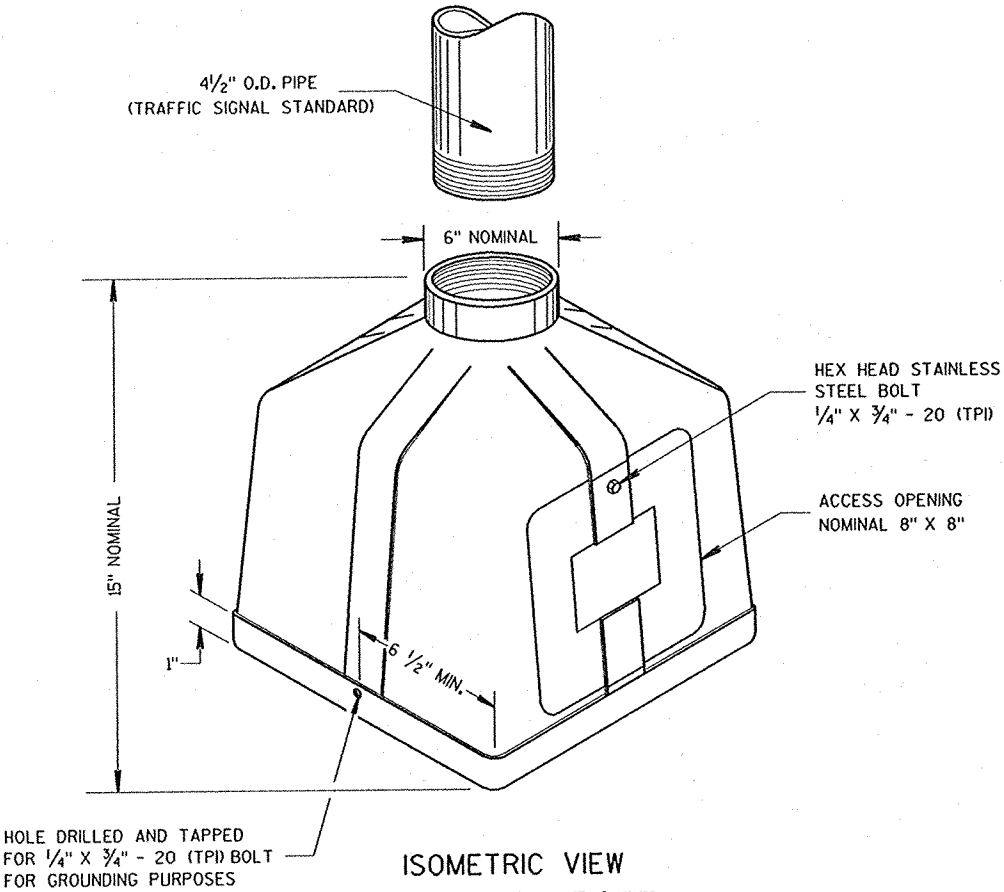

ISOMETRIC VIEW PEDESTAL BASE

CAST BASES	
STATE OF WISCONSIN DEPARTMENT OF TRANSPORTATION	
APPROVED 1-29-88 DATE	STATE TRAFFIC ENGINEER FOR HWYS
FHWA	

CONTROL CABINET BASE TYPE	DIMENSIONS				C.Y. CONCRETE (APPROX.)
	H	I	J	K	
TYPE 6 - 30" CABINET	34"	60"	10"	17"	.64
TYPE 7 - 38" CABINET	42"	60"	10"	21"	.93
TYPE 8 - 38" CABINET	42"	72"	12"	21"	1.29
TYPE 9 - VARIABLE	54"	72"	20"	27"	1.56
TYPE 10 - POST MOUNT	AS SHOWN				.32

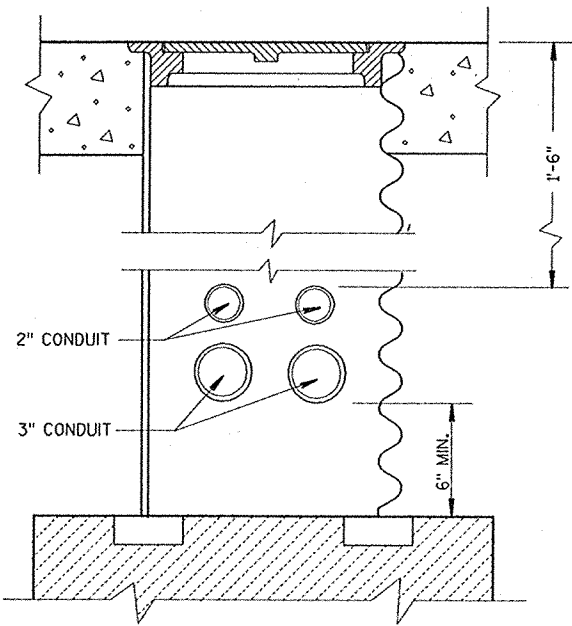

CONDUIT LOCATIONS IN 24" X 36" PULL BOX
(LEADING TO CONTROLLER CABINET BASE TYPE 6, 7, 8 AND 9)

GENERAL NOTES

DETAILS OF CONSTRUCTION, MATERIALS AND WORKMANSHIP NOT SHOWN ON THIS DRAWING SHALL CONFORM TO THE PERTINENT REQUIREMENTS OF THE CONTRACT.

INSTALL FOUR 1/2" INCH MINIMUM DIAMETER X 4 INCH MINIMUM LENGTH APPROVED CONCRETE MASONRY ANCHORS TO ANCHOR THE CABINET TO TYPE 6, 7, 8, AND 9 BASES. THE ANCHOR BOLTS SHALL BE LOCATED AS DIRECTED BY THE ENGINEER TO PROPERLY ANCHOR THE CONTROL CABINET TO THE BASE.

WHEN REQUIRED TO CONNECT NONMETALLIC CONDUIT TO METALLIC CONDUIT, ONLY ADAPTER FITTINGS, U.L. LISTED FOR ELECTRICAL USE, SHALL BE USED.

CONDUIT HEIGHT ABOVE THE CONCRETE BASE SHALL BE 1 INCH.

DEPTH OF CONDUIT INSTALLED BELOW THE TRAVELED WAY SHALL BE 24 INCHES MINIMUM AND 36 INCHES MAXIMUM.

DEPTH OF CONDUIT INSTALLED THAT IS NOT BELOW THE TRAVELED WAY SHALL BE 18 INCHES MINIMUM AND 36 INCHES MAXIMUM.

ANY EXCEPTION TO THE MAXIMUM DEPTH SHALL BE ONLY WITH THE WRITTEN APPROVAL OF THE ENGINEER.

CONTROL CABINET BASE TOP SURFACES SHALL BE TROWEL FINISHED AND LEVEL.

WHEN A TYPE 10 CONTROL CABINET BASE IS USED TO POST MOUNT A CONTROL CABINET, A 36" SQUARE 4" THICK CONCRETE MAINTENANCE PLATFORM SHALL BE REQUIRED ON THE DOOR SIDE OF THE CABINET. THE TOP 1 INCH SHALL BE ABOVE FINISHED GRADE AND BE BROOM FINISHED AND LEVEL.

MAINTENANCE PLATFORMS ARE NOT REQUIRED WHEN THE SURROUNDING AREA IS PAVED.

MINIMUM BENDING RADIUS OF CONDUIT = 6 X THE DIAMETER.

ALL METALLIC CONDUIT ENDS SHALL BE REAMED AND THREADED.

CAP ALL BELOW GRADE METALLIC CONDUIT ENDS IN WHICH WIRE OR CABLE IS NOT BEING INSTALLED.

PLUG ALL BELOW GRADE NONMETALLIC CONDUIT ENDS IN WHICH WIRE OR CABLE IS NOT BEING INSTALLED.




ALL CONDUIT ENDS AT THE TOP OF CONCRETE BASES SHALL BE CAPPED IF METALLIC OR PLUGGED IF NONMETALLIC IMMEDIATELY AFTER PLACEMENT AND BEFORE CONCRETE IS POURED. CONDUITS IN WHICH WIRE OR CABLE IS NOT BEING INSTALLED SHALL REMAIN CAPPED OR PLUGGED.

CONCRETE FORM DEPTH BELOW FINISHED GRADE SHALL BE 6" MAXIMUM. CONCRETE FORMS SHALL BE REMOVED AFTER CONCRETE HAS SET.

WHEN ANCHOR BOLTS USING THE ALTERNATE L BEND ARE FURNISHED FOR THE TYPE 10 BASE, THE 4" L BEND SHALL BE IN ADDITION TO THE SPECIFIED ANCHOR BOLT BAR LENGTH.

① FOUR (4) ANCHOR BOLTS, 1" DIA. X 3'-6"

TYPICAL 3'-0" X 3'-0" MAINTENANCE PLATFORM. LOCATION TO BE DETERMINED IN THE FIELD.

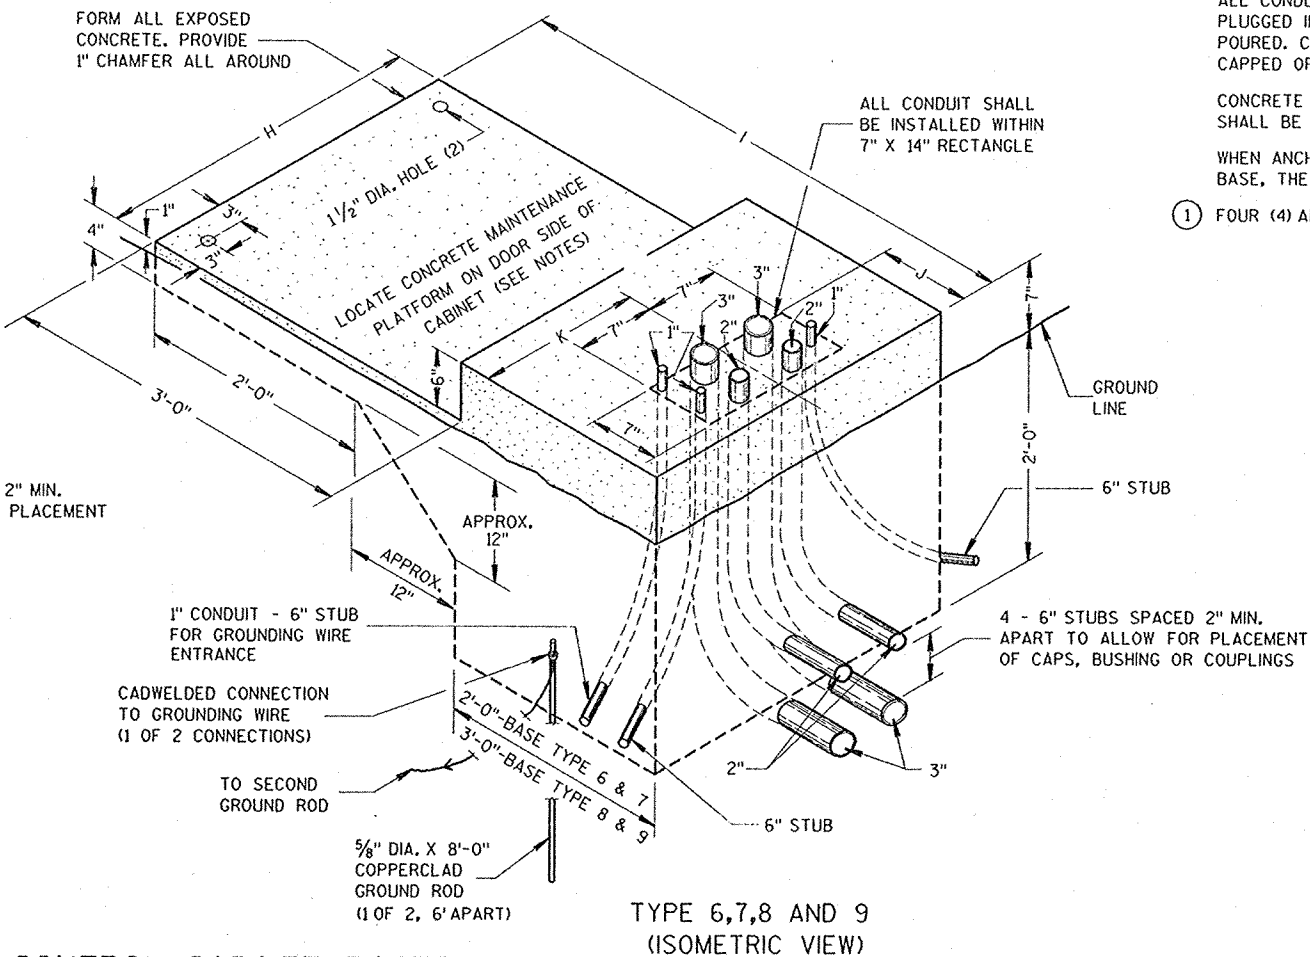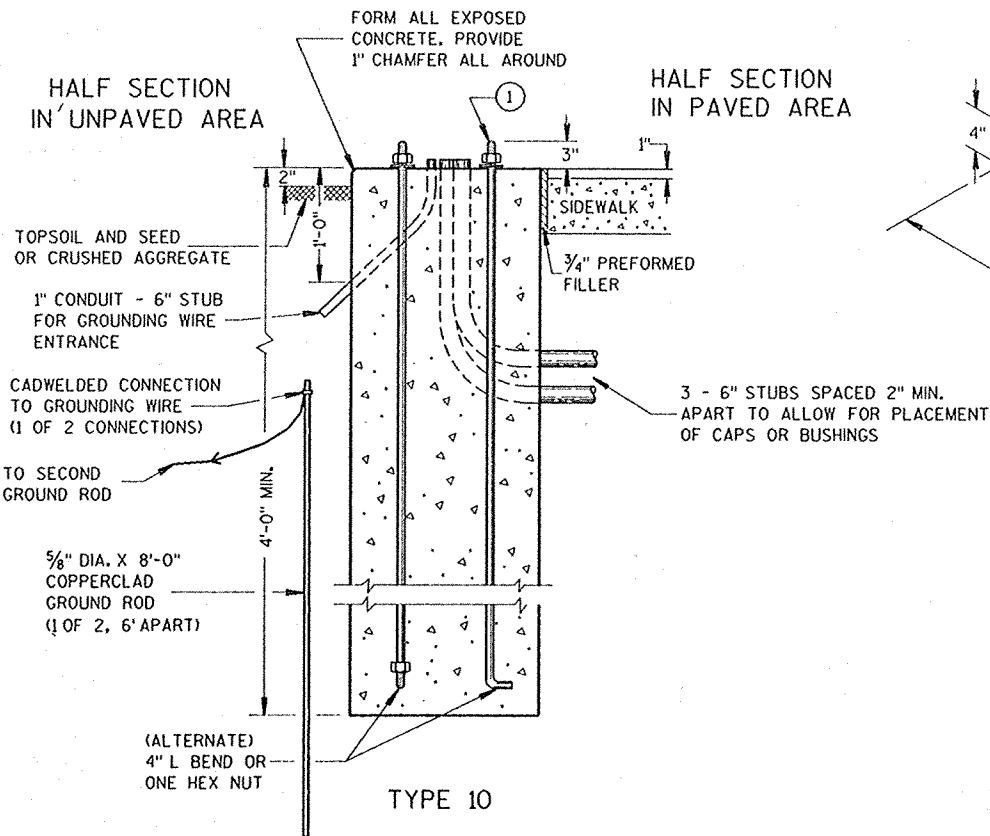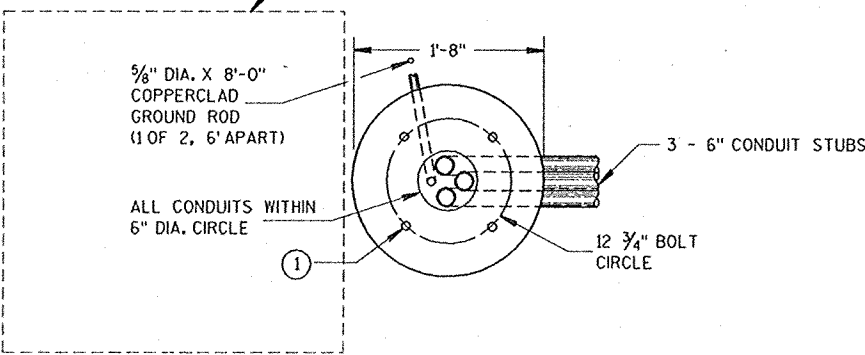

CONCRETE CONTROL CABINET BASES

CONCRETE CONTROL CABINET
BASES

STATE OF WISCONSIN
DEPARTMENT OF TRANSPORTATION

APPROVED
1-29-88
DATE



STATE TRAFFIC ENGINEER FOR HWYS

TABLE OF NOMINAL DIMENSIONS AND WEIGHTS

DIMENSION IN INCHES		TYPE OF PIPE						
		CORRUGATED STEEL						POLYETHYLENE SDR 32.5
PIPE DIAMETER (INSIDE)	A	12	12	18	18	24	24	12
PIPE LENGTH **	B	24	36	24	36	24	36	24
WALL THICKNESS	C	0.064	0.064	0.064	0.064	0.064	0.064	0.4
COVER	D	10 1/4	10 1/4	16 1/4	16 1/4	22 1/4	22 1/4	10 1/4
FRAME	E	14 1/2	14 1/2	20 1/2	20 1/2	26 1/2	26 1/2	14 1/2
FRAME	F	8 1/2	8 1/2	14 1/2	14 1/2	20 1/2	20 1/2	8 1/2
FRAME	G	11 1/2	11 1/2	17 1/2	17 1/2	23 1/2	23 1/2	11 1/2
WEIGHT IN POUNDS *								
FRAME AND COVER		60	60	110	110	155	155	60

* THE ACTUAL WEIGHT OF THE MANHOLE FRAME AND COVER MAY VARY WITHIN 5 PERCENT PLUS OR MINUS OF THE WEIGHTS SHOWN.

** NORMALLY USED LENGTHS. THE PROJECT ENGINEER SHALL DETERMINE IF PIPE LENGTHS, OTHER THAN THOSE SPECIFIED, SHALL BE USED.

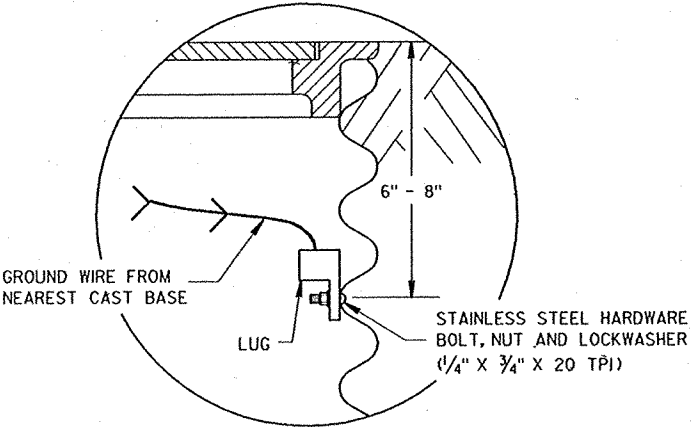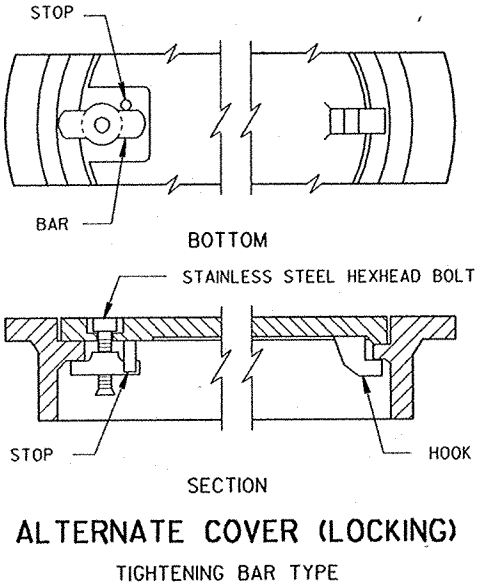

GROUNDING LUG
AND LOCATION IN
STEEL PULL BOXES

GENERAL NOTES

DETAILS OF CONSTRUCTION, MATERIALS AND WORKMANSHIP NOT SHOWN ON THIS DRAWING SHALL CONFORM TO THE PERTINENT REQUIREMENTS OF THE CONTRACT.

ALL FRAMES AND COVERS SHALL BE HEAVY DUTY TYPE, SUITABLE FOR VEHICULAR TRAFFIC LOADS. LOCKING TYPE COVERS ARE NOT REQUIRED UNLESS SPECIFIED IN THE CONTRACT.

ENTRANCE HOLES INTO PULL BOXES SHALL BE CUT WITH A CIRCULAR HOLE SAW OR HYDRAULIC CONDUIT PUNCH. HOLE SIZE SHALL BE THE OUTSIDE DIAMETER OF THE CONDUIT THAT IS TO FIT IN THE OPENING PLUS NO MORE THAN 1/4".

THE CONTRACTOR SHALL NOT INSTALL WIRE IN ANY PULL BOX UNTIL ITS INSTALLATION HAS BEEN INSPECTED AND ACCEPTED BY THE ENGINEER.

GROUNDING LUGS (MECHANICAL CONNECTORS) SHALL BE U.L. LISTED AND APPROVED FOR USE WITH COPPER WIRE. THE MECHANICAL CONNECTION (INSIDE AND OUTSIDE) TO THE PULL BOX, SHALL BE TOTALLY AND PERMANENTLY SEALED WITH A SILICONE OR RUBBERIZED CAULKING COMPOUND AS APPROVED BY THE ENGINEER.


GROUNDING LUGS ARE NOT REQUIRED IN PULL BOXES WHEN VOLTAGES OF LESS THAN 50 VOLTS AC ARE THE ONLY VOLTAGES ENCOUNTERED IN THE BOXES.

DRAIN DUCT SHALL BE MEASURED AND PAID FOR SEPARATELY.

RODENT SCREEN SHALL BE 1/8" GALVANIZED STEEL MESH AND BE INSTALLED WITH A STAINLESS STEEL HOSE CLAMP OF SUFFICIENT SIZE.

ALL METALLIC CONDUIT IN WHICH WIRE AND/OR CABLE IS TO BE INSTALLED, SHALL BE BUSHED BEFORE INSTALLATION OF THE WIRE AND/OR CABLE.

WHEN A PULL BOX IS INSTALLED IN CRUSHED AGGREGATE SHOULDERS, PLACE IT 2-3 INCHES BELOW GRADE AND COVER IT WITH 2-3 INCHES OF CRUSHED AGGREGATE

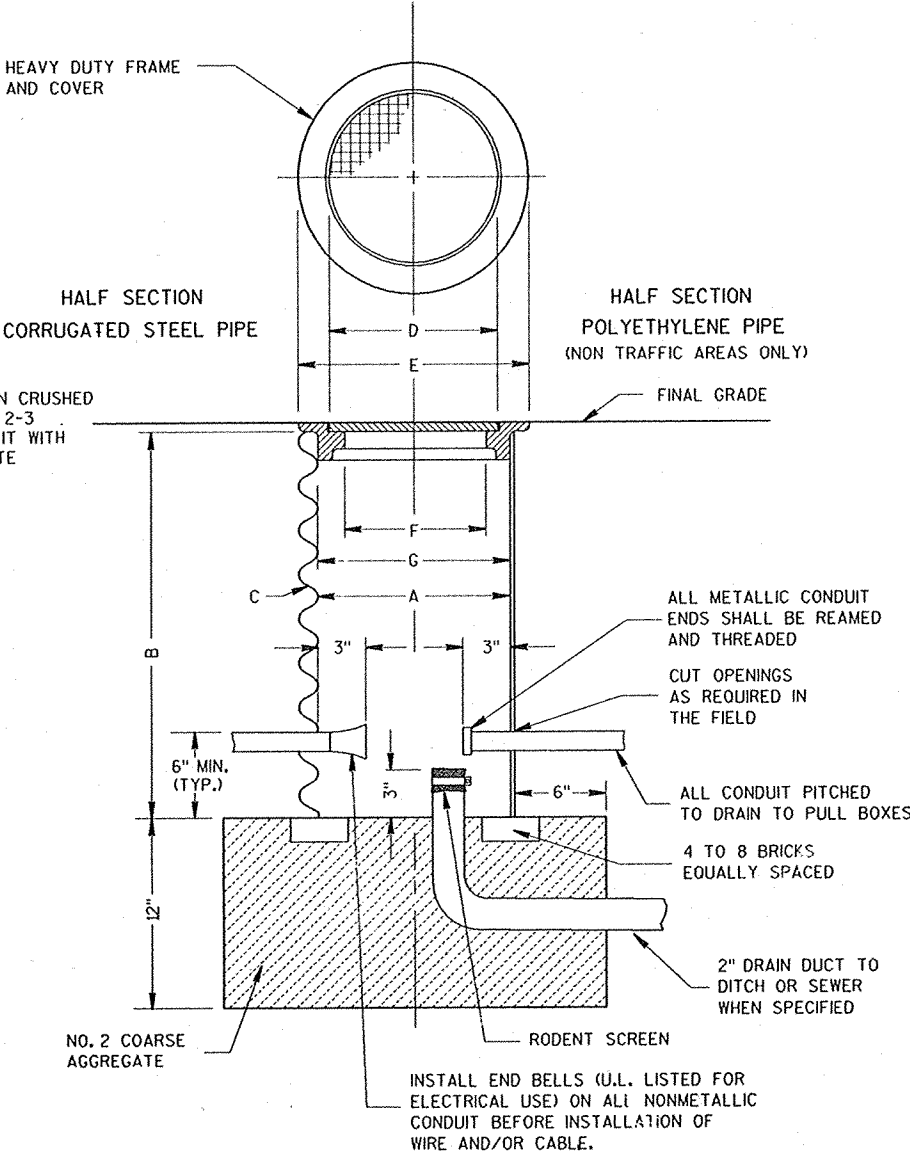


PULL BOX

PULL BOX

STATE OF WISCONSIN
DEPARTMENT OF TRANSPORTATION

APPROVED
1-29-88
DATE
FHWA

STATE TRAFFIC ENGINEER FOR HWYS

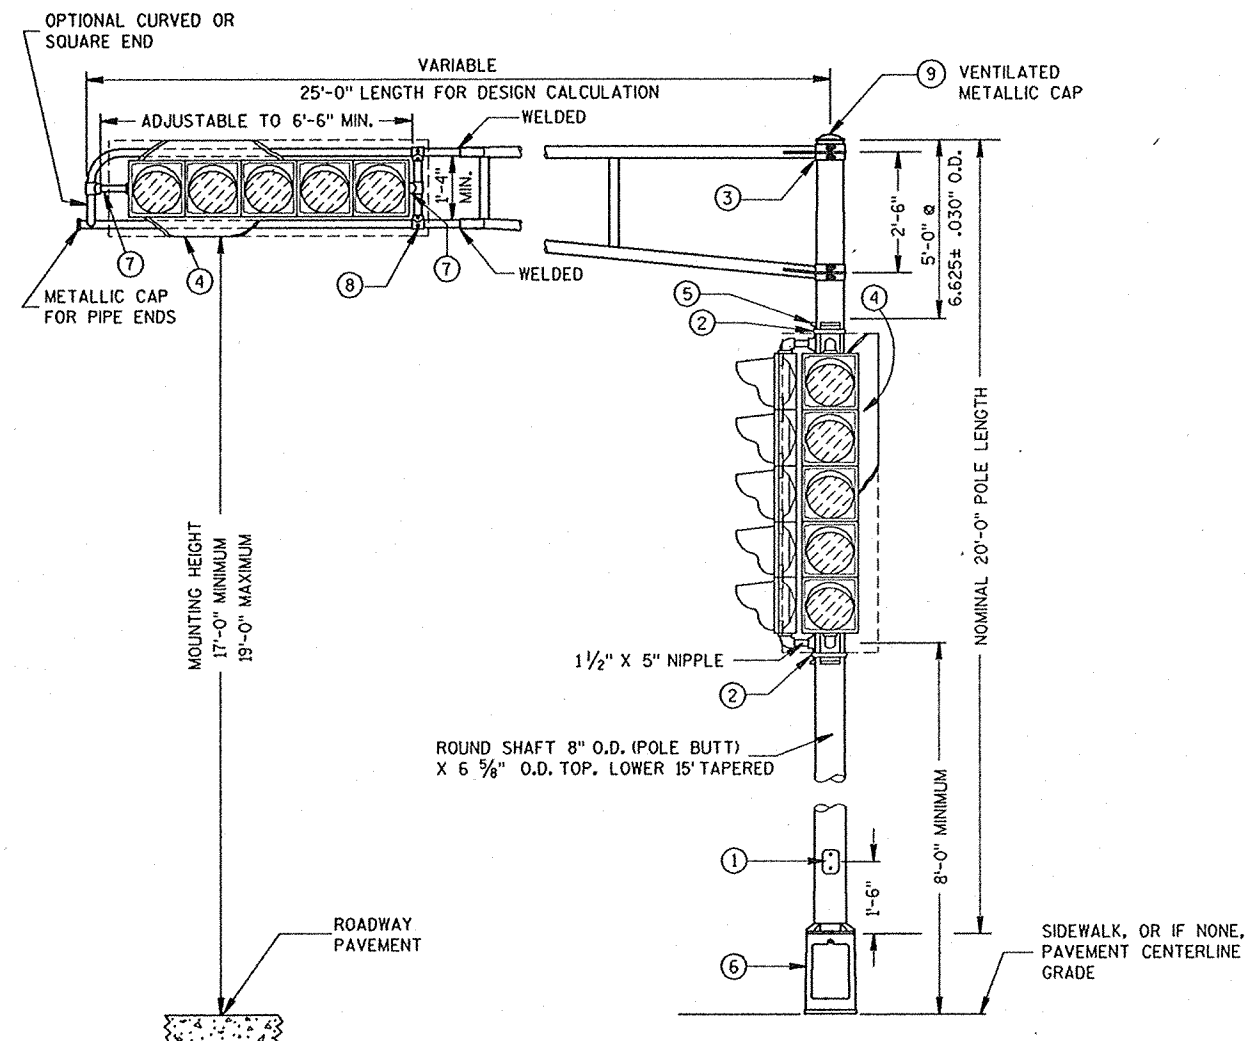

TYPE 2 POLE MOUNTING CONFIGURATION
(MAXIMUM LOAD)


GENERAL NOTES

- ① 4" X 6" HANDHOLE & COVER ASSEMBLY WITH $\frac{1}{4}$ " X $\frac{3}{4}$ " - 20 TPI HEX HEAD STAINLESS STEEL BOLTS.
- ② SIGNAL MOUNTING BRACKETS. MOUNT WITH CAP SCREWS AND BANDING. (SEE SPECIAL PROVISIONS).
- ③ GROMMETS OR 1" CHASE NIPPLES WITH LOCKNUTS SHALL BE PROVIDED FOR $1\frac{3}{8}$ " HOLE IN POLE SHAFT.
- ④ BACKPLATE REQUIRED TO SURROUND SIGNAL FACES. BACKPLATE TO EXTEND 5" BEYOND EXTREMITIES OF SIGNAL HEAD.
- ⑤ SPACERS INSTALLED TO PLUMB HEADS AS NEEDED.
- ⑥ CAST ALUMINUM TRANSFORMER BASE, WHEN REQUIRED.
- ⑦ $1\frac{1}{2}$ " PIPE THREAD ON THE MOUNTING BRACKET NIPPLES FOR THE SIGNAL HEAD. NIPPLE SHALL BE $1\frac{1}{2}$ " X 2".
- ⑧ VERTICAL STRUT (ADJUSTABLE). ONE (1) SET SCREW ($\frac{1}{4}$ " X $\frac{3}{4}$ " LONG-20 TPI, STAINLESS STEEL, HEX HEAD) INTO EACH ARM MEMBER IF STRUT IS THE SLIDING TYPE.
- ⑨ METALLIC CAPS SHALL BE FASTENED WITH $\frac{1}{4}$ " X $\frac{3}{4}$ " - 20 TPI STAINLESS STEEL, HEX HEAD BOLTS.


NOTE:
SHEET SDD 9 B 11-1e IS REQUIRED WHEN THIS
DRAWING IS CALLED FOR IN THE PLANS.

POLE MOUNTINGS FOR
TRAFFIC SIGNALS
TYPE 2


STATE OF WISCONSIN
DEPARTMENT OF TRANSPORTATION

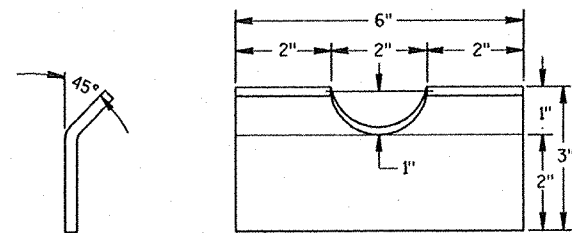


FRONT VIEW
RECTANGULAR CLAMP SHIM
(4 TO A SET)

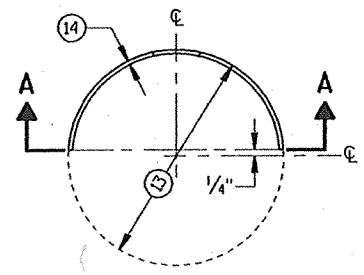


PLAN VIEW

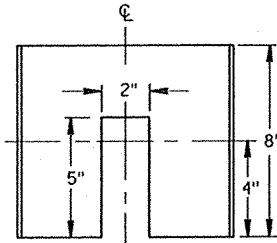

SECTION A-A
CIRCULAR CLAMP SHIM
(2 TO A SET)

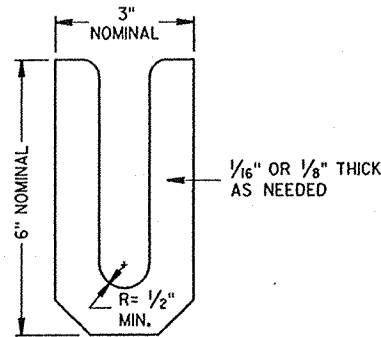


LEVELING SHIM (15)

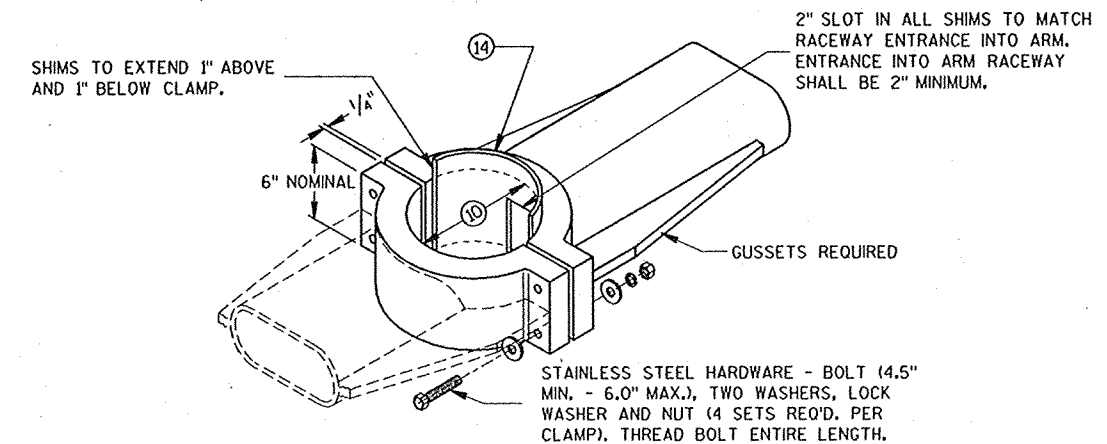



TYPICAL TROMBONE MAST ARM AND
LUMINAIRE MAST ARM MOUNTING CLAMP

GENERAL NOTES


- (10) 4.5" I.D. FOR LUMINAIRE MAST ARM CLAMP.
6.625" I.D. FOR TROMBONE MAST ARM CLAMP.
- (11) INDIVIDUAL BOLT COVERS FOR BASE PLATE.
- (12) BASE PLATE SLOTTED TO ACCEPT 1" THROUGH 12" BOLT CIRCLE USING 1" DIAMETER ANCHOR BOLTS.
- (13) OUTSIDE SHIM DIAMETER - (4.5" O.D. FOR LUMINAIRE MAST ARM)
(6.625" O.D. FOR TROMBONE MAST ARM)
- (14) VARIABLE SHIM THICKNESS - (0.10", 0.25", 0.35", 0.53" OR 0.70")
SHIM THICKNESS FOR TROMBONE MAST ARMS MAY BE TYPICALLY 0.35", 0.53" OR 0.70".
SHIM THICKNESS FOR LUMINAIRE MAST ARMS MAY BE TYPICALLY 0.10", 0.25" OR 0.35".
SHIM MATERIAL SHALL BE ALUMINUM ALLOY.
SHIM THICKNESS SHALL BE IMPRESSED INTO EACH SHIM. NUMERALS SHALL BE 1/4" HIGH AND LEGIBLE.
THE CONTRACTOR SHALL SUBMIT TWO COPIES OF ALL SHIM SHOP DRAWINGS TO THE ENGINEER FOR APPROVAL.
- (15) LEVELING SHIMS, DESIGNED FOR THE PURPOSE, SHALL BE USED WHEN PLUMBING POLES. THE USE OF WASHERS IN LIEU OF PROPER LEVELING SHIMS IS NOT ACCEPTABLE. LEVELING SHIMS SHALL BE USED ONLY BETWEEN THE TOP OF THE CONCRETE BASE AND A METALLIC BASEPLATE.

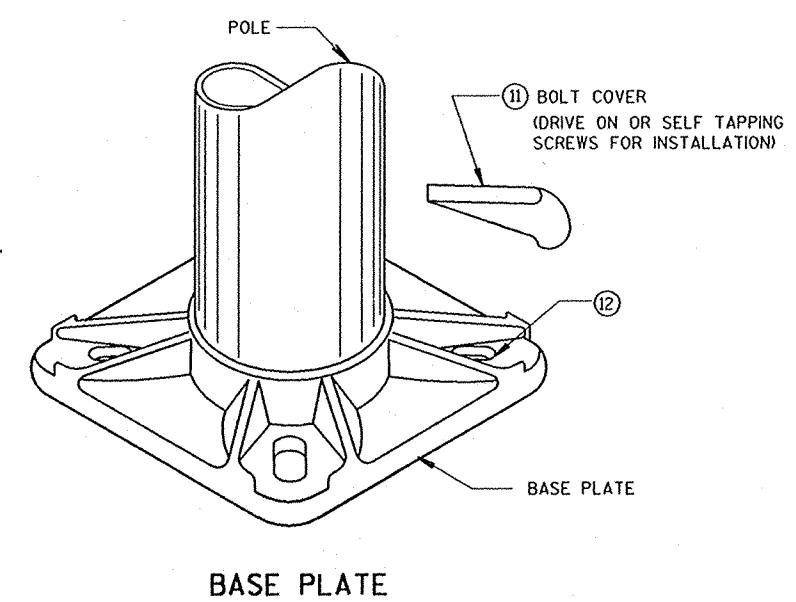


BASE PLATE

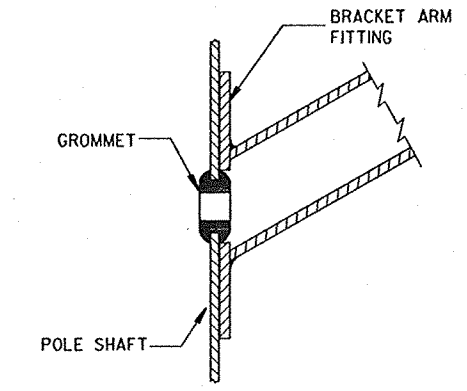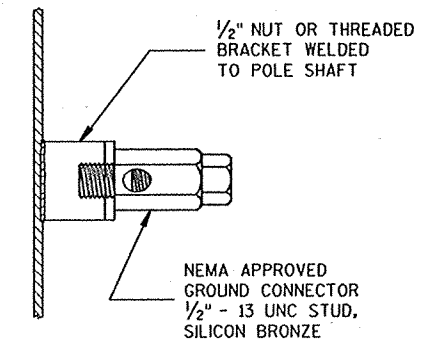


TYPICAL APPLICATION OF
GROMMET IN POLE SHAFT

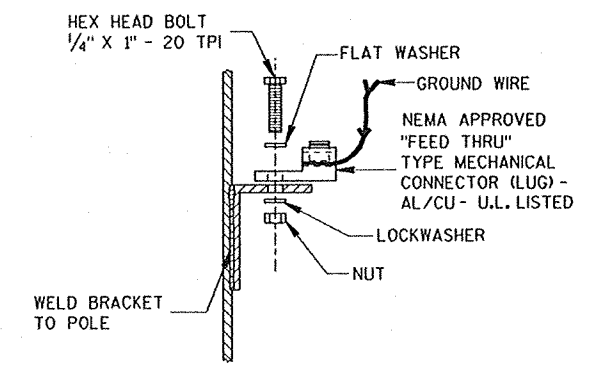

TYPICAL GROUNDING CONNECTIONS
NUT, BOLT AND WASHERS SHALL
BE STAINLESS STEEL

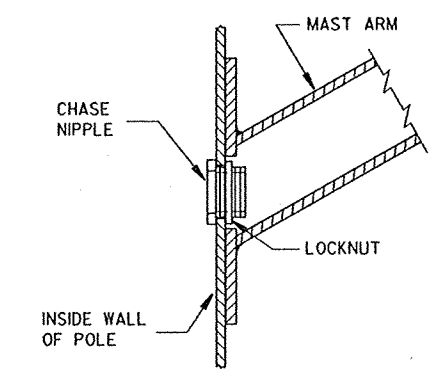

TYPICAL APPLICATION OF
CHASE NIPPLE IN POLE SHAFT

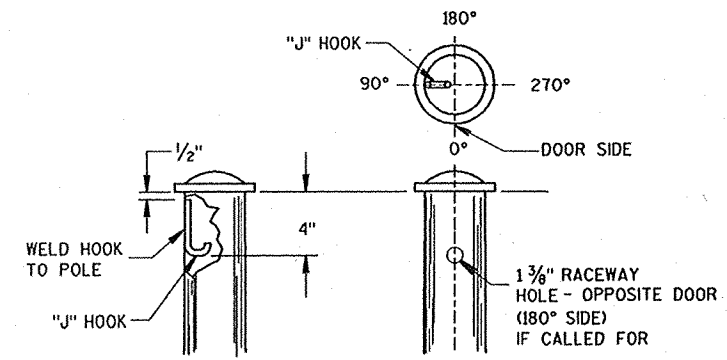


TYPICAL "J" HOOK LOCATION

NOTE:
THIS DRAWING IS REQUIRED WHEN DRAWINGS
SDD 9 B 11-1a,b,c, OR d IS CALLED FOR IN
THE PLANS.


HARDWARE DETAILS FOR
POLE MOUNTINGS

STATE OF WISCONSIN
DEPARTMENT OF TRANSPORTATION


APPROVED
8-31-88
DATE
STATE TRAFFIC ENGINEER FOR HWYS
FHWA

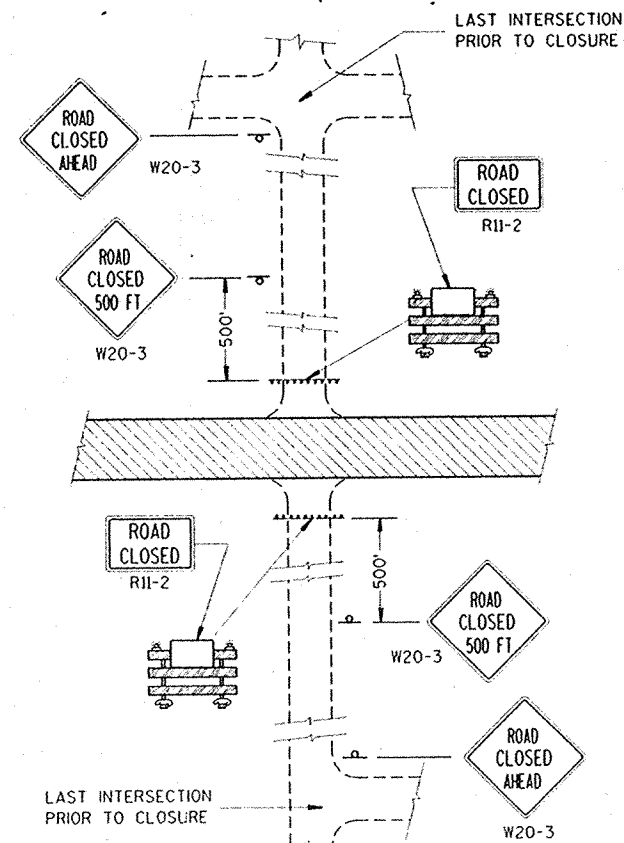

DETAIL 1
(NO ACCESS TO PROJECT)

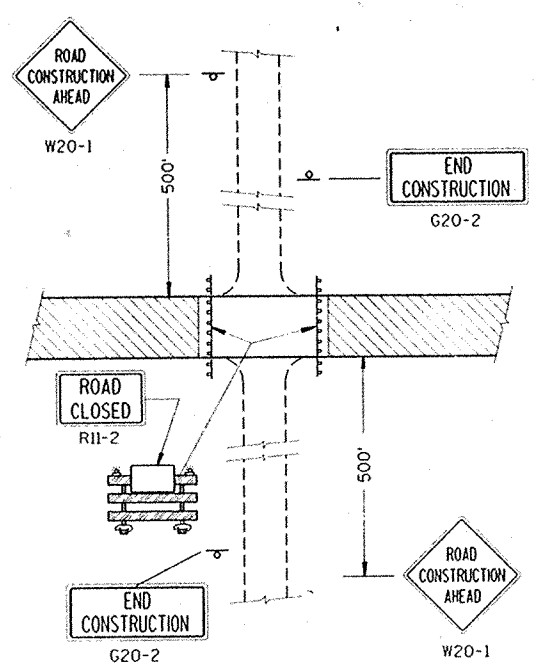


DETAIL 2
(PUBLIC CROSS-TRAFFIC MAINTAINED.
NO ACCESS TO PROJECT).

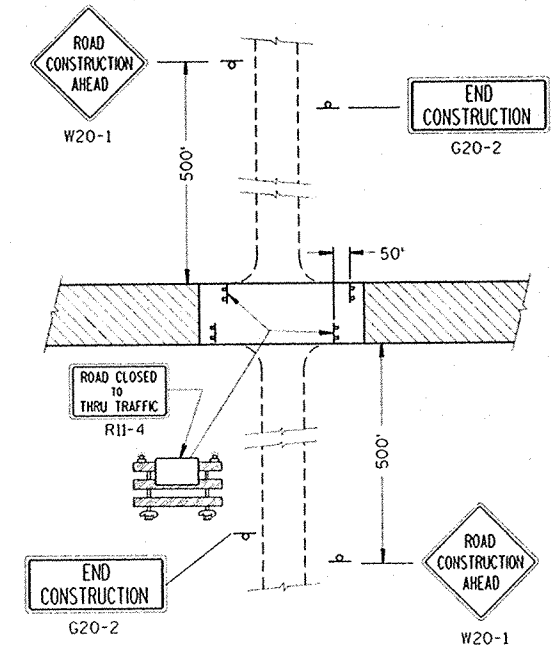


DETAIL 3
(PUBLIC CROSS-TRAFFIC MAINTAINED. CONTRACTOR,
LOCAL BUSINESS AND RESIDENT ACCESS).


SIDEROAD CLOSURES

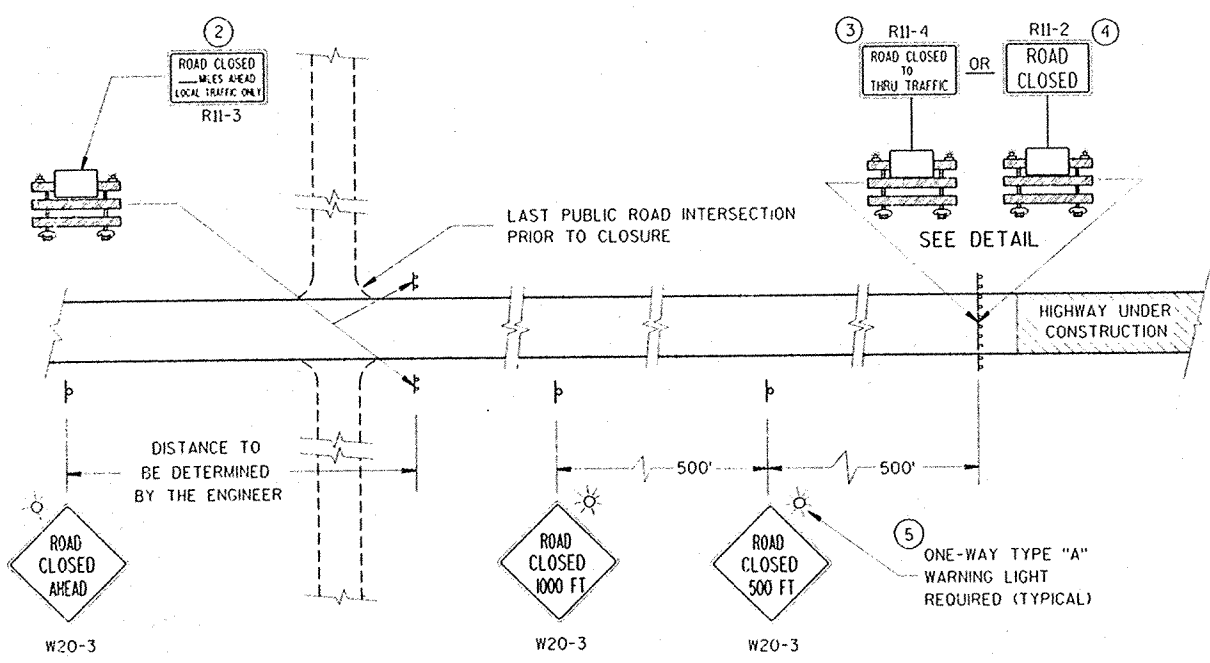

MAINLINE CLOSURE

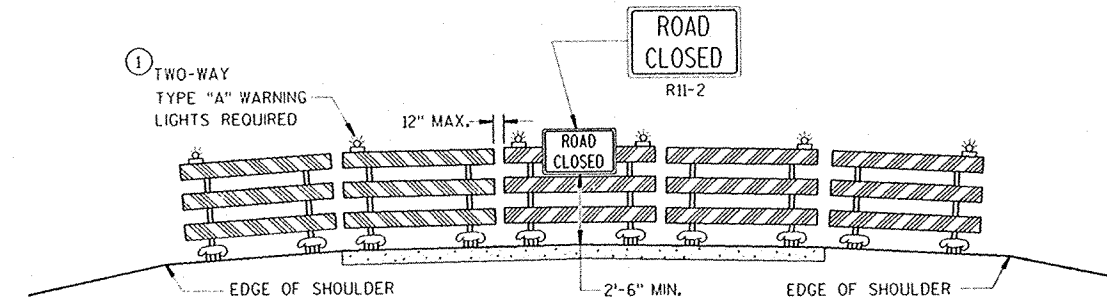

ROAD CLOSURE BARRICADE DETAIL

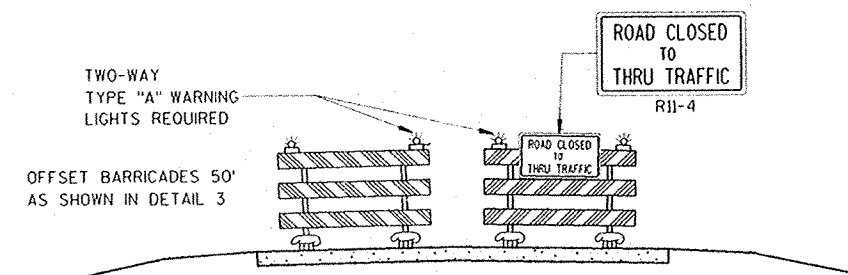

LANE CLOSURE BARRICADE DETAIL

GENERAL NOTES

DETAILS OF TRAFFIC CONTROL DEVICES AND THEIR LOCATION NOT SHOWN ON THIS DRAWING SHALL CONFORM TO THE PERTINENT REQUIREMENTS OF THE WISCONSIN MANUAL OF TRAFFIC CONTROL DEVICES, THE PLANS, SPECIFICATIONS AND CONTRACT.

SIGN AND BARRICADE LOCATIONS MAY BE ADJUSTED IN THE FIELD AS DIRECTED BY THE ENGINEER. ANY EXISTING TRAFFIC SIGNS THAT CONFLICT WITH THIS WORK SHALL BE COVERED AS DIRECTED BY THE ENGINEER. ALL "STOP" OR OTHER REGULATORY SIGNS ON THE SIDE ROADS SHALL NOT BE DISTURBED, EXCEPT WHEN NECESSARY TO COMPLETE THE WORK. THE SIGNS MUST THEN BE IMMEDIATELY REESTABLISHED.

ALL TYPE III BARRICADES SHALL HAVE RAILS REFLECTORIZED ON BOTH FACES. STRIPES SHALL BE PROPERLY SLOPED DOWN TOWARD THE TRAFFIC SIDE OR AS SHOWN IN THE ROAD CLOSURE BARRICADE DETAIL FOR FULL ROAD CLOSURES. TYPE "A" LOW INTENSITY FLASHING WARNING LIGHTS SHALL BE VISIBLE ON BOTH SIDES OF THE BARRICADE.

THE ROAD CLOSED SIGN (R11-2), ROAD CLOSED _____ MILES AHEAD SIGN (R11-3) AND THE ROAD CLOSED TO THRU TRAFFIC SIGN (R11-4) SHALL BE ATTACHED ONLY TO THE TOP RAIL OF THE TYPE III BARRICADE. THE SIGNS SHALL NOT COVER MIDDLE RAIL.

TYPE "H" REFLECTIVE SHEETING SHALL BE USED ON ALL BARRICADES, TYPE I, II AND III, AND ON ALL R11-2, R11-3 AND R11-4 SIGNS.

ALL SIGNS SHALL BE 48" X 48" UNLESS OTHERWISE NOTED BELOW:

R11-2, "ROAD CLOSED" SIGNS SHALL BE 48" X 30".

R11-3, AND R11-4 SIGNS SHALL BE 60" X 30".








G20-2 SIGNS SHALL BE 60" X 24".

- 1 TWO WARNING LIGHTS SHALL BE PROVIDED ON THE CENTER BARRICADE AND AT LEAST ONE WARNING LIGHT SHALL BE PROVIDED ON EACH OF THE OTHER BARRICADES WITHIN THE ROADWAY LIMITS. SPACING OF THE WARNING LIGHTS SHALL BE UNIFORM TO THE EDGE OF ROADWAY AS SHOWN.
- 2 THESE SIGNS AND BARRICADES ARE NOT REQUIRED IF ROAD CLOSURE BEGINS AT INTERSECTION.
- 3 FOR ROAD CLOSURE WITH LOCAL ACCESS TO PROJECT. SEE LANE CLOSURE BARRICADE DETAIL.
- 4 FOR ROAD CLOSURE WITHOUT LOCAL ACCESS TO PROJECT. SEE ROAD CLOSURE BARRICADE DETAIL.
- 5 ONE-WAY LIGHTS SHALL BE PROVIDED ON ALL ADVANCE WARNING SIGNS. THE UNIT SHALL BE POSITIONED SUCH THAT THE LIGHT SOURCE IS OUTSIDE THE SIGN FACE AND AT THE TOP OF THE SIGN.


LEGEND

- POST MOUNTED WARNING SIGN
- TYPE III BARRICADES WITH TYPE "H" REFLECTIVE SHEETING
- TYPE "A" LOW INTENSITY FLASHING WARNING LIGHT (FOR NIGHT USE)
- WORK AREA


BARRICADES AND TRAFFIC CONTROL FOR ROAD CLOSURES	
STATE OF WISCONSIN DEPARTMENT OF TRANSPORTATION	
APPROVED 10-31-89 DATE	STATE TRAFFIC ENGINEER FOR HWYS
FHWA	

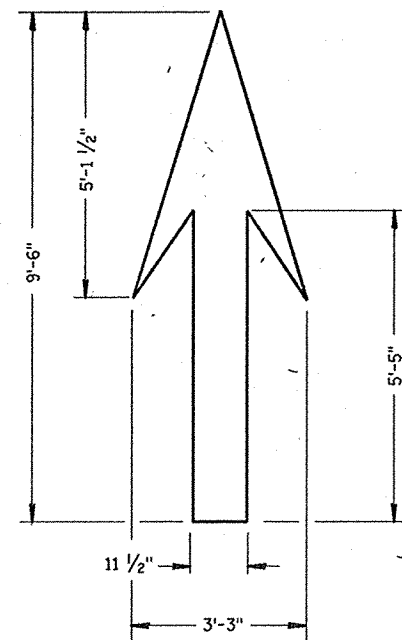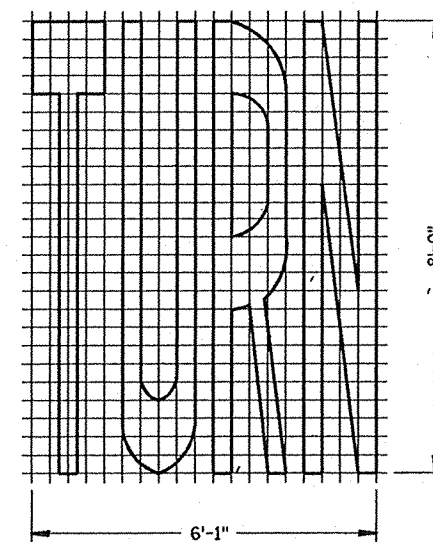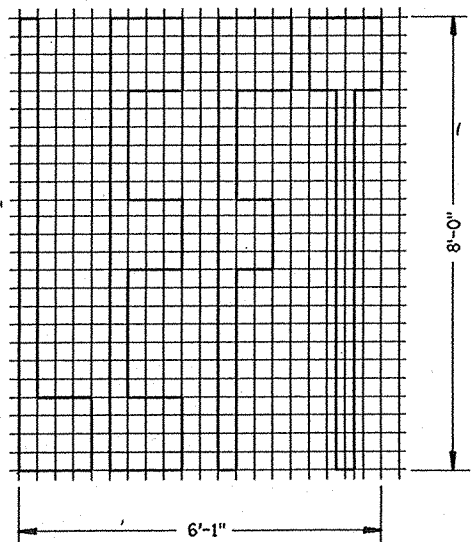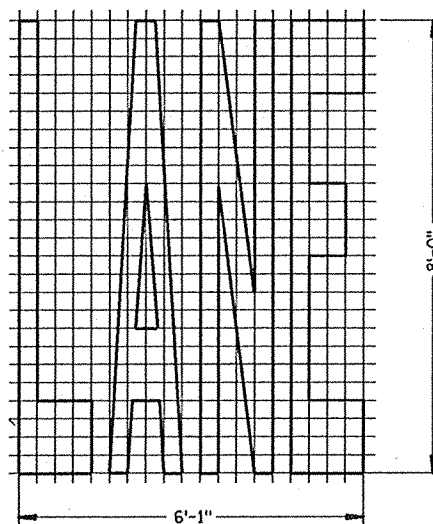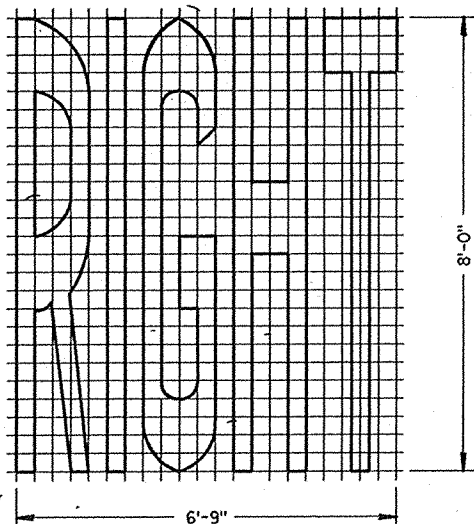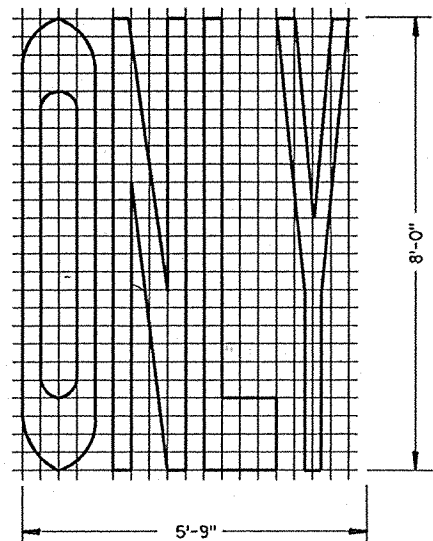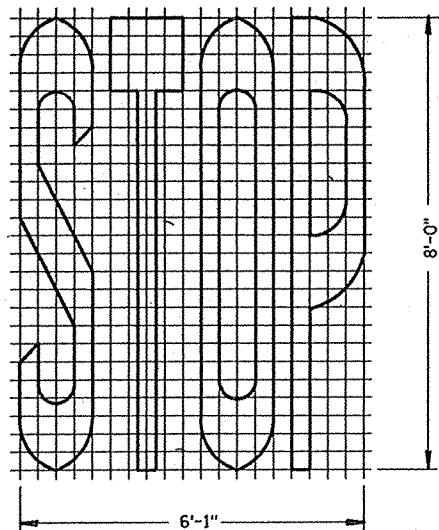


TYPE 1

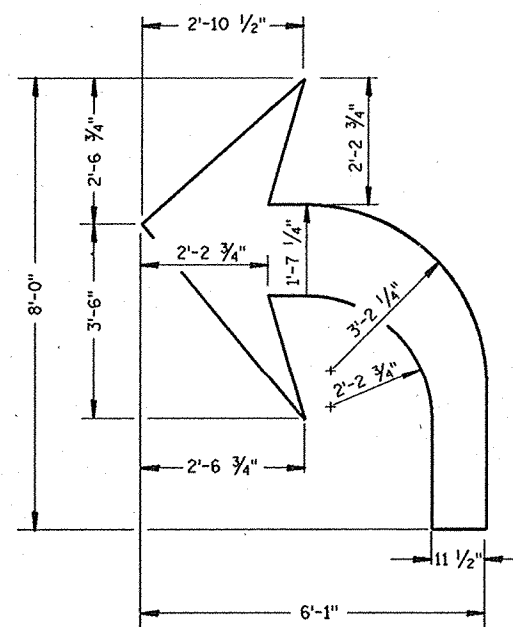

TYPE 2

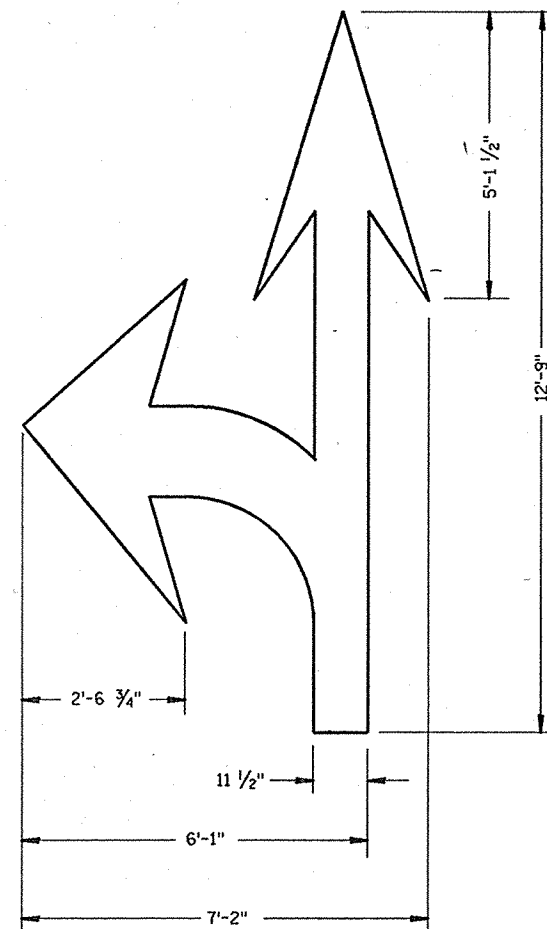

TYPE 3

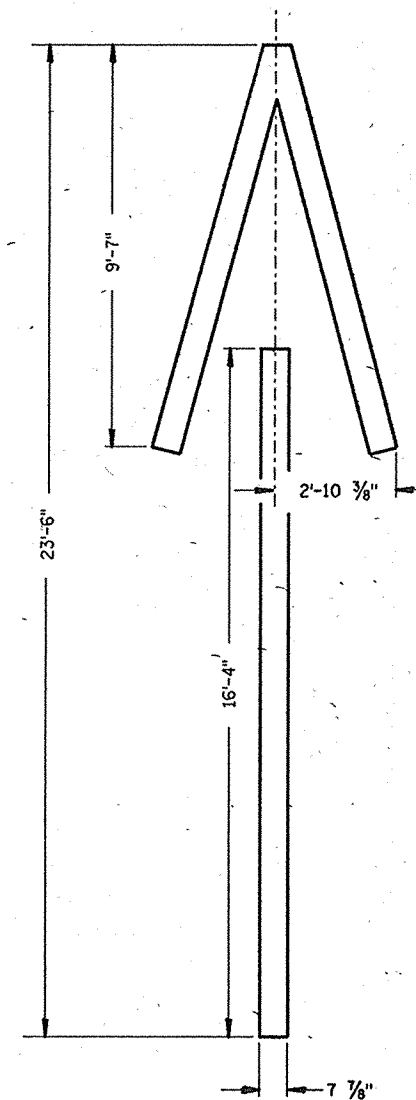

TYPE 4

GENERAL NOTES

DETAILS OF INSTALLATION, MATERIALS AND WORKMANSHIP NOT SHOWN ON THIS DRAWING SHALL CONFORM TO THE PERTINENT REQUIREMENTS OF THE STANDARD SPECIFICATIONS AND APPLICABLE SPECIAL PROVISIONS.

ALL LETTERS AND ARROWS SHALL BE WHITE AND REFLECTORIZED.

PAVEMENT MARKING SYMBOLS

STATE OF WISCONSIN
DEPARTMENT OF TRANSPORTATION


APPROVED

5-23-86


DATE

FHWA

STATE TRAFFIC ENGINEER FOR HWYS

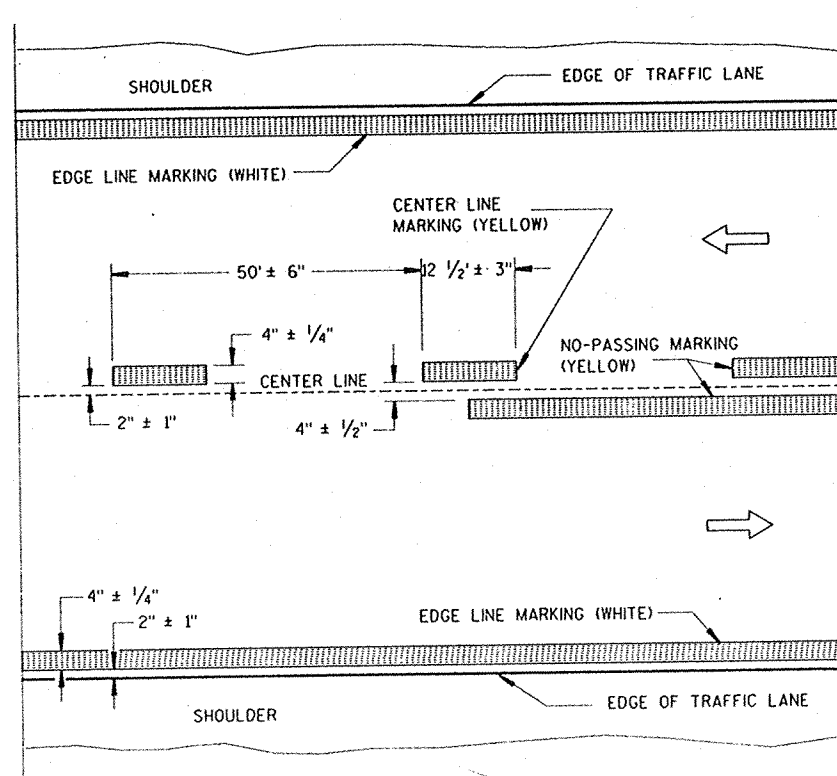


TWO WAY TRAFFIC

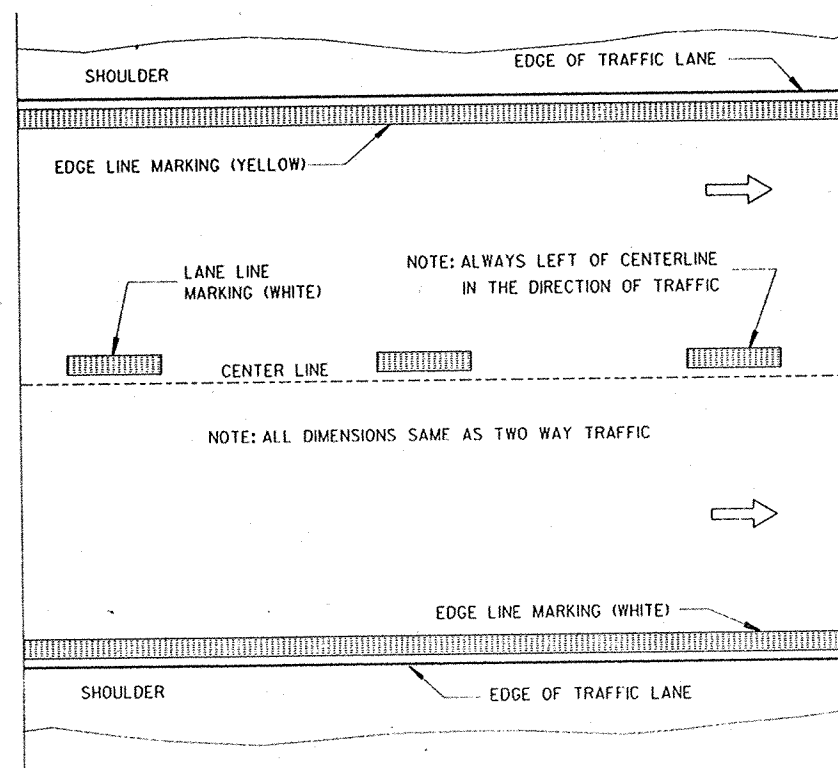

ONE WAY TRAFFIC

PERMANENT PAVEMENT MARKING

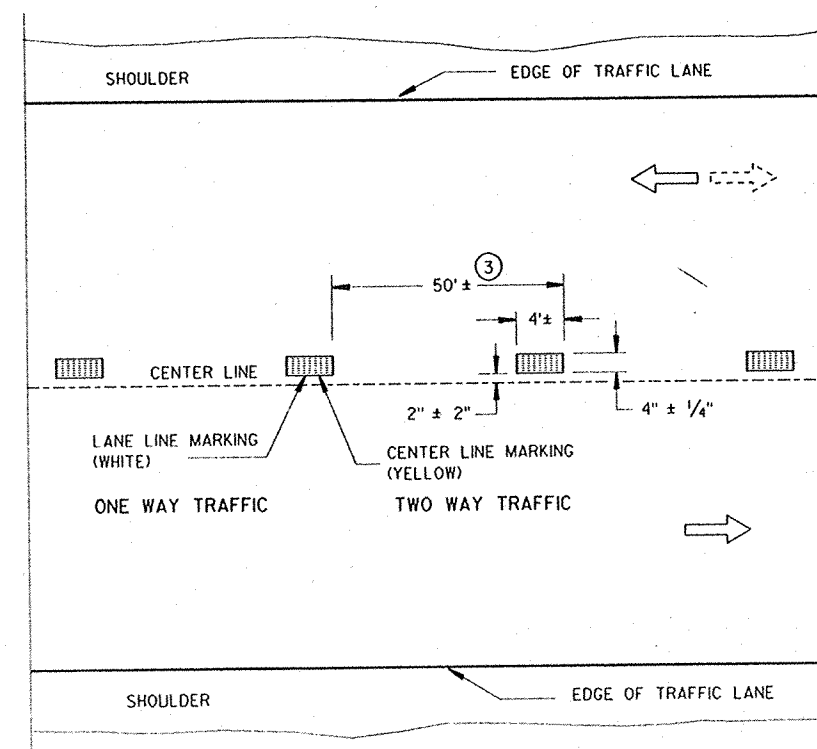


TEMPORARY PAVEMENT MARKING

GENERAL NOTES

DETAILS OF CONSTRUCTION NOT SHOWN ON THIS DRAWING SHALL CONFORM TO STANDARD SPECIFICATIONS AND SPECIAL PROVISIONS.

EDGE LINES SHALL BE OMITTED THROUGH INTERSECTIONS. EDGE LINES SHALL BE CONTINUED THROUGH DRIVEWAYS.

- ① WHEN DISTANCE "A" IS LESS THAN 250 FEET, OMIT TURNING LANE MARKING.
- ② WHEN DISTANCE "B" IS LESS THAN 100 FEET, OMIT CHANNELIZING LANE LINE.
- ③ HALF CYCLE LENGTHS (25'±) WITH 2" MINIMUM STRIPE LENGTHS SHALL BE PROVIDED ON ROADWAYS (INCLUDING TEMPORARY TRAVELED WAYS) WITH REVERSE CURVATURE, CURVATURE OF OVER 5 DEGREES OR WHEN DIRECTED BY THE ENGINEER TO MARK UNUSUAL ALIGNMENT OF THE TRAVELED WAY.

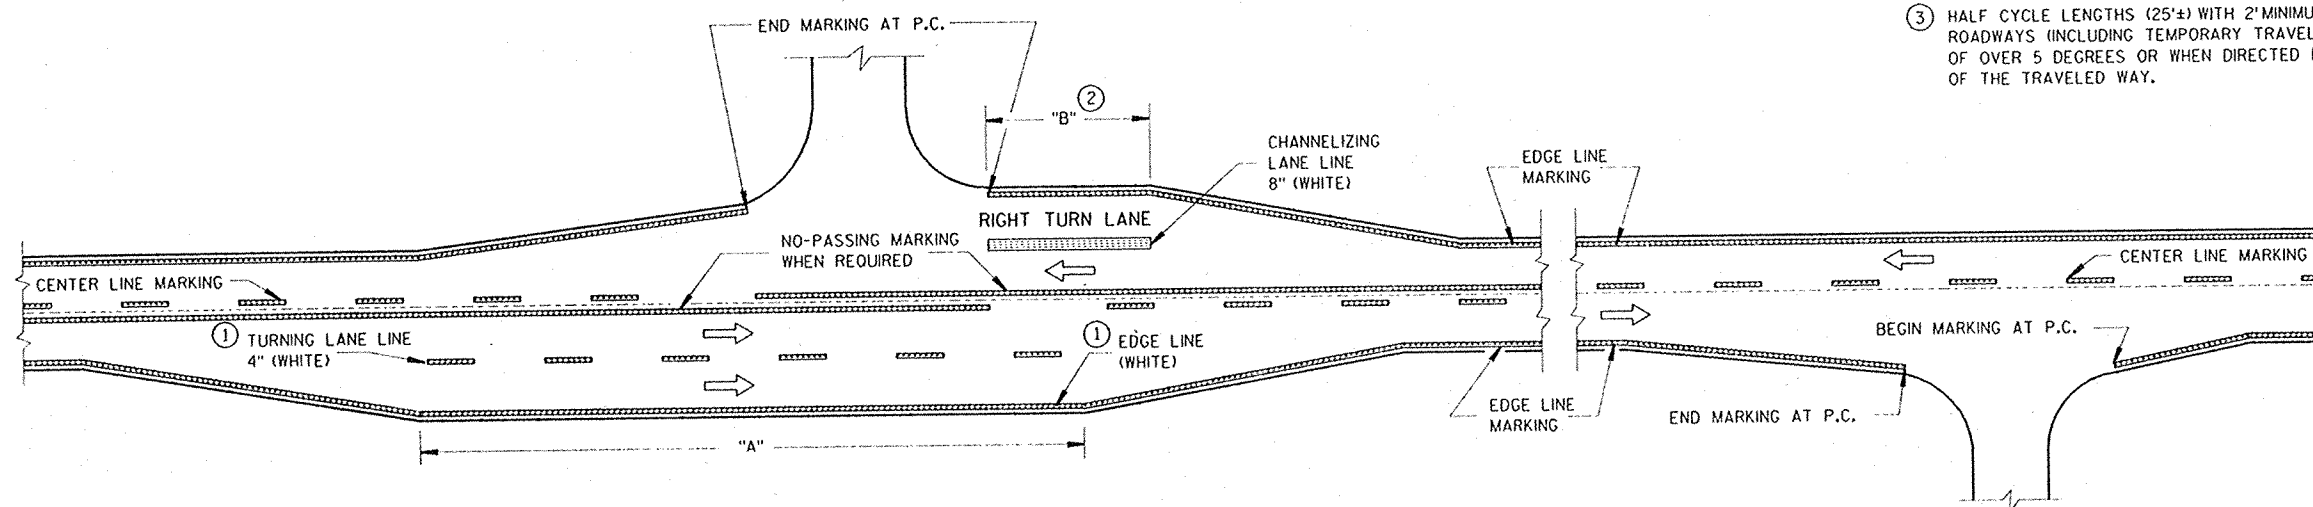

MAJOR INTERSECTION

MINOR INTERSECTION

TYPICAL PAVEMENT MARKING FOR RURAL INTERSECTIONS


PAVEMENT MARKING

STATE OF WISCONSIN
DEPARTMENT OF TRANSPORTATION


APPROVED
3-10-89
DATE

STATE TRAFFIC ENGINEER FOR HWYS


FHWA

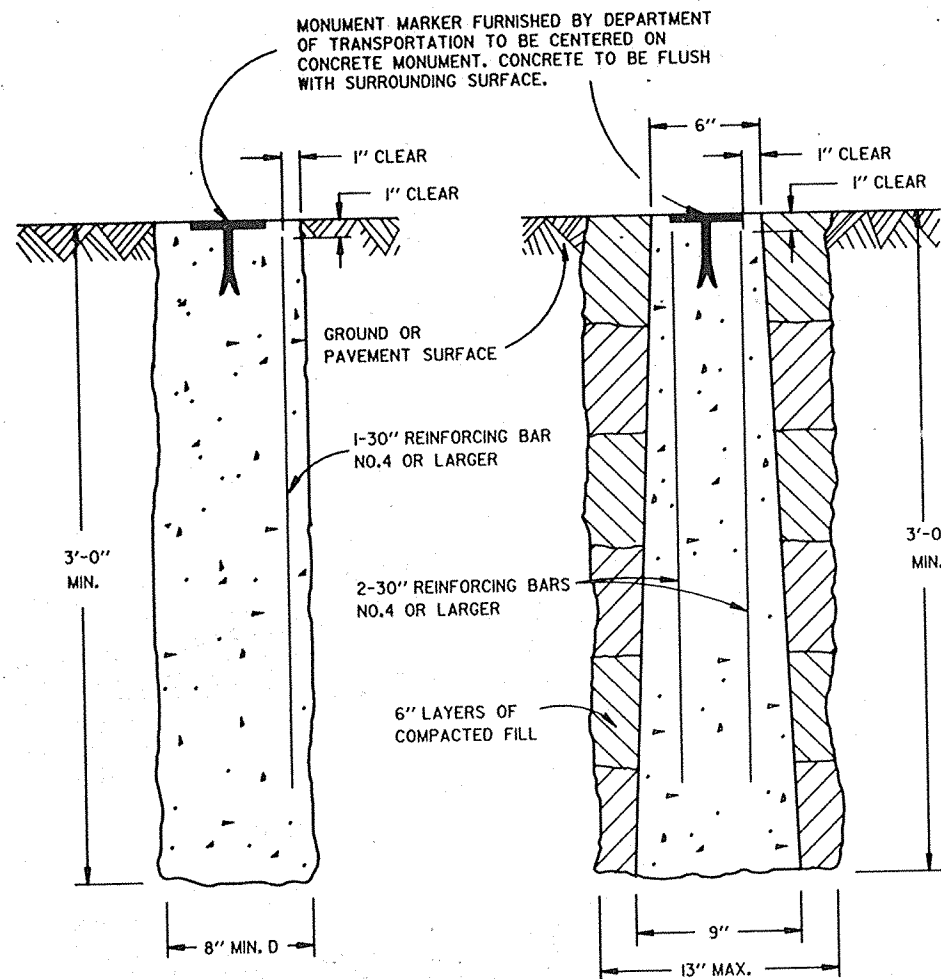

CAST-IN-PLACE
CONCRETE MONUMENTS
TYPE A

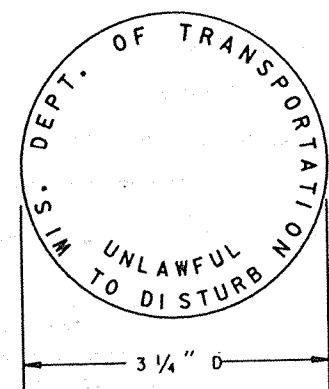


MONUMENT MARKER LOGO
FOR TYPES "A", "C" & "D"

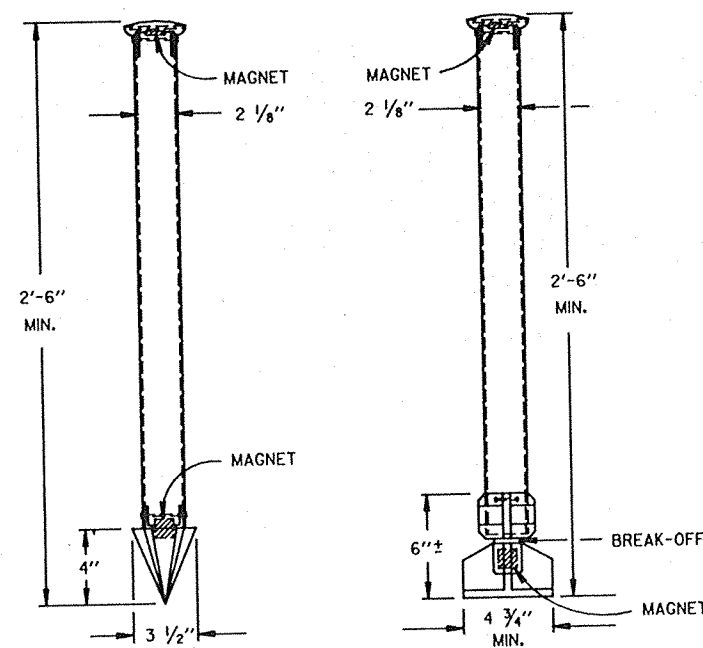

TYPE C
DRIVE-IN MONUMENT

TYPE D
BREAK-OFF MONUMENT

ALUMINUM MONUMENTS
(INCLUDES MARKER)

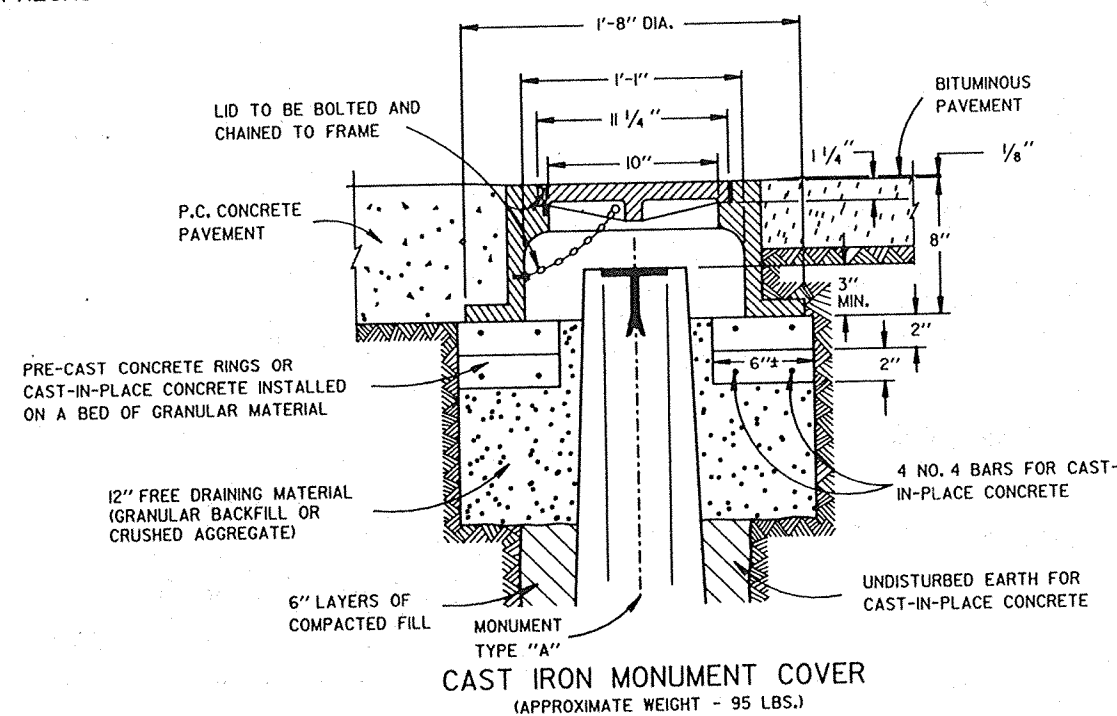

GENERAL NOTES

DETAILS OF CONSTRUCTION, MATERIALS AND WORKMANSHIP NOT SHOWN ON THIS DRAWING SHALL CONFORM TO THE PERTINENT REQUIREMENTS OF THE STANDARD SPECIFICATIONS AND THE APPLICABLE SPECIAL PROVISIONS.

DETAILED DRAWINGS OF PROPOSED ALTERNATE DESIGNS FOR METAL MONUMENTS OR MONUMENT COVERS SHALL BE SUBMITTED TO THE ENGINEER FOR APPROVAL.

THE INSTALLED METAL MONUMENT MUST BE EASILY DETECTED WITH A DIP NEEDLE. INERT PERMANENT MAGNETS SHALL BE ATTACHED NEAR THE TOP AND BOTTOM OF THOSE MONUMENTS CONSTRUCTED OF A METAL ALLOY WHICH IS NOT ATTRACTIVE TO A DIP NEEDLE.


TYPE A AND TYPE D MONUMENTS ARE EQUAL ALTERNATES UNLESS OTHERWISE SPECIFIED.

THE CAST IRON MONUMENT COVER SHALL BE A "NON-ROCKING" TYPE. ADJUSTMENT OF THE COVER TO GRADE MAY BE ACCOMPLISHED BY THE USE OF MORTAR AND BRICK, OR BY EITHER PRECAST OR CAST-IN-PLACE REINFORCED CONCRETE GRADE RINGS.


MONUMENTS SHALL BE LOCATED AND PLACED AT THE DIRECTION OF THE ENGINEER.

ALUMINUM MONUMENTS AND MONUMENT COVERS SHALL BE MADE FROM AN ALUMINUM AND MAGNESIUM ALLOY AS DETERMINED BY THE MANUFACTURER.

THE MONUMENT COVERS DETAILED ON THIS DRAWING ARE NOT EQUAL ALTERNATES. MONUMENT COVERS SHALL BE CAST IRON UNLESS ALUMINUM IS SPECIFIED ELSEWHERE IN THE CONTRACT.

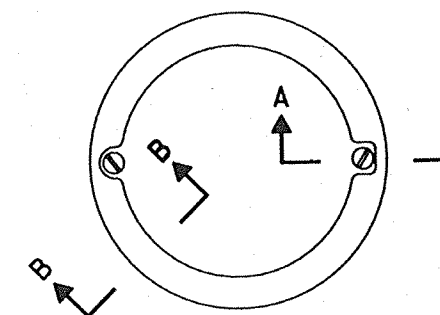

TOP VIEW

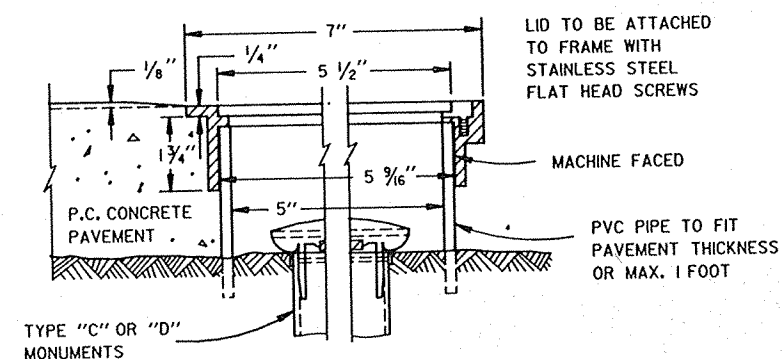

SECTION B-B SECTION A-A
ALUMINUM MONUMENT COVER

(APPROXIMATE WEIGHT 2 LBS)
(FOR CONCRETE PAVEMENT ONLY)


LANDMARK REFERENCE MONUMENTS AND COVERS

STATE OF WISCONSIN
DEPARTMENT OF TRANSPORTATION

APPROVED
6-18-84
DATE


CHIEF DESIGN ENGINEER

FHWA

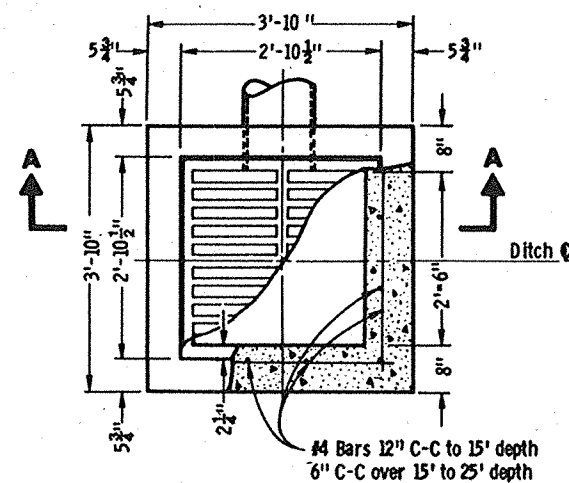


PLAN VIEW

INLET TYPE 8
REINFORCED CONCRETE

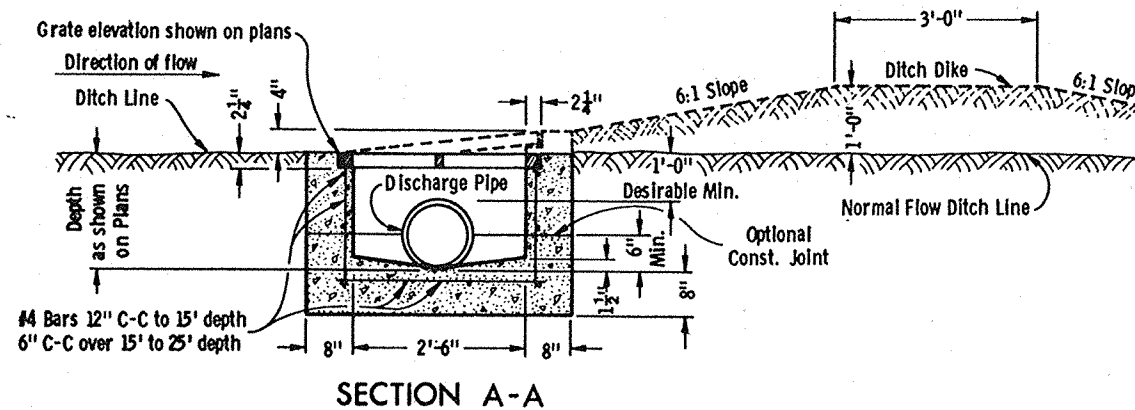


SECTION A-A

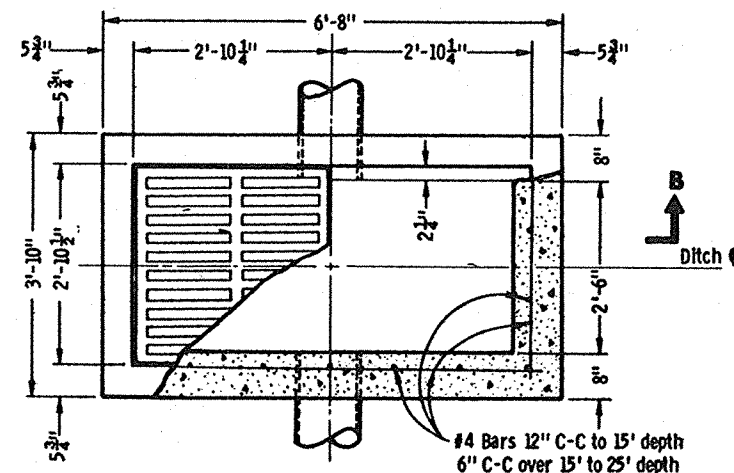


PLAN VIEW

INLET TYPE 9
REINFORCED CONCRETE

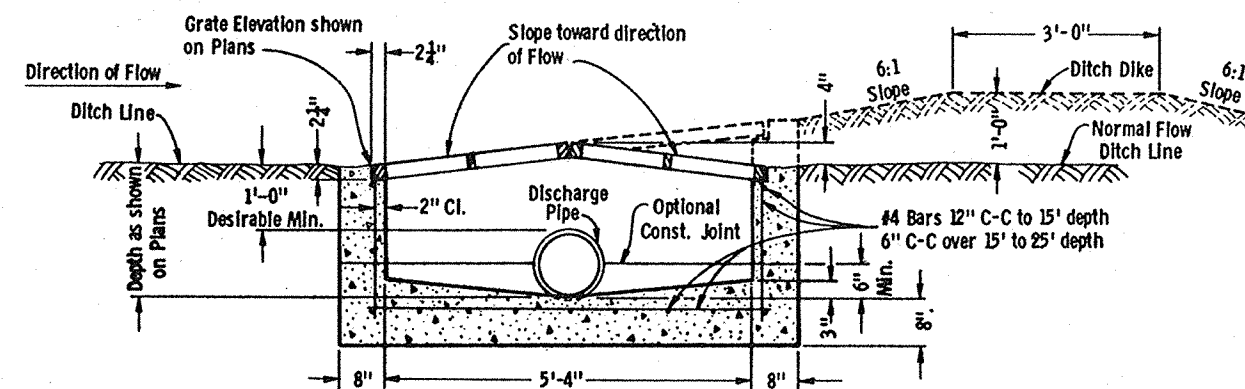


SECTION B-B

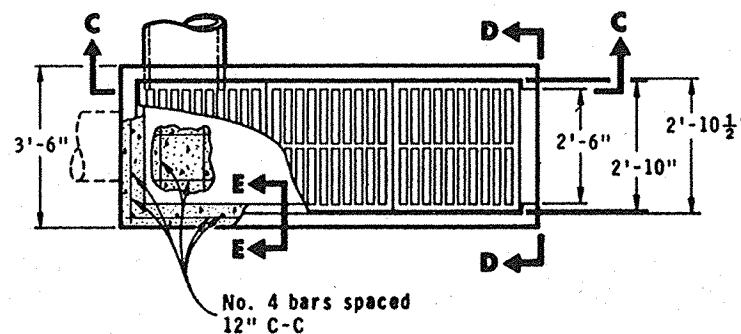


PLAN VIEW


INLET TYPE 10
REINFORCED CONCRETE

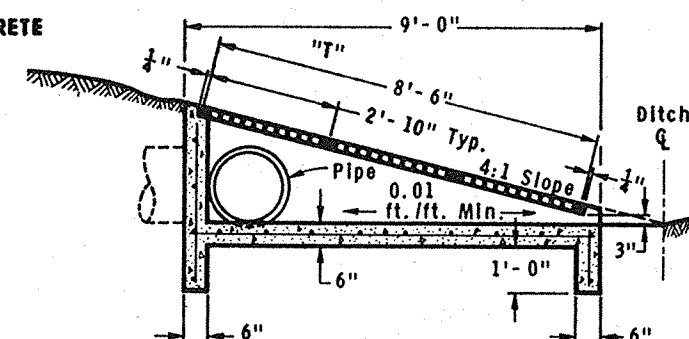

SECTION C-C

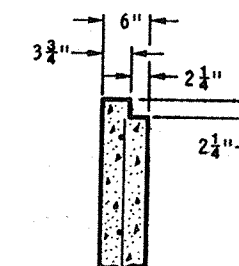

SECTION E-E

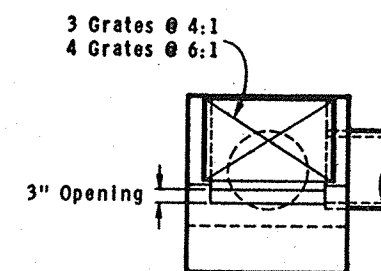

VIEW D-D

GENERAL NOTES


Details of construction, materials and workmanship not shown on this drawing shall conform to the pertinent requirements of the Standard Specifications and the applicable Special Provisions.

Detailed drawings for proposed alternate designs for Inlets which may include precast reinforced concrete inlets, shall be submitted to the Engineer for approval providing that such alternate designs make provision for equivalent capacity and strength.


Precast reinforced concrete inlet units, if used, shall conform to the requirements of the Catch Basins, Manholes and Inlets Section of the Standard Specification's.

All Inlets are designated on the Plans as "Inlets, 8-MS", etc. This designation is interpreted to mean that the number, or first digit designates the masonry portion of the structure and the following letter designates the type of cover or iron casting to be used therewith to comprise the complete unit.

All bar steel reinforcement shall be embedded 2 inches clear unless otherwise shown or noted.

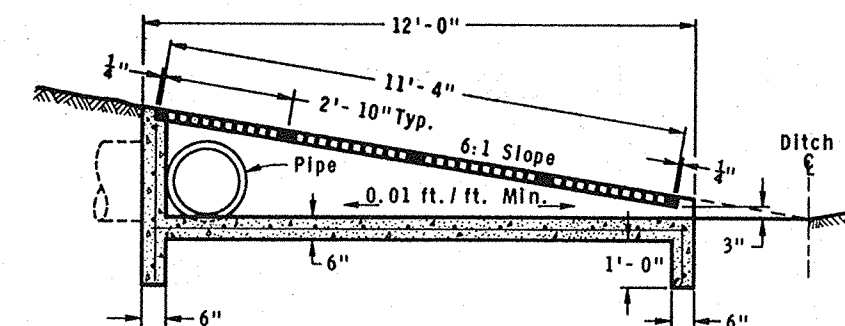

SECTION G-G

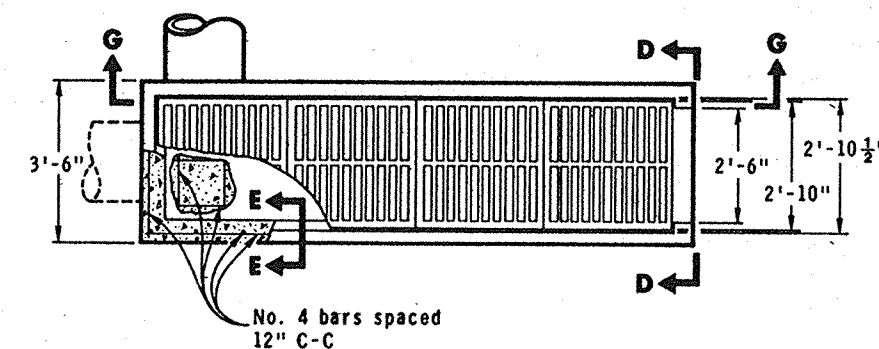

PLAN VIEW
INLET TYPE 11
REINFORCED CONCRETE

INLETS TYPE 8,9,10 and 11

State of Wisconsin
Department of Transportation
Division of Highways

RECOMMENDED FOR APPROVAL:

4-30-74

DATE

APPROVED

5-02-74

DATE

J. C. Hennrich
CHIEF OF FACILITIES DEVELOPMENT

W. J. Sinder
STATE HIGHWAY ENGINEER


STATION	DISTANCE	YARDAGE	
		EXCAVATION	FILL
1+00	100	296	46
2+00	100	317	126
3+00	100	320	176
4+00	100	407	135
5+00	100	443	96
6+00	100	415	96
7+00	100		
8+00	100		
SCALE
(FEET)


SHEET TOTAL

2198

675

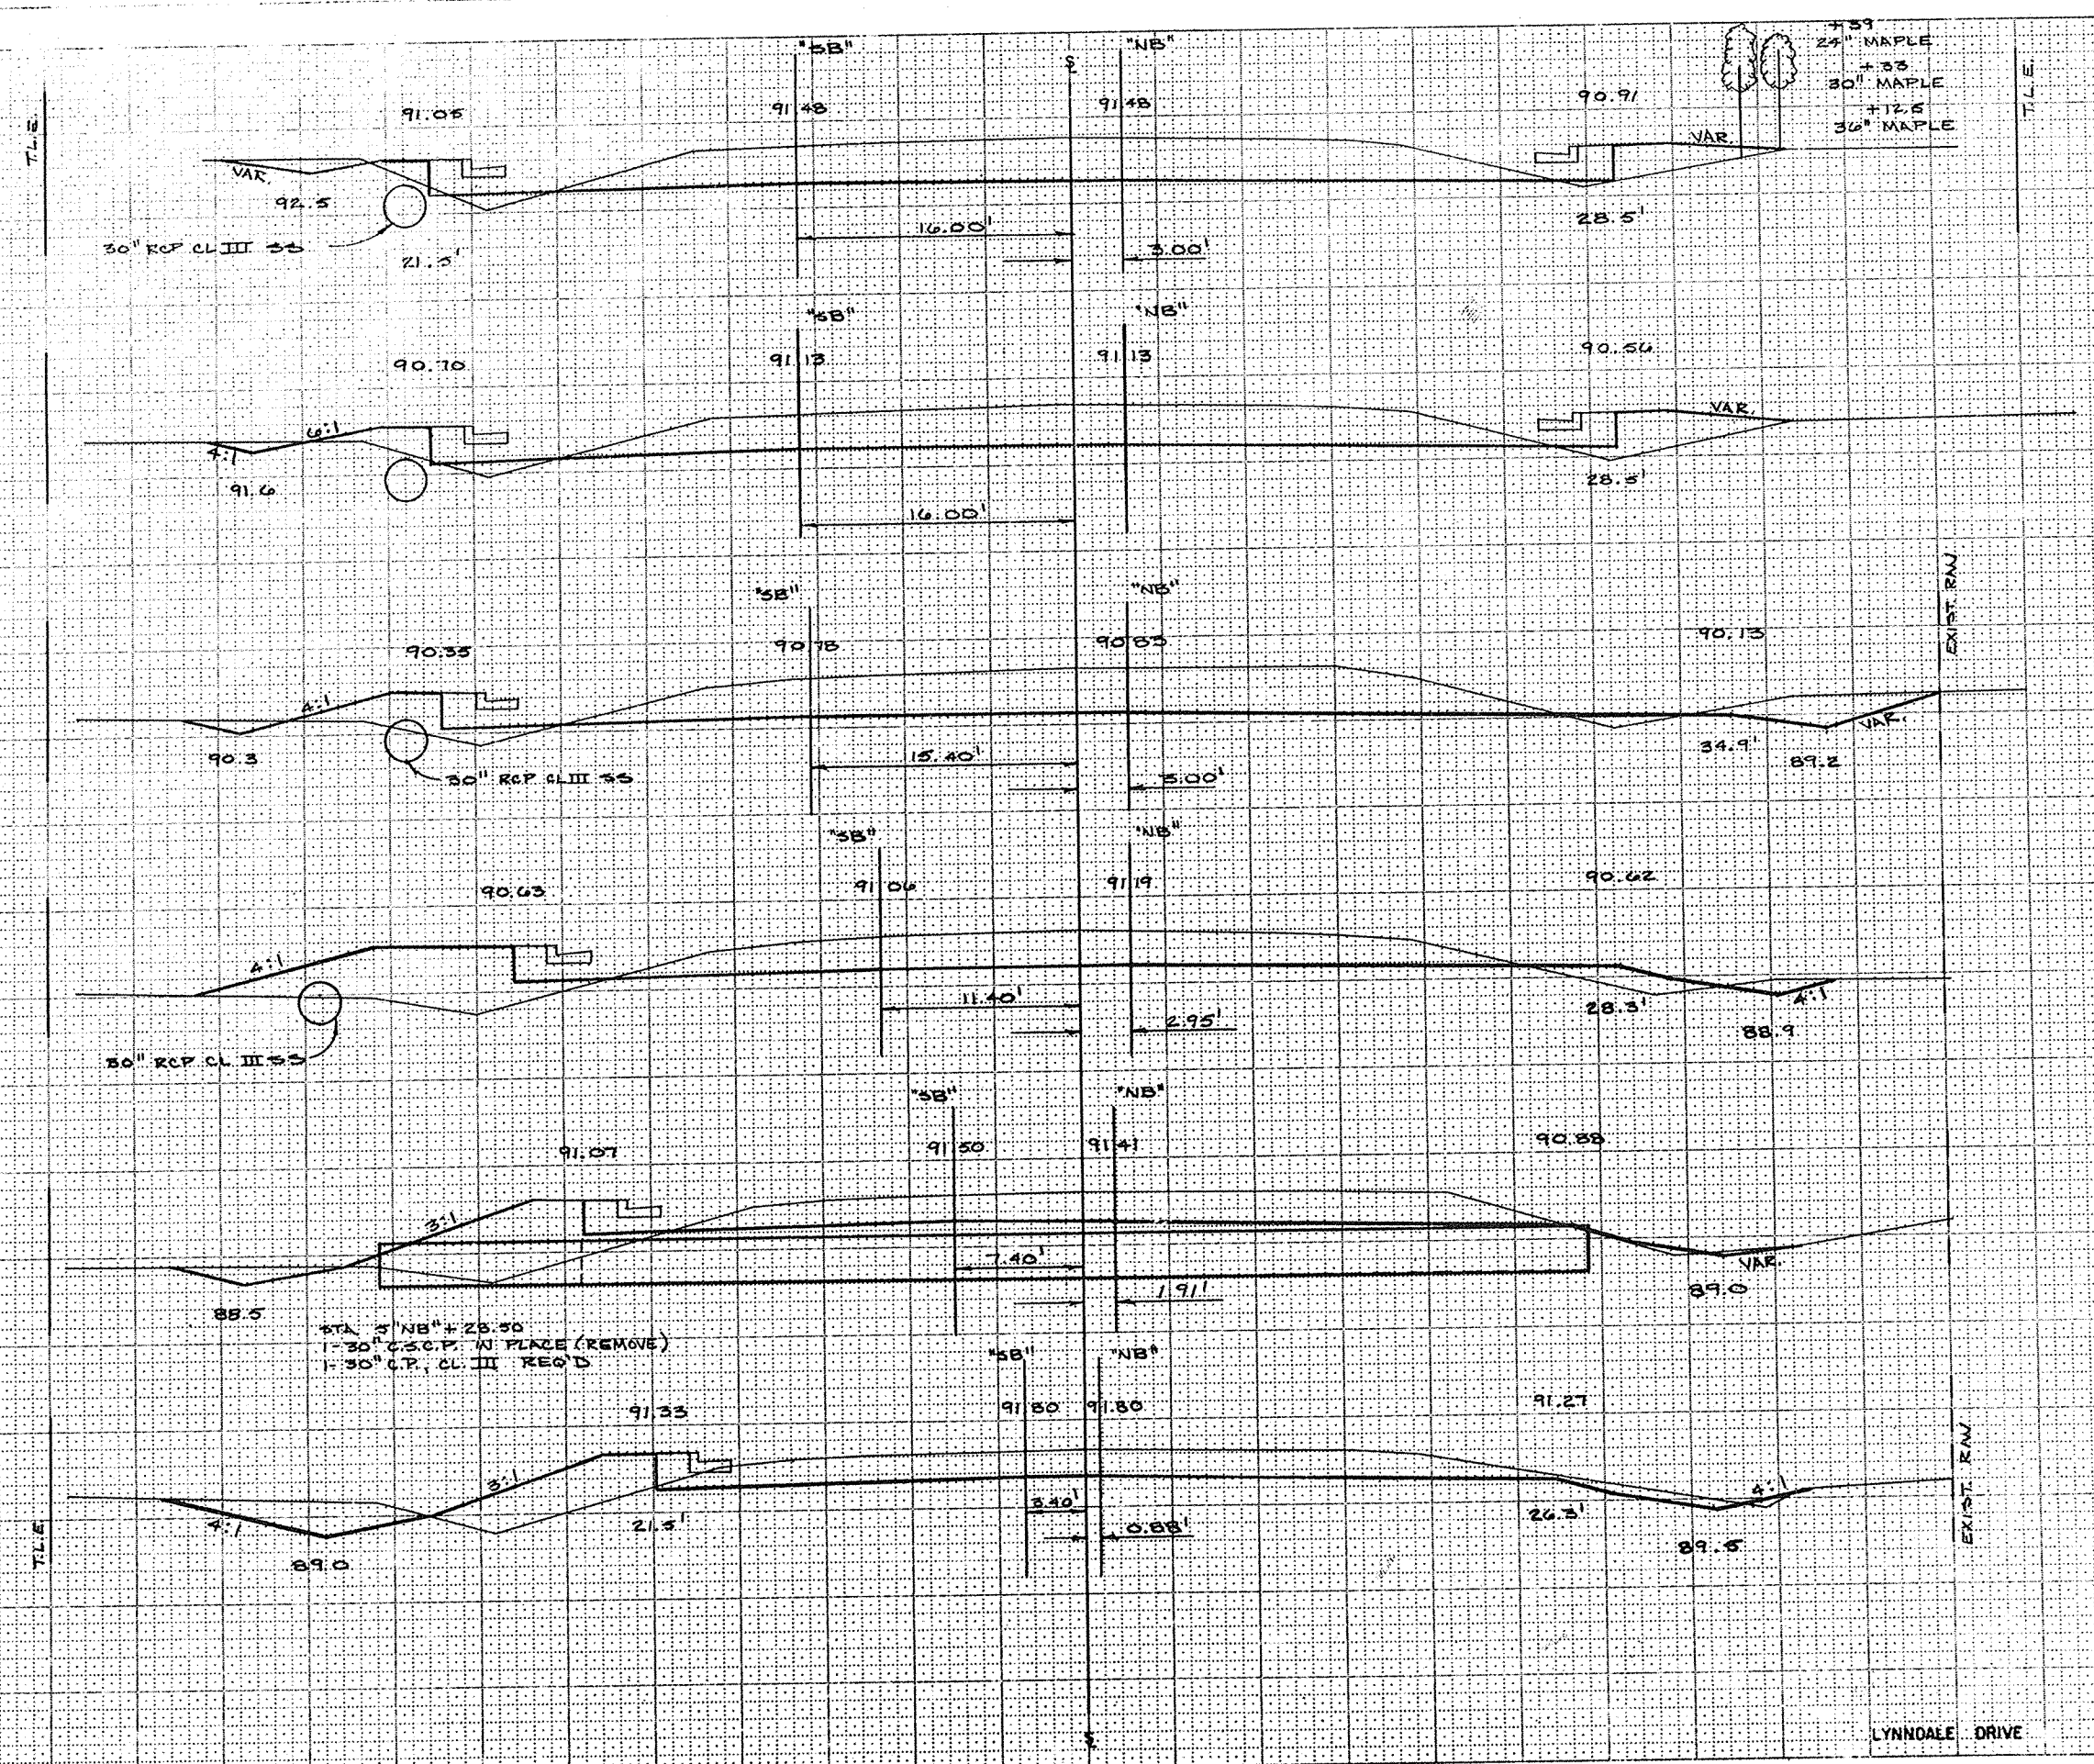

LYNNDALE DRIVE

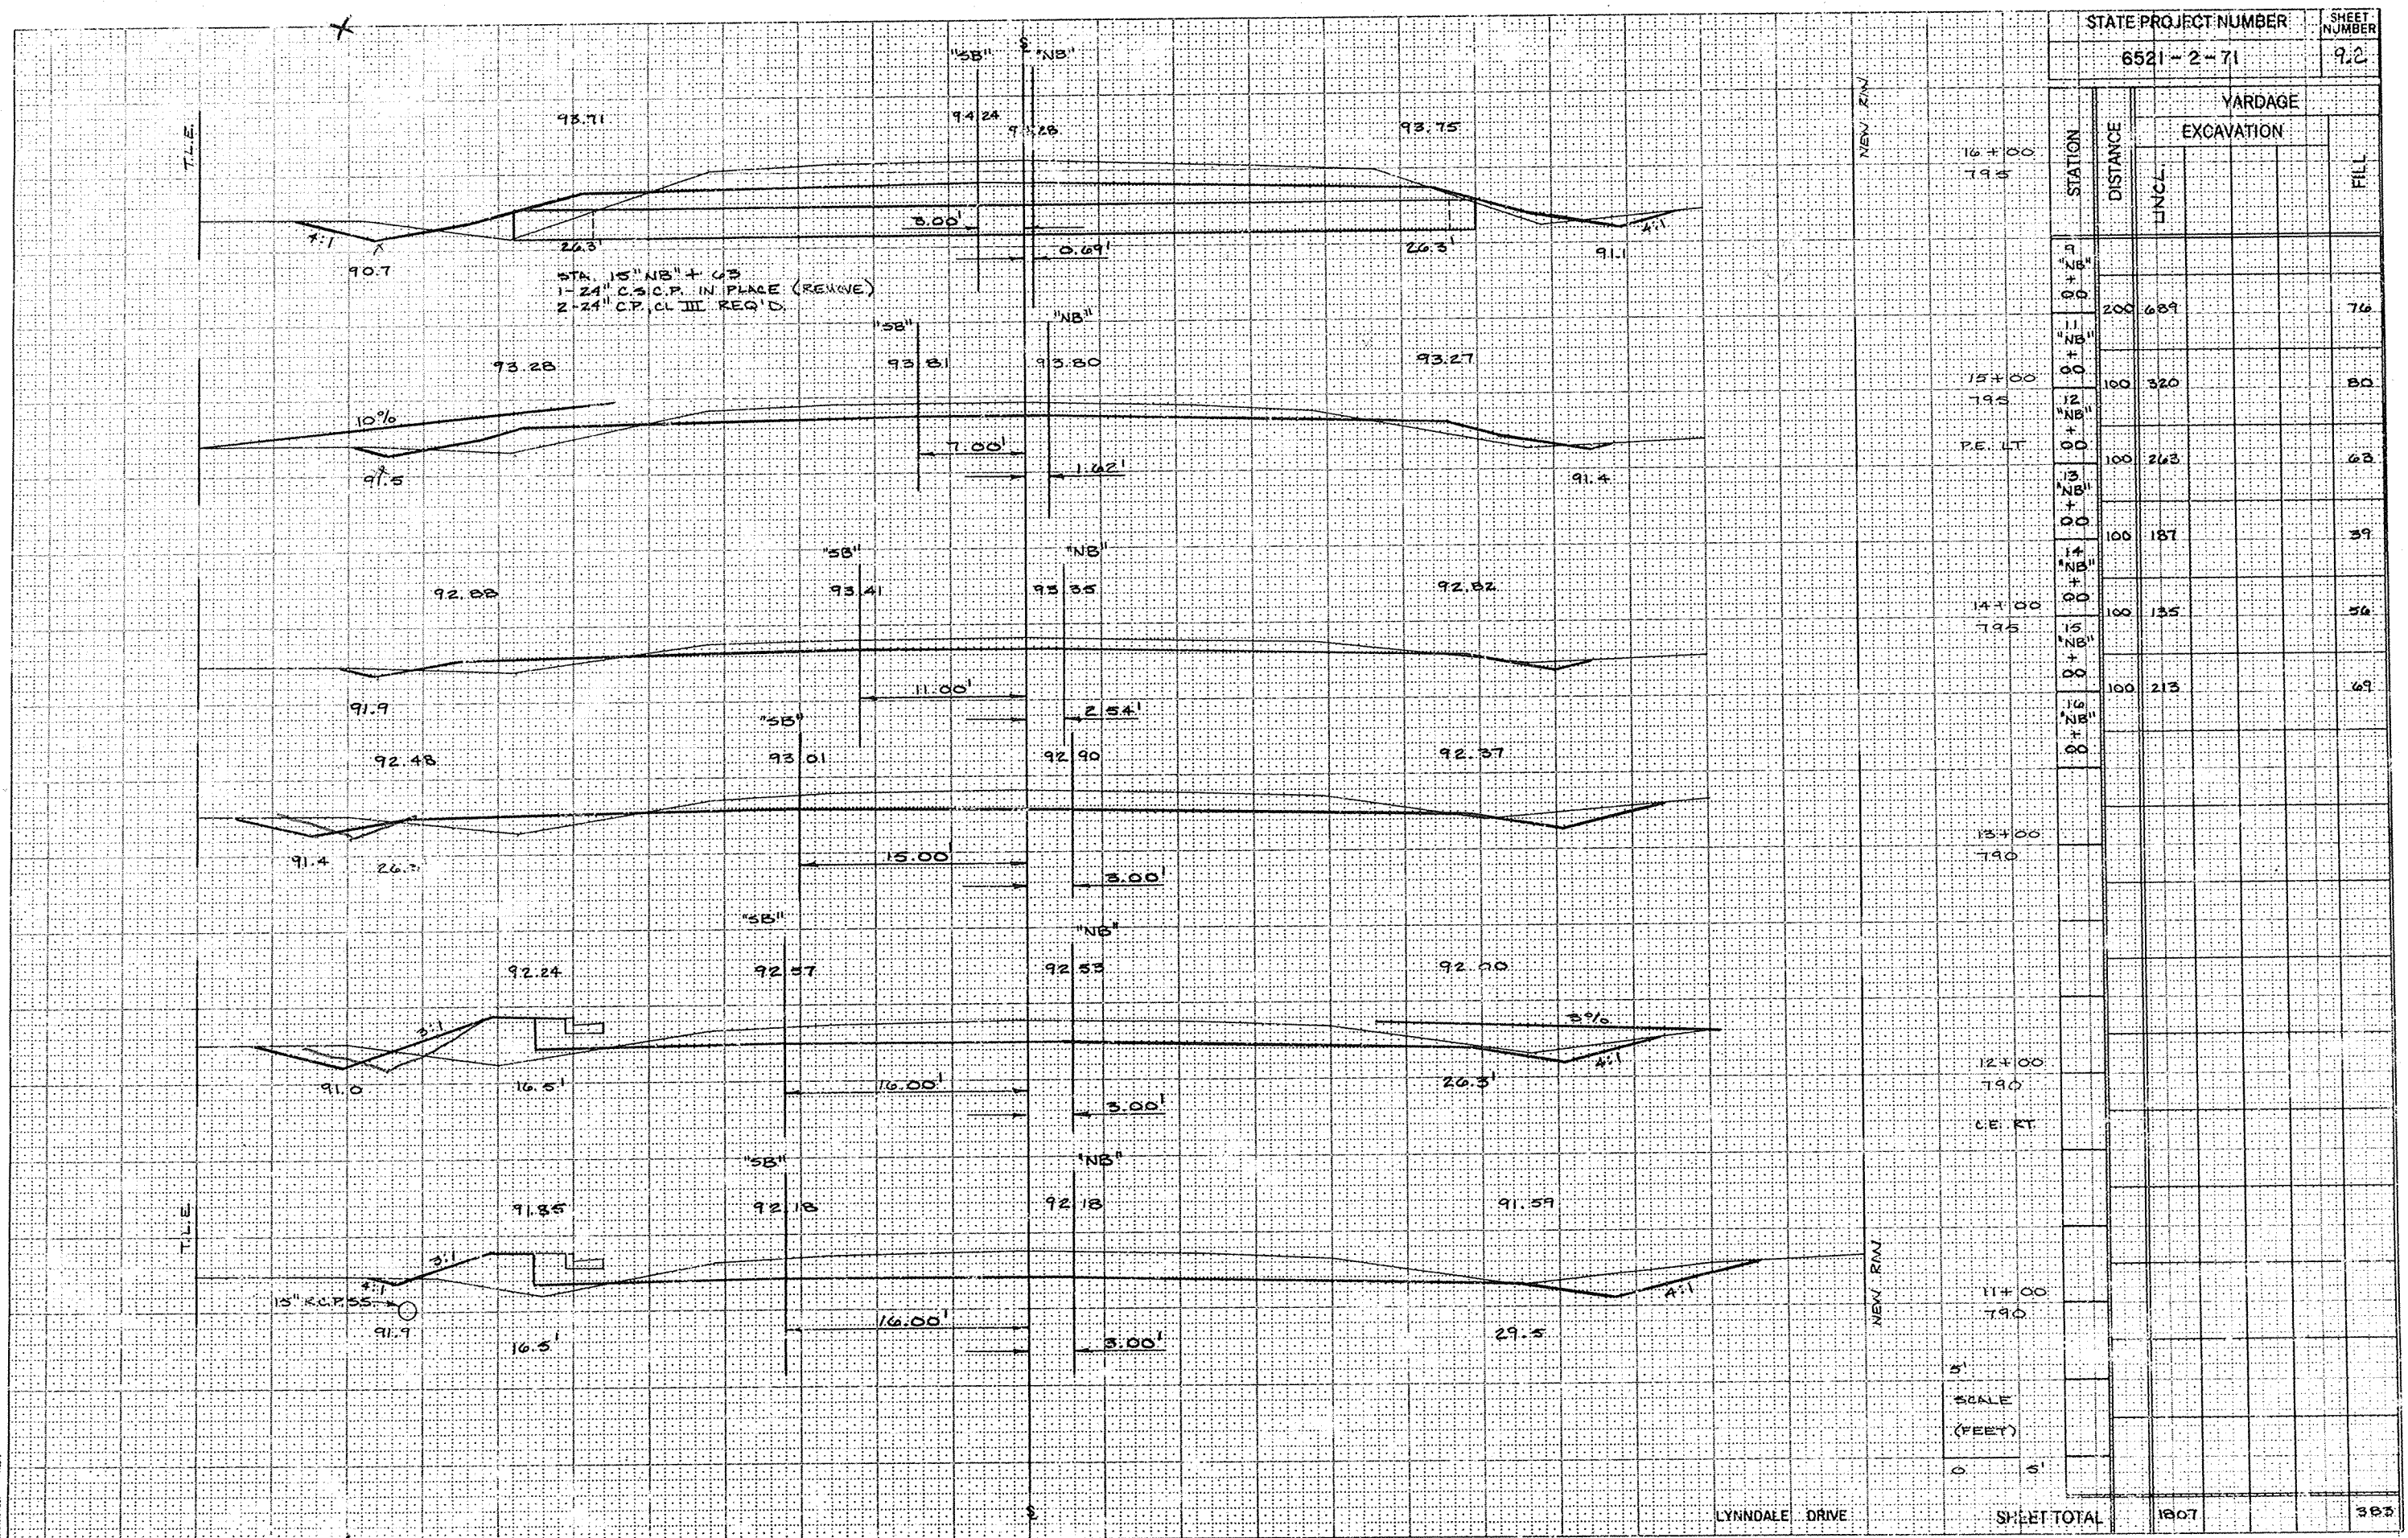

STATE PROJECT NUMBER
6521-2-71


SHEET NUMBER
92

STATION	DISTANCE	VARDAGE	
		EXCAVATION	FILL
14+00	194		
13+00	194		
12+00	194		
15+00	194		
16+00	194		
17+00	194		
6521-2-71 CTH "A" DISTRICT 3
 M1201(14) (TN OF GRAND CHUTE) OUTA.
 LYNNDAL DR. & CAPITOL DR. INTERS.
 SOMMERS CONSTRUCTION CO., INC. CONTR. 1
 GRADE, BASE, ASPH. SUR., TRAFFIC SIGNALS

FOR OMNI

SIGNAL WIRING DIAGRAM

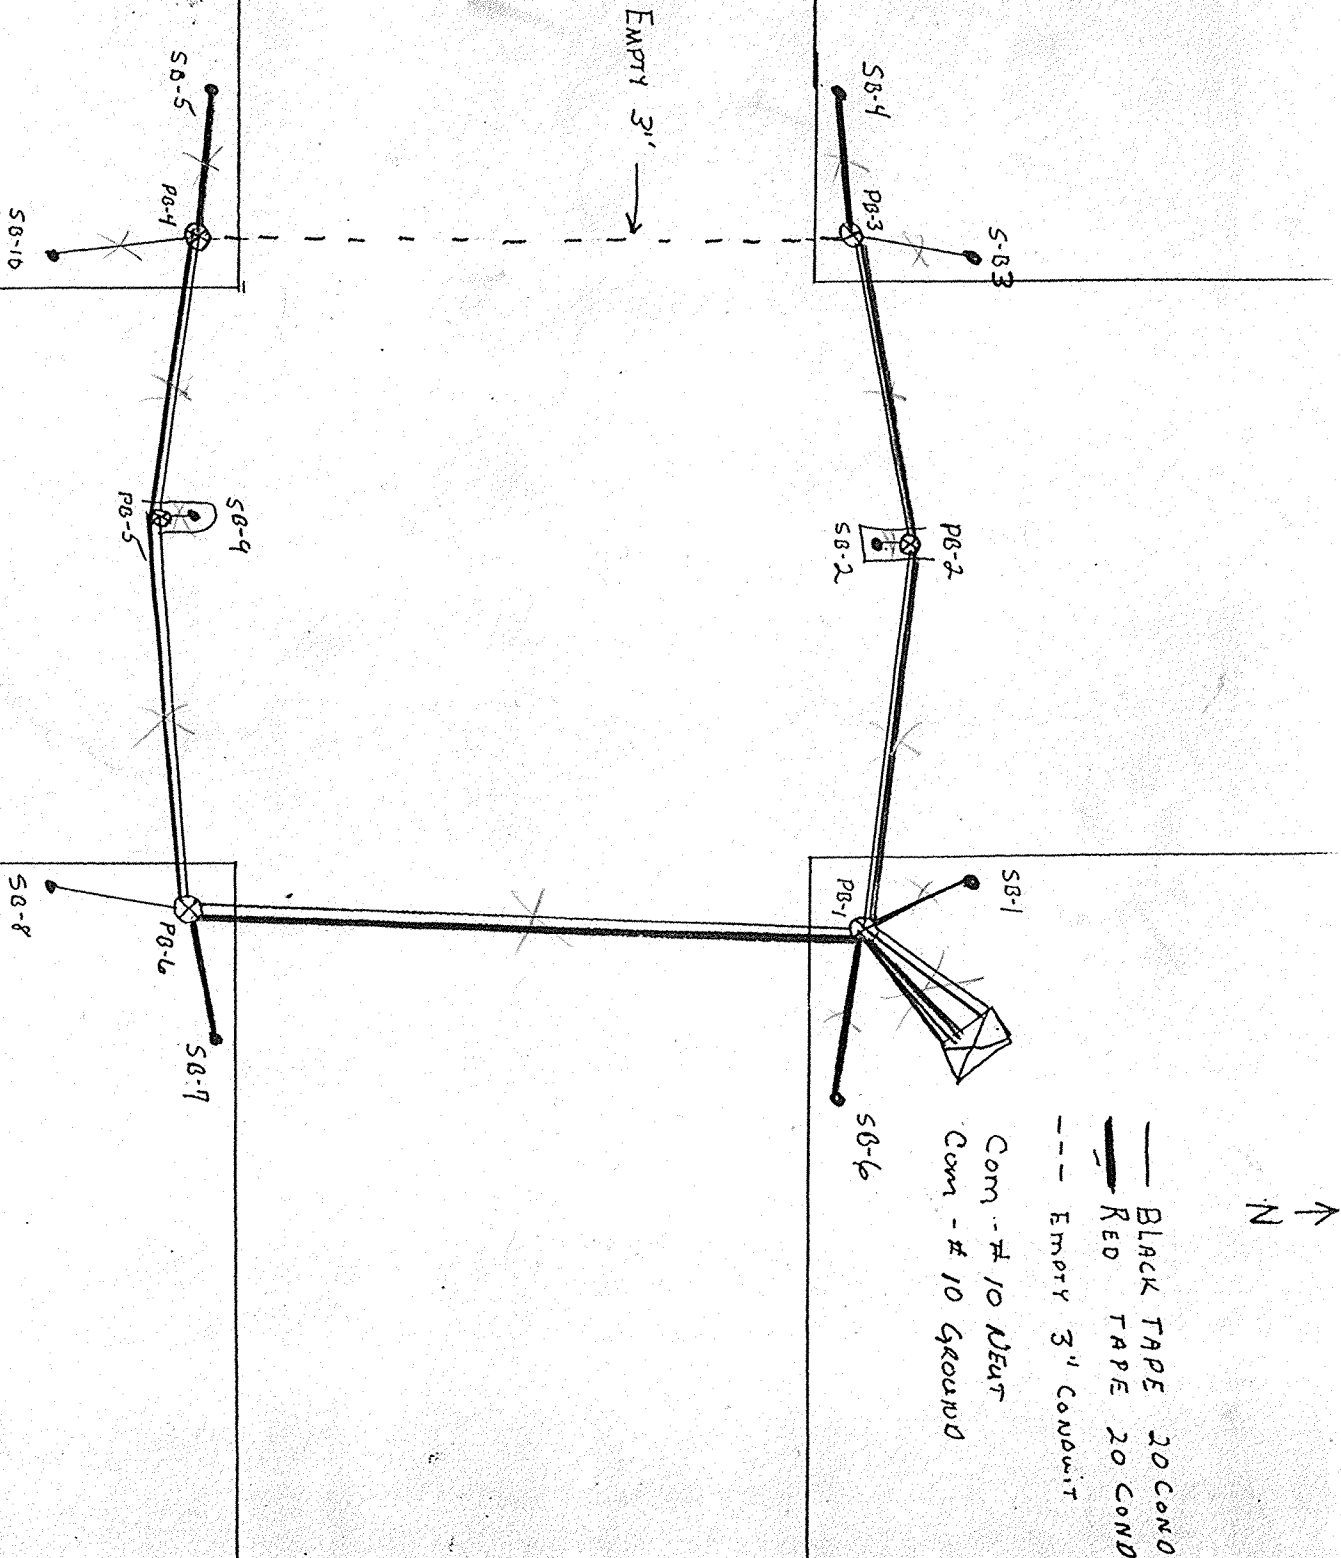

NB+SB MOVEMENTS

20 COND BLACK TAPE

NB-R - RED
 NB-Y - OR
 NB-G - GRE
 SB-R - RED/BLK
 SB-Y - OR/BLK
 SB-G - GR/BLK
 DW-φ8 - BLK
 W-φ8 - BLU
 DW-φ4 - BLK/WH
 W-φ4 - BLU/WH
 Y-φ1 - RED/WH
 G-φ1 - GR/WH
 Y-φ5 - OR/RED
 G-φ5 - BLU/RED
 PB Com - WH
 PB-φ8 - RED/GRE
 PB-φ4 - WH/RED

EB+WB MOVEMENTS

20 COND RED TAPE

EB-R - RED
 EB-Y - OR
 EB-G - GRE
 WB-R - RED/BLK
 WB-Y - OR/BLK
 WB-G - GR/BLK
 DW-φ6 - BLK
 W-φ6 - BLU
 DW-φ2 - BLK/WH
 W-φ2 - BLU/WH
 Y-φ3 - RED/WH
 G-φ3 - GRE/WH
 PB Com - WH
 PB-φ2 - WH/RED
 PB-φ6 - RED/GRE

SPARES - BLK/RED, BLU/BLK, WH/BLK.

11 = D1

21 = D3

31 = D5

41 = D7

51 = D9

61 = D11

81 = D15

SPARES BLK/RED, BLU/RED, OR/RED

WH/BLK, BLU/BLK